

CONTRACT DRAWINGS - FOR - Pawtucket Regional Water Treatment Facility Pkg 11 & 12 Raw Water Pump Station

Pawtucket, Rhode Island


OCTOBER 31, 2006

INDEX


<u>DWG.</u>	<u>TITLE</u>
	COVER
G-1	ABBREVIATIONS AND SYMBOLS
G-2	PROCESS SCHEMATIC
	<u>SITE</u>
LA-1	EXISTING CONDITIONS PLAN
LA-2	PROPOSED SITE PLAN
LA-3	SITE DETAILS
ST-1	SITE PIPING PLAN
ST-2	SITE PIPING DETAILS
	<u>STRUCTURAL</u>
S-1	STRUCTURAL PLANS AT EL. 59.00
S-2	STRUCTURAL PLANS AT EL. 75.00
S-3	STRUCTURAL ROOF PLAN
S-4	STRUCTURAL DETAILS AND NOTES
	<u>ARCHITECTURAL</u>
A-1	ABBREVIATIONS AND CODE SUMMARY
A-4	HIGH ROOF PLAN
A-14	DETAILS
A-17	PUMP LEVEL FLOOR PLAN SCHEDULES AND DETAILS
A-17a	GROUND LEVEL PLAN, ELEVATIONS AND DETAILS
A-18	SECTIONS AND DETAILS
A-18a	LOUVER DETAILS

INDEX

<u>DWG.</u>	<u>TITLE</u>
	<u>MECHANICAL</u>
M-16	PLAN AND SECTIONS
M-17	CHEMICAL FEED SCHEMATICS, INTAKE STRUCTURE PLAN AND SECTION
	<u>FIRE PROTECTION</u>
FP-1	GENERAL NOTES, LEGENDS AND SPECIFICATIONS
FP-2	FLOOR PLAN AND DETAILS
	<u>PLUMBING</u>
P-1	GENERAL NOTES, LEGENDS, SCHEDULES AND ABBREVIATIONS
P-2	PLUMBING FLOOR PLANS AND DETAILS
	<u>HVAC</u>
H-1	GENERAL NOTES, LEGENDS AND SCHEDULES
H-2	HVAC FLOOR PLANS, SECTION AND ELEVATIONS
H-3	MECHANICAL SITE PLAN AND DETAILS
	<u>ELECTRICAL</u>
E-1	LEGEND, ABBREVIATIONS AND GENERAL NOTES
E-2	SITE PLAN
E-3	480V SINGLE LINE DIAGRAM "MCC2"
E-4	CONTROL WIRING DIAGRAMS
E-5	BLOCK WIRING DIAGRAMS
E-6	SCHEDULES
E-7	DETAILS
E-8	LIGHTING AND MISC. SYSTEM PLAN
E-9	PUMP LEVEL POWER PLAN
E-10	GROUND LEVEL POWER PLAN

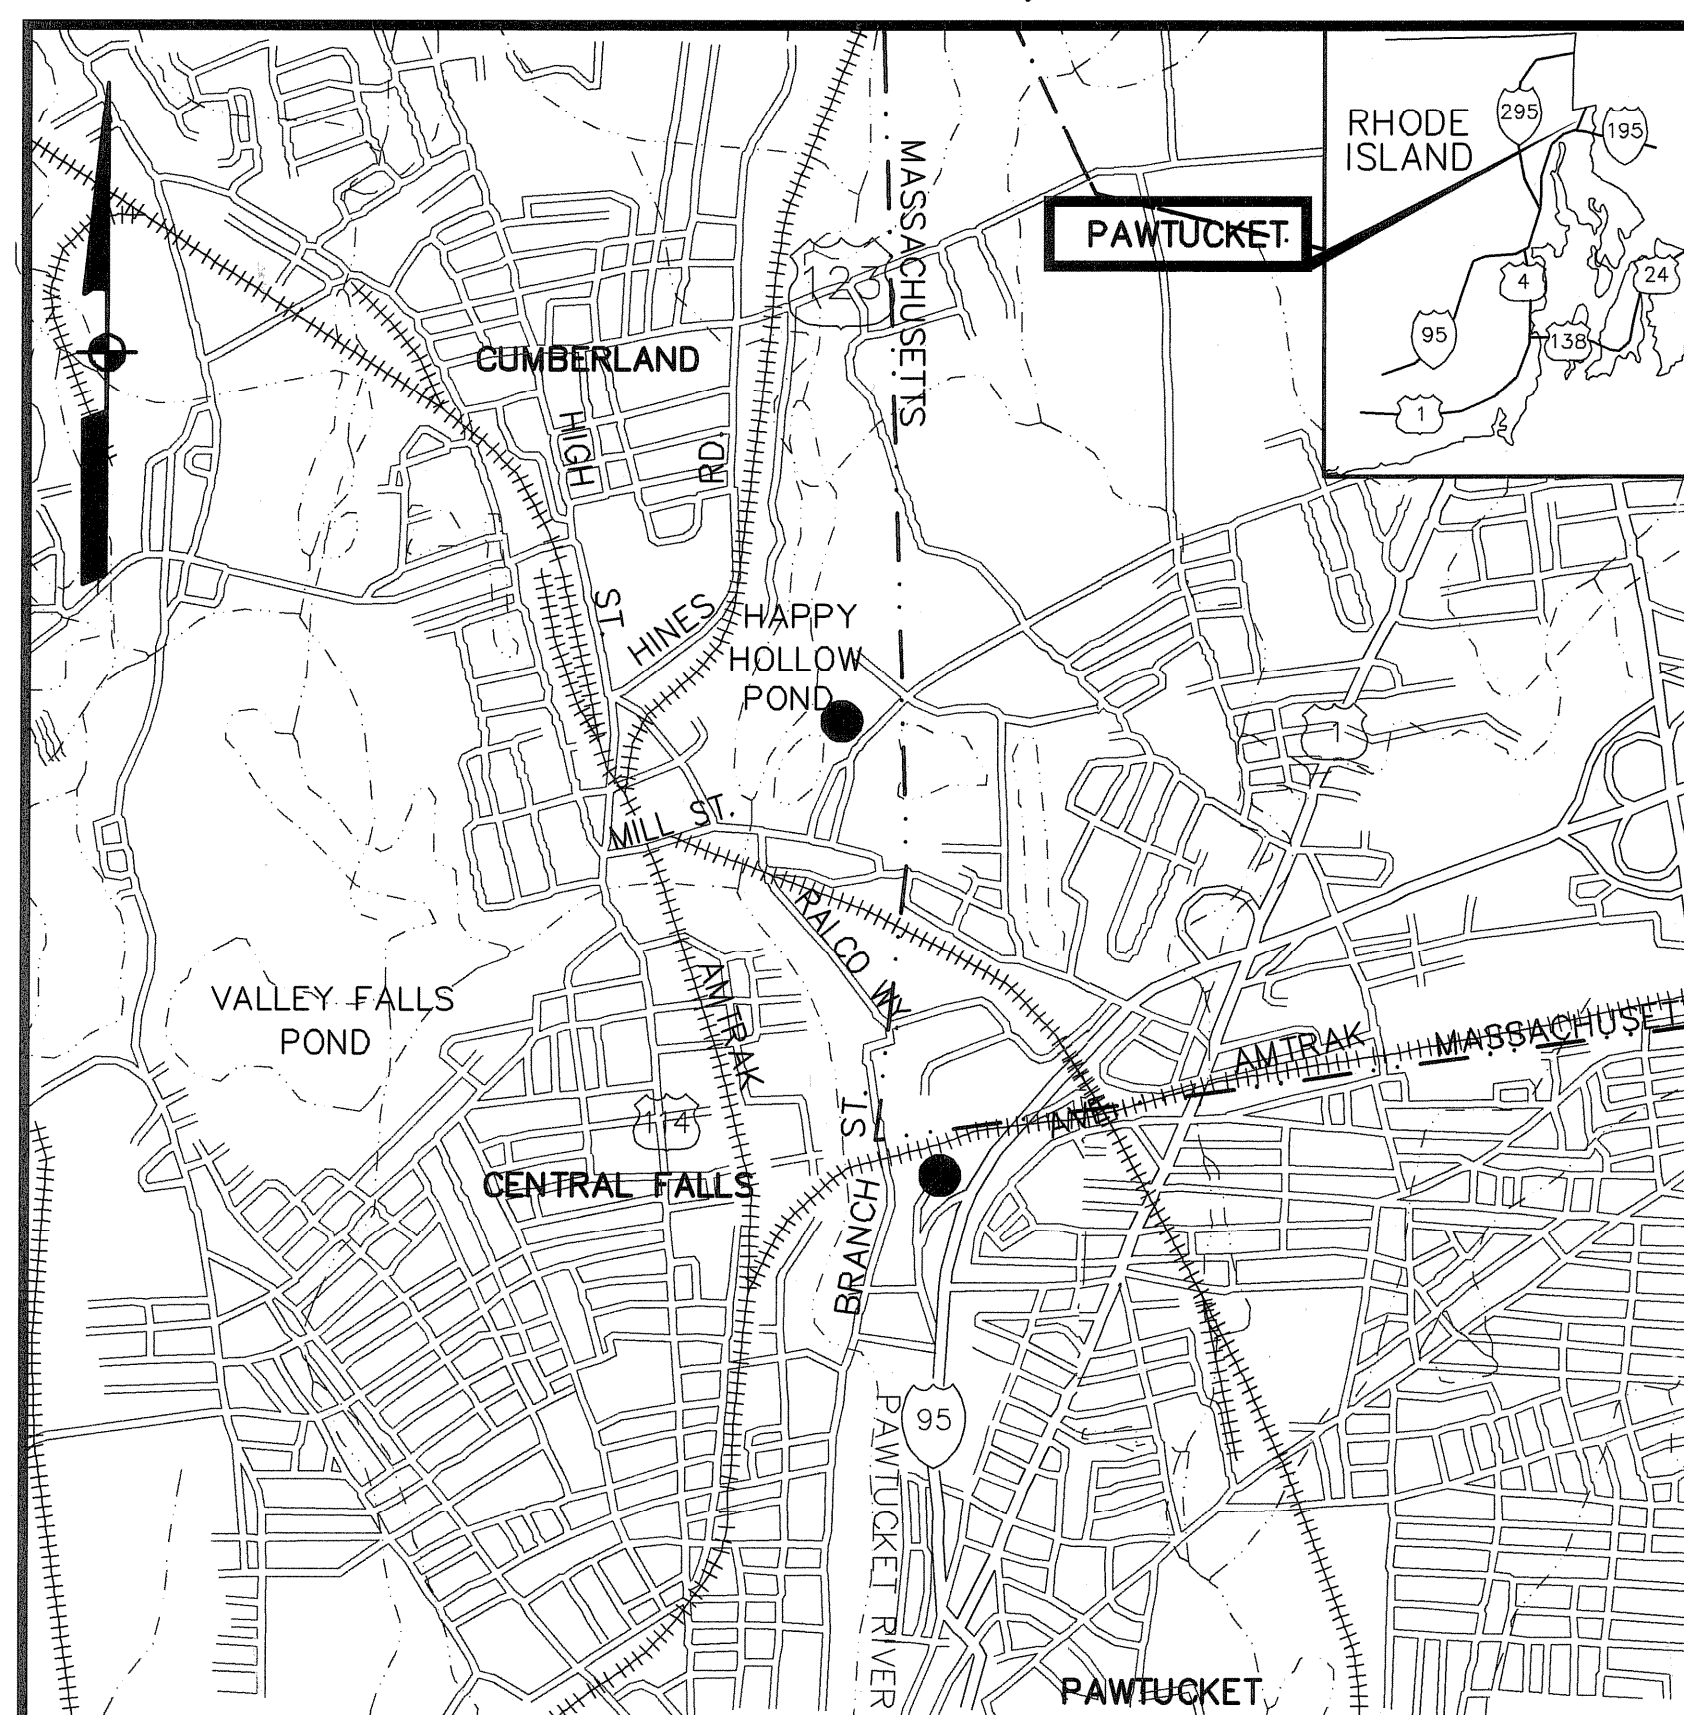

LOCUS
NOT TO SCALE

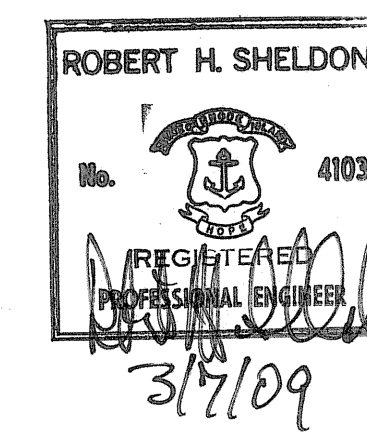

A Tyco International Ltd. Company

300 Baker Avenue Suite 290 Concord, Mass.

GENERAL NOTES

LOCATIONS OF ALL UTILITIES AND SUB-SURFACE STRUCTURES ARE FROM SURVEY AND RECORDS OF TOWN, CORPORATIONS, ETC., AND ARE CONSIDERED APPROXIMATE BOTH AS TO SIZE AND LOCATION AND ARE INDICATED ON THESE DRAWINGS TO GIVE BIDDERS A GENERAL IDEA OF EXISTING CONDITIONS TO BE INVESTIGATED BY THE BIDDER. IT IS UNDERSTOOD AND AGREED THAT EACH BIDDER WILL NOT RELY UPON THESE DRAWINGS FOR SUCH INFORMATION, BUT THAT EACH BIDDER SHALL MAKE EXAMINATIONS IN THE FIELD BY VARIOUS AVAILABLE METHODS AND SHALL OBTAIN INFORMATION FROM UTILITY CORPORATIONS AND INDIVIDUALS AS TO THE LOCATION OF ALL SUB-SURFACE STRUCTURES.

ALL ELEVATIONS REFER TO NATIONAL GEODETIC VERTICAL DATUM OF 1929.

EARTH TECH
AS-BUILT FILE
MAY 2008

ABBREVIATIONS AND SYMBOLS

ABBREVIATION	SYMBOLS		DESCRIPTION	ABBREVIATION	SYMBOLS		DESCRIPTION
	LESS THAN 4 INCHES	4 INCHES & GREATER			LESS THAN 4 INCHES	4 INCHES & GREATER	
ACV			AIR CONTROL VALVE	S.OPER.			SOLENOID OPERATED VALVE
B. EL.			BASE ELBOW	LAT.			STRAINER
BV			BALL VALVE	TEE			TEE
BCV			BALL CHECK VALVE	3-WAY PV			THREE WAY PLUG VALVE
BFV			BUTTERFLY VALVE (OPEN/CLOSE)	VB			VACUUM BREAKER
BF			BLIND FLANGE	VENTURI			VENTURI
CL			CENTER LINE	Y.HYD.			YARD HYDRANT
CV			CHECK VALVE				
DIS. MANT. JT.			DISMANTLING JOINT				
ECC.RED.			ECCENTRIC REDUCER				
F.D.			FLOOR DRAIN				
FV OR FCV			FLOW CONTROL VALVE				
FLG. & FL.			FLANGE AND FLARE				
GV			GATE VALVE ^①				
H.B.			HOSE BIB				
HYD.			HYDRANT				
H.W.			HAND WHEEL				
KV			KNIFE VALVE				
M.H.			MANHOLE				
MFM			MAGNETIC FLOW METER				
MOV			MOTOR OPERATED VALVE				
NV			NEEDLE VALVE				
PRV			PRESSURE (REDUCING/REGULATING) VALVE				
BPV			BACK PRESSURE CONTROL VALVE				
SLV			SURGE RELIEF VALVE				
PCV			PNEUMATIC OPERATED MODULATING FLOW CONTROL VALVE				
RED.			REDUCER, REDUCING				
RM			ROTAMETER				

NOTE:
 ① GATE VALVES SHALL NOT BE LARGER THAN 12" DIAMETER UNLESS OTHERWISE DIRECTED.

ABBREVIATIONS FOR PIPE TYPES

ABBREVIATION	DESCRIPTION
A.C.C.M.P.	ASPHALT COATED CORRUGATED METAL PIPE
C.I.	CAST IRON PIPE
CPVC	CHLORINATED POLYVINYL CHLORIDE
CU	COPPER PIPE
D.I.	DUCTILE IRON PIPE
FRP	FIBERGLASS REINFORCED PIPE
FPVC	FLEXIBLE POLYVINYL CHLORIDE
GALV.	GALVANIZED PIPE
P.C.C.P.	PRESTRESSED CONCRETE CYLINDER PIPE
POLY	POLYETHYLENE PIPE
P.V.C.	POLYVINYL CHLORIDE PIPE
R.C.	REINFORCED CONCRETE PIPE
S	STEEL PIPE
S.S.	STAINLESS STEEL PIPE
V	VINYL TUBING

ABBREVIATION	PIPE
P.V.C.	CHEMICAL - DOSING
C.P.V.C.	CHEMICALS - FILL
S.S. OR D.I.	INTERIOR RAW WATER
S.S. OR D.I.	INTERIOR TREATED WATER
S.S.	AIR
P.V.C.	ANALYZERS
STEEL	DRAIN
STEEL	FUEL
CU	HEATING WATER
D.I.	OVERFLOW, HIGH SERVICE PUMPS, BACKWASH PUMPS
CU	POTABLE WATER
DUCTILE IRON (4" OR GREATER) P.V.C. (1 1/2" - 3") CU (1 1/4" OR SMALLER)	PLANT WATER
D.I.	SANITARY DRAIN
P.V.C.	VENT
S.S. OR D.I.	RAW AND GALLERY PIPING

NOTES:
 1. LAYOUTS SHOWN ON MECHANICAL DRAWINGS ARE BASED UPON STAINLESS STEEL PIPE EXCEPT FOR IN HIGH SERVICE PUMP ROOM.
 2. THE WALL PIPE SHALL BE PROVIDED WITH SPACE BETWEEN THE WALL AND THE FLANGE TO ALLOW FOR REMOVAL OF BOLTS AS SHOWN IN DWG. M-6. TAPPING WILL NOT BE ACCEPTED.
 3. UPON APPROVAL FORM ENGINEER, VITALIC COUPLING CAN BE USED AS RESTRAINTS IN PLACE OF FLANGE CONNECTIONS.

ABBREVIATIONS

ABBREVIATION	DESCRIPTION
ACV	AIR CONTROL VALVE
AD	AIR DUCT
AE	ANALYZER ELEMENT
AFF	ABOVE FINISHED FLOOR
AI	AIR INTAKE
AL	ALUMINUM
ALK	ALKALINITY
BL	BLOWER
BWCV	BACKWASH CONTROL VALVE
CBWCV	CLARIFIER BACKWASH CONTROL VALVE
C.FLG.	COMPANION FLANGE
CHEM.	CHEMICAL
CPB	CHLORINE PULL BOX
CPLG.	COUPLING
CONC.	CONCRETE
C.O.	CLEAN OUT
CSK.	COUNTERSUNK
D	DISCHARGE
DIA.	DIAMETER
DISCH.	DISCHARGE
DN	DOWN
D & T	DRILL AND TAP
EBP	EQUALIZATION PUMP
EL	ELEVATION
EQ.	EQUALIZATION
EQUIP.	EQUIPMENT
EXP.	EXPANSION
FCV	FLOW CONTROL VALVE
FE	FLOW ELEMENT
FIN. GR.	FINISHED GRADE
FLEX.	FLEXIBLE
FL. EL.	FLOOR ELEVATION
FIN. FLR. EL.	FINISHED FLOOR ELEVATION
FIT	FLOW INDICATOR TRANSMITTER
FLG.	FLANGE
FWCV	FILTER TO WASTE CONTROL VALVE
HGL	HYDRAULIC GRADE LINE
HORIZ.	HORIZONTAL
HSP	HIGH SERVICE PUMP
H.P.	HIGH POINT
H.W.L.	HIGH WATER LEVEL
I	INTAKE
INV.	INVERT
LE	LEVEL ELEMENT
LIT	LEVEL INDICATING ELEMENT
LONG	LONG
L.R.	LONG RADIUS
L.W.L.	LOW WATER LEVEL
MAX.	MAXIMUM
MTG.	MANUFACTURER
MJ	MECHANICAL JOINT
M.W.L.	MAXIMUM WATER LEVEL
MIN.	MINIMUM
MFCV	MANUAL FLOW CONTROL VALVE
MFM	MAGNETIC FLOW METER
N.C.	NORMALLY CLOSED
N.O.	NORMALLY OPEN
NTS	NOT TO SCALE
O.C.	ON CENTER
OPER.	OPERATOR
PDBL	POSITIVE DISPLACEMENT BLOWER
PE	PRESSURE ELEMENT
PIT	PRESSURE INDICATOR TRANSMITTER
PG	PRESSURE GAUGE
PL	PLATE
PS	PRESSURE SWITCH
PSI	POUNDS PER SQUARE INCH
RED.	REDUCER, REDUCING
RM	ROTAMETER
S	SPARE
S.G.	SLIDE GATE
SHT.	SHEET
S.O.	SIDE OUTLET
SQ.	SQUARE
S.R.	SHORT RADIUS
S.S.	STAINLESS STEEL
SUCT.	SUCTION
SWP	SAMPLE WATER PUMP
T.O.C.	TOP OF CONCRETE
TOS	TOP OF SLAB
TYP.	TYPICAL
UV	ULTRAVIOLET
VEN.	VENTURI
VERT.	VERTICAL
VG	VACUUM GAUGE
V.O.R.	VALVE ON RISER
W/	WITH
WEIR EL.	WEIR CREST ELEVATION
W.L. EL.	WATER LEVEL ELEVATION
W.P.	WALL PIPE
W.S.	WALL SLEEVE
WS	WATER SURFACE

EarthTech
 A Tyco International Ltd. Company
 300 BAKER AVENUE SUITE 200 CONCORD MA 01742 (978) 371-4000

FULL SIZE DRAWING = 4"	REVISIONS
AS-BUILT DRAWING FILE	DATE
ISSUED FOR SET POSTED SET	DATE
ISSUED FOR CONSTRUCTION	DATE
REV. B AGENCY REVIEW	DATE
REV. A CLIENT REVIEW	DATE


ROBERT H. SHELDON
 No. 4103
 REGISTERED PROFESSIONAL ENGINEER

PAWTUCKET, RHODE ISLAND
PAWTUCKET REGIONAL WATER TREATMENT FACILITY
PKGS 11 & 12 - RAW WATER PUMP STATION
 ABBREVIATIONS AND SYMBOLS

DESIGNED BY	DWG SCALE
	NONE
DRAWN BY	CONTRACT NO.
CHECKED BY	DATE
	OCTOBER 31, 2008

EARTH TECH
AS-BUILT FILE
 MAY 2008

G-1
 SHEET OF

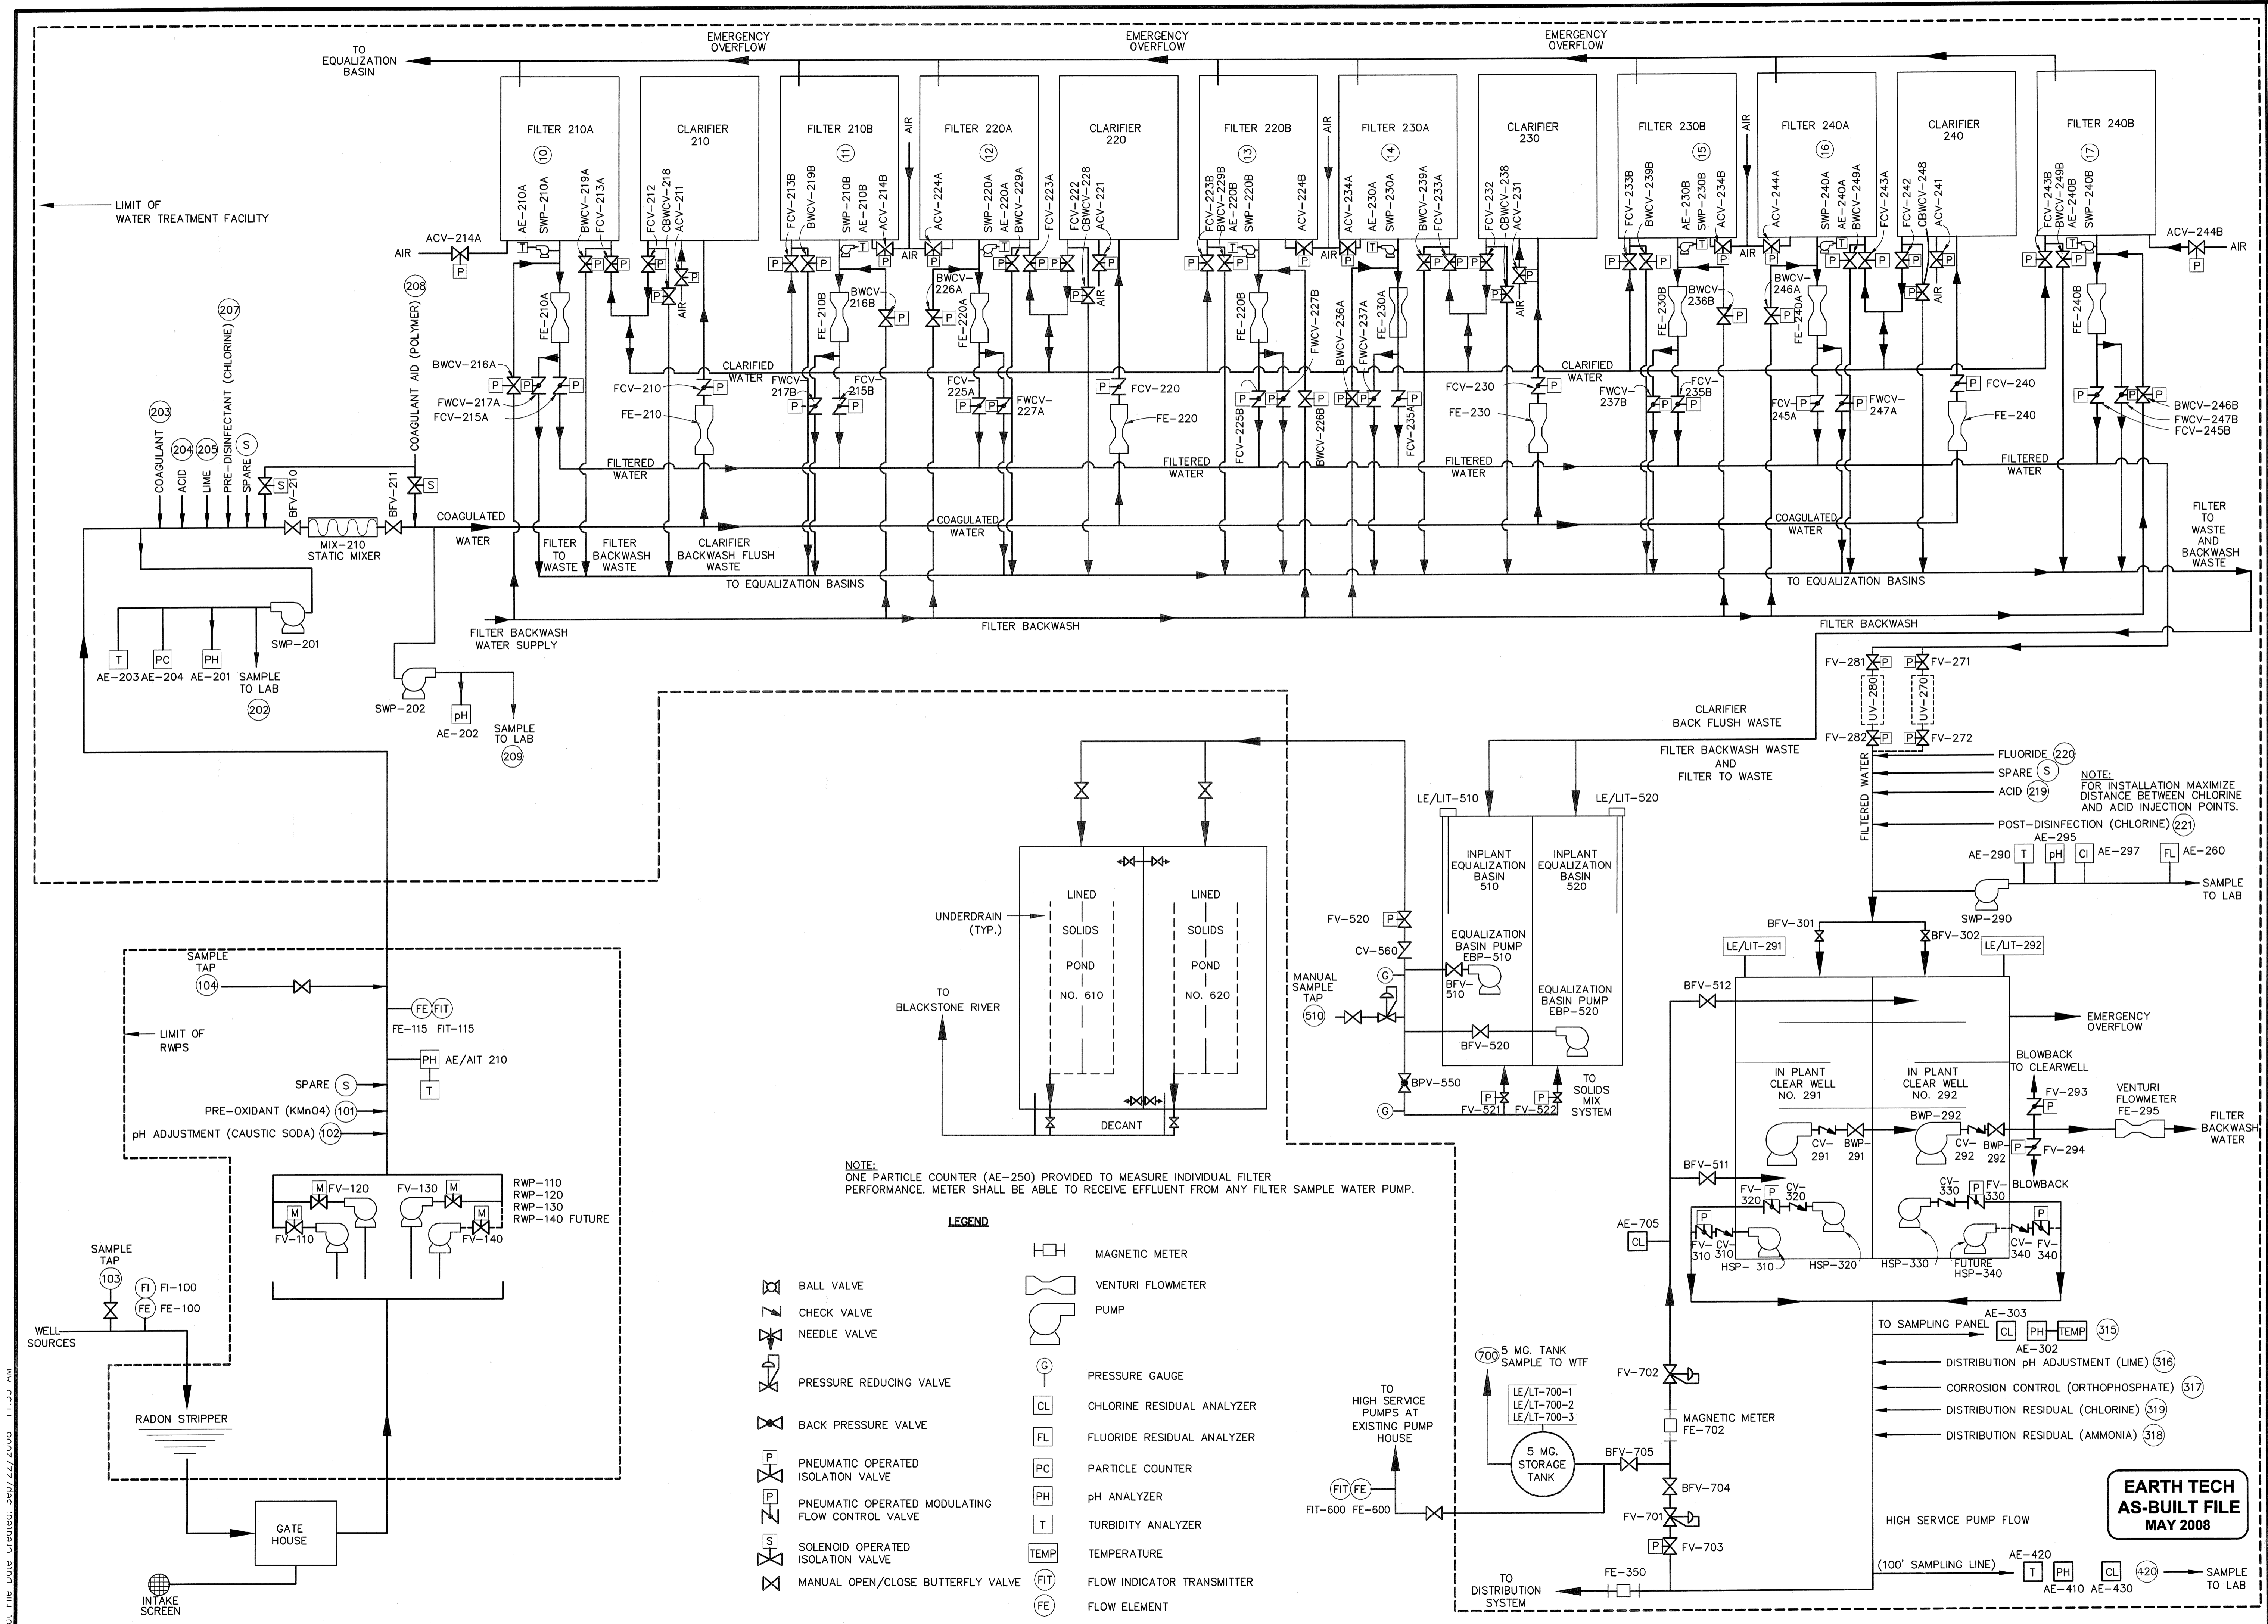

NOTE: ONE PARTICLE COUNTER (AE-250) PROVIDED TO MEASURE INDIVIDUAL FILTER PERFORMANCE. METER SHALL BE ABLE TO RECEIVE EFFLUENT FROM ANY FILTER SAMPLE WATER PUMP.

LEGEND

- BALL VALVE
- CHECK VALVE
- NEEDLE VALVE
- PRESSURE REDUCING VALVE
- BACK PRESSURE VALVE
- PNEUMATIC OPERATED ISOLATION VALVE
- PNEUMATIC OPERATED MODULATING FLOW CONTROL VALVE
- SOLENOID OPERATED ISOLATION VALVE
- MANUAL OPEN/CLOSE BUTTERFLY VALVE
- MAGNETIC METER
- VENTURI FLOWMETER
- PUMP
- PRESSURE GAUGE
- CHLORINE RESIDUAL ANALYZER
- FLUORIDE RESIDUAL ANALYZER
- pH ANALYZER
- TURBIDITY ANALYZER
- TEMPERATURE
- FLOW INDICATOR TRANSMITTER
- FLOW ELEMENT

EarthTech
A Tyco International Ltd. Company

300 BAKER AVENUE SUITE 290 CONCORD MA 01742 (978) 371-6000

FULL SIZE DRAWING = 4"	
AS-BUILT DRAWING FILE	DATE: 10/31/08
ISSUED FOR RFI POSTED SET	A.R. 10/29/05
ISSUED FOR CONSTRUCTION	A.R. 9/16/05
REV. B AGENCY REVIEW	A.R. 7/22/05
REV. A CLIENT REVIEW	DATE
BY	NO.


PAWTUCKET, RHODE ISLAND
PAWTUCKET REGIONAL WATER TREATMENT FACILITY
PKGS 11 & 12 - RAW WATER PUMP STATION
PROCESS SCHEMATIC

DESIGNED BY	DWG SCALE
DRAWN BY	NONE
CHECKED BY	CONTRACT NO.
	DATE
	OCTOBER 31, 2008

EARTH TECH
AS-BUILT FILE
MAY 2008




G-2
SHEET OF

EXISTING

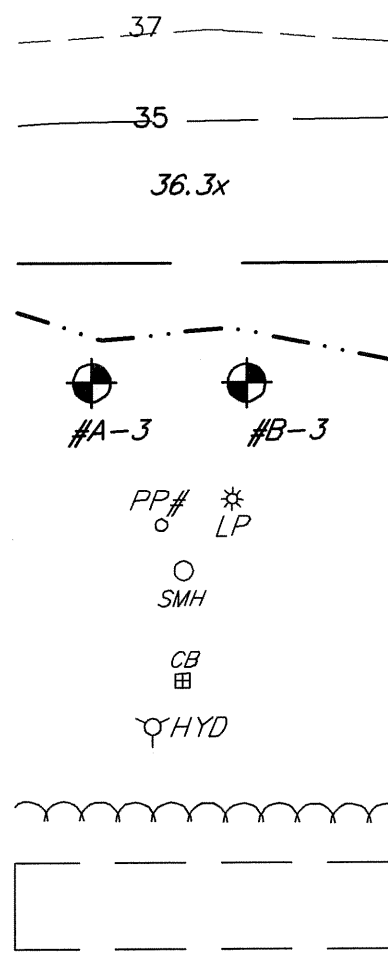

GENERAL LEGEND

PROPOSED

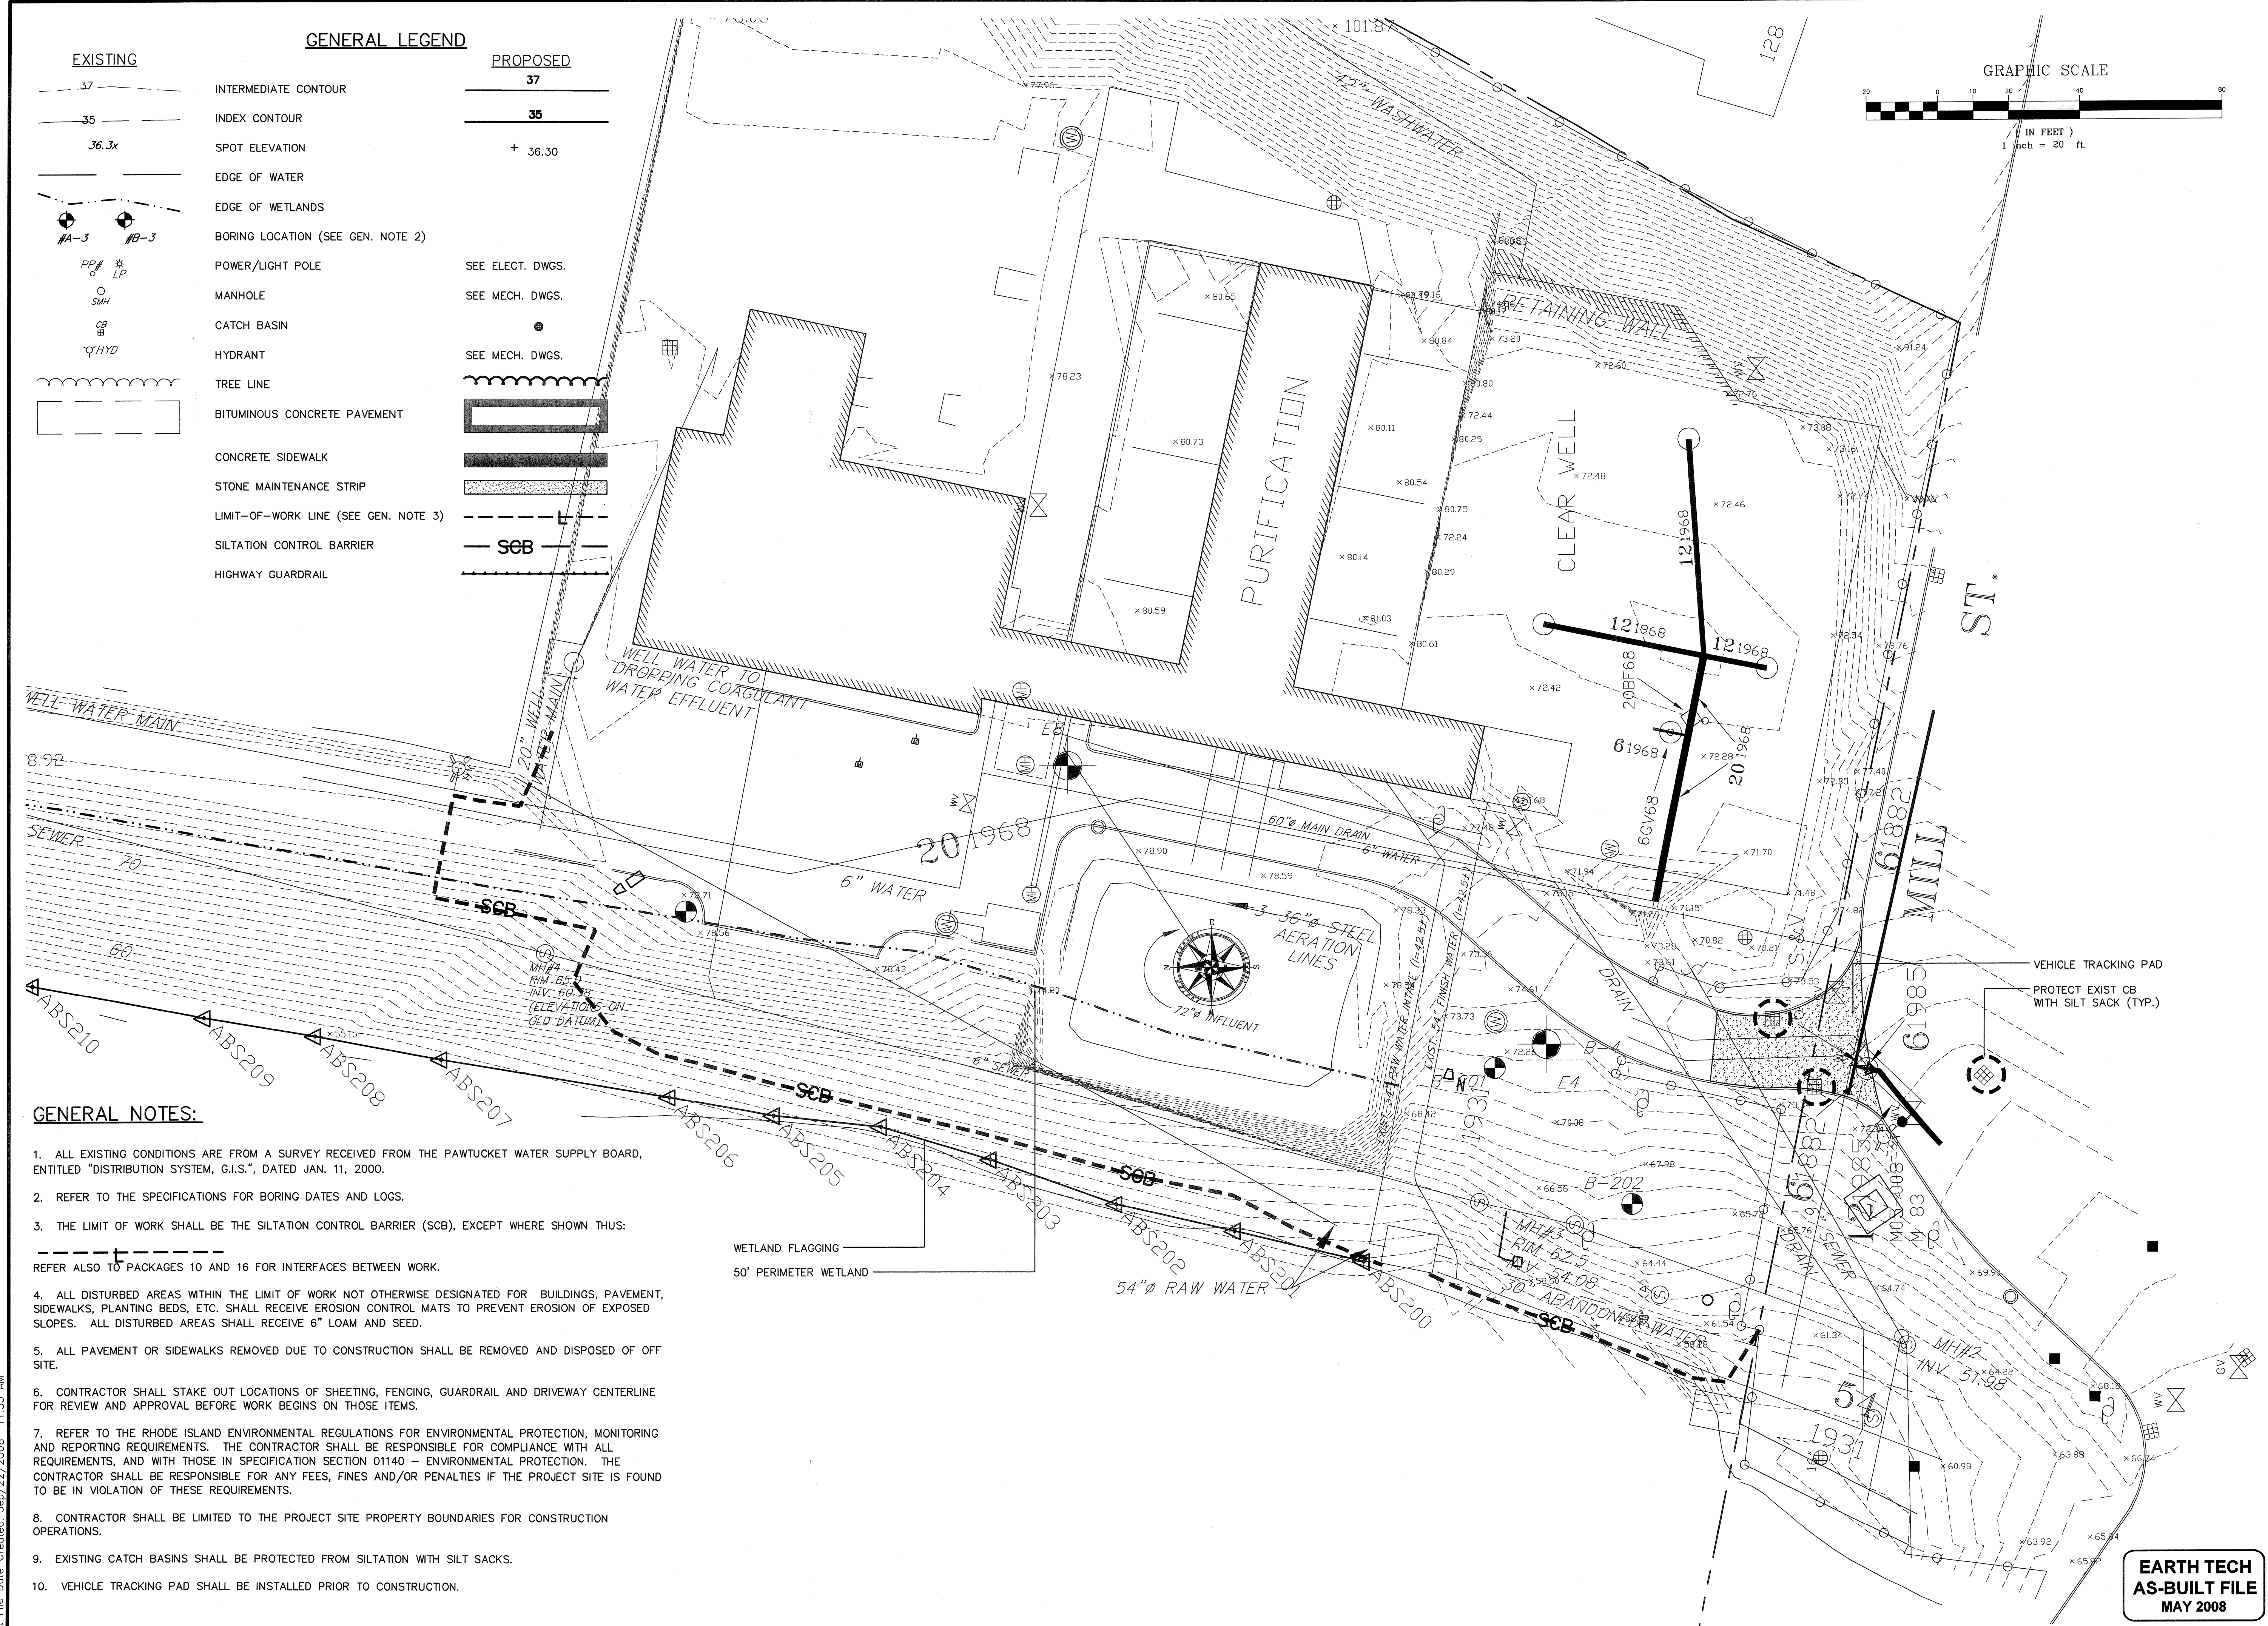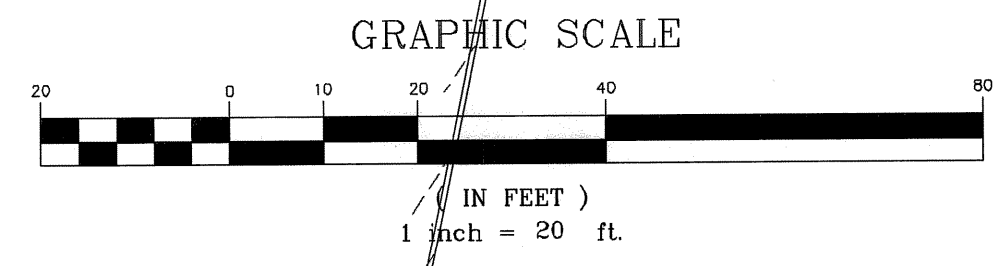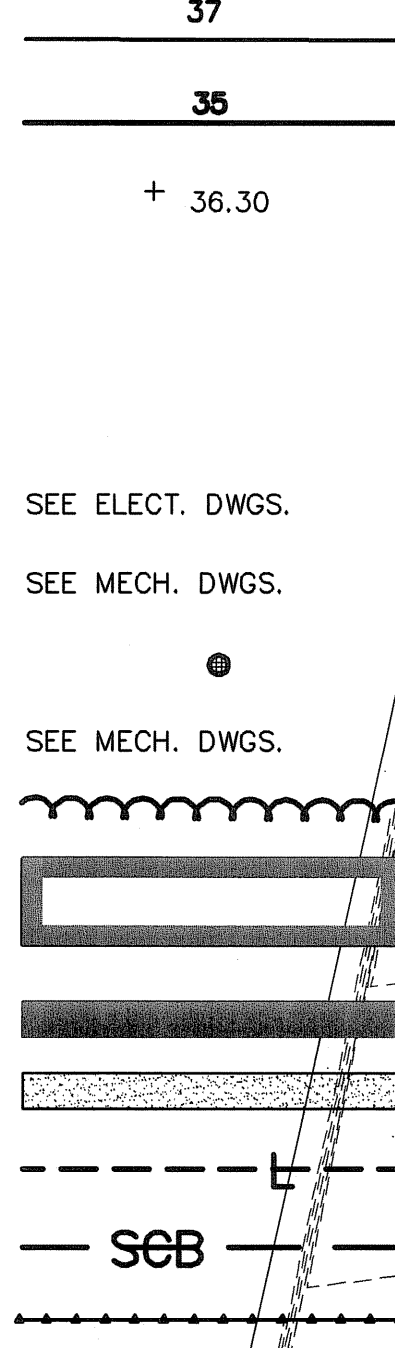

GENERAL NOTES:

1. ALL EXISTING CONDITIONS ARE FROM A SURVEY RECEIVED FROM THE PAWTUCKET WATER SUPPLY BOARD, ENTITLED "DISTRIBUTION SYSTEM, G.I.S.", DATED JAN. 11, 2000.
2. REFER TO THE SPECIFICATIONS FOR BORING DATES AND LOGS.
3. THE LIMIT OF WORK SHALL BE THE SILTATION CONTROL BARRIER (SCB), EXCEPT WHERE SHOWN THUS:
REFER ALSO TO PACKAGES 10 AND 16 FOR INTERFACES BETWEEN WORK.
4. ALL DISTURBED AREAS WITHIN THE LIMIT OF WORK NOT OTHERWISE DESIGNATED FOR BUILDINGS, PAVEMENT, SIDEWALKS, PLANTING BEDS, ETC. SHALL RECEIVE EROSION CONTROL MATS TO PREVENT EROSION OF EXPOSED SLOPES. ALL DISTURBED AREAS SHALL RECEIVE 6" LOAM AND SEED.
5. ALL PAVEMENT OR SIDEWALKS REMOVED DUE TO CONSTRUCTION SHALL BE REMOVED AND DISPOSED OF OFF SITE.
6. CONTRACTOR SHALL STAKE OUT LOCATIONS OF SHEETING, FENCING, GUARDRAIL AND DRIVEWAY CENTERLINE FOR REVIEW AND APPROVAL BEFORE WORK BEGINS ON THOSE ITEMS.
7. REFER TO THE RHODE ISLAND ENVIRONMENTAL REGULATIONS FOR ENVIRONMENTAL PROTECTION, MONITORING AND REPORTING REQUIREMENTS. THE CONTRACTOR SHALL BE RESPONSIBLE FOR COMPLIANCE WITH ALL REQUIREMENTS, AND WITH THOSE IN SPECIFICATION SECTION 01140 - ENVIRONMENTAL PROTECTION. THE CONTRACTOR SHALL BE RESPONSIBLE FOR ANY FEES, FINES AND/OR PENALTIES IF THE PROJECT SITE IS FOUND TO BE IN VIOLATION OF THESE REQUIREMENTS.
8. CONTRACTOR SHALL BE LIMITED TO THE PROJECT SITE PROPERTY BOUNDARIES FOR CONSTRUCTION OPERATIONS.
9. EXISTING CATCH BASINS SHALL BE PROTECTED FROM SILTATION WITH SILT SACKS.
10. VEHICLE TRACKING PAD SHALL BE INSTALLED PRIOR TO CONSTRUCTION.

WETLAND FLAGGING
50' PERIMETER WETLAND

NO.	REVISIONS	DATE	BY
2	AS-BUILT DRAWING FILE	MAY 2008	DRB
1	ISSUED FOR RT POSTED SET	10/21/08	
0	ISSUED FOR CONSTRUCTION	10/28/05	
B	REV. B AGENCY REVIEW	8/16/05	
A	REV. A CLIENT REVIEW	7/22/05	

ROBERT H. SHELDON
No. 4103
[Signature]



PAWTUCKET, RHODE ISLAND
**PAWTUCKET REGIONAL
WATER TREATMENT FACILITY**
PKGS 11 & 12 - RAW WATER PUMP STATION
MILL ST RAW WATER PUMP STATION
EXISTING CONDITIONS PLAN

DESIGNED BY	DWG SCALE AS NOTED
DRAWN BY	CONTRACT NO
CHECKED BY	DATE
	OCTOBER 31, 2008

EARTH TECH
AS-BUILT FILE
MAY 2008

Filename: L:\WORK\68993\CAD\AS-BUILT\11-12 RWTP\SITE\68993 - MILL ST RWPS - SITEPLAN.DWG
Plot File Date Created: Sep/22/2008 11:33 AM

Filename: L:\WORK\69993\CAD\AS-BUILT\11-12 RWTP\SITE\69993 - MILL ST RWPS - SITEPLAN.DWG
 Plot File Date Created: Sep/22/2008 11:33 AM

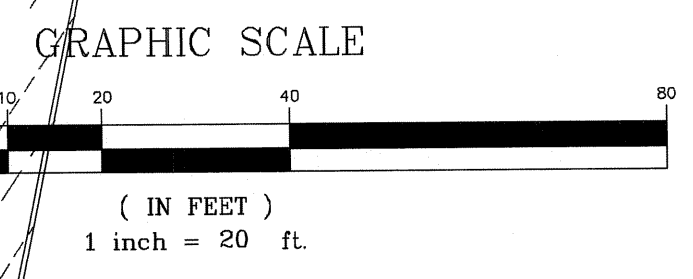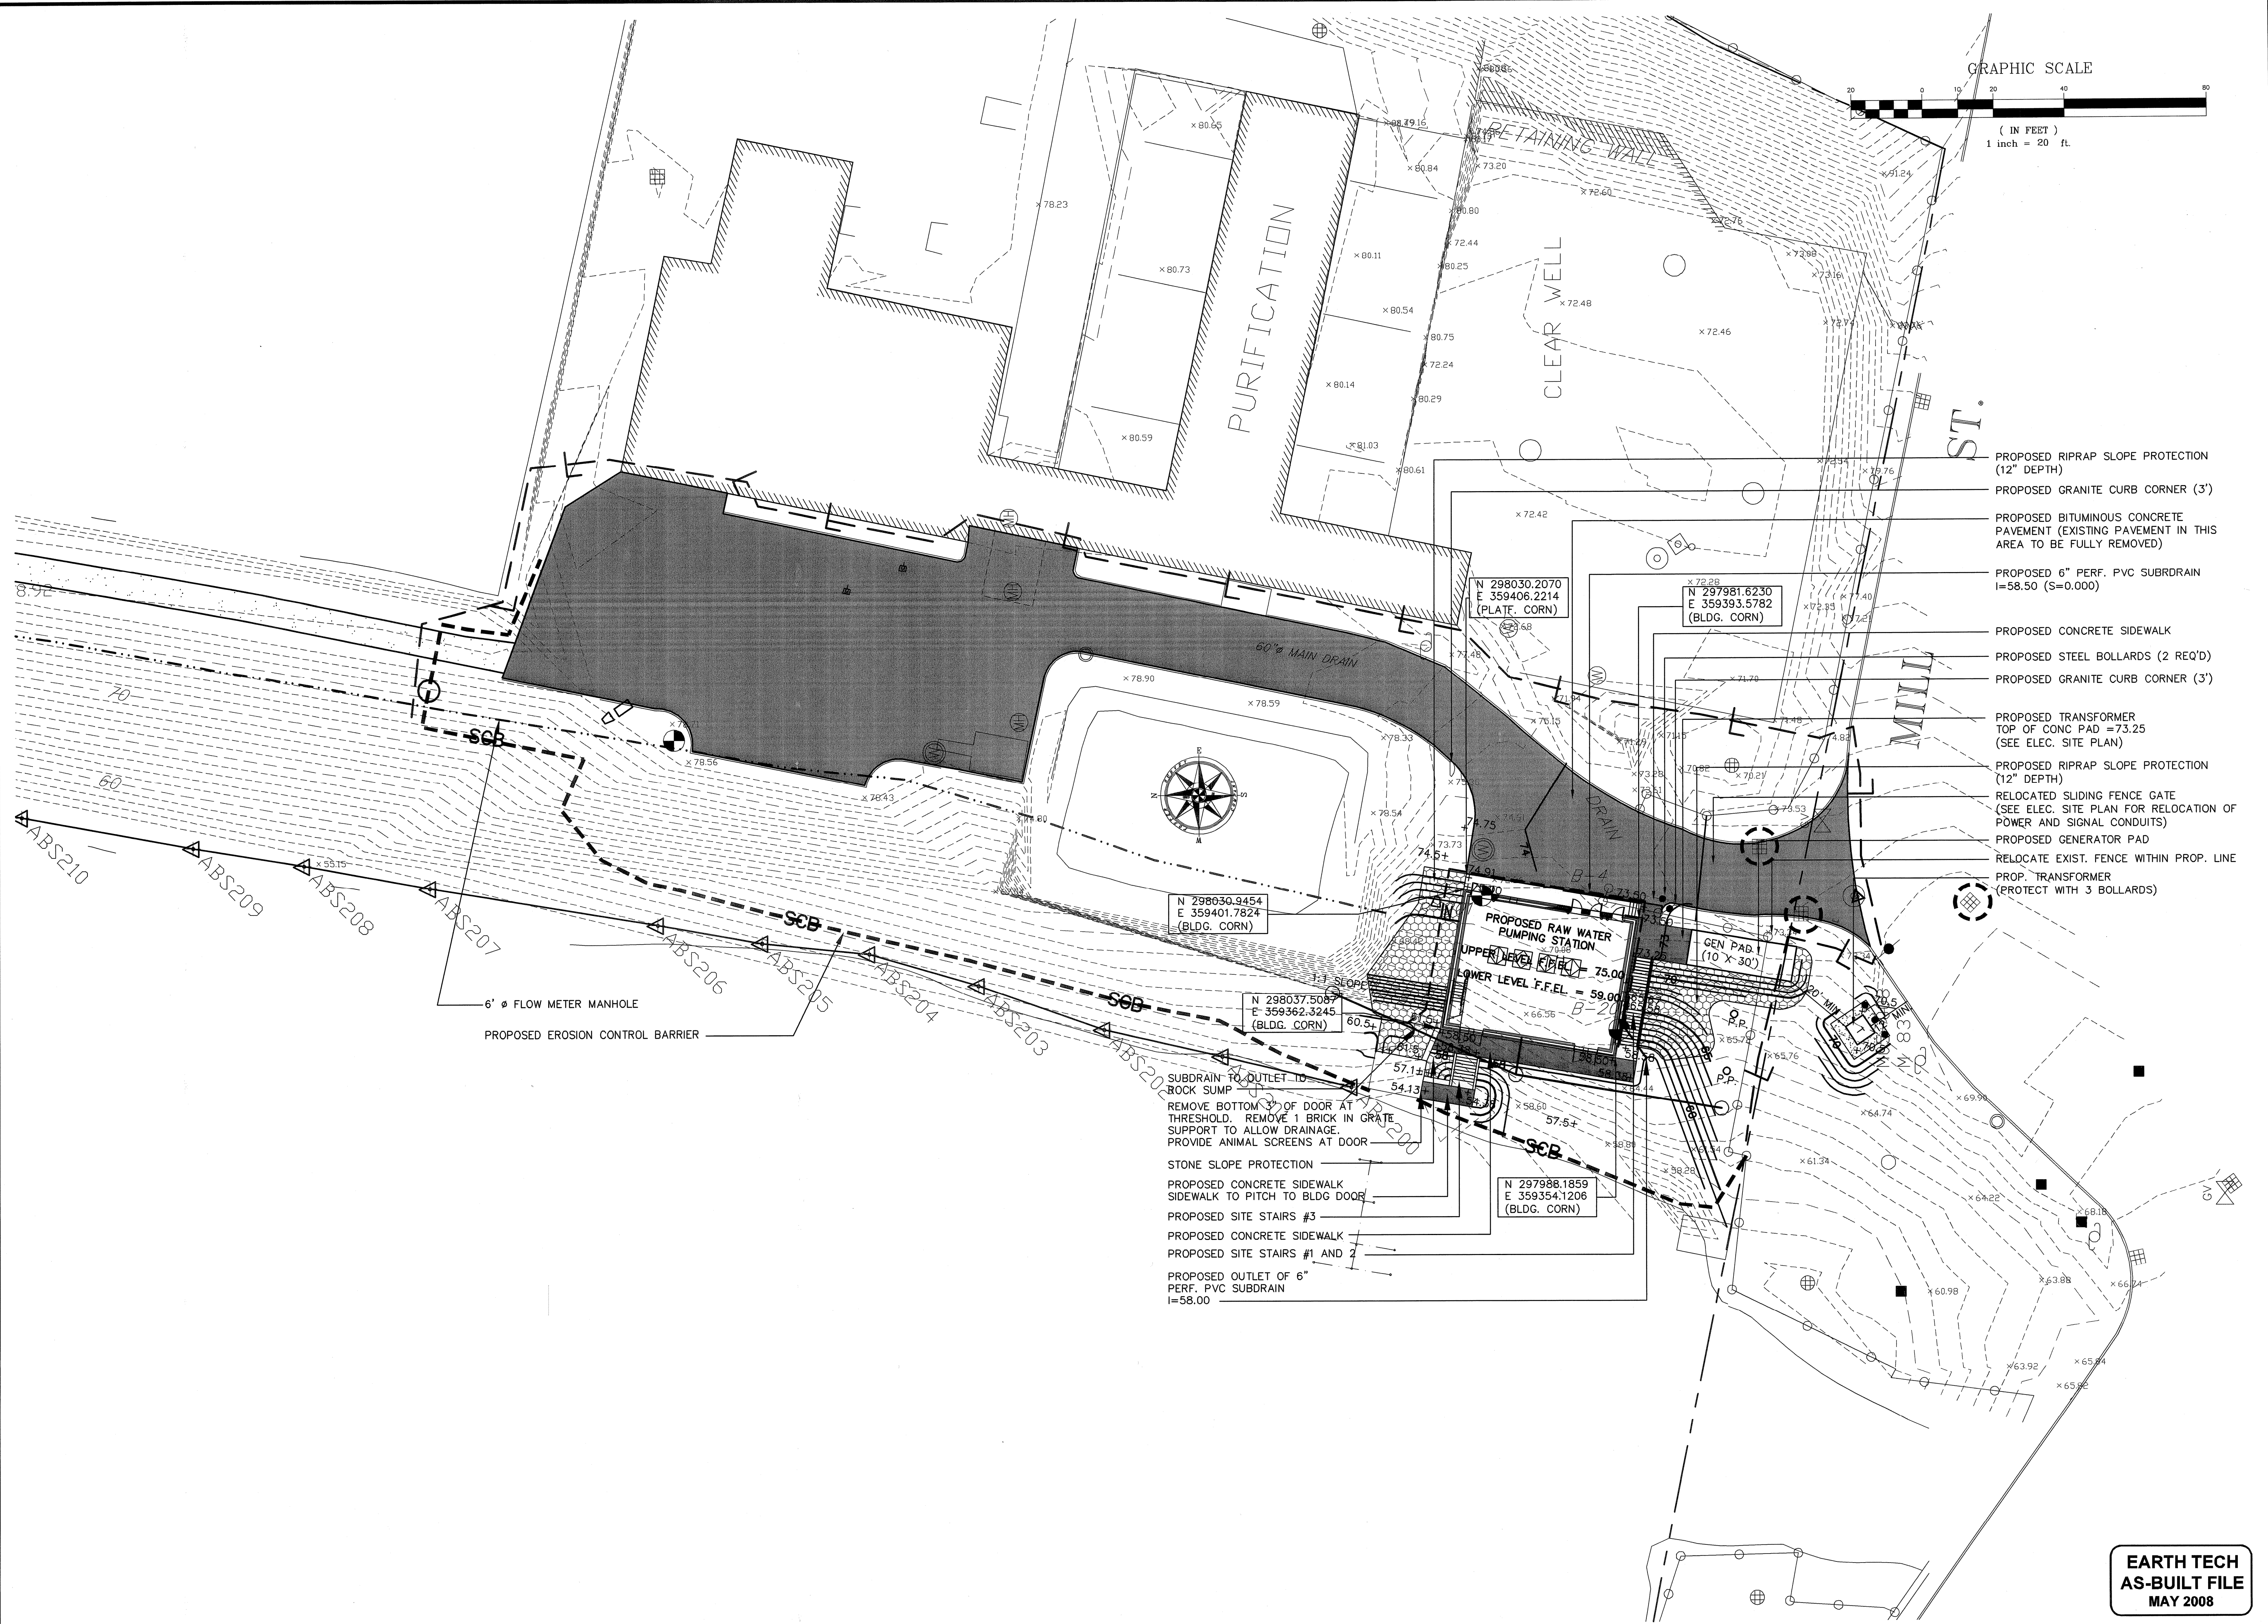

NO.	REVISIONS	DATE	BY
1	ISSUED FOR RFI POSTED SET	10/21/08	
2	ISSUED FOR CONSTRUCTION	10/28/08	
3	REV. B AGENCY REVIEW	8/16/05	
4	REV. A CLIENT REVIEW	7/22/05	

ROBERT H. SHELDON
 No. 0103
 PROFESSIONAL ENGINEER
 STATE OF MASSACHUSETTS

- PROPOSED RIPRAP SLOPE PROTECTION (12" DEPTH)
- PROPOSED GRANITE CURB CORNER (3')
- PROPOSED BITUMINOUS CONCRETE PAVEMENT (EXISTING PAVEMENT IN THIS AREA TO BE FULLY REMOVED)
- PROPOSED 6" PERF. PVC SUBDRAIN I=58.50 (S=0.000)
- PROPOSED CONCRETE SIDEWALK
- PROPOSED STEEL BOLLARDS (2 REQ'D)
- PROPOSED GRANITE CURB CORNER (3')
- PROPOSED TRANSFORMER TOP OF CONC PAD = 73.25 (SEE ELEC. SITE PLAN)
- PROPOSED RIPRAP SLOPE PROTECTION (12" DEPTH)
- RELOCATED SLIDING FENCE GATE (SEE ELEC. SITE PLAN FOR RELOCATION OF POWER AND SIGNAL CONDUITS)
- PROPOSED GENERATOR PAD
- RELOCATE EXIST. FENCE WITHIN PROP. LINE PROP. TRANSFORMER (PROTECT WITH 3 BOLLARDS)




- SUBDRAIN TO OUTLET TO ROCK SUMP
- REMOVE BOTTOM 3" OF DOOR AT THRESHOLD. REMOVE 1 BRICK IN GRATE SUPPORT TO ALLOW DRAINAGE. PROVIDE ANIMAL SCREENS AT DOOR
- STONE SLOPE PROTECTION
- PROPOSED CONCRETE SIDEWALK SIDEWALK TO PITCH TO BLDG DOOR
- PROPOSED SITE STAIRS #3
- PROPOSED CONCRETE SIDEWALK
- PROPOSED SITE STAIRS #1 AND 2
- PROPOSED OUTLET OF 6" PERF. PVC SUBDRAIN I=58.00

PAWTUCKET, RHODE ISLAND
PAWTUCKET REGIONAL WATER TREATMENT FACILITY
PKGS 11 & 12 - RAW WATER PUMP STATION
 MILL ST RAW WATER PUMP STATION
PROPOSED SITE PLAN



DESIGNED BY	DWG SCALE AS NOTED
DRAWN BY	CONTRACT NO.
CHECKED BY	DATE OCTOBER 31, 2008

EARTH TECH
AS-BUILT FILE
 MAY 2008



Filename: L:\WORK\69993\CAD\AS-BUILT\11-12\RWTF\SITE\69993 - MILL ST RWFS - SITEPLAN.DWG
 Plot File Date Created: Sep/22/2008 11:33 AM

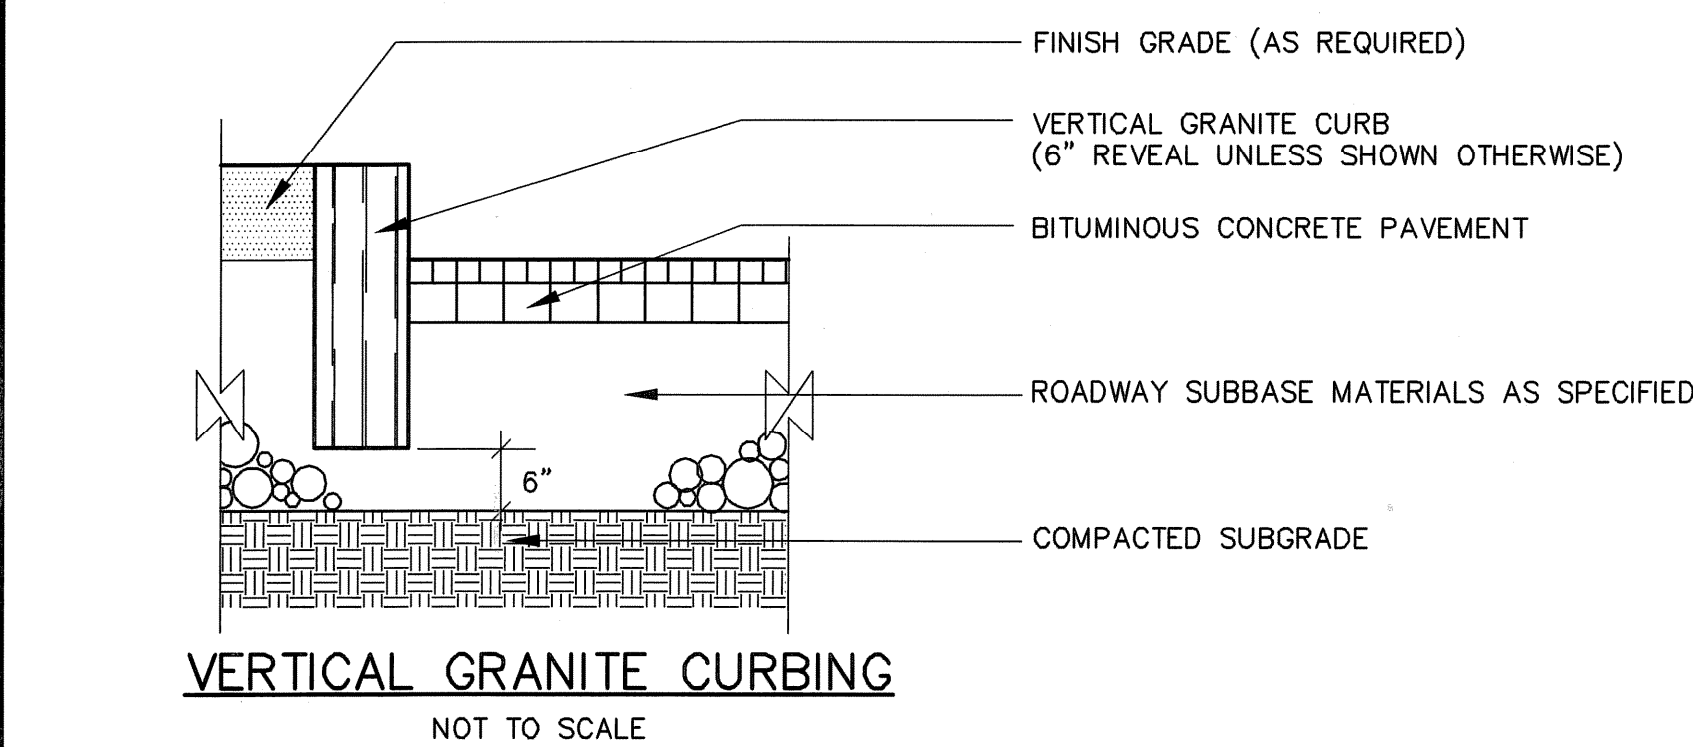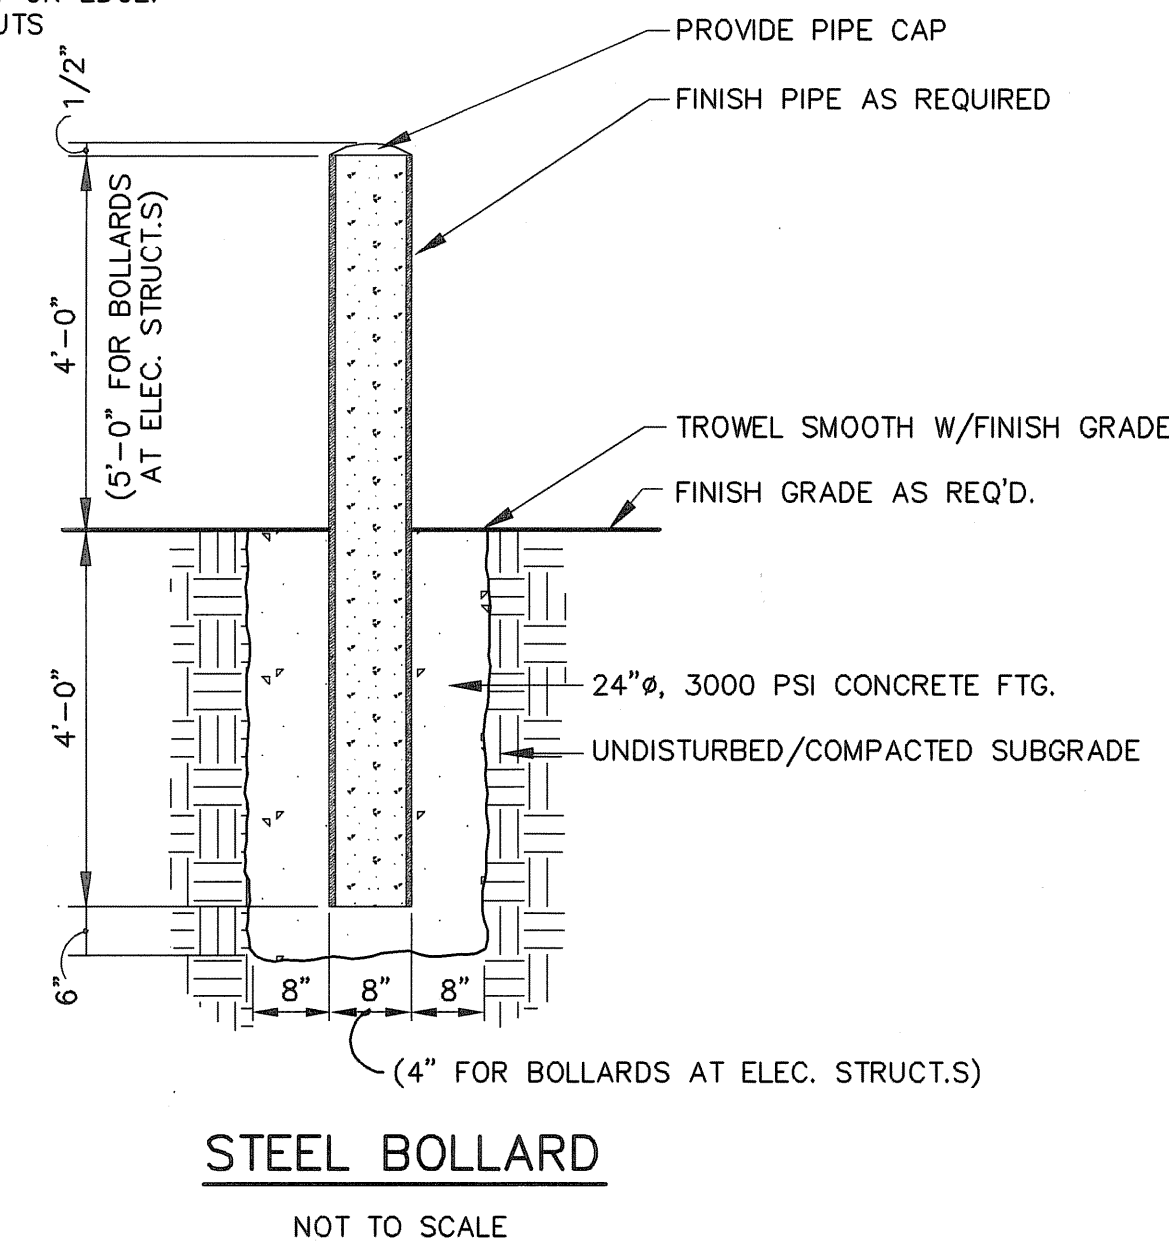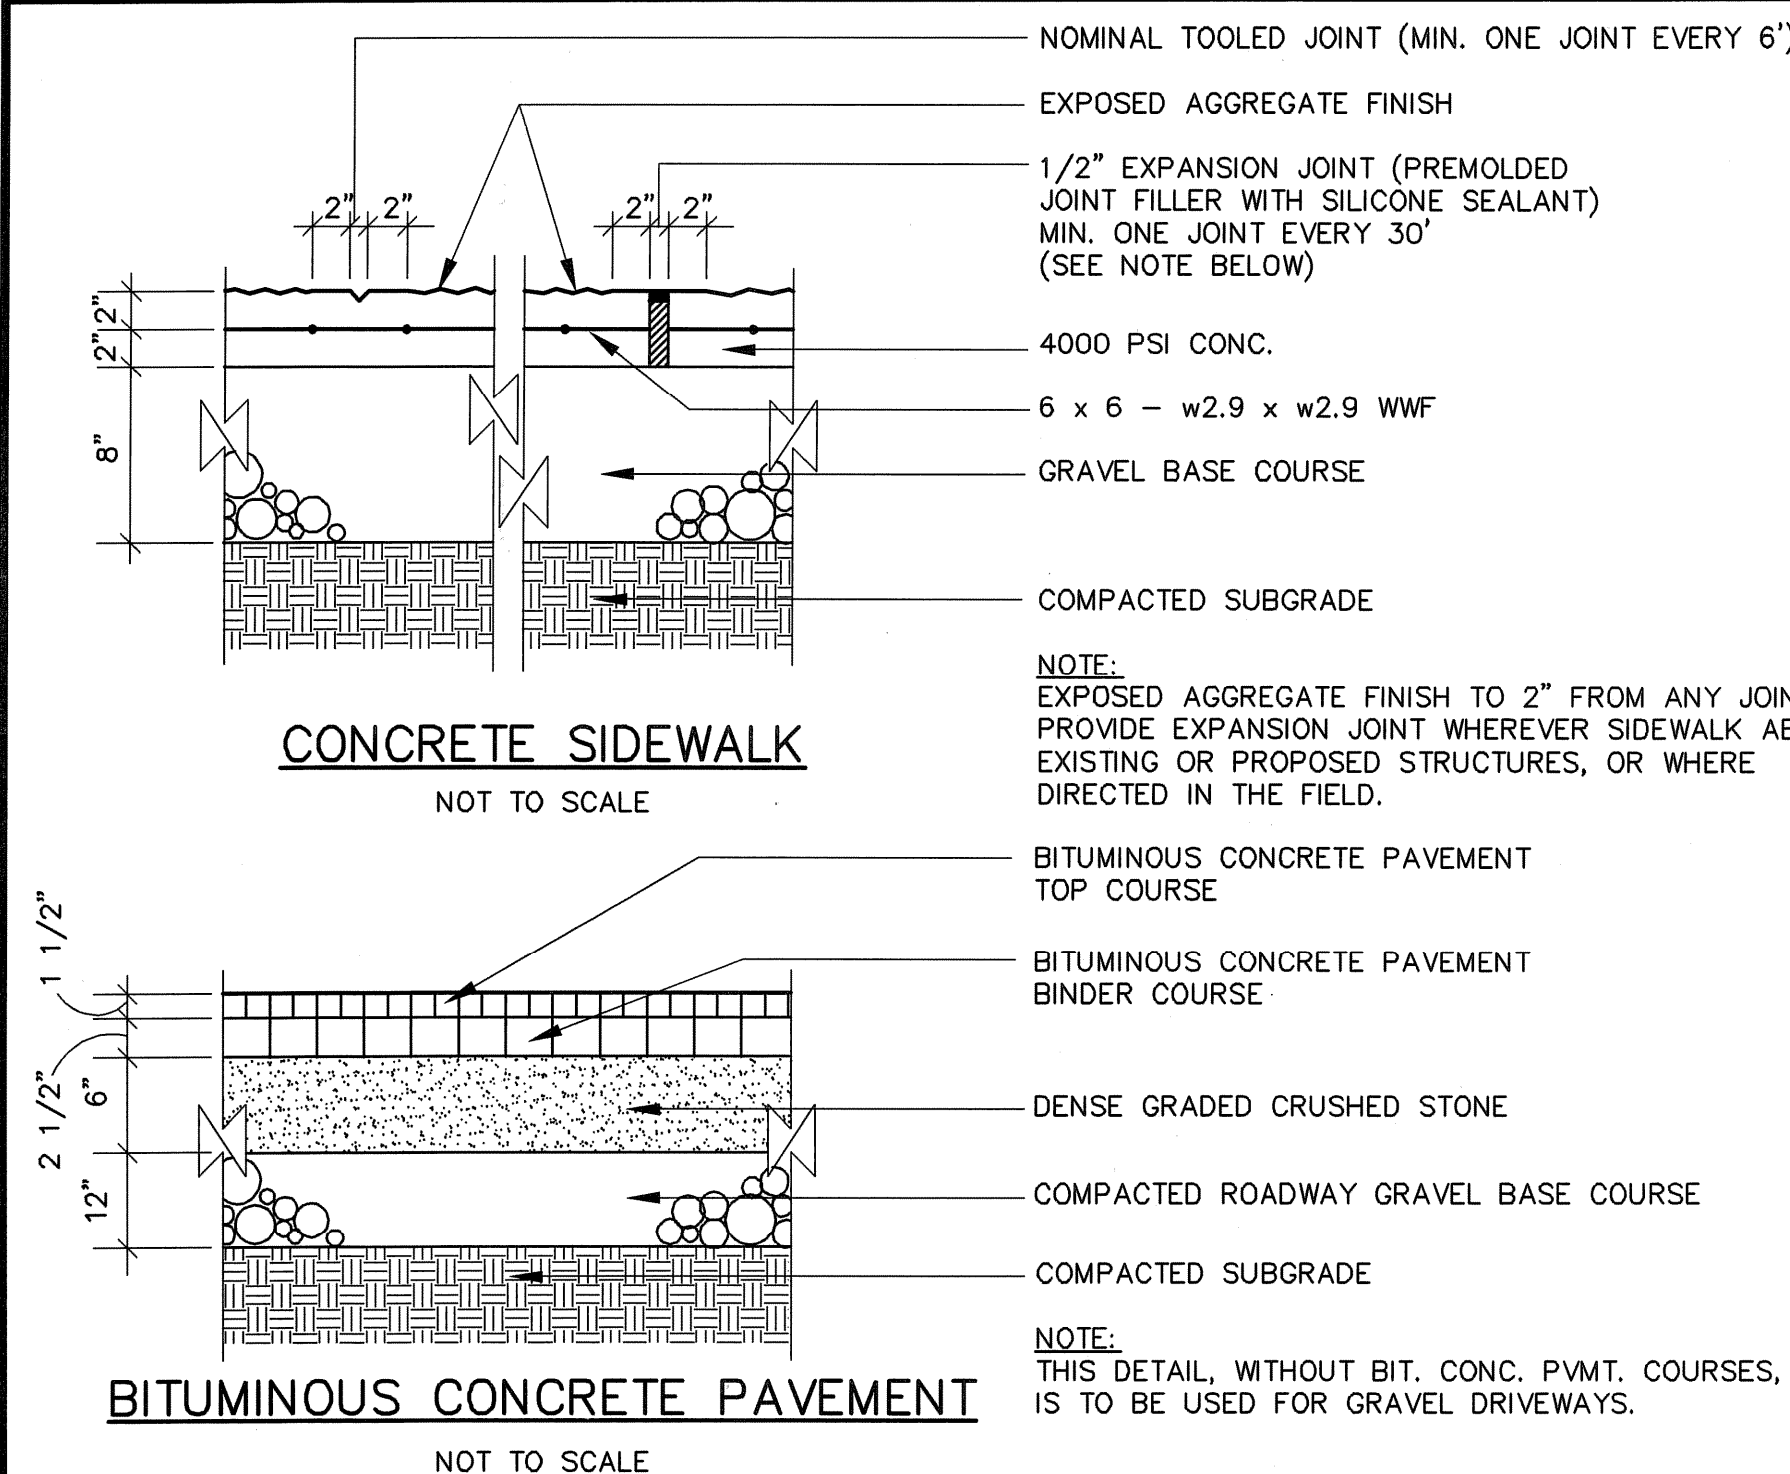



SITE STAIRWAY SCHEDULE								
STAIRWAY	"A"	"B"	"C"	"D"	"E"	"F"	B.S. ELEV.	T.S. ELEV.
1	7"	11"	6'-0"	7'-0"	11'-0"	8"	58.58	65.58
2	7"	11"	6'-0"	7'-7"	11'-11"	8"	65.67	73.25
3	6"	11"	6'-0"	1'-9"	7'-4"	8"	54.38	58.38

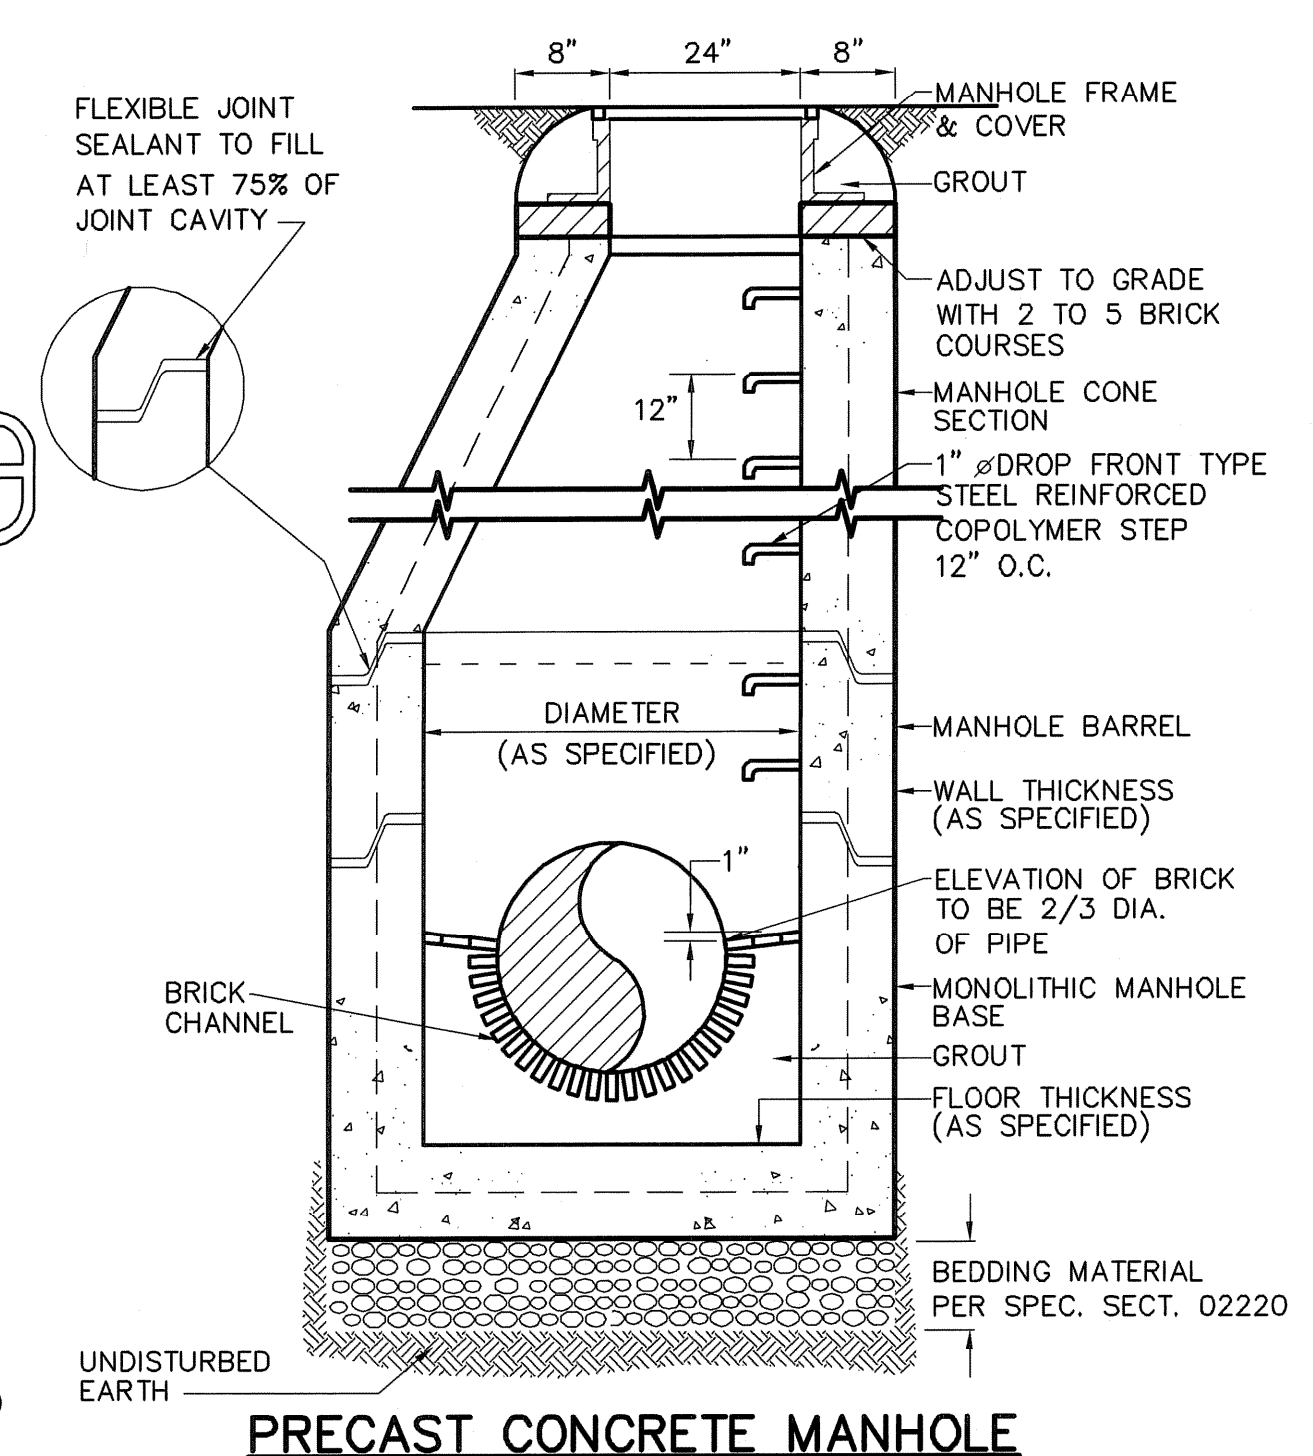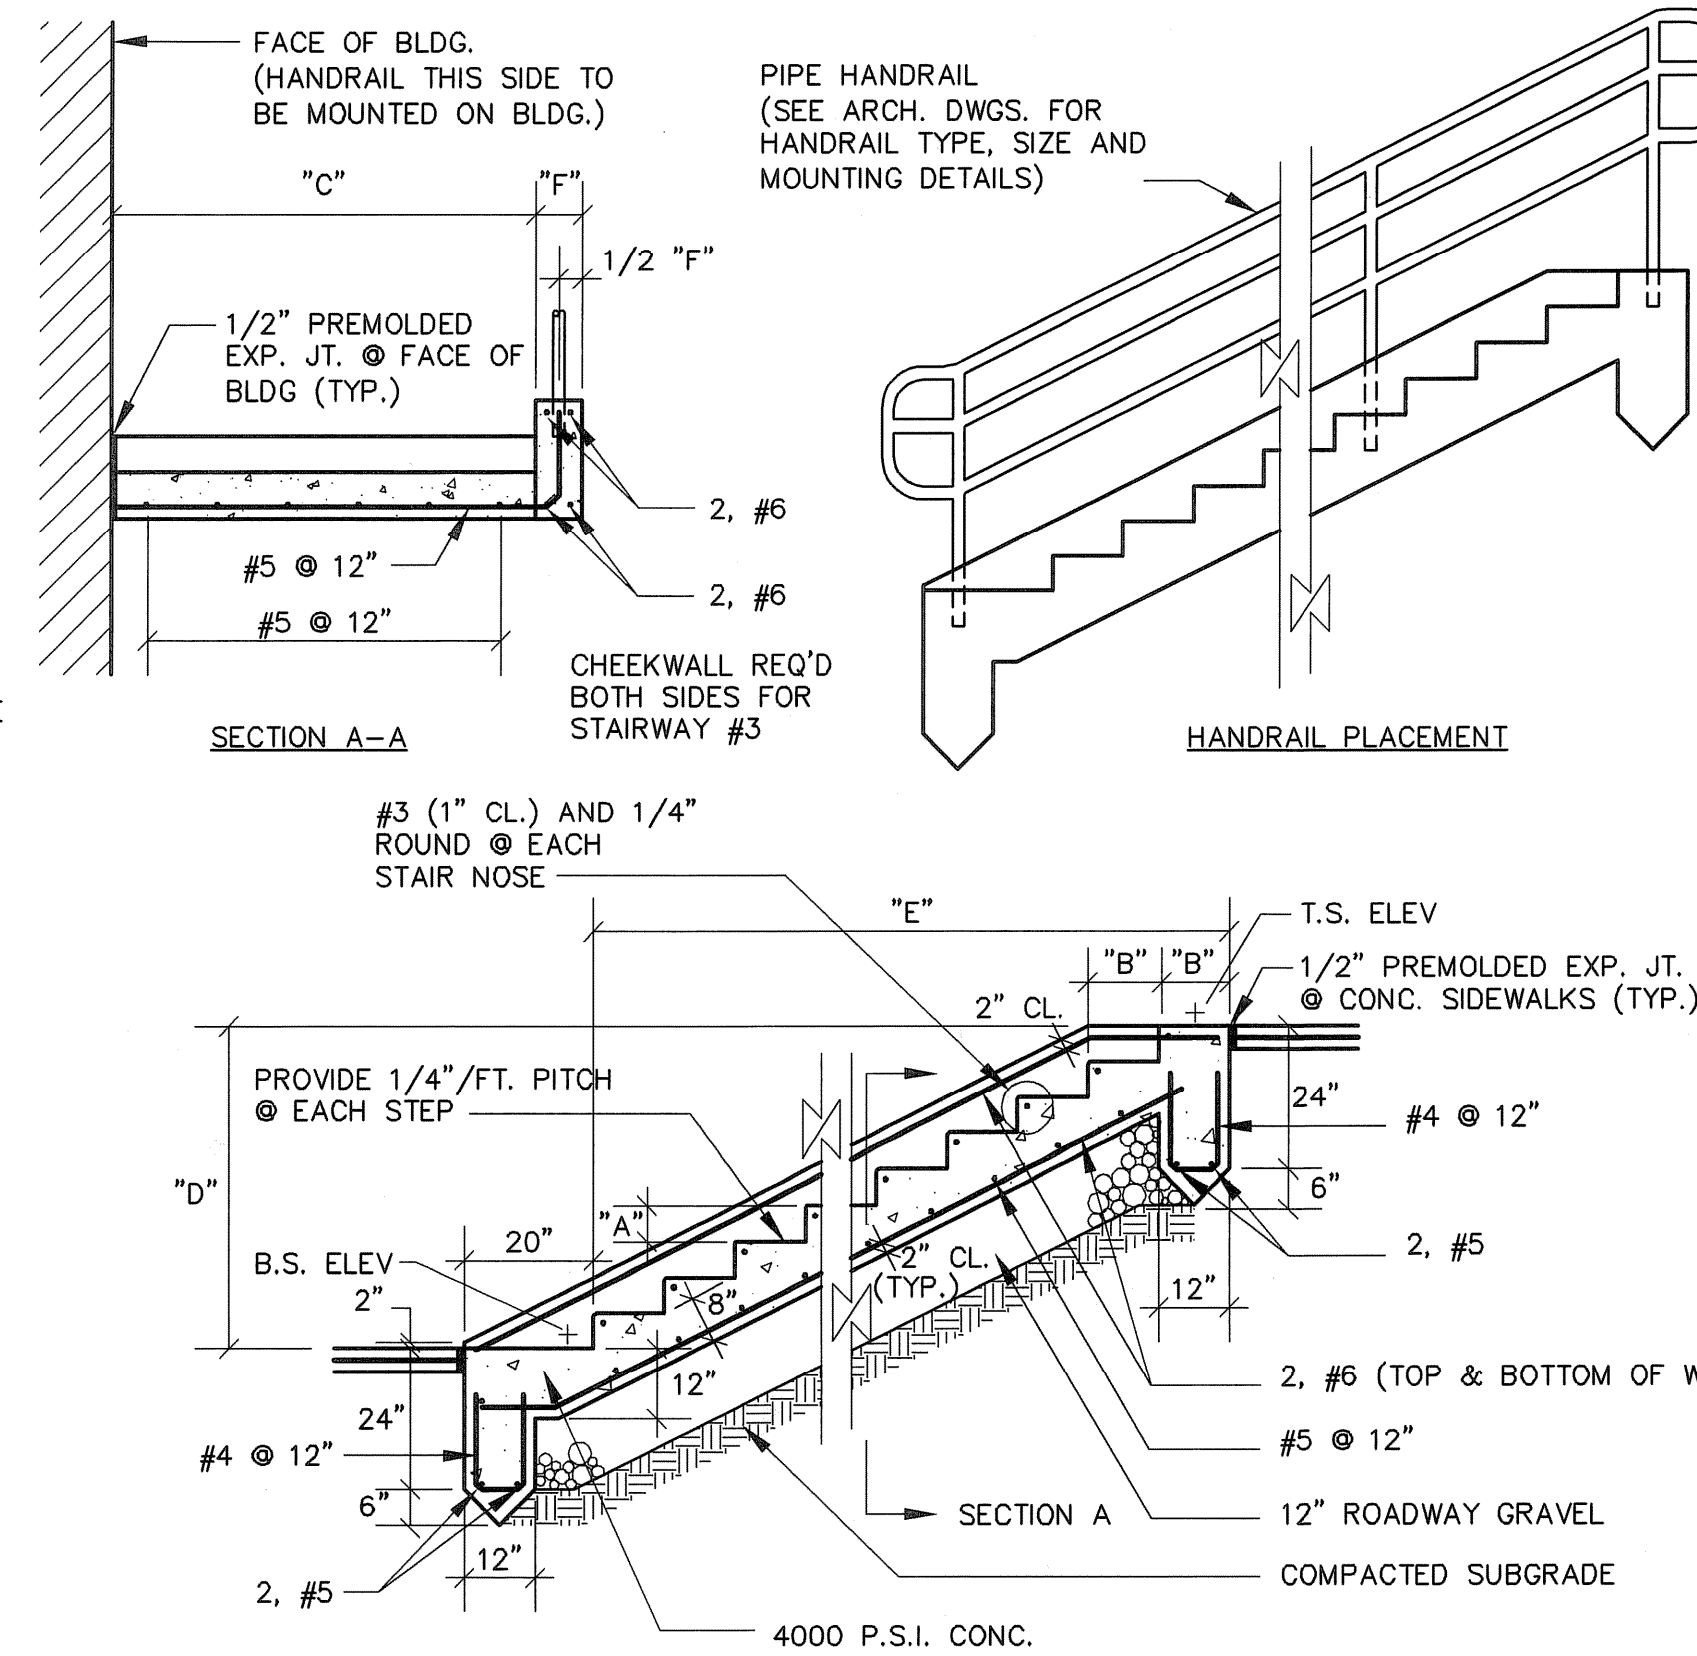

DIAMETER	WALL THICKNESS	FLOOR THICKNESS
4 FT.	5 IN.	6 IN.
5 FT.	6 IN.	7 IN.
6 FT.	7 IN.	8 IN.

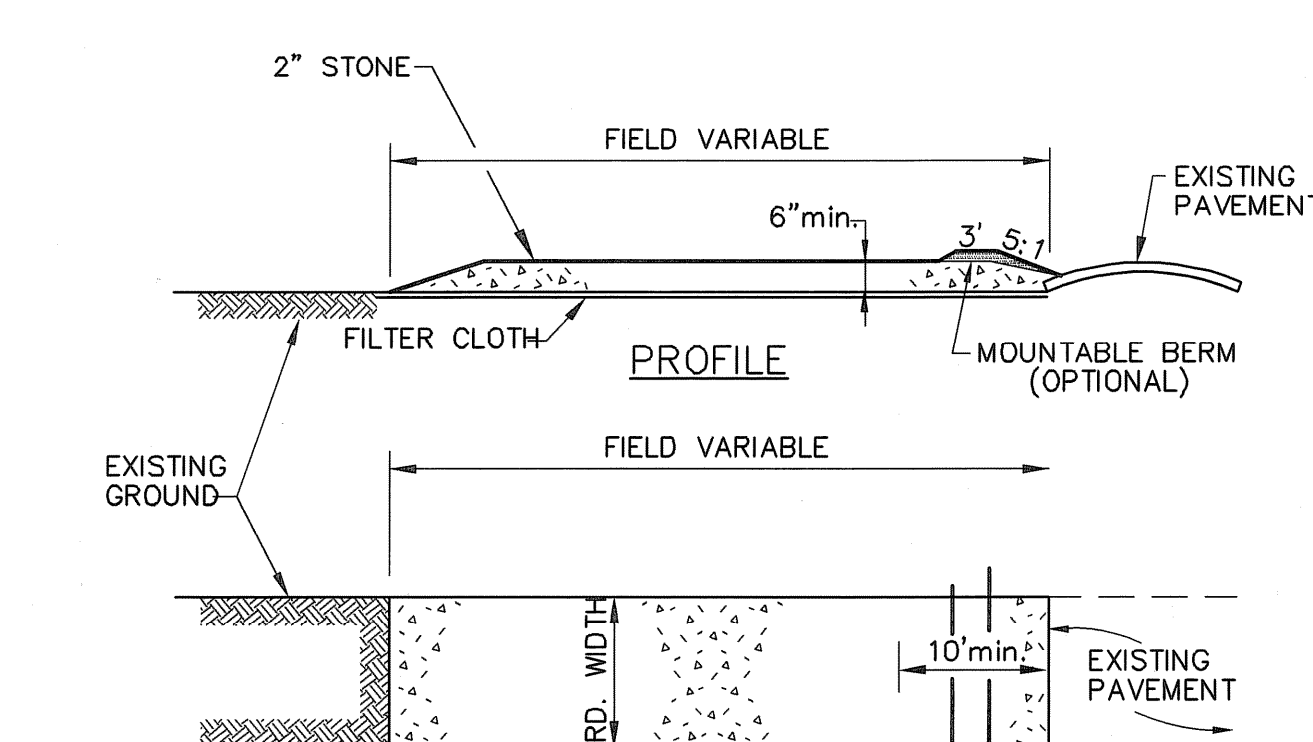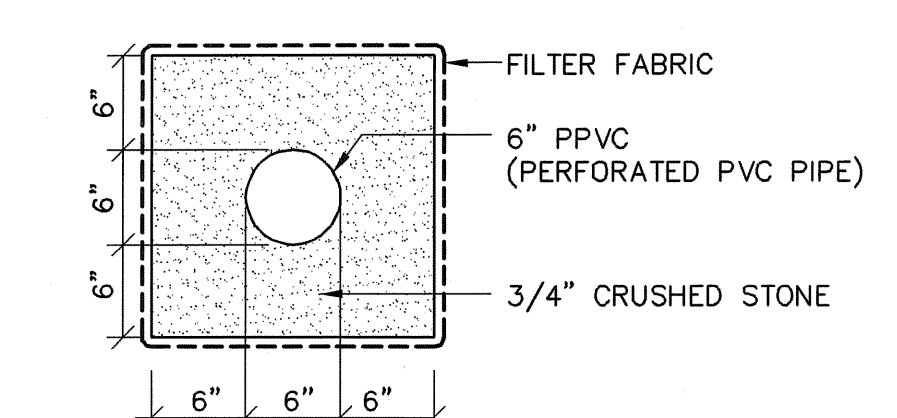

- CONSTRUCTION SPECIFICATIONS:**
- STONE SIZE: USE 2" DIAMETER STONE OR RECLAIMED/RECYCLED CONCRETE EQUIVALENT.
 - LENGTH: RECOMMEND GREATER THAN 50 FEET WHERE PRACTICAL.
 - THICKNESS: NOT LESS THAN 6 INCHES.
 - WIDTH: 10 FEET MINIMUM, BUT NOT LESS THAN THE FULL WIDTH AT POINTS WHERE INGRESS OR EGRESS OCCUR.
 - FILTER CLOTH: SHALL BE PLACED OVER THE ENTIRE AREA PRIOR TO THE PLACING OF STONE.
 - SURFACE WATER: ALL SURFACE WATER FLOWING OR DIVERTED TOWARD CONSTRUCTION ENTRANCES SHALL BE PIPED ACROSS THE ENTRANCE. IF PIPING IS IMPRACTICAL, A MOUNTABLE BERM WILL BE PERMITTED.
 - MAINTENANCE: THE ENTRANCE SHALL BE MAINTAINED IN A CONDITION THAT WILL PREVENT TRACKING OR FLOWING OF SEDIMENT ONTO PUBLIC RIGHT-OF-WAY. THIS MAY REQUIRE PERIODIC TOP DRESSING WITH ADDITIONAL STONE AS CONDITIONS DEMAND AND REPAIR AND/OR CLEANOUT OF ANY MEASURES USED TO TRAP SEDIMENT. ALL SEDIMENT SPILLED, DROPPED, WASHED, OR TRACKED ONTO PUBLIC RIGHT-OF-WAY MUST BE REMOVED IMMEDIATELY.
 - PERIODIC INSPECTION AND NEEDED MAINTENANCE SHALL BE PROVIDED.
 - REMOVE STABILIZED CONSTRUCTION ENTRANCE PRIOR TO PLACEMENT OF BITUMINOUS BASE COURSE

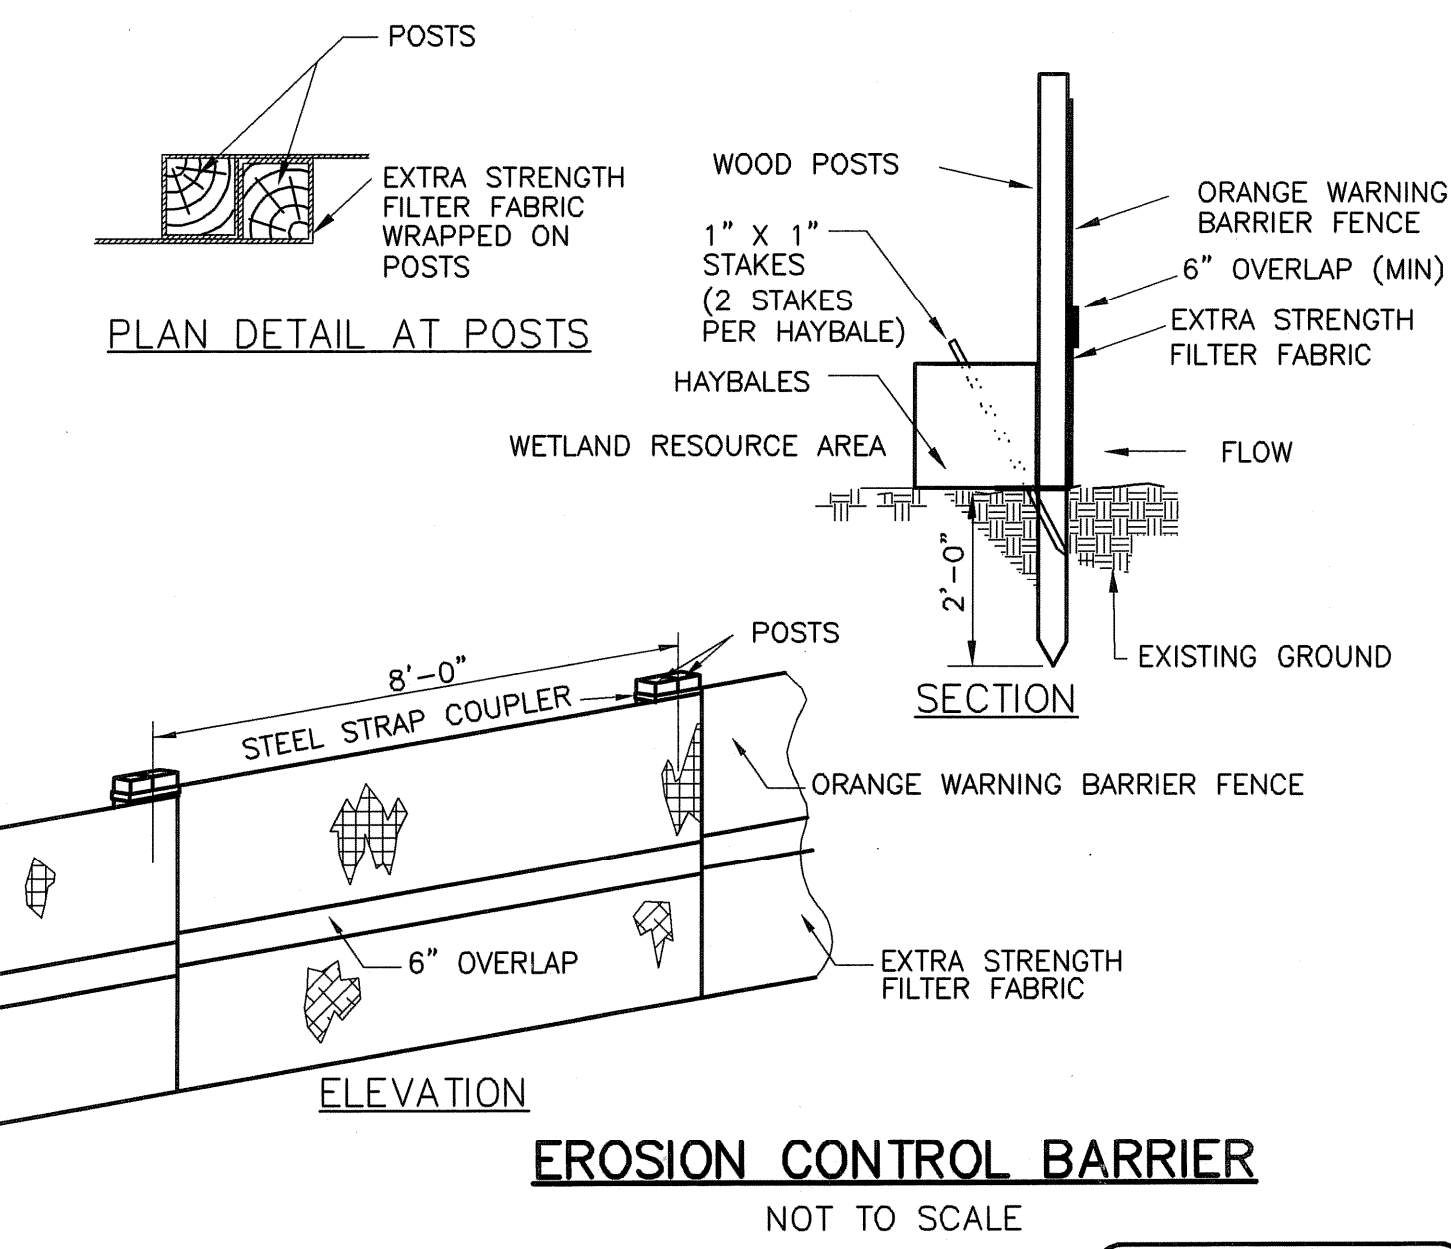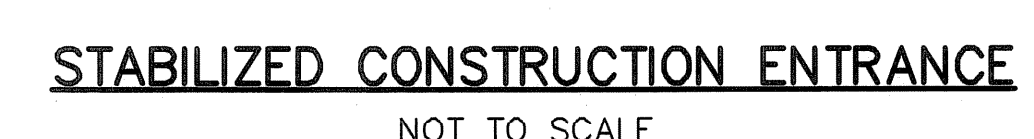

EarthTech
A Tyco International Ltd. Company
300 BAKER AVENUE SUITE 200 CONCORD MA 01742 (978) 371-4000

AS-BUILT DRAWING FILE	DATE	BY	REVISIONS
ISSUED FOR RFI POSTED SET	10/21/08		
ISSUED FOR CONSTRUCTION	10/28/08		
REV. B AGENCY REVIEW	6/16/05		
REV. A CLIENT REVIEW	7/22/05		



PAWTUCKET, RHODE ISLAND
PAWTUCKET REGIONAL WATER TREATMENT FACILITY
PKGS 11 & 12 - RAW WATER PUMP STATION
 MILL ST RAW WATER PUMP STATION
 SITE DETAILS

DESIGNED BY: DWG SCALE AS NOTED
 DRAWN BY: CONTRACT NO.
 CHECKED BY: DATE OCTOBER 31, 2008

EARTH TECH AS-BUILT FILE MAY 2008

LA-3
SHEET OF

Filename: C:\DOCUMENTS AND SETTINGS\ DAN WALTON\MY DOCUMENTS\PAWTUCKET_69993\69993 - MILL ST RWPS - SITEPLAN W WALSH.DWG
 Plot File Date Created: Mar/05/2009 3:31 PM

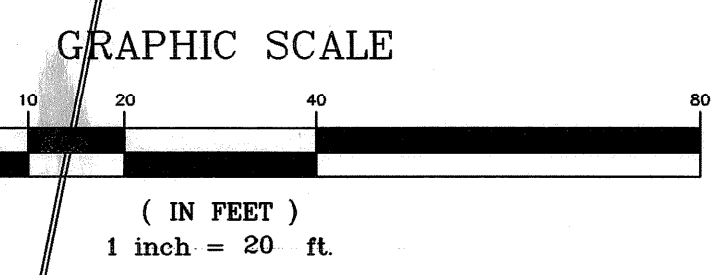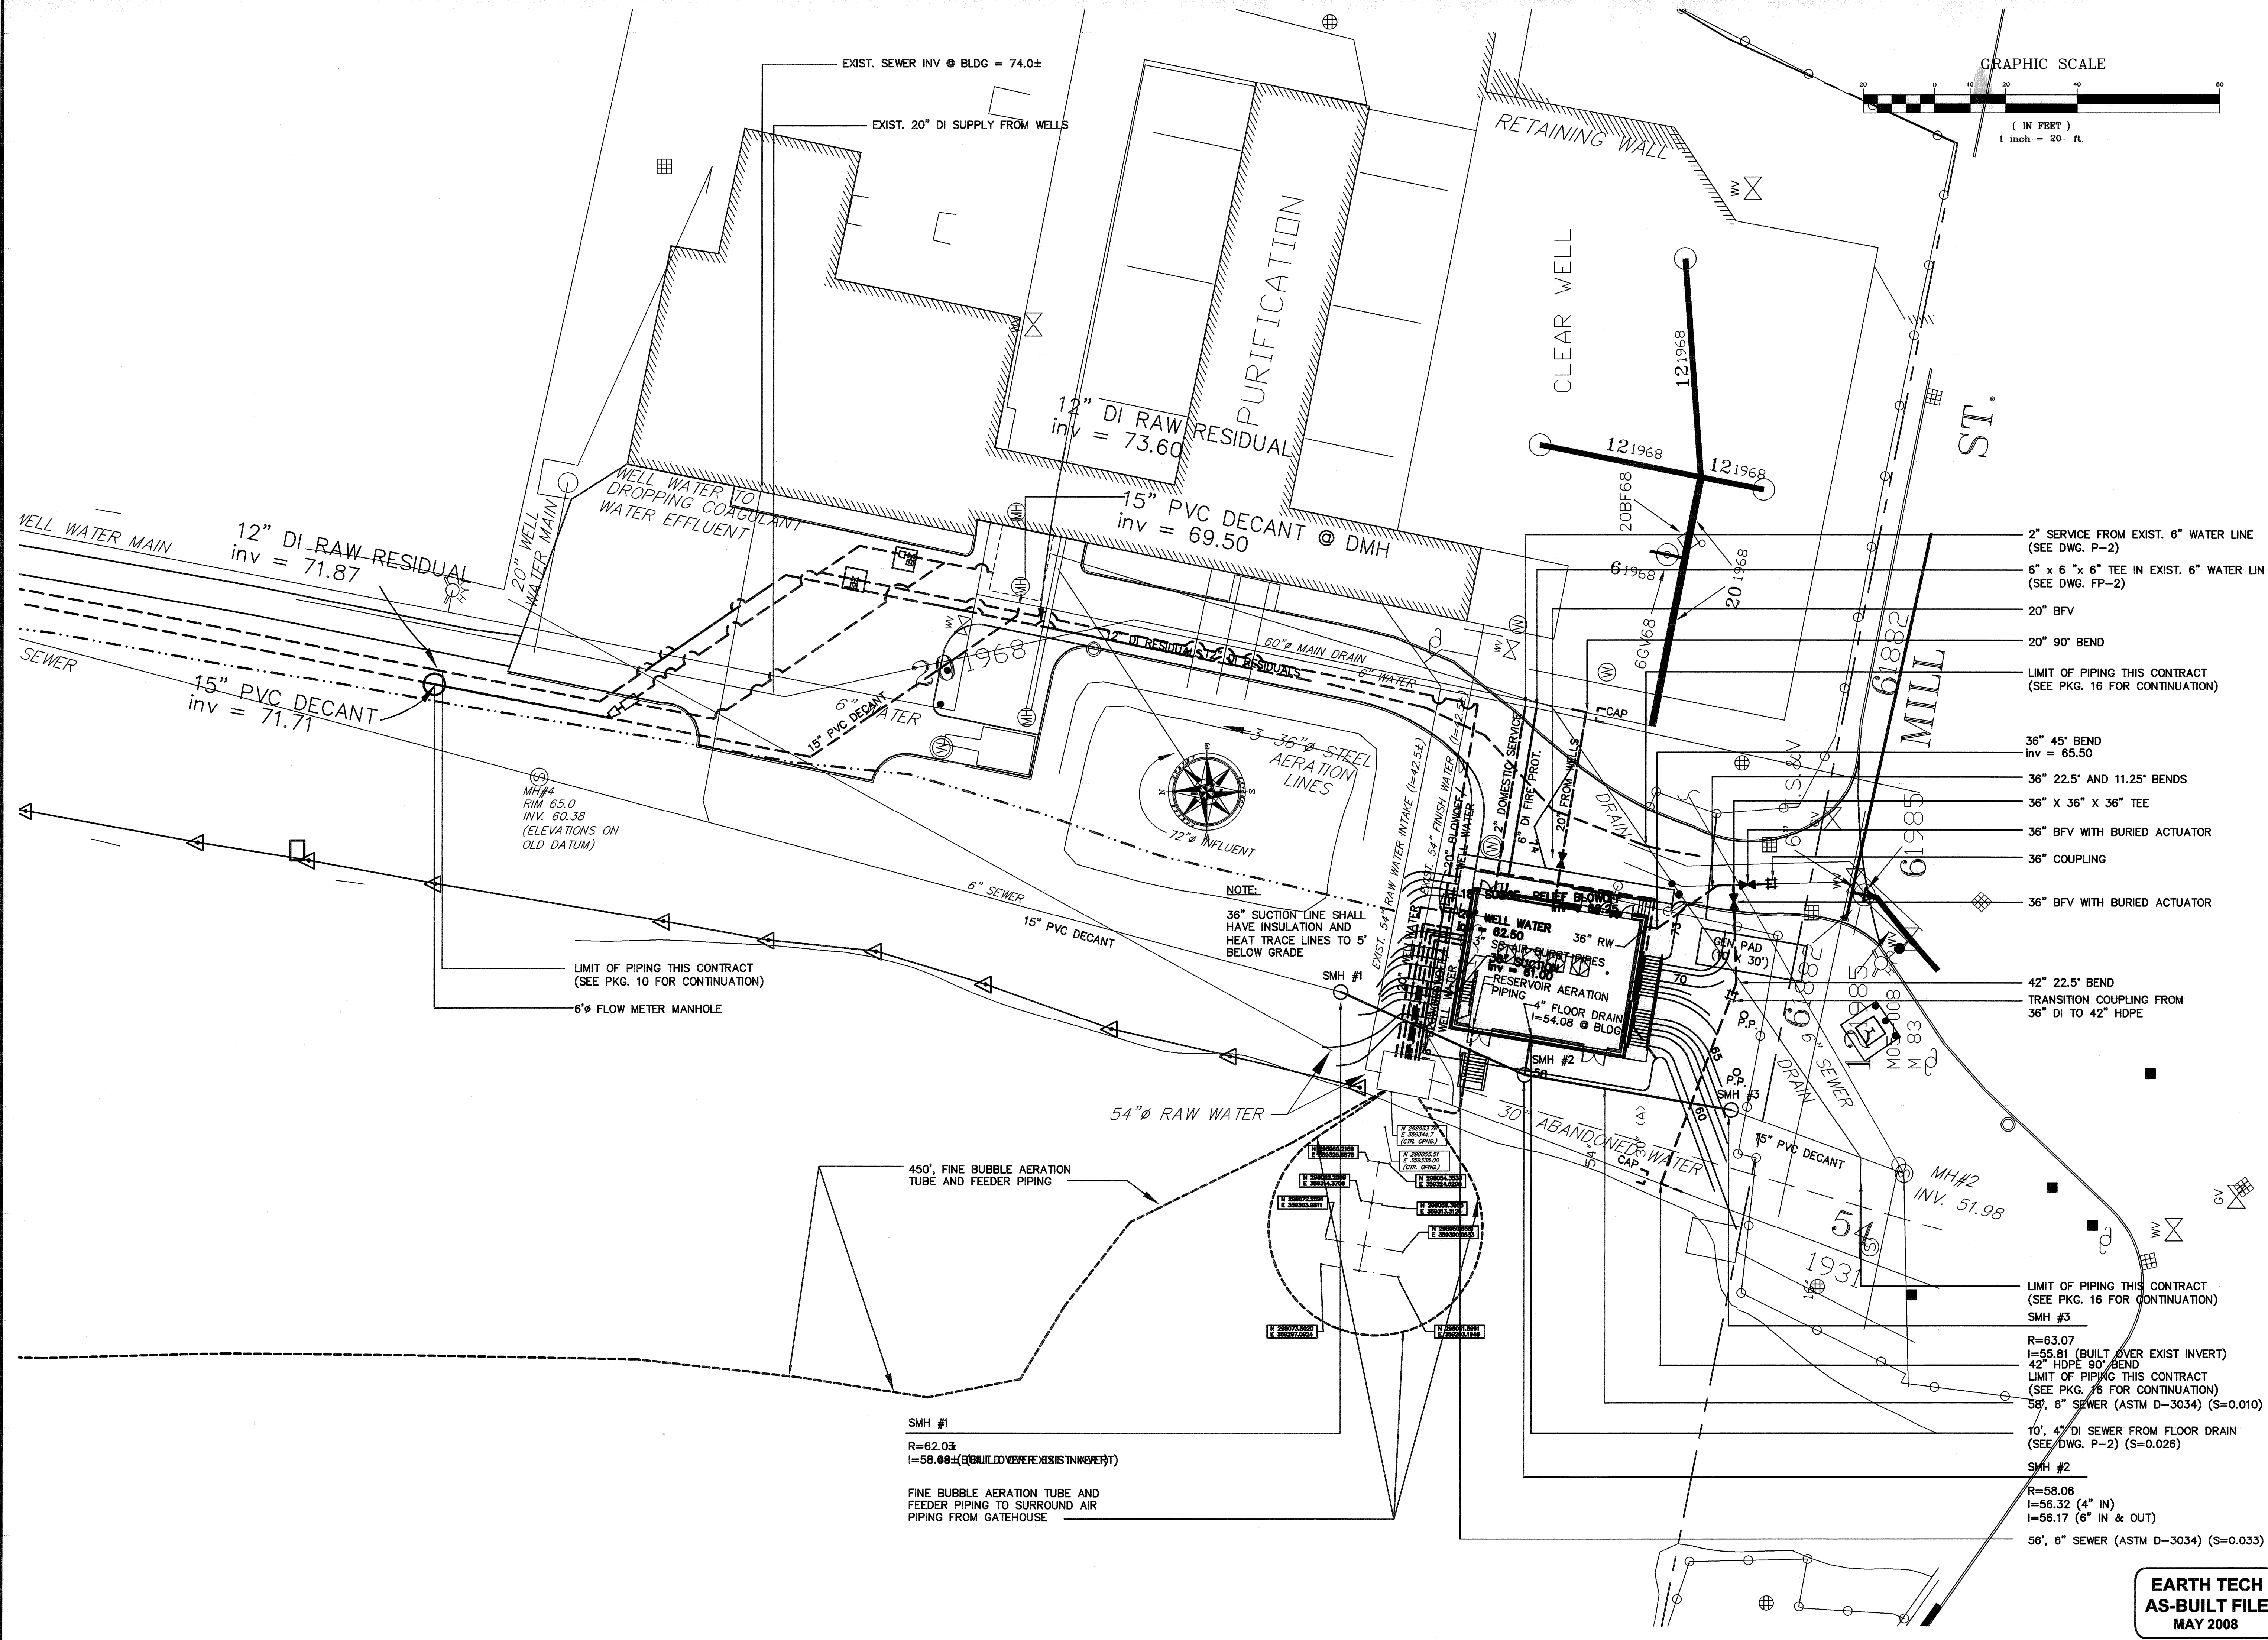

FULL SIZE DRAWING = 4"

NO.	DATE	BY	REVISIONS
1	10/27/06		ISSUED FOR RFI POSTED SET
2	10/27/06		AS-BUILT DRAWING FILE
3	10/28/05		ISSUED FOR CONSTRUCTION
4	6/16/05		REV. B AGENCY REVIEW
5	7/22/05		REV. A CLIENT REVIEW



ROBERT H. SHELDON
 No. 4103
 (Professional Engineer Seal)

PAWTUCKET, RHODE ISLAND
**PAWTUCKET REGIONAL
 WATER TREATMENT FACILITY**
PGS 11 & 12 - RAW WATER PUMP STATION
 MILL ST RAW WATER PUMP STATION
 SITE PIPING PLAN

DESIGNED BY	DWG SCALE
DRAWN BY	AS NOTED
CHECKED BY	CONTRACT NO
DATE	
OCTOBER 31, 2006	


EARTH TECH
 AS-BUILT FILE
 MAY 2008

ST-1
 SHEET OF

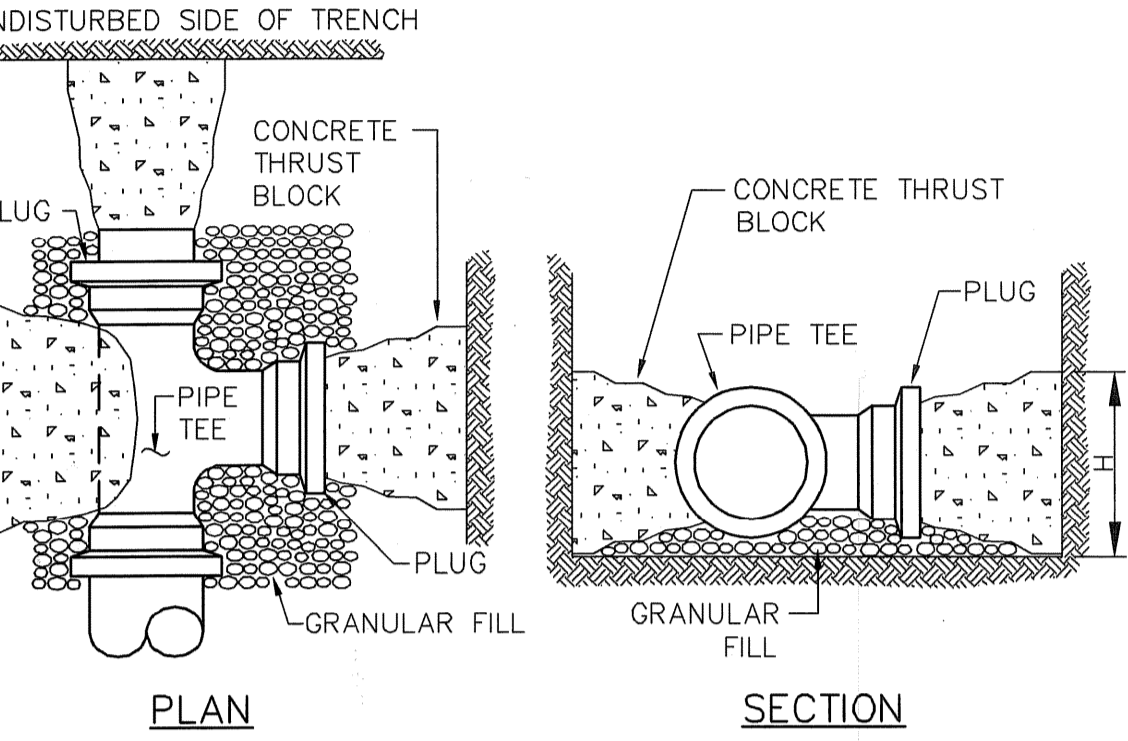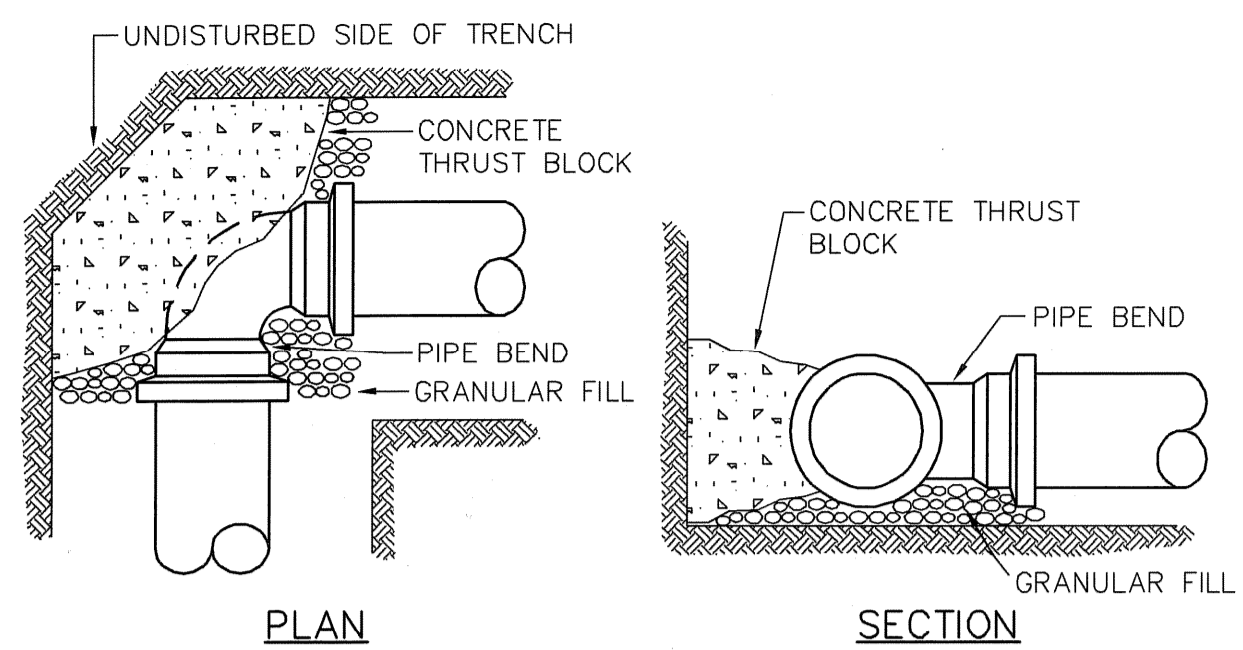


NOTE:
ALL FITTINGS TO BE PLACED ON WELL CONSOLIDATED GRAVEL BLOCK HEIGHT (H) SHOULD BE APPROXIMATELY 1/2 LENGTH (L) AT SOIL BEARING FACE.

TYPICAL THRUST BLOCK PLACEMENT ON BENDS, TEES AND PLUGS
NOT TO SCALE

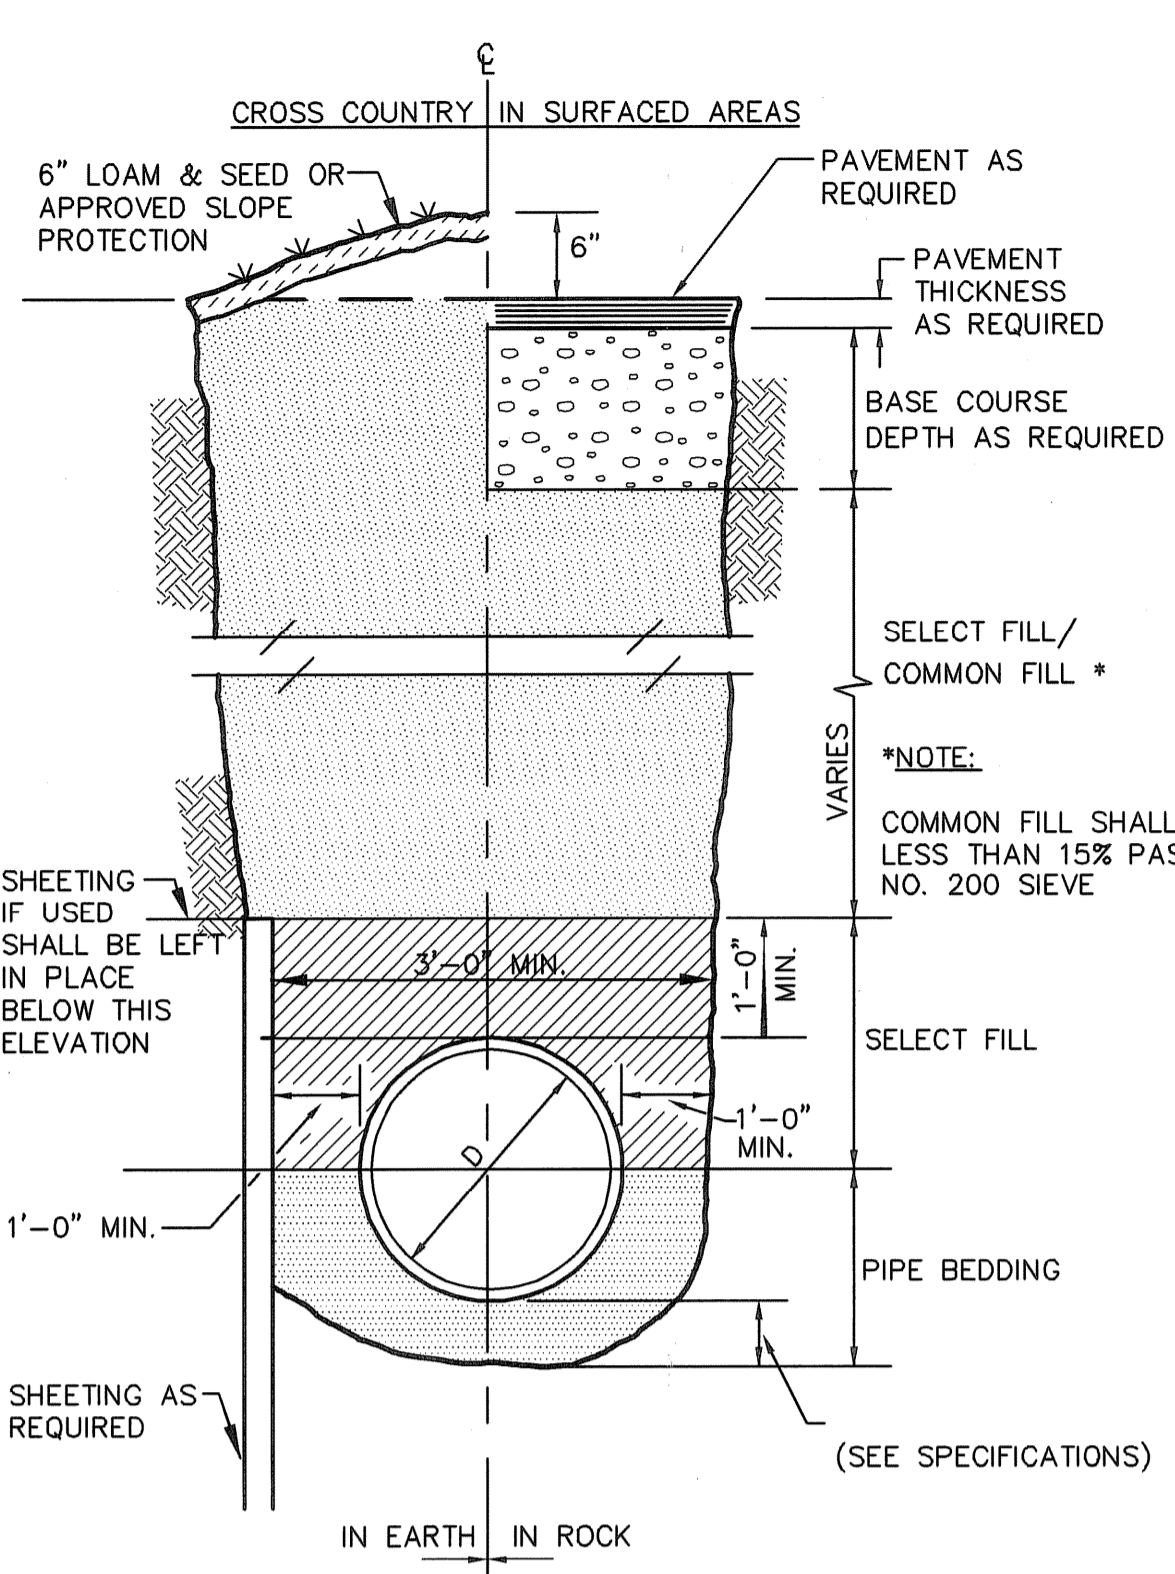

TYPICAL TRENCH SECTION
NOT TO SCALE

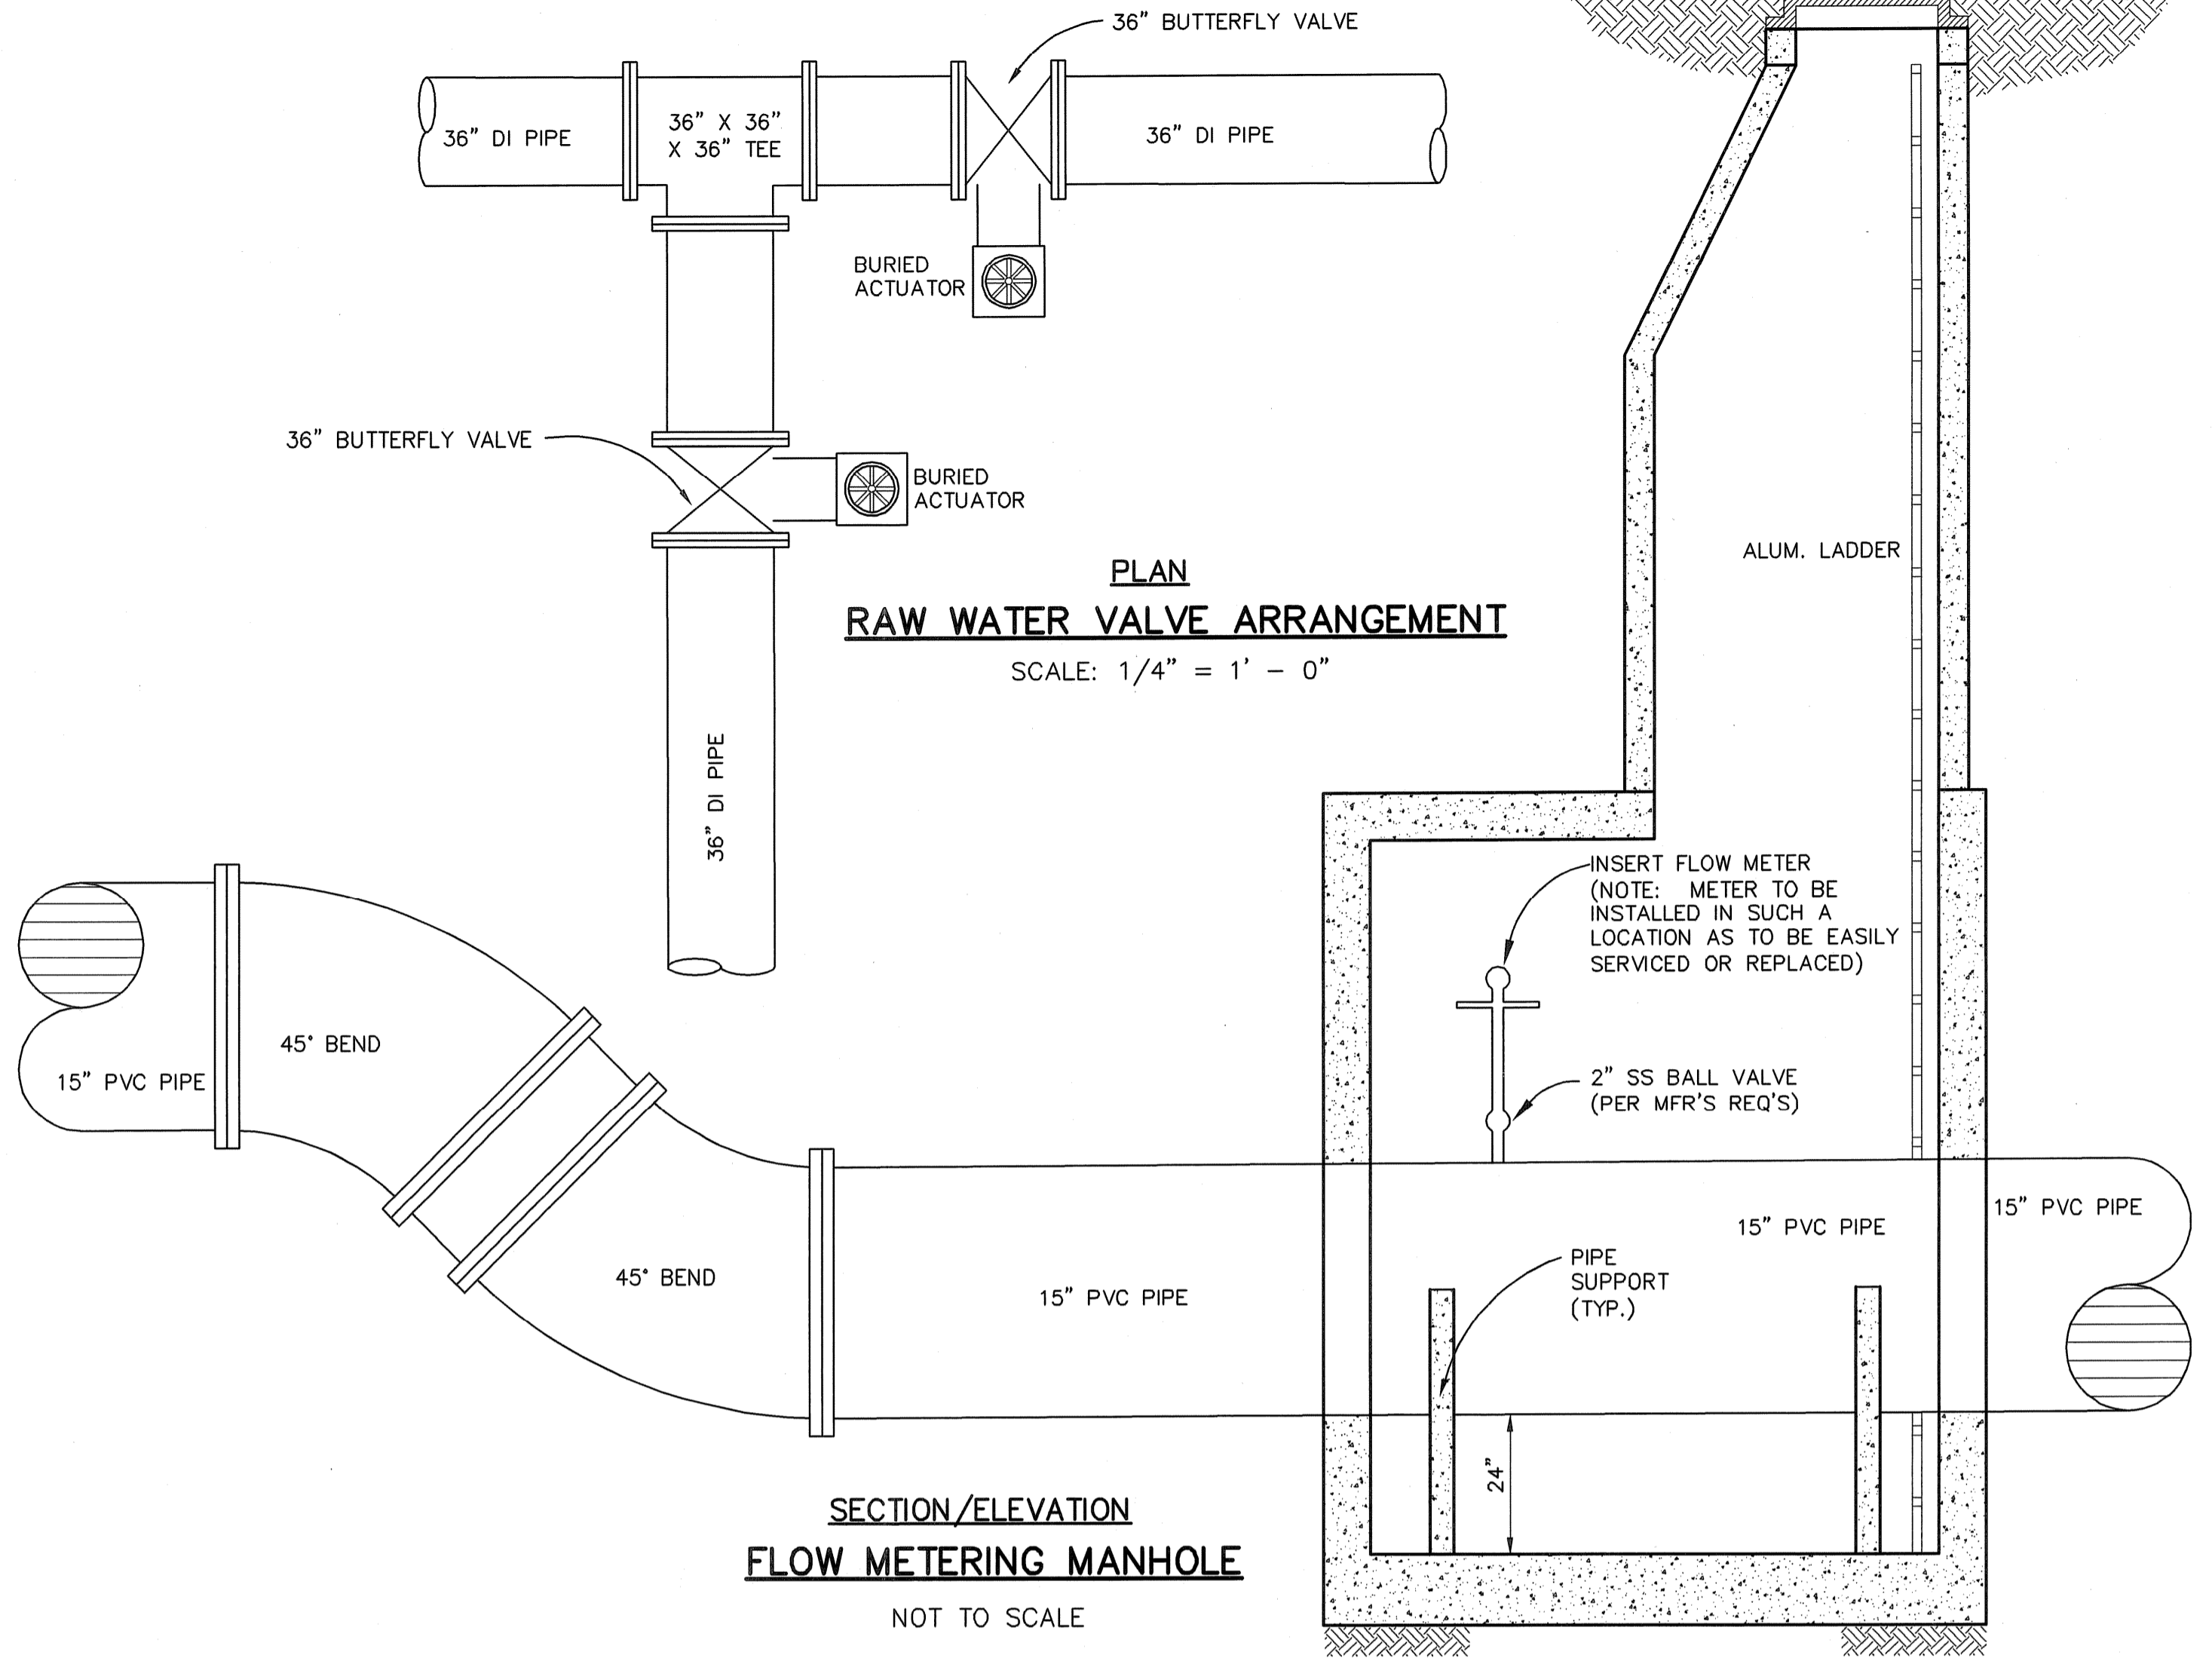

RAW WATER VALVE ARRANGEMENT
SCALE: 1/4" = 1' - 0"

SECTION/ELEVATION FLOW METERING MANHOLE
NOT TO SCALE

MINIMUM RESTRAINED LENGTH (FEET)

	DIAMETER (INCHES)																						
	4	6	8	10	12	14	16	18	20	24	36												
BENDS																							
11.25	1	1	2	2	3	3	3	4	4	5	9												
22.5	2	3	4	5	5	6	7	8	9	10	18												
45	4	6	8	10	11	13	15	16	18	21	46												
90	10	15	19	23	27	31	35	39	43	50	111												
TEES																							
4	8	0	0	0	0	-	-	-	-	-	-												
6	-	18	13	8	2	0	0	0	0	-	-												
8	-	-	29	25	21	16	12	8	3	0	-												
10	-	-	-	38	35	32	28	25	21	14	-												
12	-	-	-	-	48	46	43	40	37	31	-												
14	-	-	-	-	-	58	56	53	51	45	30												
16	-	-	-	-	-	-	68	66	64	59	56												
18	-	-	-	-	-	-	-	78	76	79	79												
20	-	-	-	-	-	-	-	-	87	84	100												
24	-	-	-	-	-	-	-	-	-	106	138												
36	-	-	-	-	-	-	-	-	-	106	162												
REDUCER																							
4	-	18	32	45	56	-	-	-	-	-	-												
6	-	-	19	34	47	60	72	-	-	-	-												
8	-	-	-	18	34	49	62	74	-	-	-												
10	-	-	-	-	19	36	50	64	77	-	-												
12	-	-	-	-	-	19	36	51	65	91	-												
14	-	-	-	-	-	-	19	36	52	80	-												
16	-	-	-	-	-	-	-	19	37	67	208												
18	-	-	-	-	-	-	-	-	19	53	195												
20	-	-	-	-	-	-	-	-	-	37	179												
VERTICAL OFFSETS (DOWN)																							
11.25	0	0	3	0	6	0	8	0	11	0	14	0	16	1	19	1	21	2	26	4	31	10	
22.5	9	0	15	2	20	4	26	5	31	7	36	8	42	10	47	12	52	13	62	16	63	20	
45	25	6	54	11	49	14	60	17	71	20	82	24	93	27	104	30	114	33	135	40	130	40	
DEAD END																							
	24	34	45	55	65	75	85	95	104	124	263												

- VALUES WERE CALCULATED ASSUMING A MINIMUM OF 5 FEET OF COVER OVER THE PIPE, TYPE 5 LAYING CONDITION AND A TOTAL PRESSURE OF 250 PSI (150 PSI TEST PRESSURE WITH A 100 PSI SURGE ALLOWANCE).
- THE VALUES LISTED FOR BENDS IS THE LENGTH OF RESTRAINED JOINT PIPING REQUIRED FOR EACH SIDE OF THE FITTING.
- THE VALUES LISTED FOR TEES IS THE LENGTH OF RESTRAINED JOINT PIPING REQUIRED FOR THE TEE BRANCH. VALUES WERE CALCULATED BASED ON A MINIMUM LENGTH OF 10 FEET BETWEEN THE NEAREST JOINTS ON BOTH SIDES OF THE TEE.
- THE VALUES LISTED FOR REDUCERS IS THE LENGTH OF RESTRAINED JOINT PIPING REQUIRED FOR THE LARGER PIPE.
- THE VALUES LISTED FOR VERTICAL OFFSETS ARE THE LENGTHS OF THE RESTRAINED JOINT PIPING REQUIRED FOR THE HIGHER PIPE AND THE LOWER PIPE, RESPECTIVELY, AND ASSUMING A VERTICAL OFFSET OF 3 FEET.
- WHERE THE RESTRAINED LENGTH OF TWO OR MORE FITTINGS OVERLAP, THE LARGER RESTRAINED LENGTH SHALL GOVERN.
- BACKFILL SHOULD BE COMPACTED TO AT LEAST 90 PERCENT OF MAXIMUM DRY UNIT WEIGHT DETERMINED BY ASTM TEST DESIGNATION D-1557.
- VALUES LISTED ARE FOR THE SPECIFIC LAYING CONDITIONS LISTED ABOVE. FOR THE LENGTH OF RESTRAINED JOINT PIPING FOR OTHER CONDITIONS, SEE THE ENGINEER.

MINIMUM RESTRAINED JOINT PIPE LENGTH - WATER MAINS

MINIMUM BEARING AREA - FT.²

PIPE DIAMETER (INCHES)	TEES, DEAD ENDS, VALVES	90° BENDS	45° BENDS	22 1/2° BENDS	11 1/4° BENDS
4	2.0	2.0	2.0	2.0	2.0
6	2.5	3.6	2.0	2.0	2.0
8	4.4	6.2	3.3	2.0	2.0
10	6.5	9.2	5.0	2.6	2.0
12	8.9	12.6	6.8	3.4	2.0
14	12.0	16.9	9.2	4.6	2.3
16	14.8	-	11.4	5.8	2.9
18	-	-	12.8	7.3	3.7
20	-	-	16.8	8.6	4.2
24	-	-	-	12.0	6.0
30	-	-	-	-	9.1
36	-	-	-	-	12.7
42	-	-	-	-	16.8

- BEARING AREAS, BASED ON SOIL BEARING CAPACITY OF 4,000 PSF. MINIMUM BEARING AREA IS 2.0 SQUARE FEET.
- IF SOIL HAS DIFFERENT BEARING CAPACITY THAN NOTED, NEW BEARING CAN BE CALCULATED BY RATIO I.E., IF SOIL HAS BEARING OF 2,000 PSF, MULTIPLY TABULATED VALUE BY 4/2.
- TABLE IS FOR HORIZONTAL RESTRAINT ONLY.
- VALUES SHOWN ARE FOR TEST PRESSURE OF 150 PSI WITH A 100 PSI SURGE ALLOWANCE.
- THRUST BLOCKS SHALL NOT BE PLACED AGAINST THE FOLLOWING SOILS: A) PEAT, ORGANIC SILT AND ORGANIC SOILS; B) SOFT CLAY; C) RUBBISH FILL AND OTHER UNSUITABLE ARTIFICIAL FILL; D) SHATTERED SHALE; E) INORGANIC SILT AND VERY FINE SANDS.
- WHERE POSSIBLE, POUR CONCRETE ANCHOR BLOCKS AGAINST UNDISTURBED EARTH. OTHERWISE, PLACE COMPACTED BACKFILL USING GRAVEL AND WELL GRADED SAND AFTER REMOVING FORMS.
- BACKFILL SHOULD BE COMPACTED TO AT LEAST 90 PERCENT OF MAXIMUM DRY UNIT WEIGHT DETERMINED BY ASTM TEST DESIGNATION D-1557.

MINIMUM THRUST BLOCK SIZING

Filename: L:\WORK\69993\CAD\AS-BUILT\11-12 RWTP\SITE\69993 - MILL ST RWPS - SITEPLAN.DWG
 Plot File Date Created: Sep/22/2008 11:33 AM

EarthTech
A Tyco International Ltd. Company
300 BAKER AVENUE SUITE 250 CONCORD MA 01742 (978) 371-4000

AS-BUILT DRAWING FILE ISSUED FOR RFI POSTED SET ISSUED FOR CONSTRUCTION REV. B AGENCY REVIEW REV. A CLIENT REVIEW	MAY 2008 10/21/06 10/28/05 8/16/05 7/22/05
FULL SIZE DRAWING = 4" 2 1 0 B A INS	DATE BY

ROBERT H. SHELDON
No. 4103

PAWTUCKET, RHODE ISLAND
PAWTUCKET REGIONAL WATER TREATMENT FACILITY
PKGS 11 & 12 - RAW WATER PUMP STATION
 MILL ST RAW WATER PUMP STATION
 SITE PIPING DETAILS

DESIGNED BY	DWG SCALE
DRAWN BY	CONTRACT NO.
CHECKED BY	DATE
	OCTOBER 31, 2008

EARTH TECH AS-BUILT FILE
MAY 2008

ST-2
SHEET OF


SYMBOLS USED AS ABBREVIATIONS:

<	ANGLE	⊥	PERPENDICULAR
⊥	CENTERLINE	⊘	PLATE
⊥	CHANNEL	⊘	ROUND
P	PENNY		

ABBREVIATIONS:

ABF ABOVE	DPR DAMPER	GLF GLASS FIBER	MIN MINIMUM	SFGL SAFETY GLASS
AFF ABOVE FINISHED FLOOR	DP DAMPROOFING	GCMU GLAZED CONCRETE MASONRY UNITS	MIR MIRROR	SCH SCHEDULE
ASC ABOVE SUSPENDED CEILING	DL DEAD LOAD	GST GLAZED STRUCTURAL TILE	MISC MISCELLANEOUS	SCN SCREEN
ACC ACCESS	DEM DEMOLISH, DEMOLITION	GB GRAB BAR	MOD MODULAR	SNT SEALANT
ACFL ACCESS FLOOR	DMT DEMOUNTABLE	GD GRADE, GRADING	MLD MOLDING, MOULDING	SLR SEALER
AP ACCESS PANEL	DEP DEPRESSED	GRN GRANITE	MR MOISTURE RESISTANT	STG SEATING
AC ACUSTICAL	DTL DETAIL	GVL GRAVEL	MT MOUNT (ED). (ING)	SEC SECTION
ACPL ACUSTICAL PLASTER	DIAG DIAGONAL	GF GROUND FACE	MO MASONRY OPENING	SSK SERVICE SINK
ACT ACUSTICAL TILE	DIAM DIAMETER	GT GROUT	MOV MOVABLE	SHTH SHEATHING
ACR ACRYLIC PLASTIC	DIM DIMENSION	GPDW GYPSUM DRY WALL	MULL MULLION	SHT SHEET
ADD ADDENDUM	DPR DISPENSER	GPL GYPSUM LATHE	NL NAILABLE	SG SHEET GLASS
ADH ADHESIVE	DIV DIVISION	GPPL GYPSUM PLASTER	NAT NATURAL	SH SHELF, SHELVING
ADJ ADJACENT	DR DOOR	GPT GYPSUM TILE	NI NICKEL	SHO SHORE (D). (ING)
ADJT ADJUSTABLE	DA DOUBLEACTING		NR NOISE REDUCTION	SIM SIMILAR
AGG AGGREGATE	DH DOUBLE HUNG		NRC NOISE REDUCTION COEFFICIENT	SKL SKYLIGHT
A/C AIR CONDITIONING	DTA DOVETAIL ANCHOR		NOM NOMINAL	SL SLEEVE
ALT ALTERNATE	DS DOVETAIL ANCHOR SLOT		NMT NONMETALLIC	SC SOLID CORE
AL ALUMINUM	D DRAIN		N NORTH	SP SOUNDPROOF
ANC ANCHOR, ANCHORAGE	DRB DRAINBOARD		NIC NOT IN CONTRACT	S SOUTH
AB ANCHOR BOLT	DT DRAIN TILE		NTS NOT TO SCALE	SPC SPACER
ANOD ANODIZED	DWR DRAWER			SPK SPEAKER
APX APPROXIMATE	DWG DRAWING			SPL SPECIAL
ARCH ARCHITECT (URAL)	DF DRINKING FOUNTAIN			SPEC SPECIFICATION (S)
AD AREA DRAIN	DW DUMBWAITER			SO SQUARE
ASPH ASPHALT				SST STAINLESS STEEL
AT ASPHALT TILE				STD STANDARD
AUTO AUTOMATIC				STA STATION
				STL STEEL
				STO STORAGE
				SD STORM DRAIN
				STR STRUCTURAL
				SCT STRUCTURAL CLAY TILE
				SGFT STRUCTURAL GLAZED FACING TILE
				SUS SUSPENDED
				SYM SYMMETRY (ICAL)
				SYN SYNTHETIC
				SYS SYSTEM
				TKBD TACKBOARD
				TKS TACKSTRIP
				TEL TELEPHONE
				TV TELEVISION
				TC TERRA COTTA
				TZ TERRAZZO
				THK THICK (NESS)
				THR THRESHOLD
				TPTN TOILET PARTITION
				TPD TOILET PAPER DISPENSER
				TOL TOLERANCE
				T&G TONGUE AND GROOVE
				TOMRD TOP OF METAL ROOF DECK
				TOEMRD TOP OF EXISTING METAL ROOF DECK
				TORF TOP OF ROOF
				TSL TOP OF SLAB
				TST TOP OF STEEL
				TW TOP OF WALL
				TB TOWEL BAR
				TR TRANSOM
				T TREAD
				TYP TYPICAL
				UC UNDERCUT
				UNF UNFINISHED
				UR URINAL
				V-J JOINT (ED)
				VB VAPOR BARRIER
				VAR VARNISH
				VNR VENEER
				VIF VERIFY IN FIELD
				VRM VERMICULITE
				VERT VERTICAL
				VG VERTICAL GRAIN
				VIN VINYL
				VB VINYL BASE
				VCT VINYL COMPOSITE TILE
				VF VINYL FABRIC
				VP VISION PANEL
				WSCT WAINSCOT
				WTW WALL TO WALL
				WH WALL HUNG
				WC WATER CLOSET
				WP WATERPROOFING
				WR WATER REPELLENT
				WS WATERSTOP
				WWF WELDED WIRE FABRIC
				W WEST
				WHB WHEEL BUMPER
				W WIDTH, WIDE
				WIN WINDOW
				WG WIRED GLASS
				WM WIRE MESH
				WO WITHOUT
				WOOD WOOD
				WB WOOD BASE
				WPT WORKING POINT

SYMBOLS

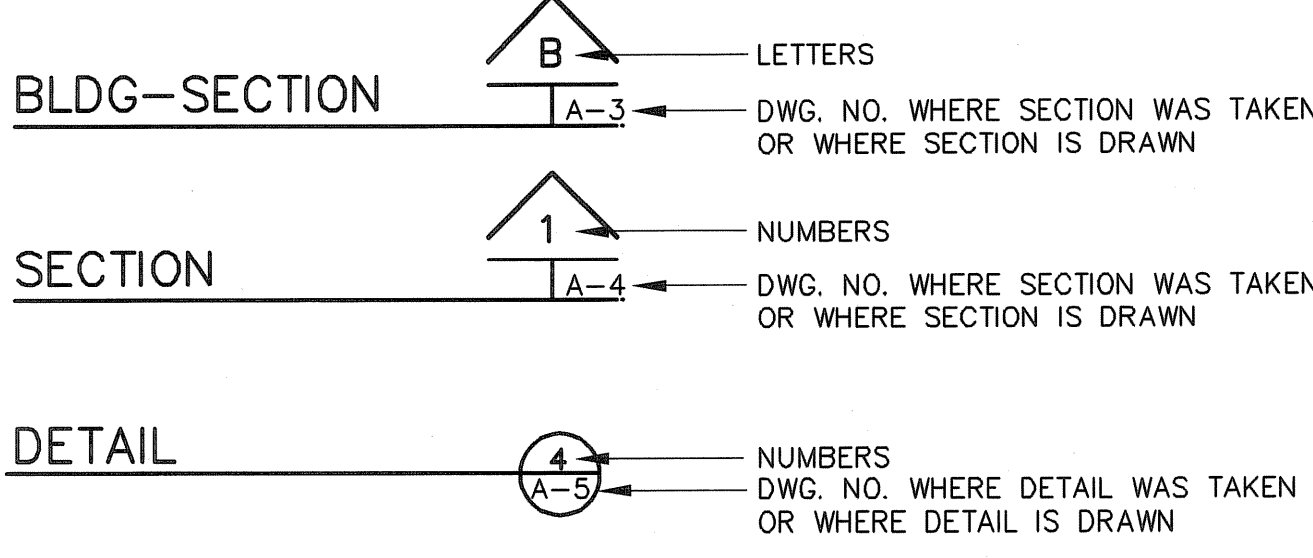

- ① DOOR DESIGNATION
- △ LOUVER DESIGNATION
- ⓐ WINDOW DESIGNATION
- Ⓧ HATCH HINGE LOCATION
- △ PARTITION TYPE

INTERIOR PARTITION SCHEDULE

1		4" CMU FROM FINISH FLOOR TO UNDERSIDE OF STRUCTURE.
2		8" CMU FROM FINISH FLOOR TO UNDERSIDE OF STRUCTURE.
3		8" CMU (2 HR. FIRE RATED UNITS) FROM FINISH FLOOR TO UNDERSIDE OF STRUCTURE.
4		12" CMU FROM FINISH FLOOR TO UNDERSIDE OF STRUCTURE.
5		12" CMU (2 HR FIRE RATING) FROM FINISH FLOOR TO UNDERSIDE OF STRUCTURE.
6		GPDW PARTITION 2" METAL STUDS @ 16" O.C. W/ 5/8" GPDW ON ONE SIDE. STUDS TO UNDERSIDE OF STRUCTURE DRYWALL TO 6" ABOVE FINISHED CEILING
7		GPDW PARTITION 4" METAL STUDS @ 16" OC WITH 5/8" GPDW EACH SIDE FULL HEIGHT. (MOISTURE RESISTANT AND SOUND INSULATION BATTS WHERE INDICATED).

PARTITION SCHEDULE GENERAL NOTES:

1. ALL CMU PARTITIONS EXTEND TO UNDERSIDE OF STRUCTURE.
2. SEE DRAWING A-14 FOR TYPICAL PARTITION DETAILS.

CODE SUMMARY - W.T.P.

RHODE ISLAND STATE BUILDING CODE
8TH EDITION - INTERNATIONAL BUILDING CODE 2003 EDITION

BUILDING DESCRIPTION:
TWO STORY MASONRY BEARING WALL BUILDING WITH
CONCRETE TEE AND STEEL BEAM ROOF FRAMING

BUILDING FOOTPRINT 26,126 SQ. FT.
BUILDING HEIGHT 2 STORIES - 34 FT. MAX. ABOVE GRADE

USE GROUP F-2 LOW HAZARD FACTORY AND INDUSTRIAL
OCCUPANCY EXCEPT FOR CHEMICAL STORAGE AREAS AT FIRST
FLOOR WHICH ARE H-4 HIGH HAZARD - HEALTH HAZARDS

CONSTRUCTION TYPE = II B NON COMBUSTIBLE UNPROTECTED

FIRE PROTECTION:

SPRINKLERS REQUIRED. FIRST FLOOR TO BE SPRINKLERED EXCEPT
FOR PUMP ROOM 114 WHICH HAS 5,000 - VOLT MOTORS. THIS
ROOM IS TO HAVE 2 HR FIRE SEPARATION FROM REST OF FIRST
FLOOR. UPPER FLOOR SPRINKLERED, EXCEPT FOR ELECTRICAL
ROOM 205 AND FILTER ROOM 212.

CODE SUMMARY - LAB AND OFFICE AREA

RHODE ISLAND STATE BUILDING CODE
8TH EDITION - INTERNATIONAL BUILDING CODE 2003 EDITION

BUILDING DESCRIPTION:
EXISTING ONE STORY BUILDING
SPACE WITH MECHANICAL MEZZANINE

FOOTPRINT OF RENOVATED AREA 4,900 SQ. FT. ±
BUILDING HEIGHT EXISTING - 34 FT. ± ABOVE GRADE

USE GROUP B - BUSINESS OCCUPANCY

CONSTRUCTION TYPE = V B COMBUSTIBLE UNPROTECTED

FIRE PROTECTION:

RENOVATED AREA OF BUILDING SPRINKLERED

LEGEND

	CONCRETE		LUMBER
	CONCRETE MASONRY UNIT (C.M.U.)		FINISH WOOD
	CEMENT PLASTER, MORTAR OR GPDW.		PLY-WOOD
	RIGID INSULATION		ACOUSTIC TILE
	FIBERGLASS INSULATION		STEEL

TAMM ARCHITECTS & ENGINEERS, INC.
AN EARTH TECH COMPANY - RI COA A-14,324


300 BAKER AVENUE SUITE 200 CONCORD MA 01742 (978) 371-0000

DESIGNED BY	ARN	DWG SCALE	NTS
DRAWN BY	EOD	CONTRACT NO	
CHECKED BY	ARN	DATE	OCTOBER 31, 2008

PAWTUCKET, RHODE ISLAND
PAWTUCKET REGIONAL
WATER TREATMENT FACILITY
PAGES 11 & 12 - RAW WATER PUMP STATION
ABBREVIATIONS AND CODE SUMMARY


DESIGNED BY	ARN	DWG SCALE	NTS
DRAWN BY	EOD	CONTRACT NO	
CHECKED BY	ARN	DATE	OCTOBER 31, 2008

EARTH TECH
AS-BUILT FILE
MAY 2008

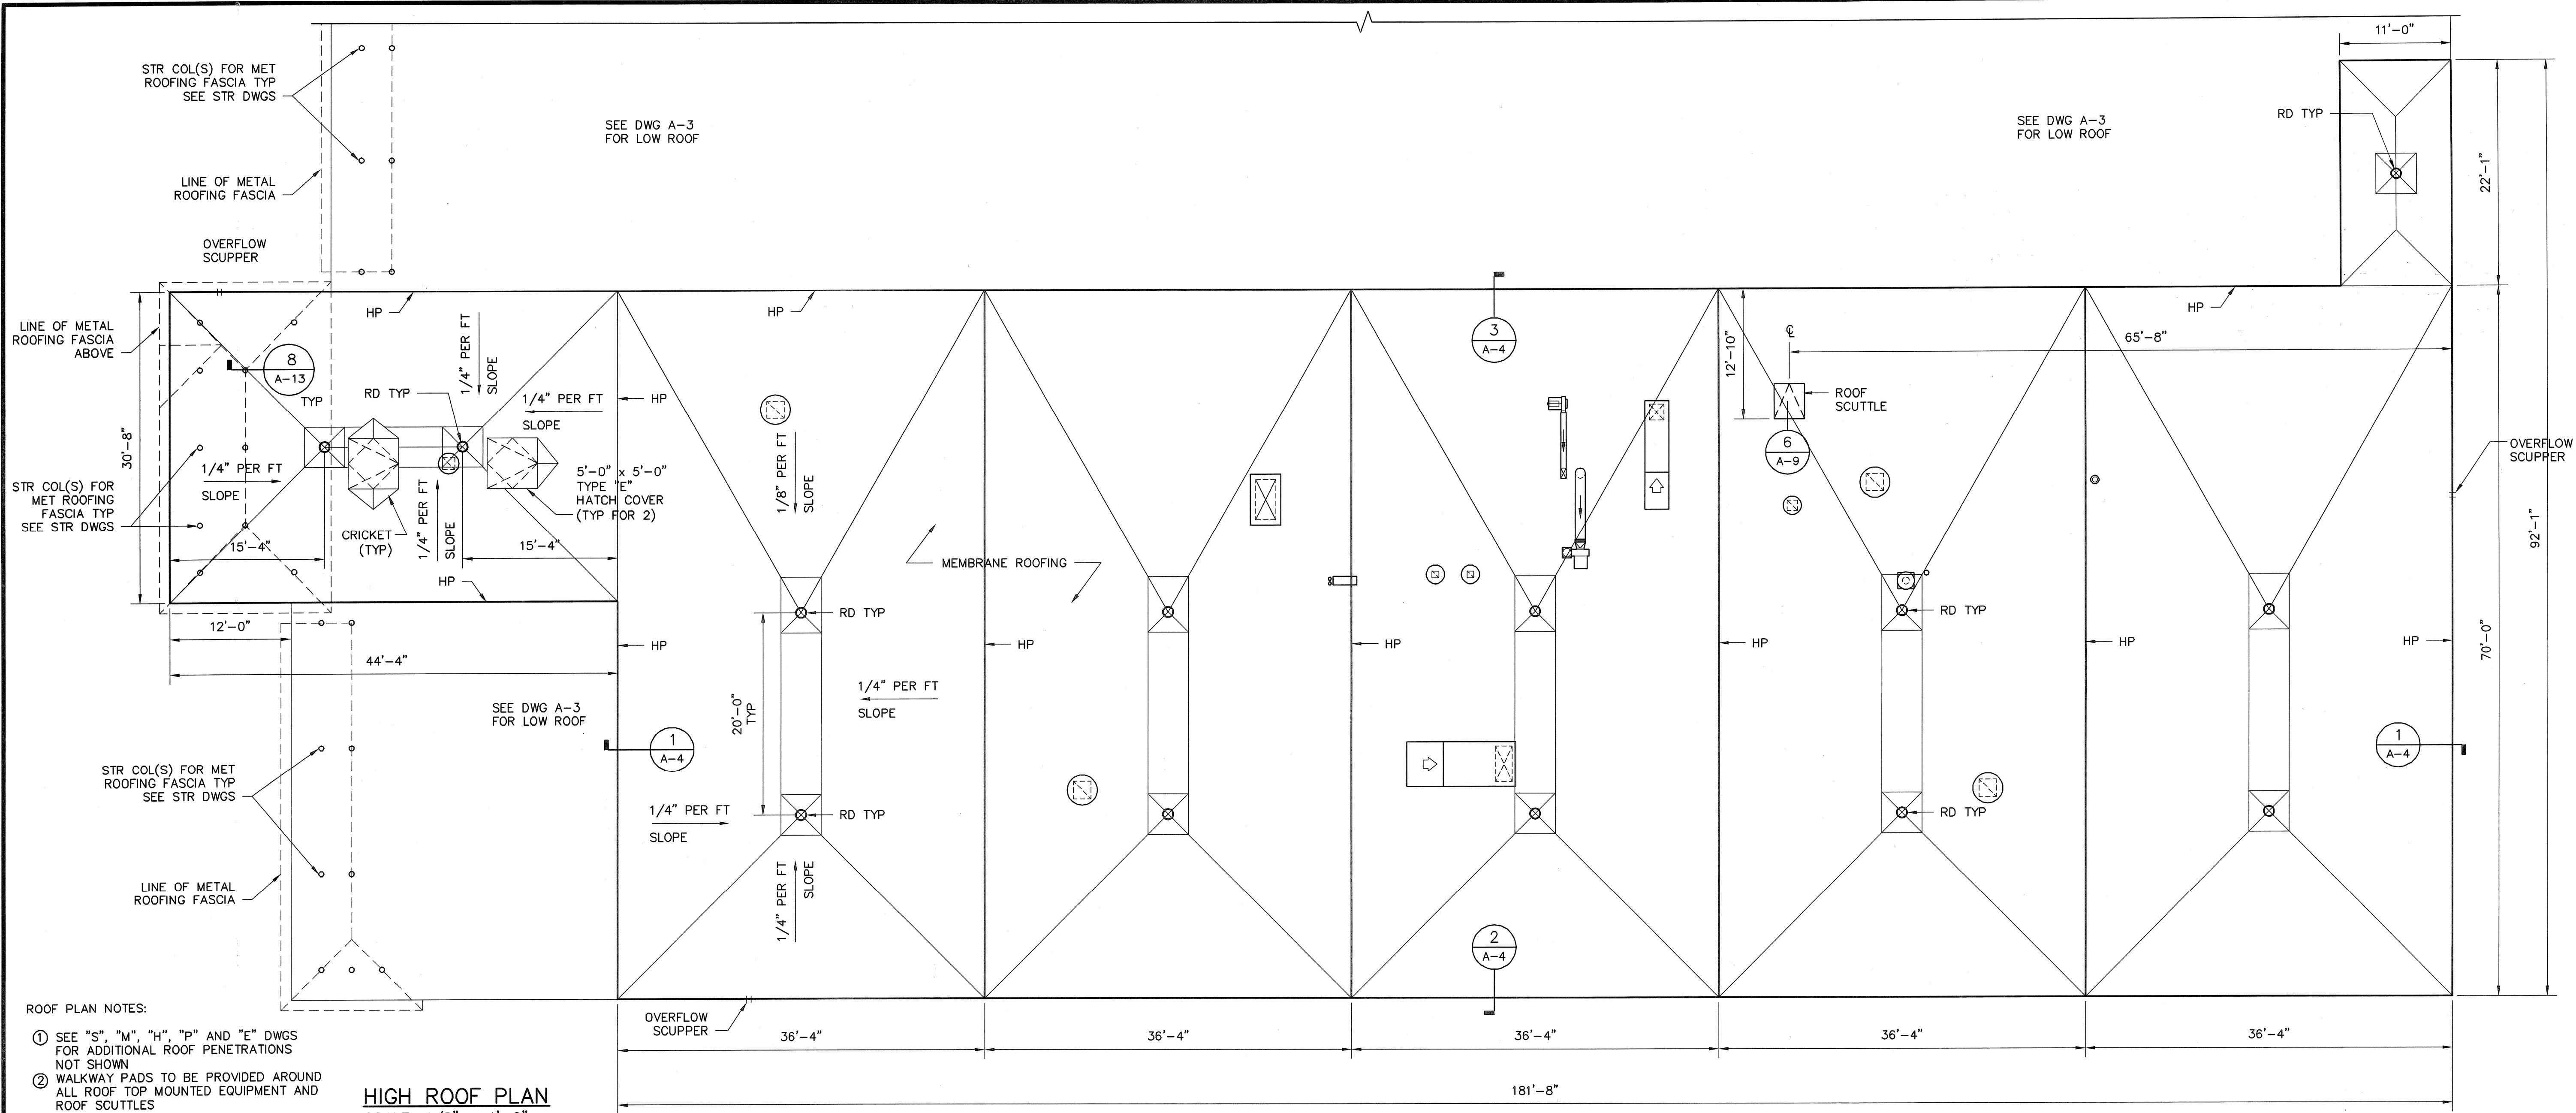


ROOF PLAN NOTES:
 ① SEE "S", "M", "H", "P" AND "E" DWGS FOR ADDITIONAL ROOF PENETRATIONS NOT SHOWN
 ② WALKWAY PADS TO BE PROVIDED AROUND ALL ROOF TOP MOUNTED EQUIPMENT AND ROOF SCUTTLES


HIGH ROOF PLAN
 SCALE: 1/8" = 1'-0"

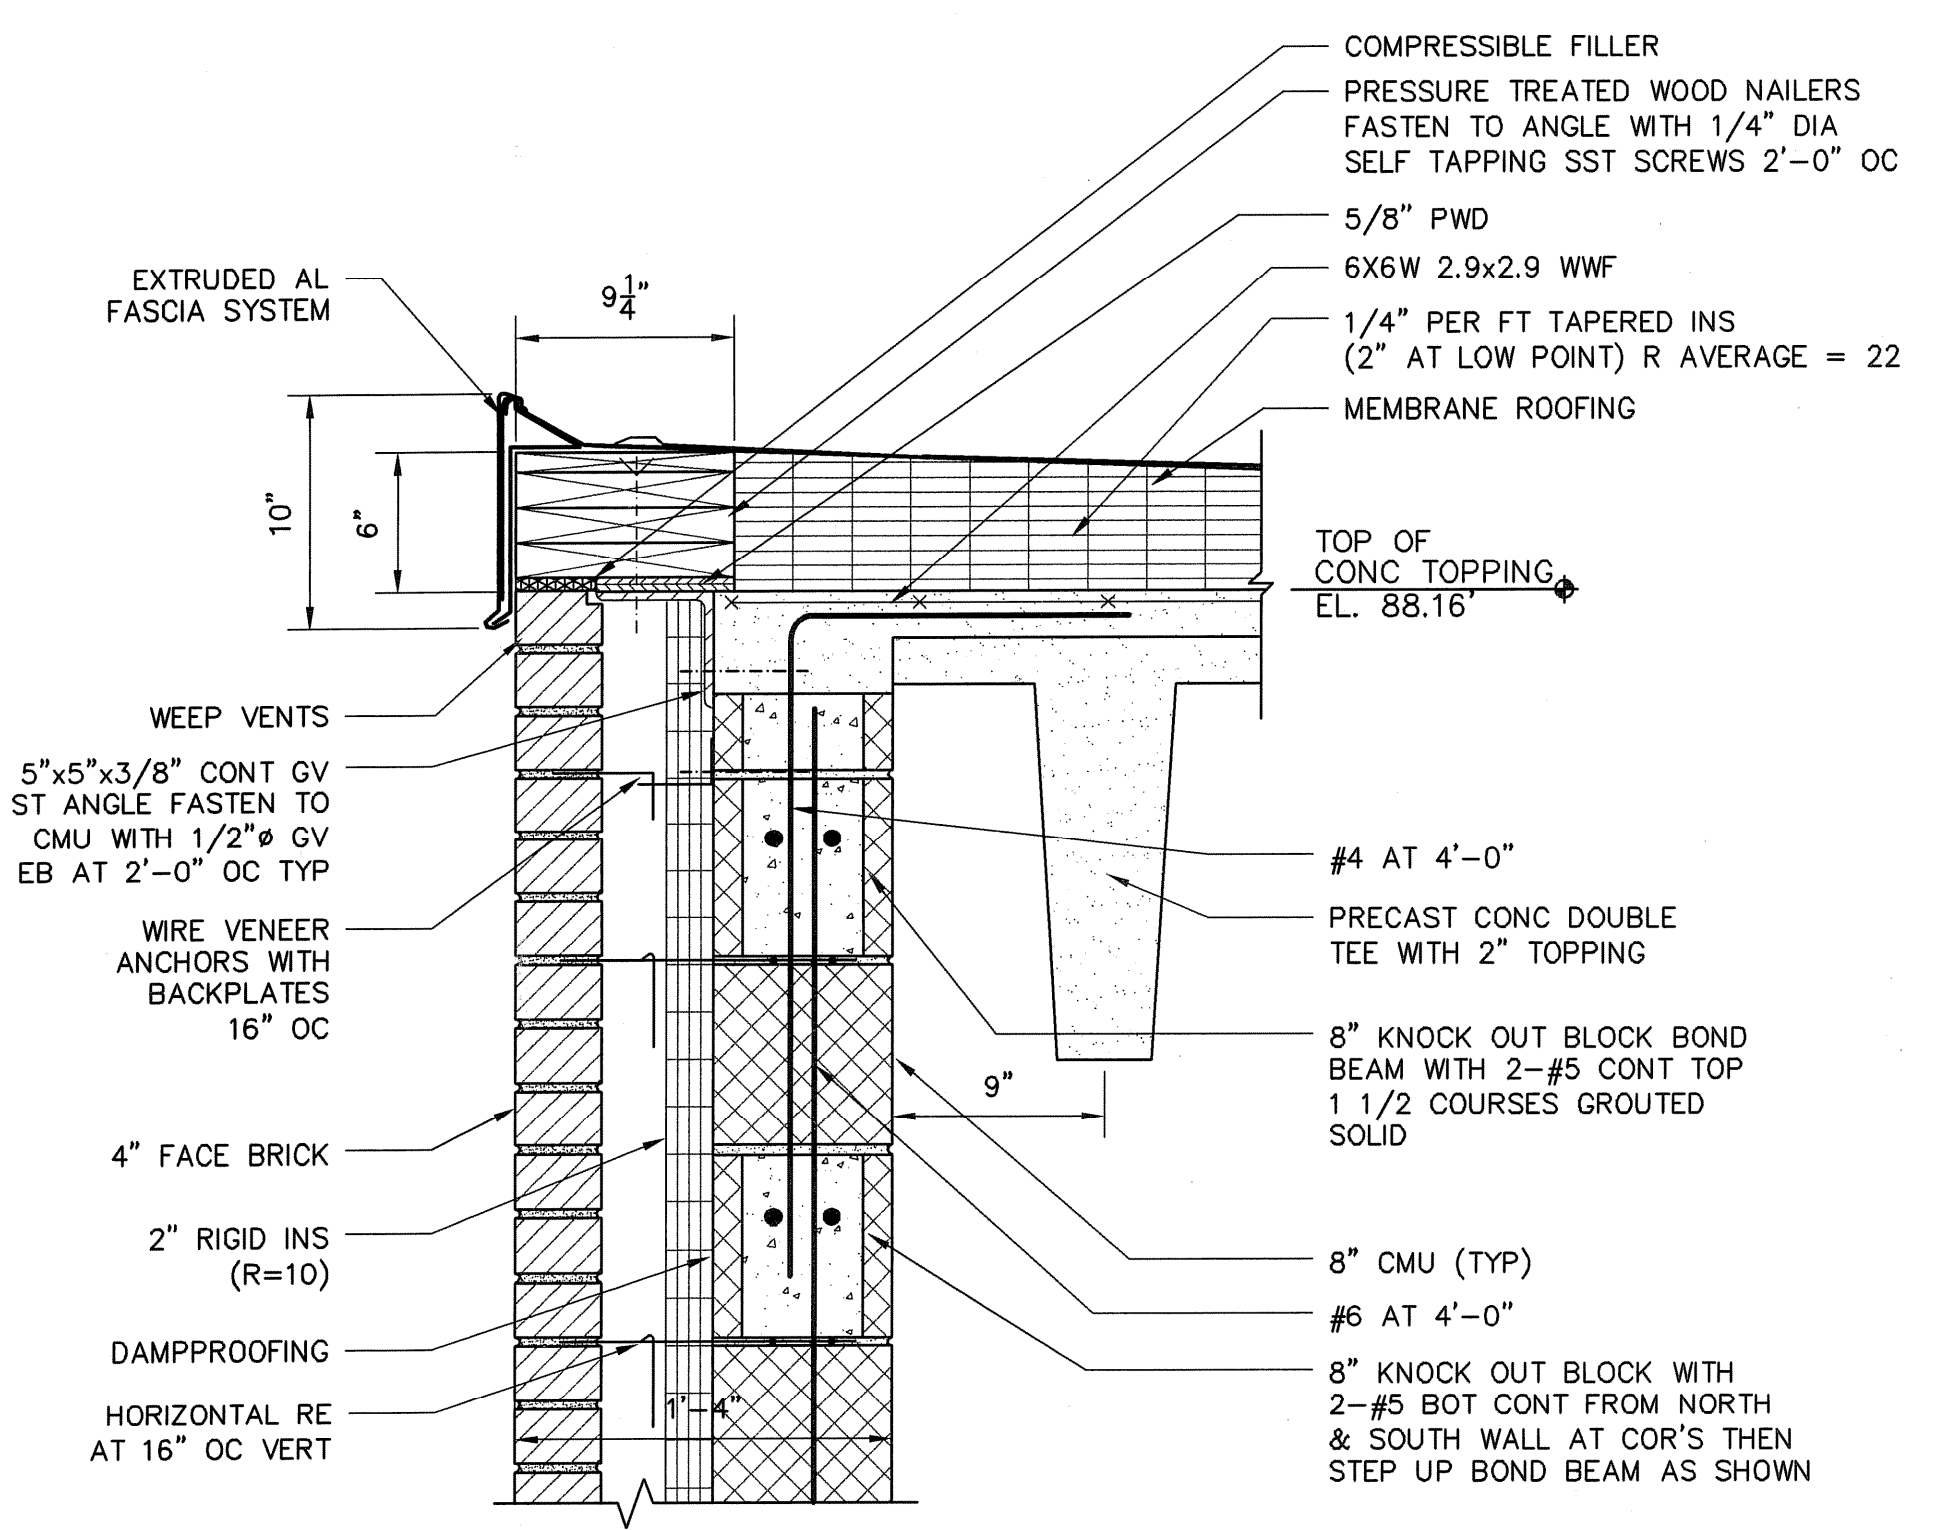

DETAIL 1
 SCALE: 1 1/2" = 1'-0" A-4

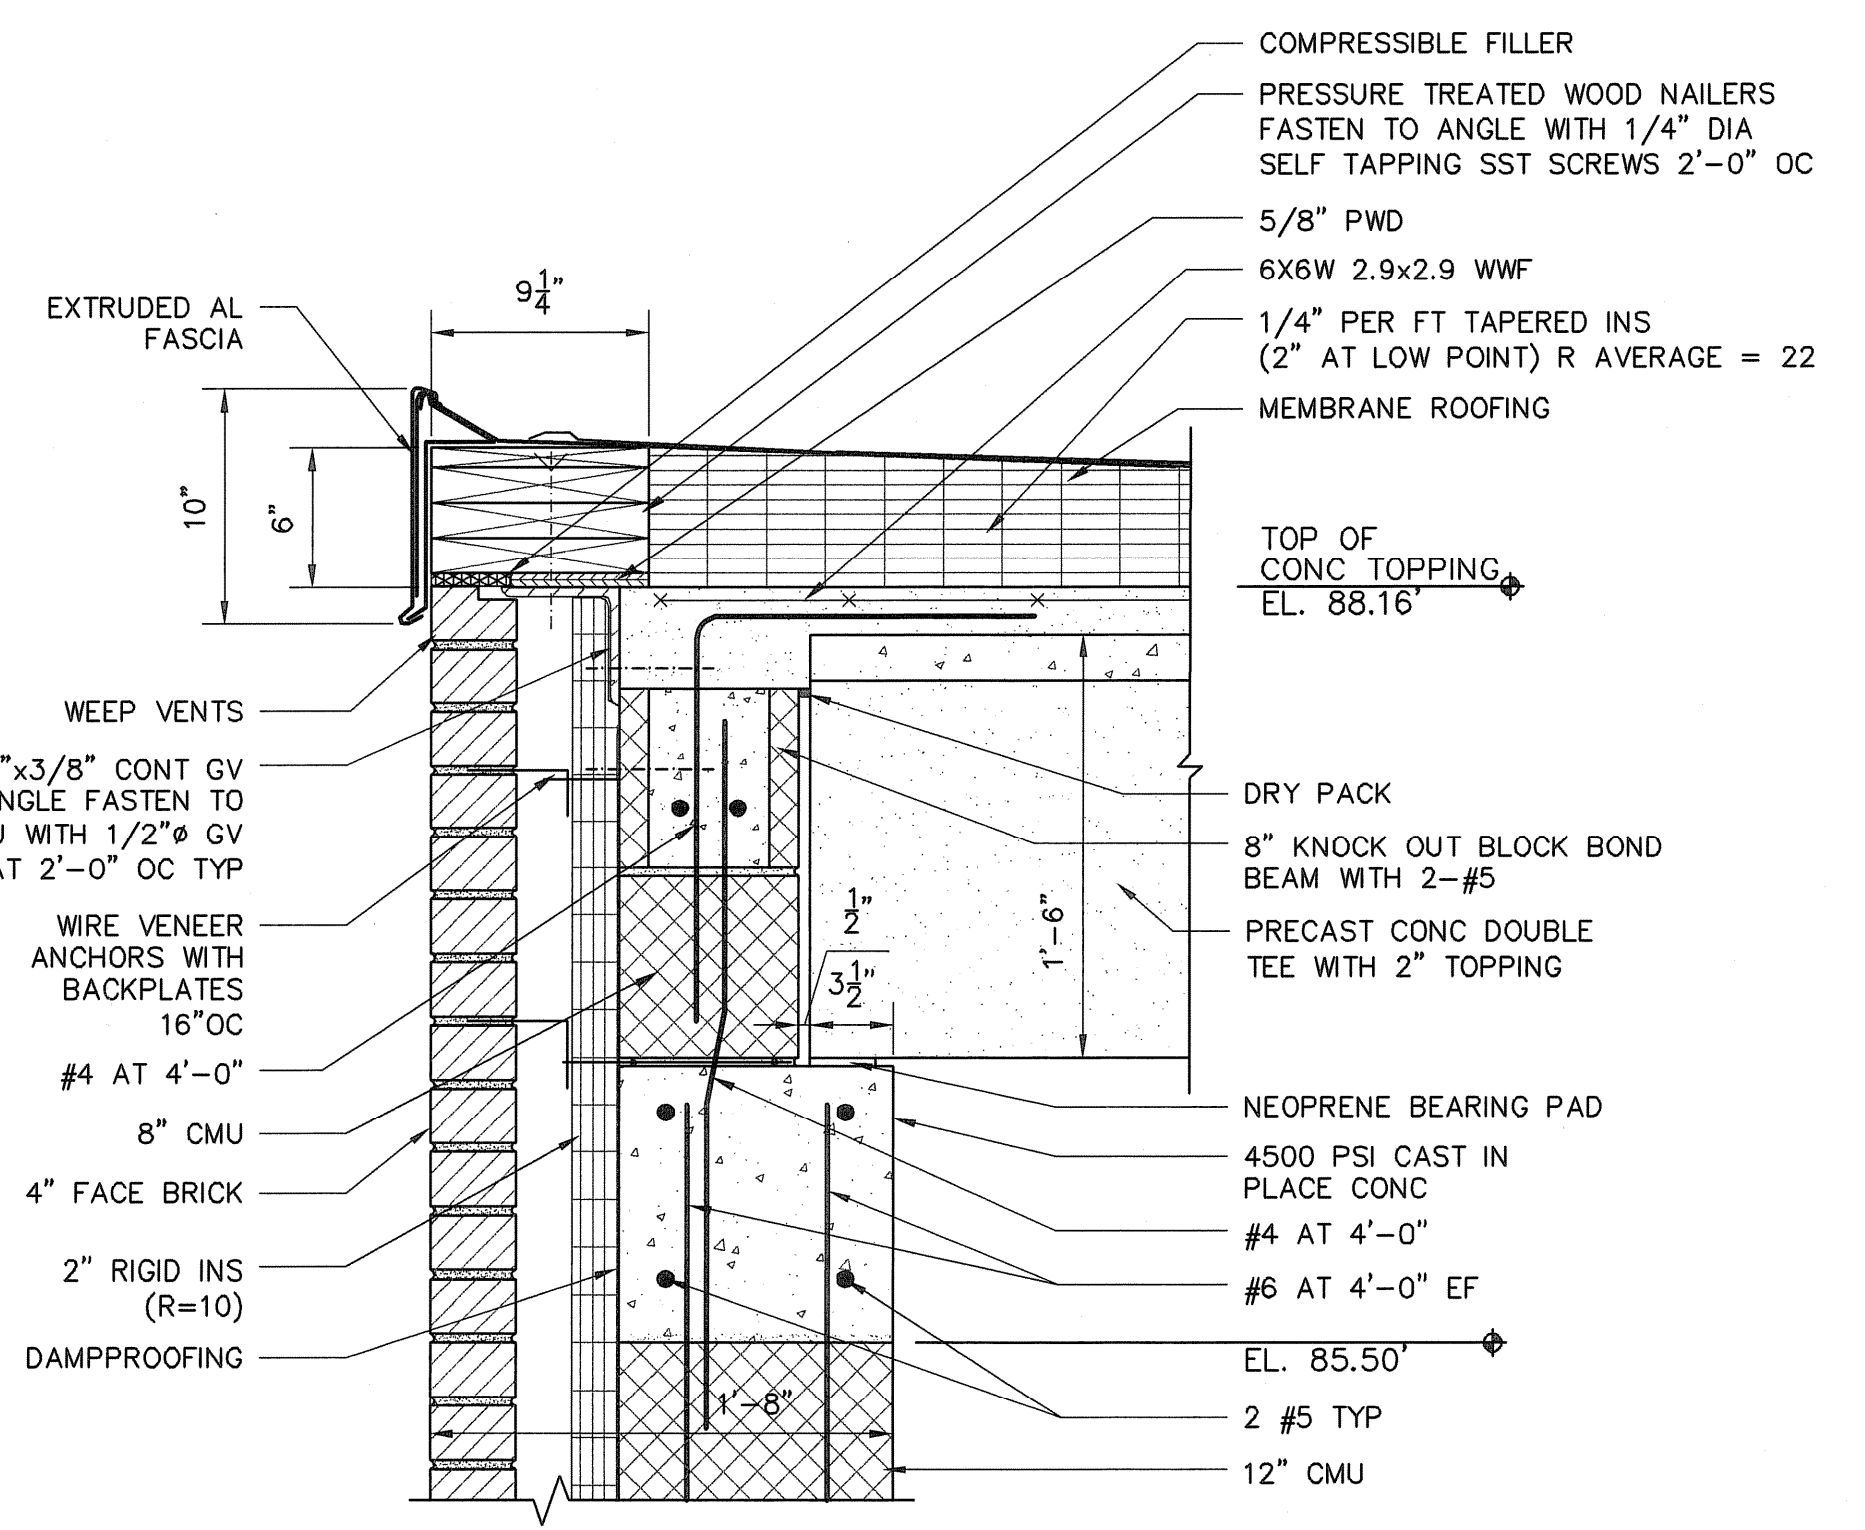


DETAIL 2
 SCALE: 1 1/2" = 1'-0" A-4

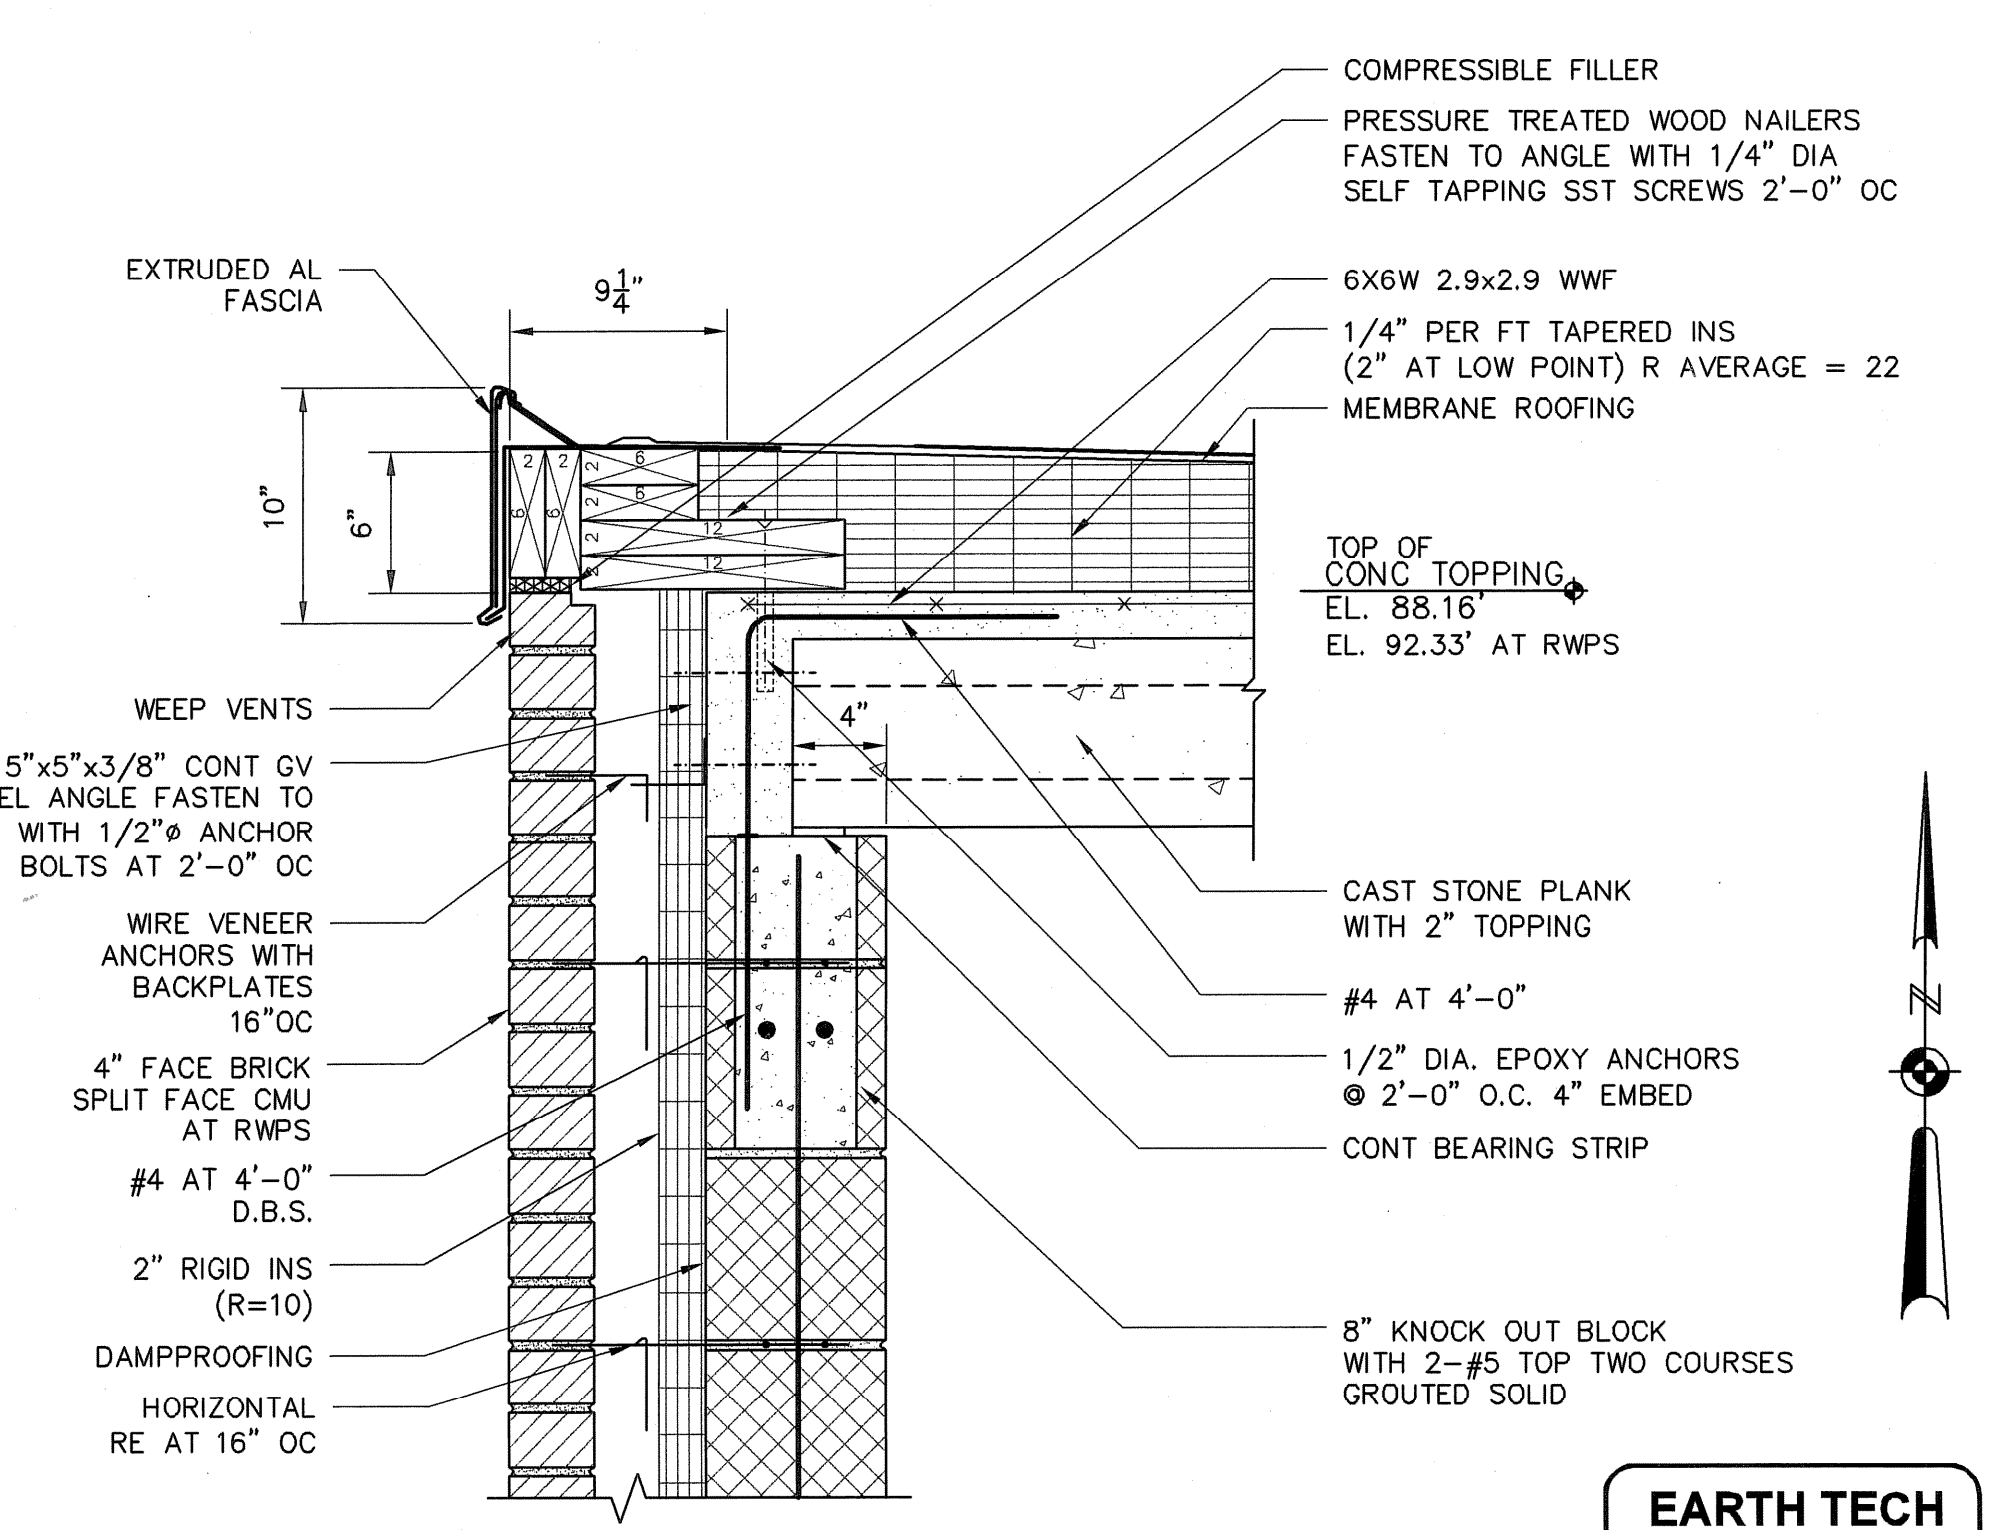

DETAIL 3
 SCALE: 1 1/2" = 1'-0" A-4


NO.	DATE	BY	REVISIONS
2	10/27/08	DRB	AS-BUILT DRAWING FILE
1	10/27/08		ISSUED FOR SET POSTED SET
0	10/28/05		ISSUED FOR CONSTRUCTION
B	8/16/05		REV. B AGENCY REVIEW
A	7/22/05		REV. A CLIENT REVIEW

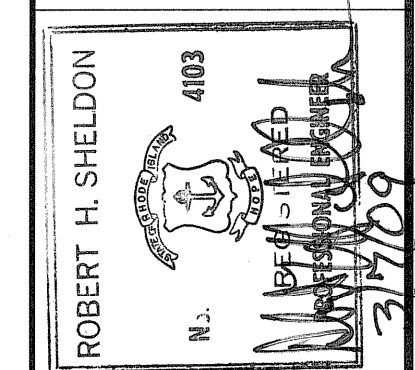


PAWTUCKET, RHODE ISLAND
PAWTUCKET REGIONAL WATER TREATMENT FACILITY
PKGS 11 & 12 - RAW WATER PUMP STATION
 HIGH ROOF PLAN

DESIGNED BY	DWG SCALE
ARN	1/8"=1'-0"
DRAWN BY	CONTRACT NO.
EDC	
CHECKED BY	DATE
ARN	OCTOBER 31, 2008


EARTH TECH
AS-BUILT FILE
 MAY 2008

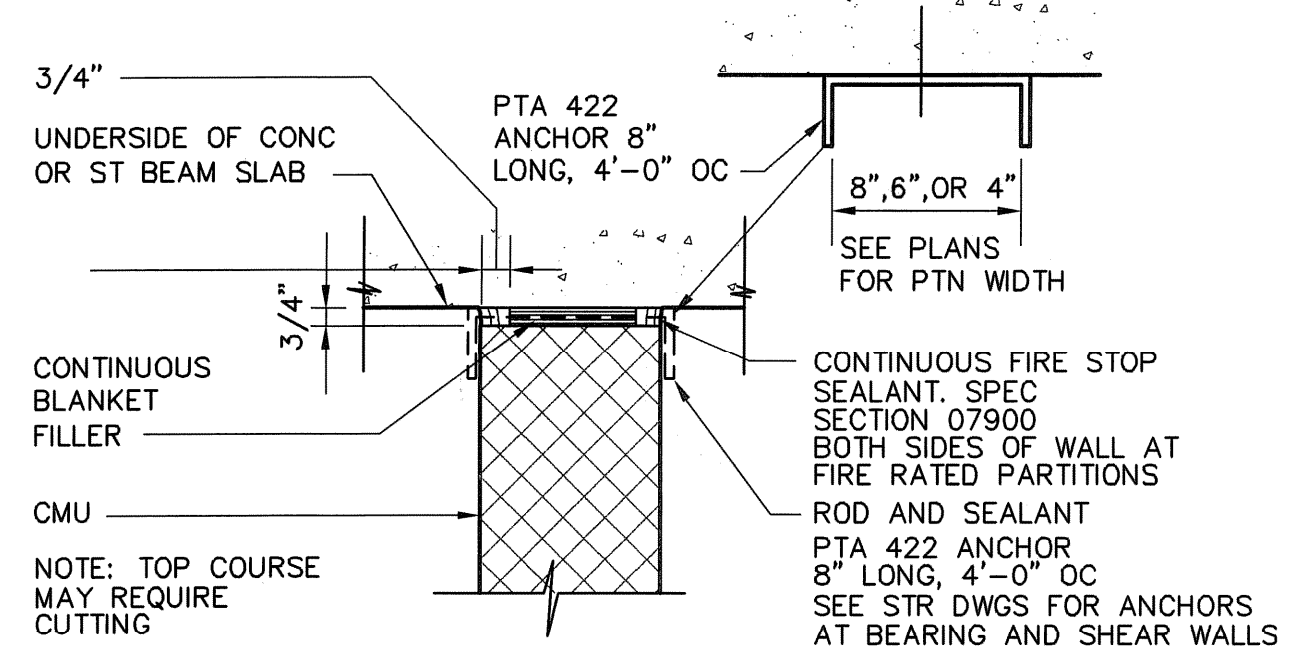


TYPICAL DETAIL (TOP OF CMU WALL) 1
SCALE: 1 1/2"=1'-0"

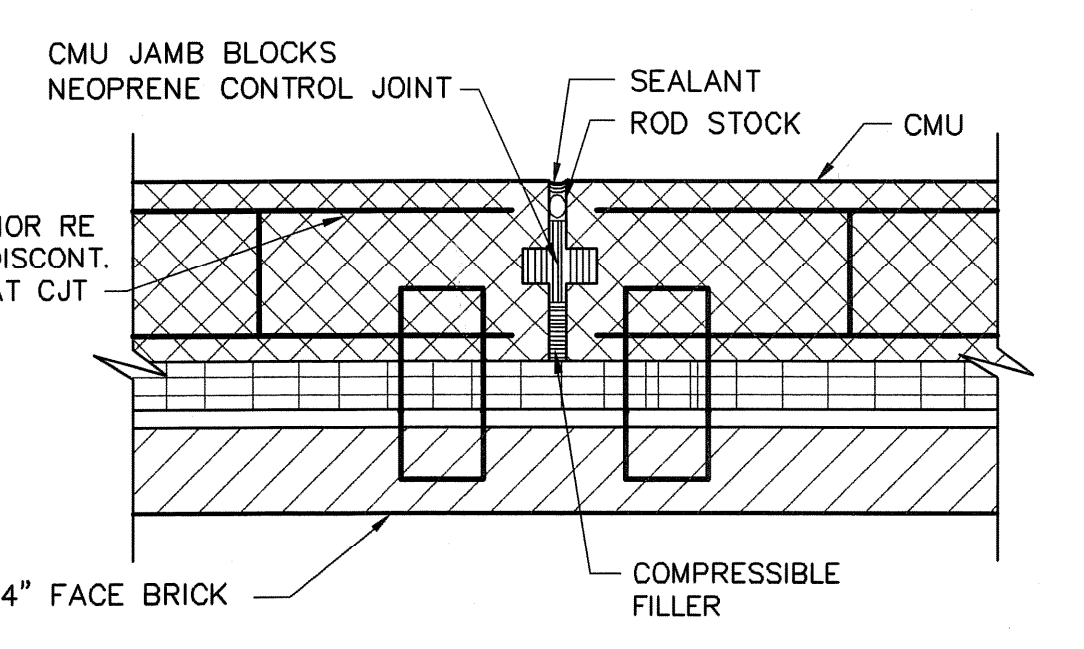


BACK UP MASONRY CONTROL JOINT 2
SCALE: 1 1/2"=1'-0"

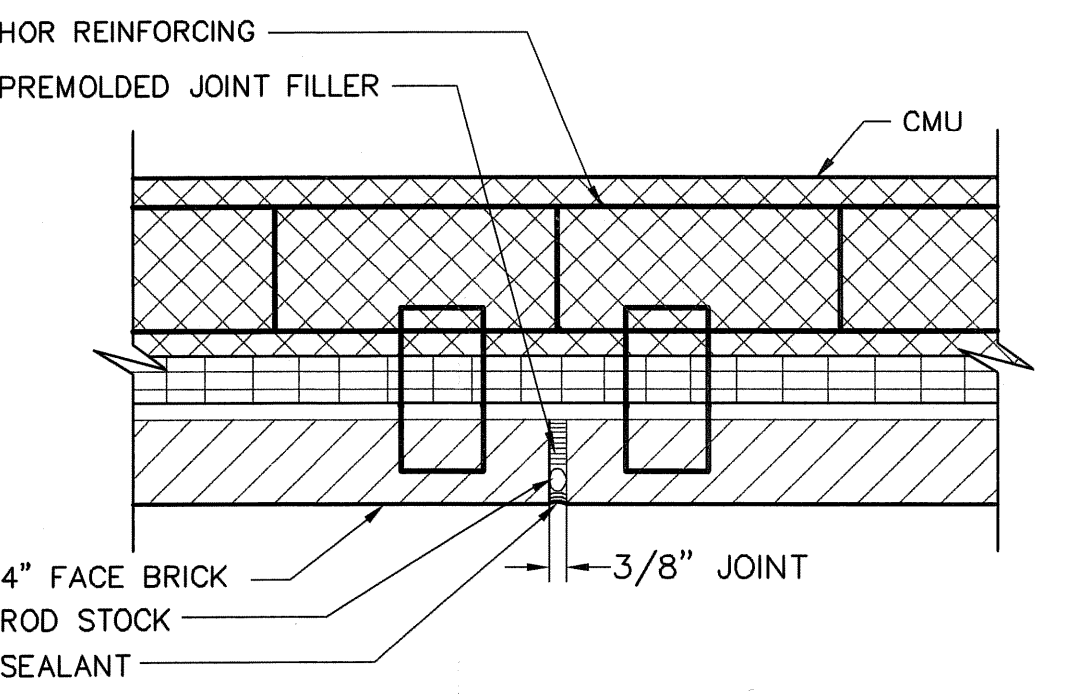


VENEER CONTROL JOINT 3
SCALE: 1 1/2"=1'-0"

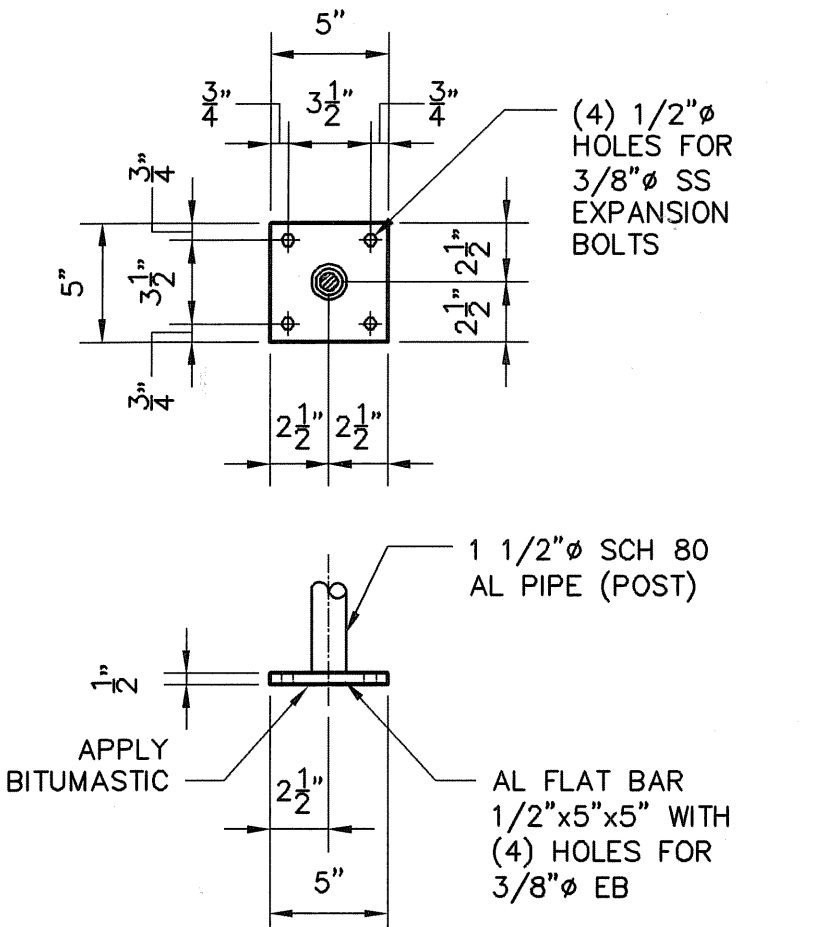


TYP. TOP MOUNTED POST 4
SCALE: 1 1/2"=1'-0"

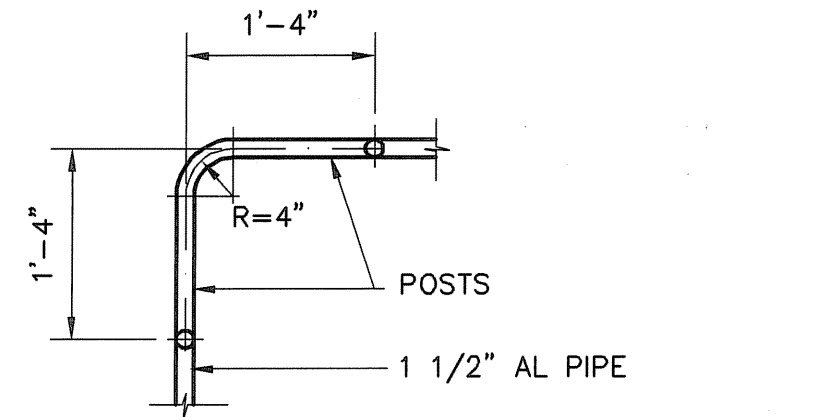


PLAN VIEW OF RAIL AND POSTS AT CORNER 5
SCALE: 3/4"=1'-0"

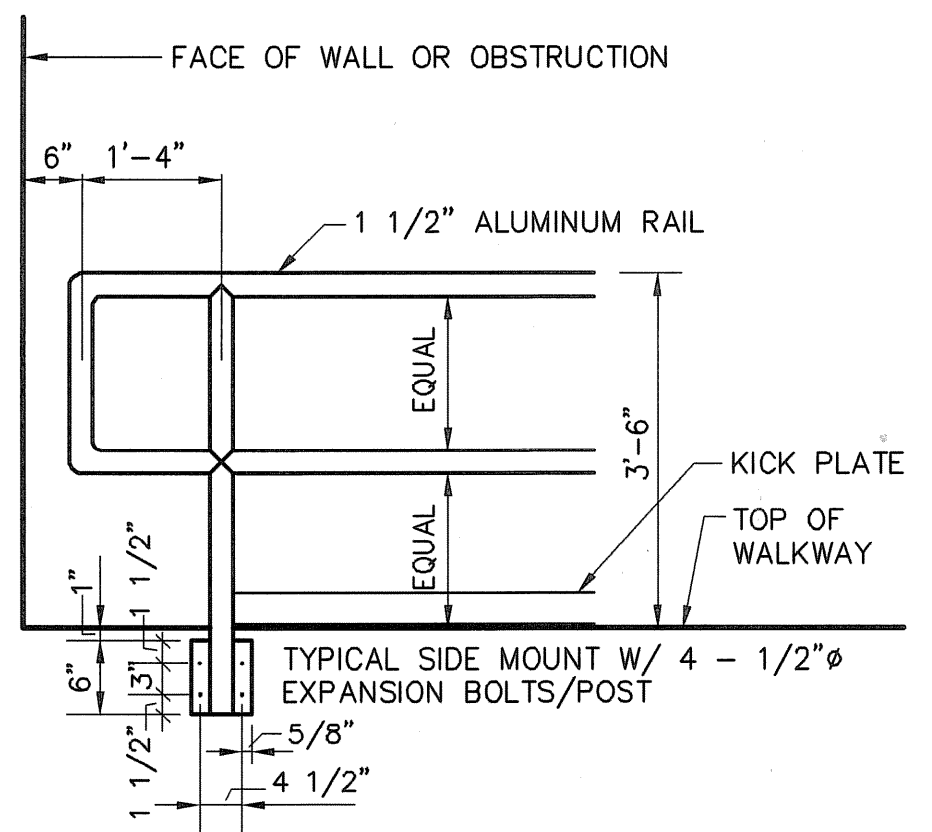


TYPICAL RAILING 6
N.T.S.

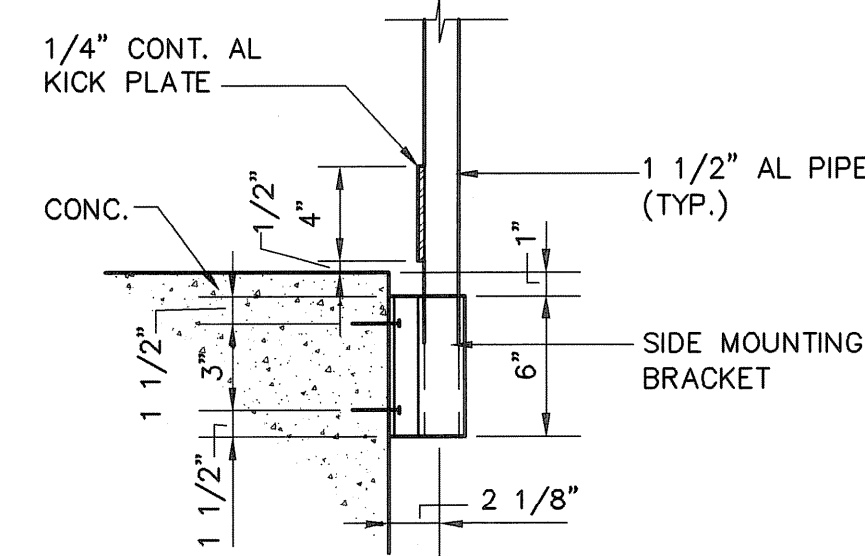


TYP. SIDE MOUNTED POST 7
SCALE: 1 1/2"=1'-0"

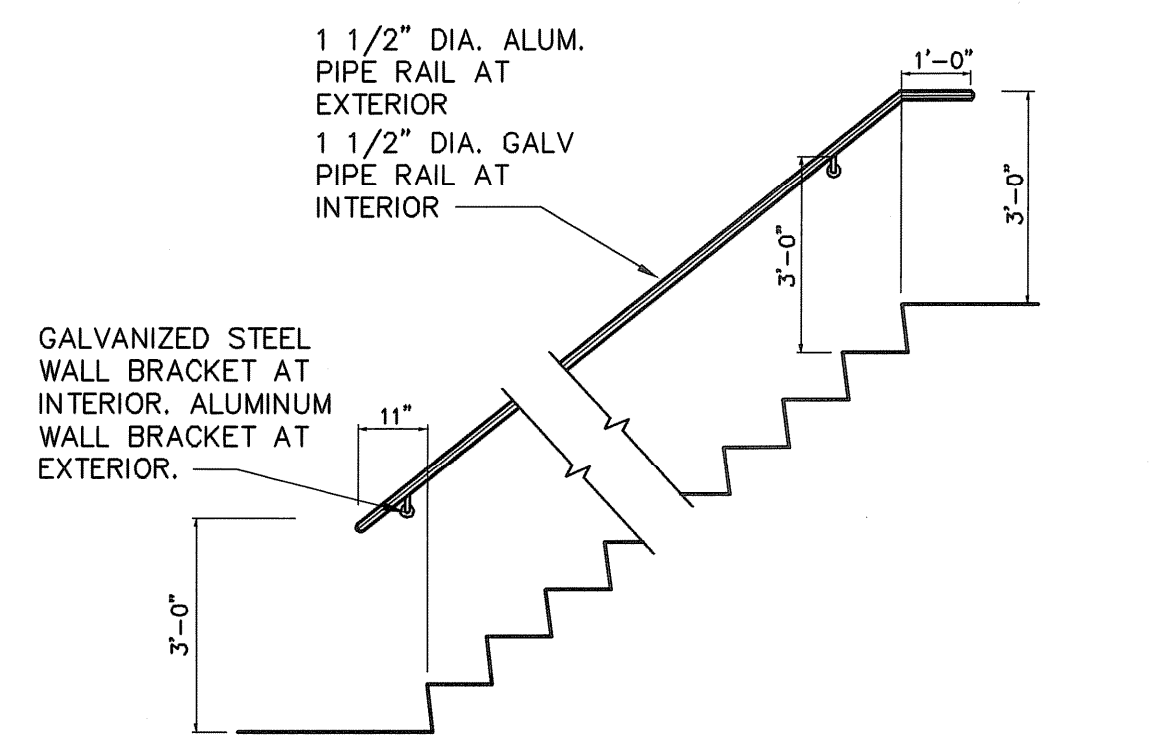


TYP. WALL MOUNTED STAIR HANDRAIL 8
N.T.S.

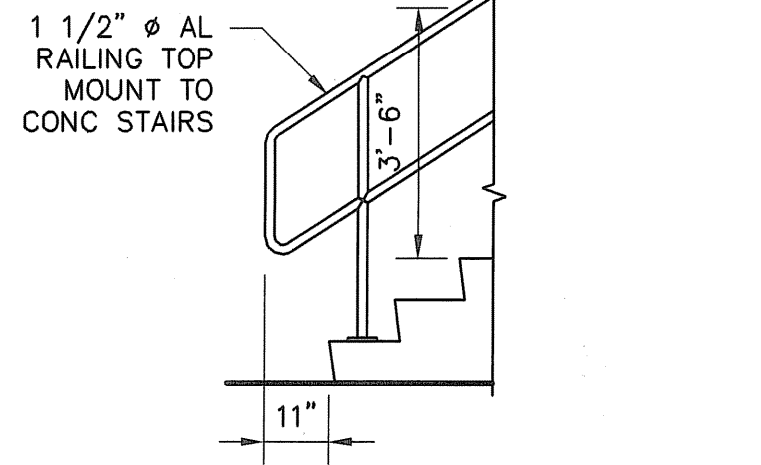


TYP. RAILING AT STAIR 9
SCALE: 3/8"=1'-0"

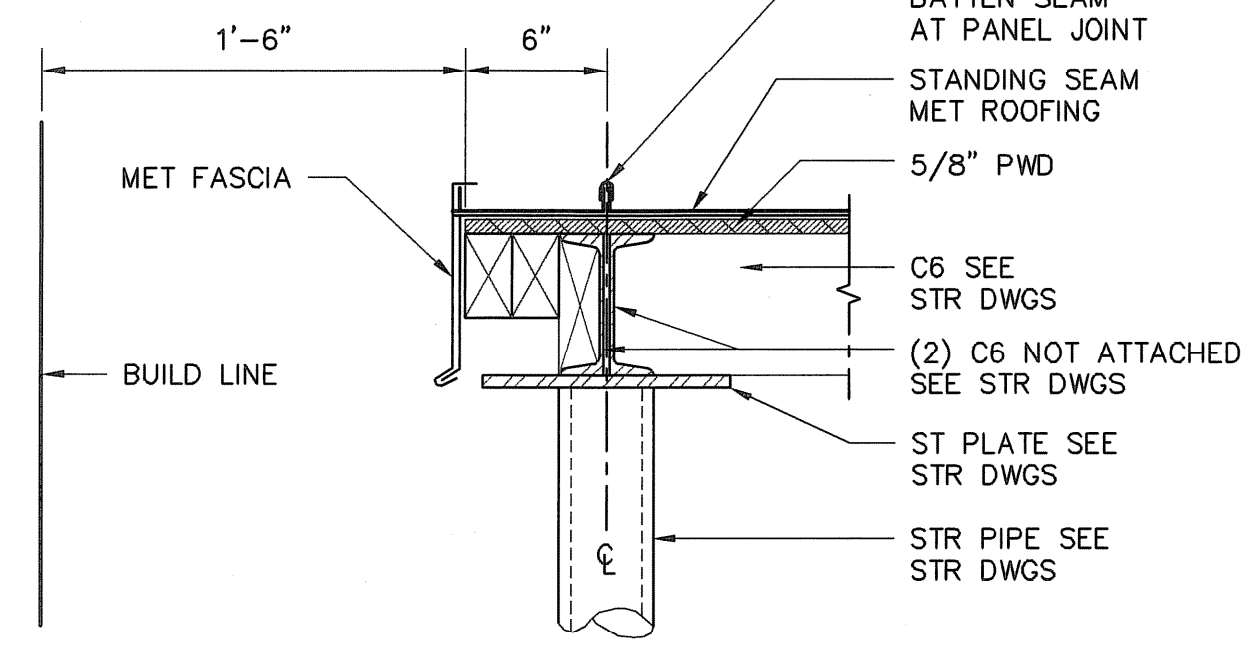


DETAIL GABLE END OF ROOFING/FASCIA 10
SCALE: 1 1/2"=1'-0"

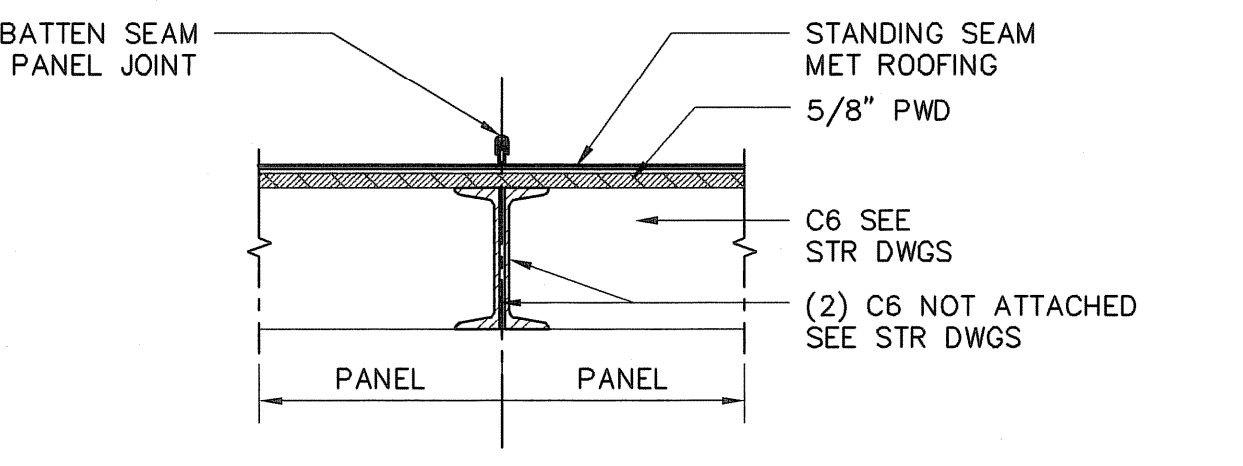


DETAIL PANEL JOINT 11
SCALE: 1 1/2"=1'-0"

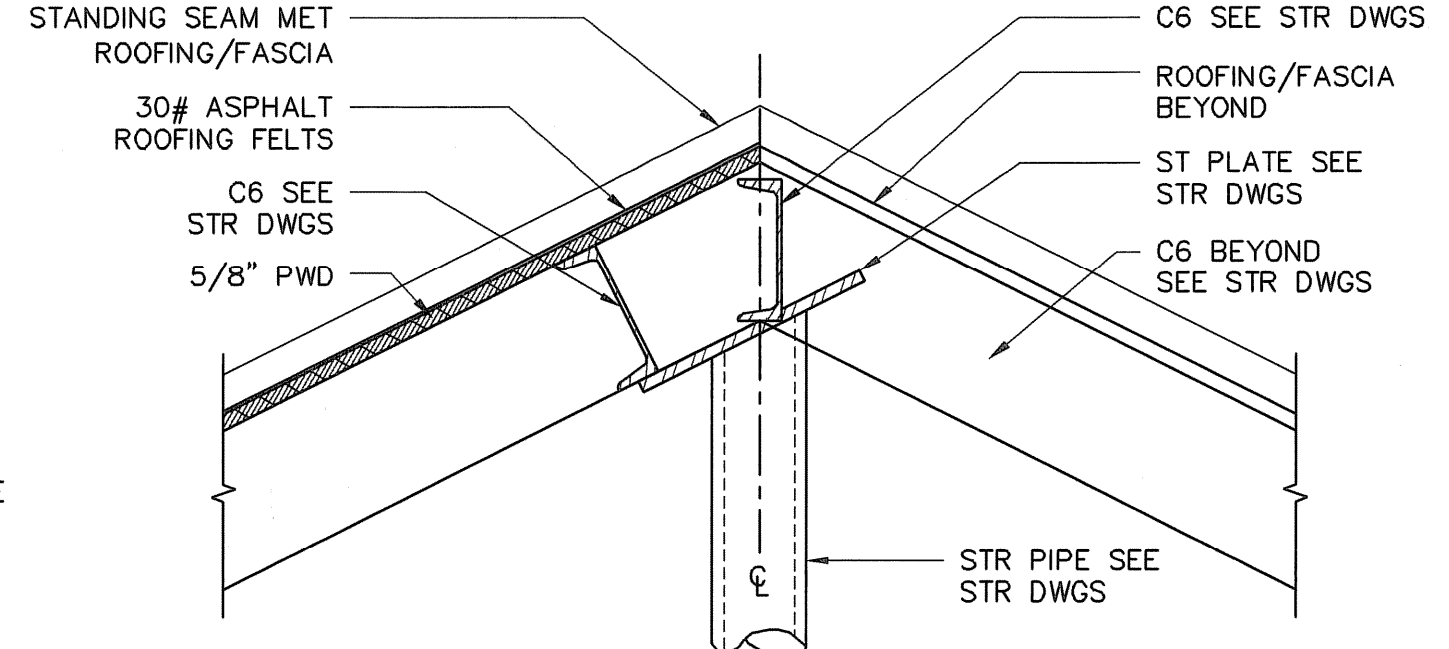


DETAIL AT PEAK 12
SCALE: 1 1/2"=1'-0"

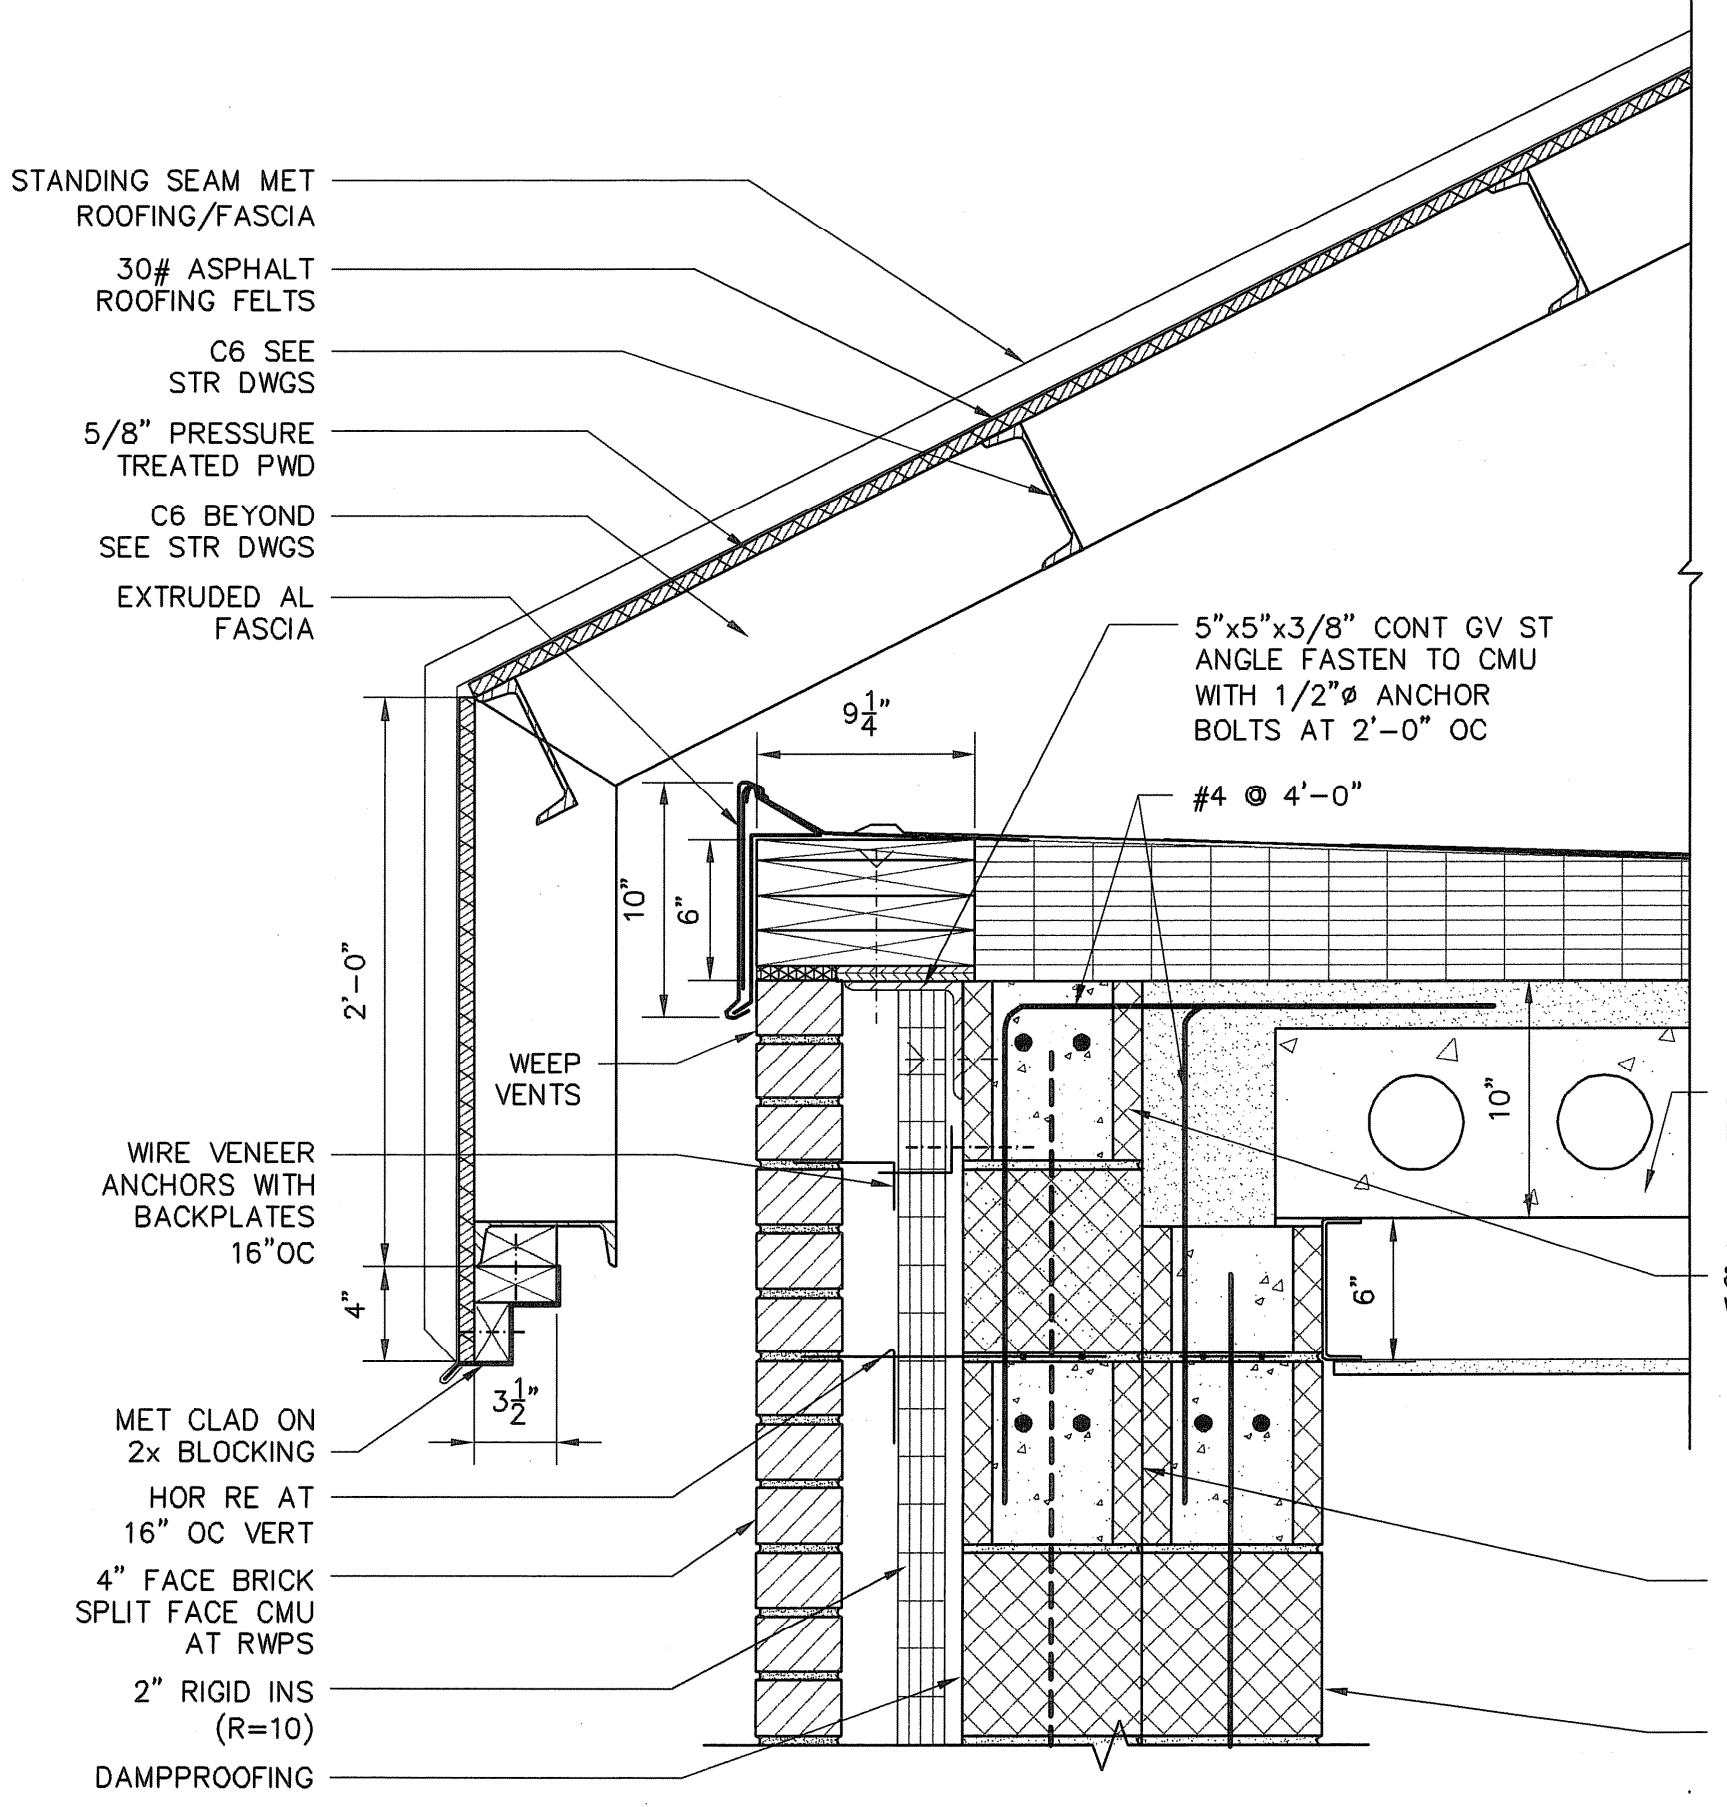






DETAIL AT CANOPY 13
SCALE: 1 1/2"=1'-0"

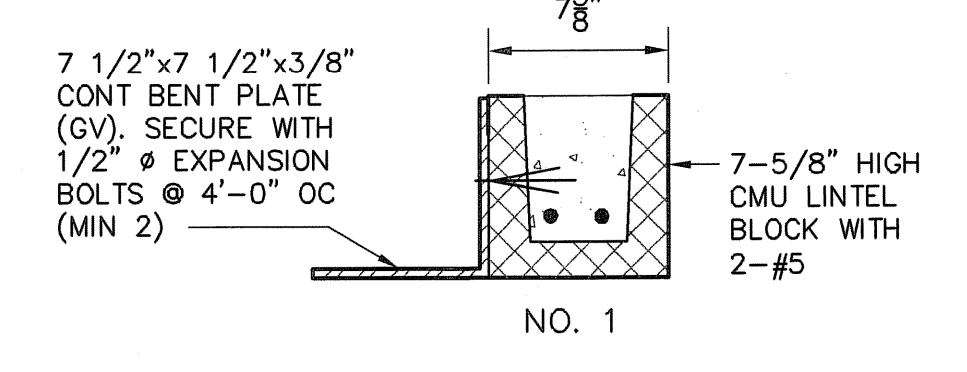

KNOCK OUT PANEL DETAIL 14
SCALE: 1 1/2"=1'-0"

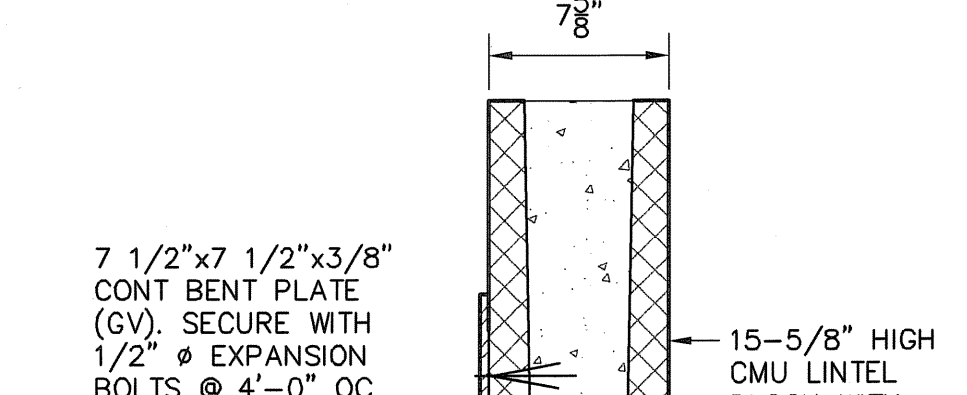


INTERIOR CMU ANCHORAGE TO CONCRETE 15
SCALE: 1 1/2"=1'-0"

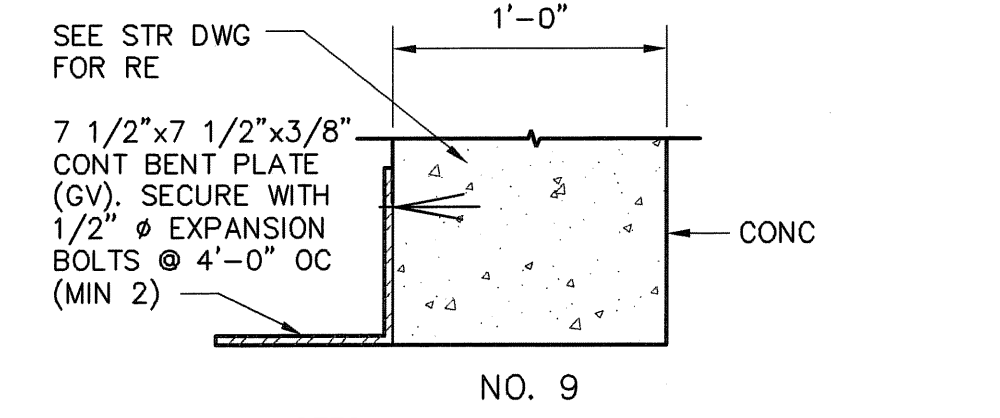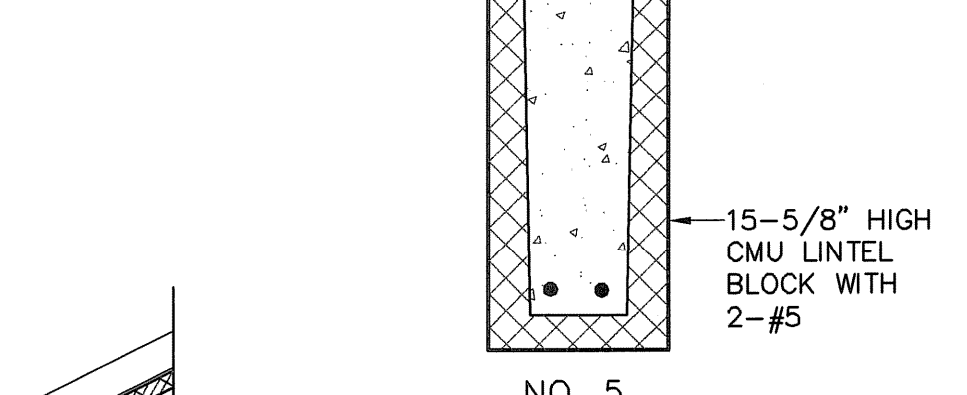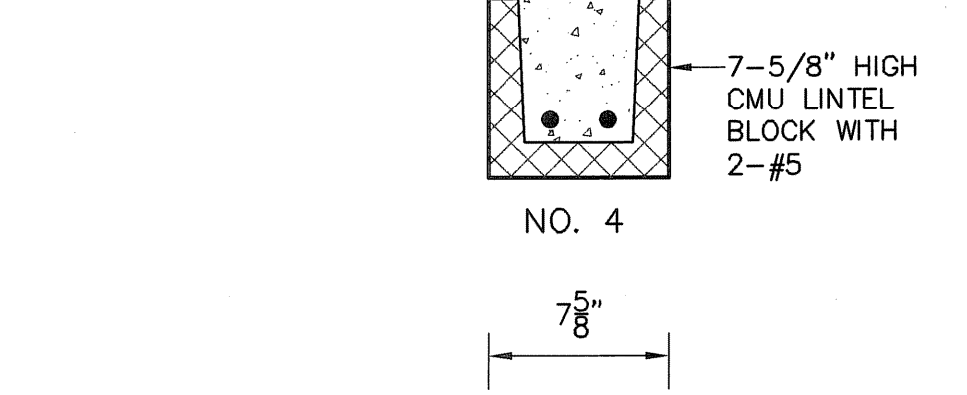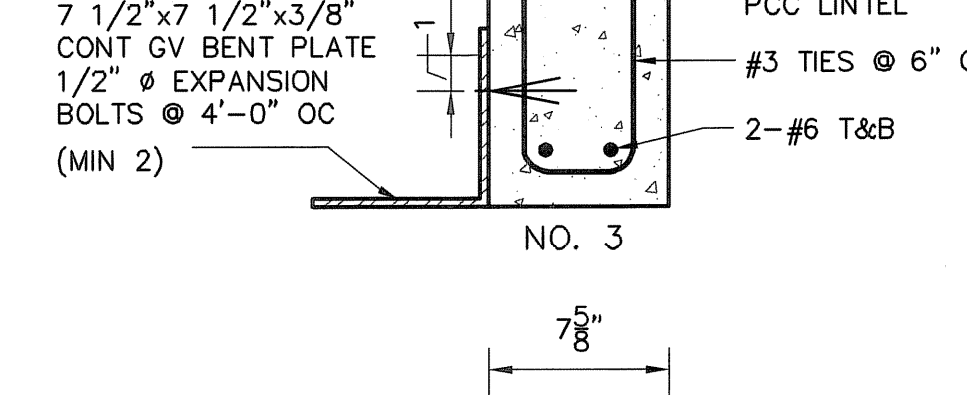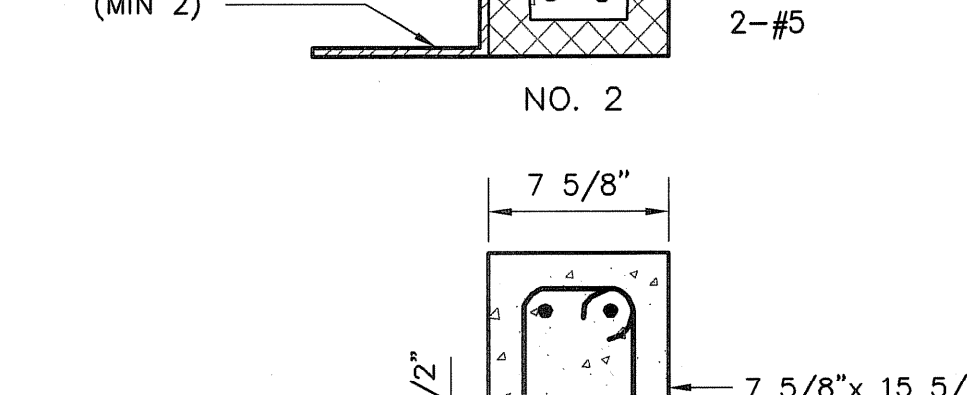


- NOTES:**
1. ALL LINTELS TO HAVE MINIMUM 8" BEARING EACH END EXCEPT AS NOTED.
 2. SEE DOOR HEAD DETAILS ON DWGS A-11 FOR ADDITIONAL LOOSE STEEL LINTEL ANGLES WHERE APPLICABLE.
 3. SEE LOUVER HEAD DETAILS ON DWG A-11 FOR ADDITIONAL LOOSE STEEL LINTEL ANGLES WHERE APPLICABLE.

CONCRETE/MASONRY LINTEL SCHED
SCALE: 1 1/2"=1'-0"

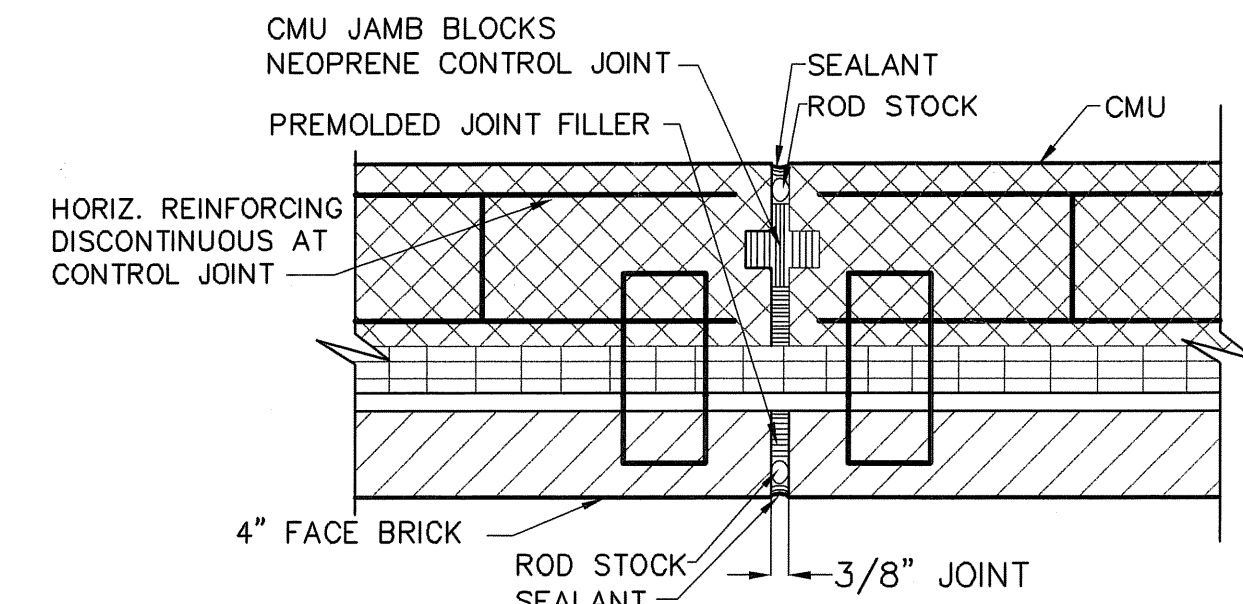

KNOCK OUT PANEL DETAIL 14
SCALE: 1 1/2"=1'-0"

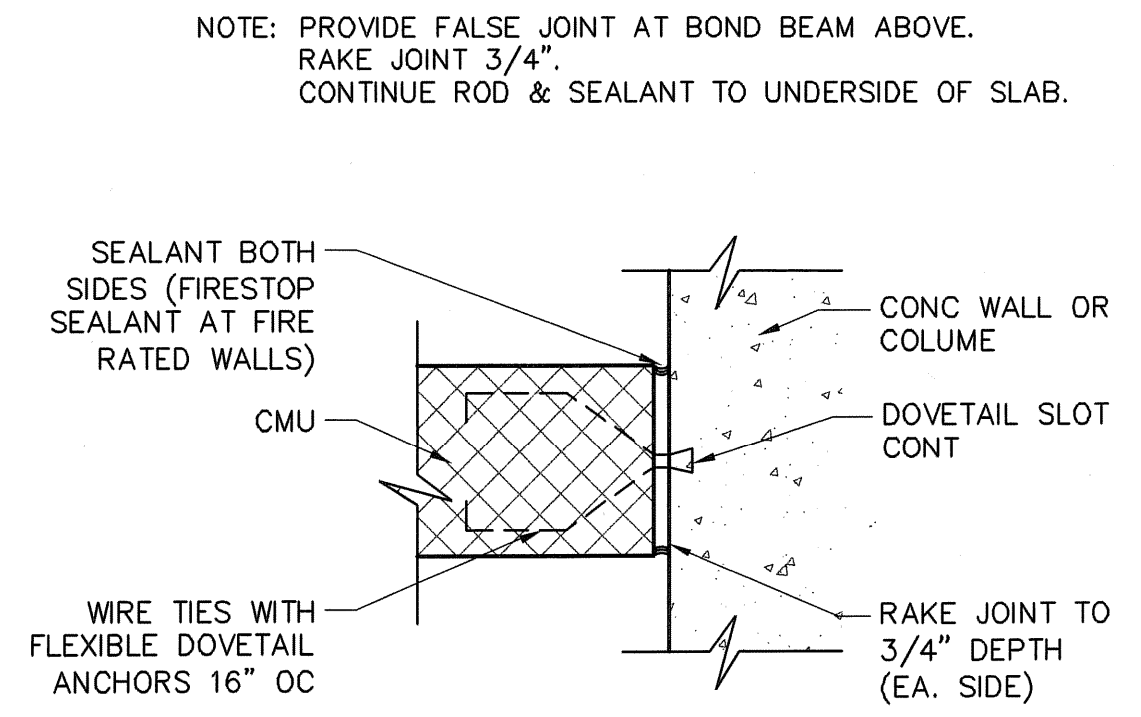


DETAIL 15
SCALE: 1 1/2"=1'-0"

EARTH TECH AS-BUILT FILE MAY 2008


NO.	DATE	BY	REVISIONS
2	MAY 2008	AR	AS-BUILT DRAWING FILE
1	10/31/06	AR	ISSUED FOR RFI POSTED SET
0	10/28/05	AR	ISSUED FOR CONSTRUCTION
B	9/16/05	AR	REV. B AGENCY REVIEW
A	7/22/05	AR	REV. A CLIENT REVIEW

ROBERT H. SHELDON
No. 4103
7/10/09


DESIGNED BY	DWG SCALE
ARN	AS NOTED
DRAWN BY	CONTRACT NO.
EDD	
CHECKED BY	DATE
ARN	OCTOBER 31, 2008

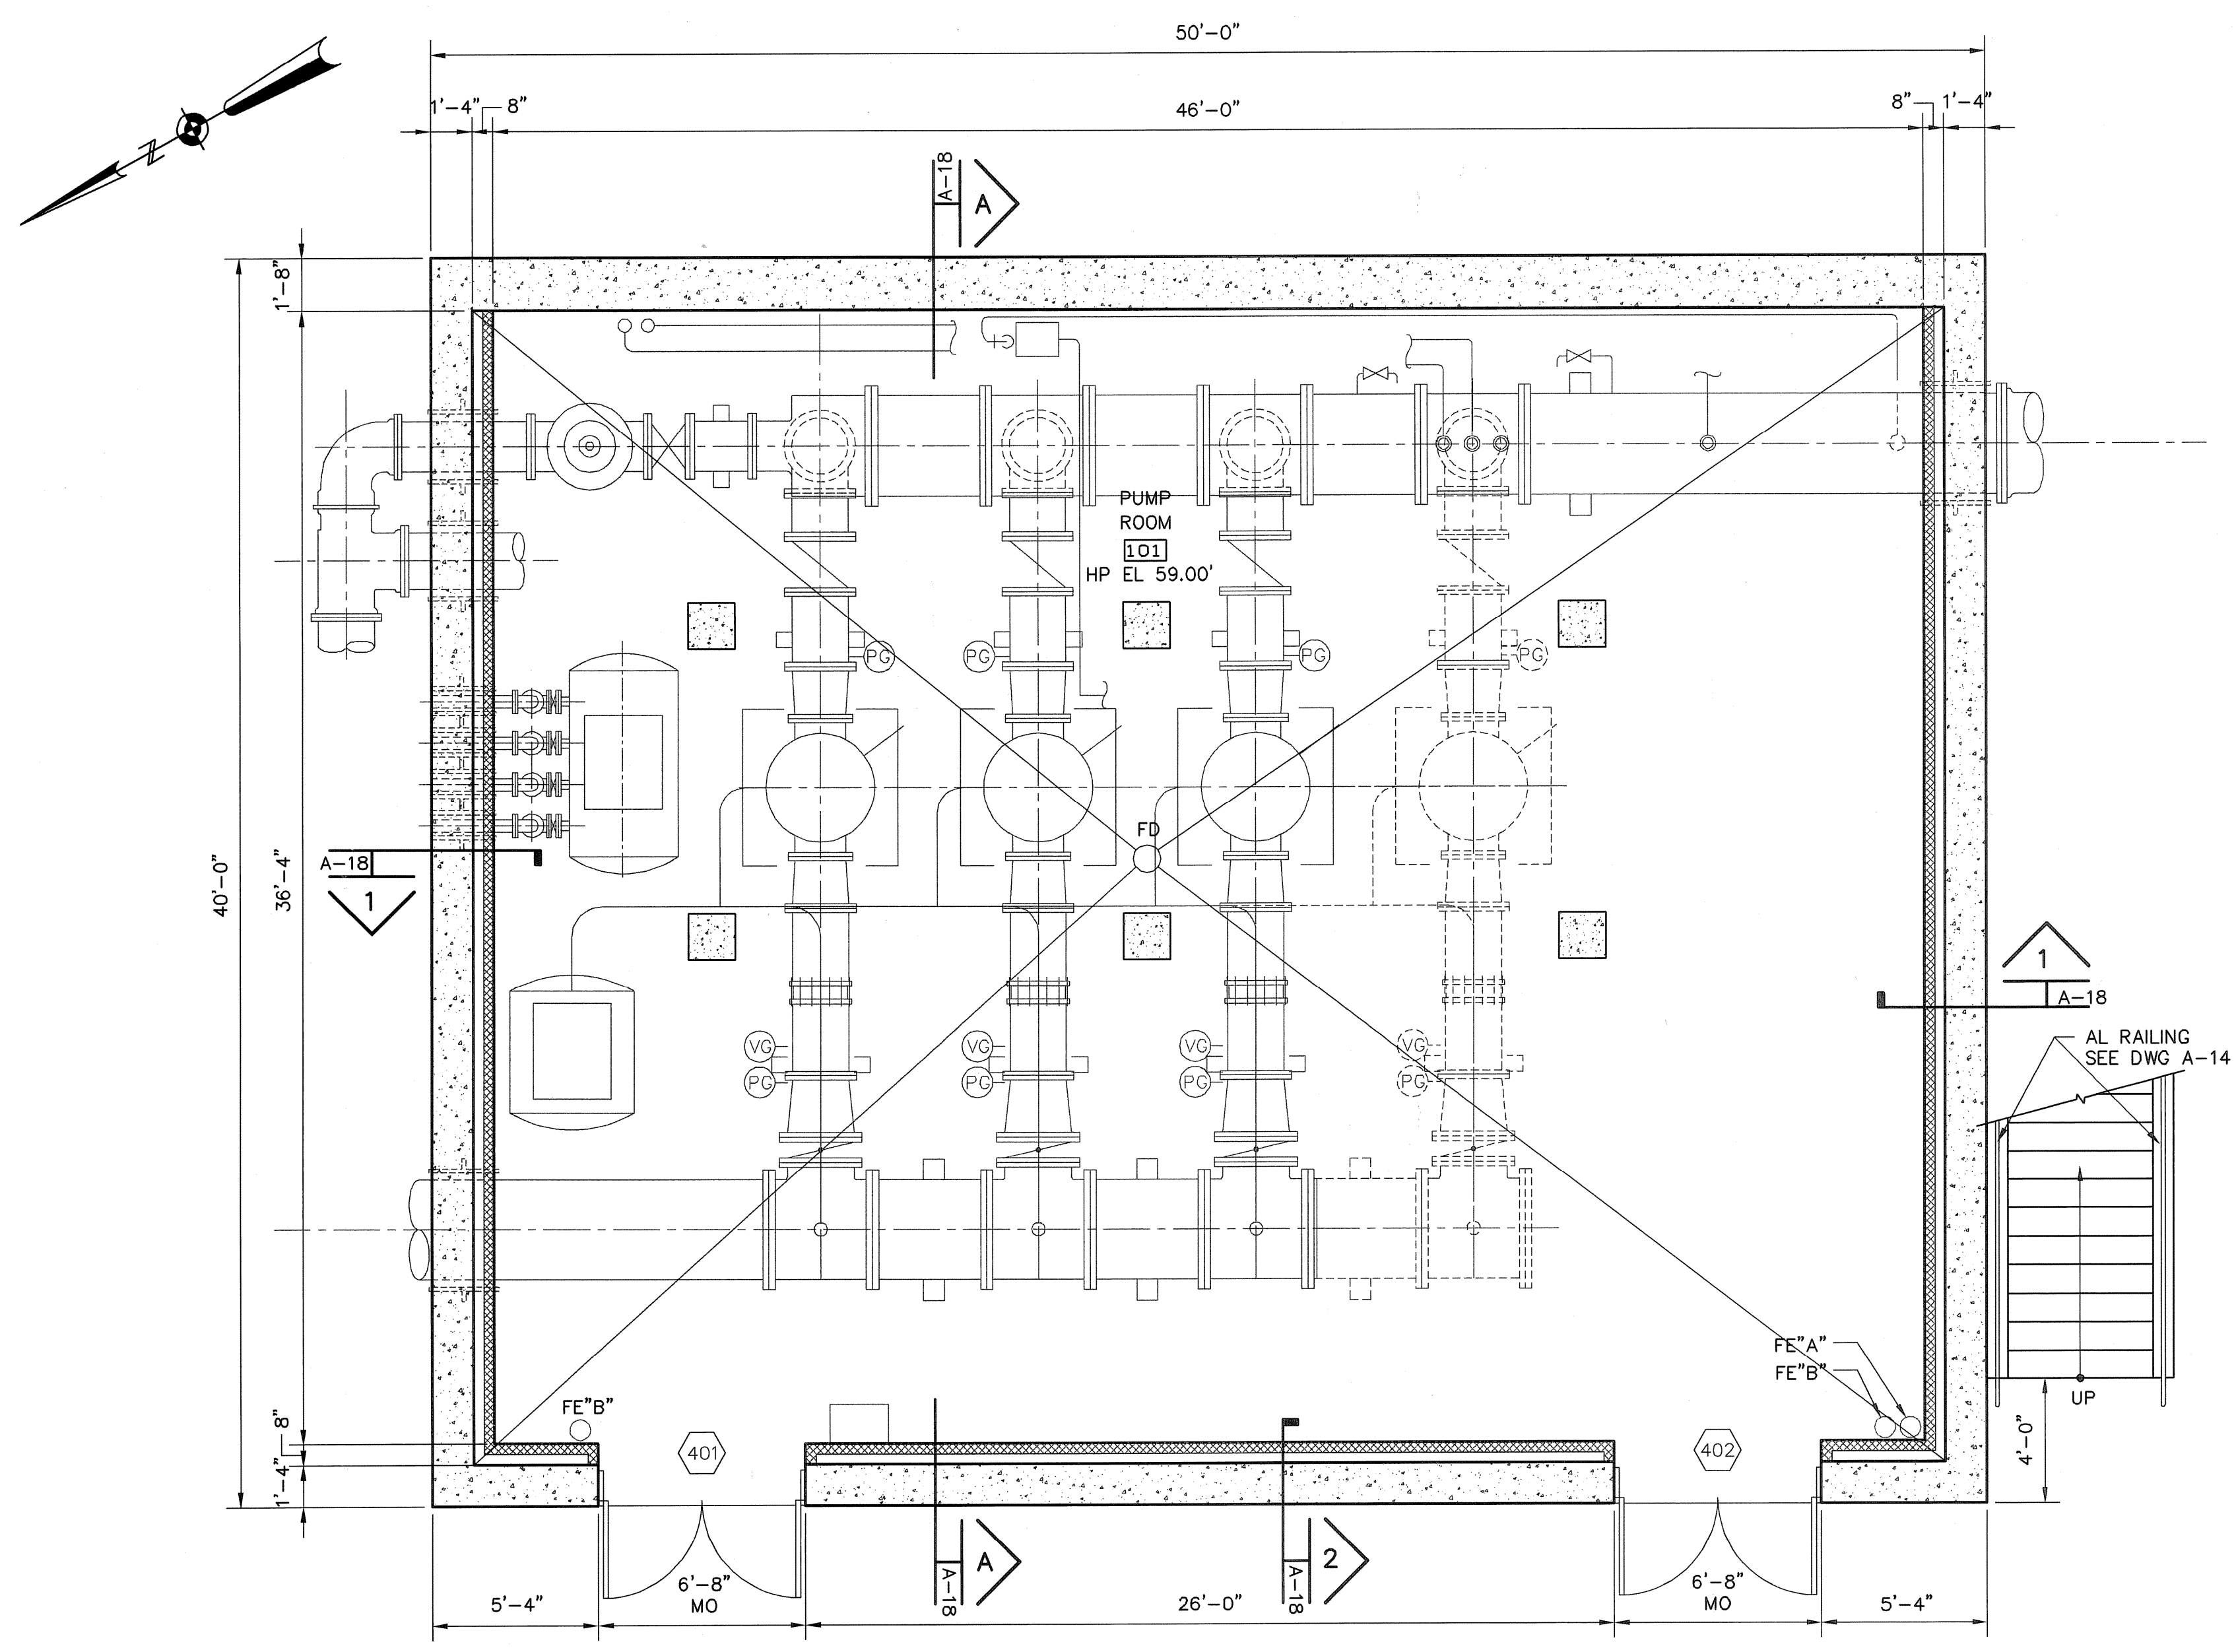


PUMP LEVEL FLOOR PLAN - EL. 59.00'
SCALE: 1/4" = 1'-0"

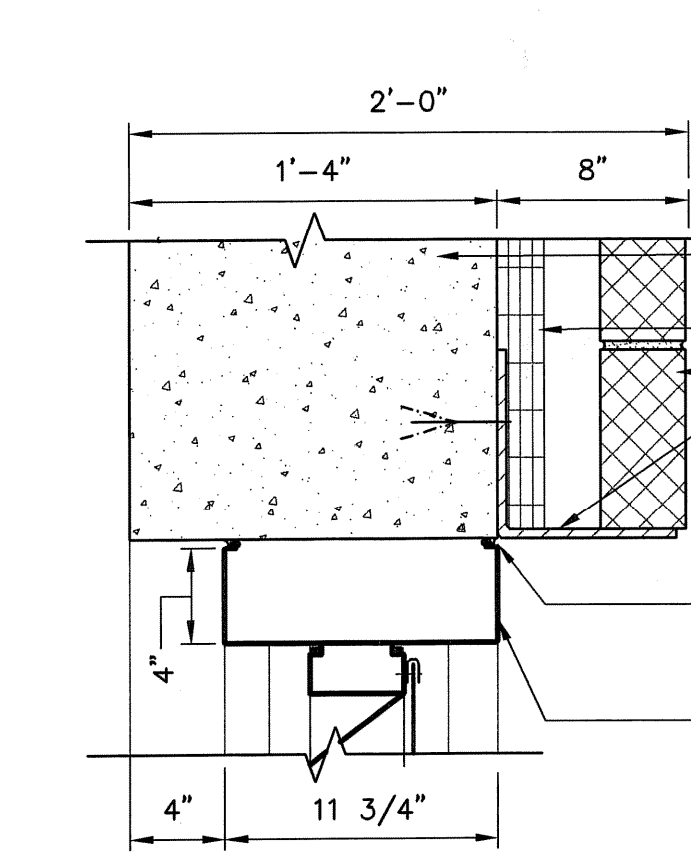


DETAIL (HEAD) 1
SCALE: 1 1/2" = 1'-0" (A-17)

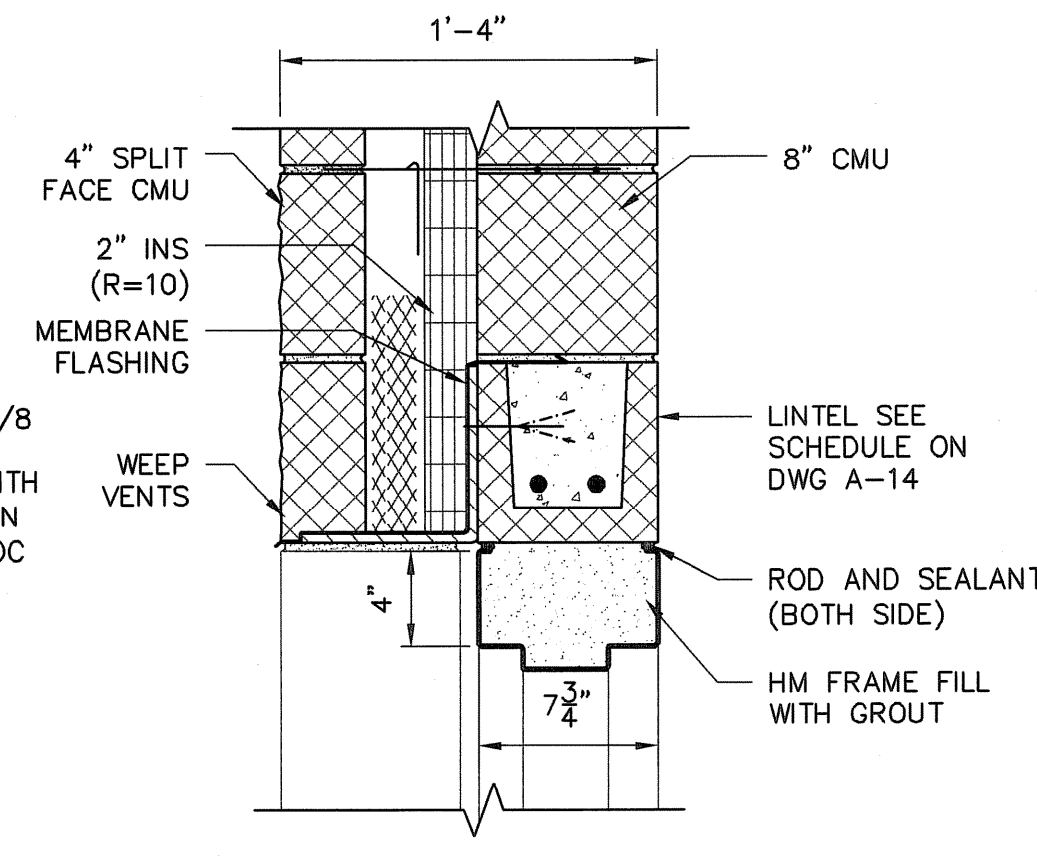


DETAIL (HEAD) 3
SCALE: 1 1/2" = 1'-0" (A-17)

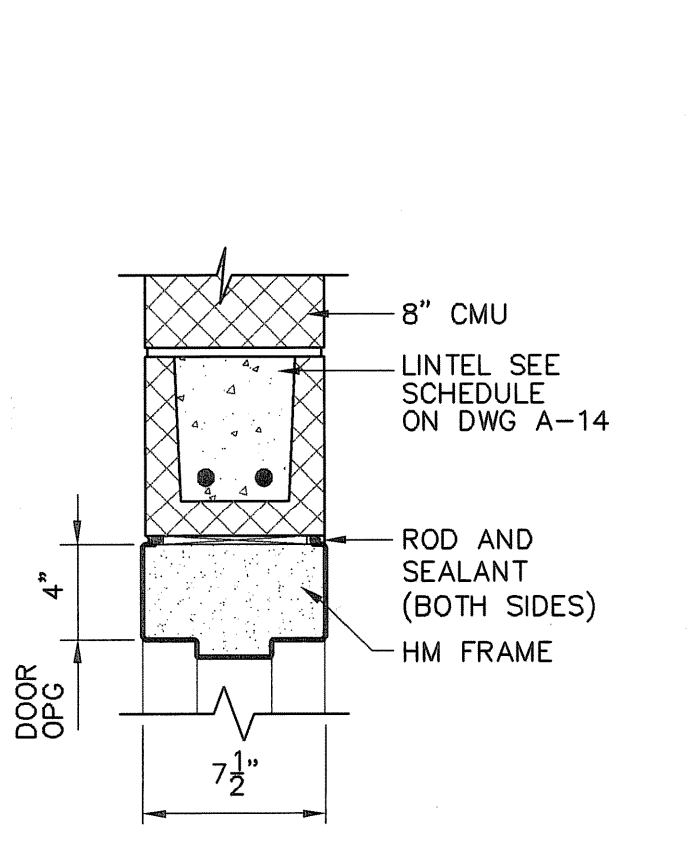


DETAIL (HEAD) 5
SCALE: 1 1/2" = 1'-0" (A-17)

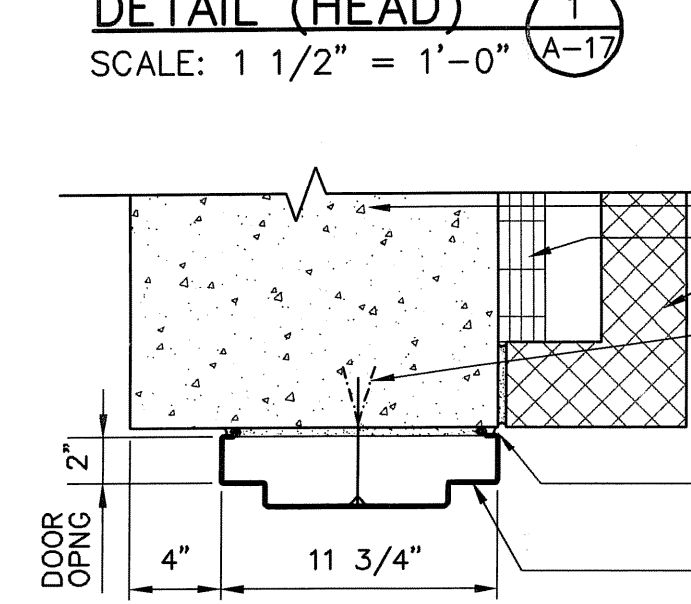


DETAIL (JAMB) 2
SCALE: 1 1/2" = 1'-0" (A-17)

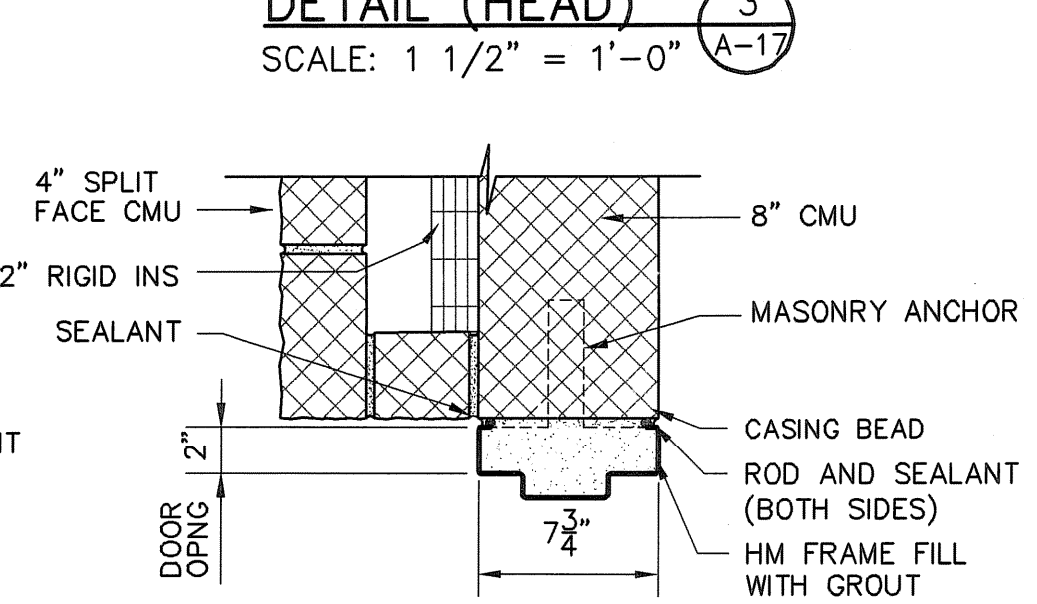


DETAIL (JAMB) 4
SCALE: 1 1/2" = 1'-0" (A-17)

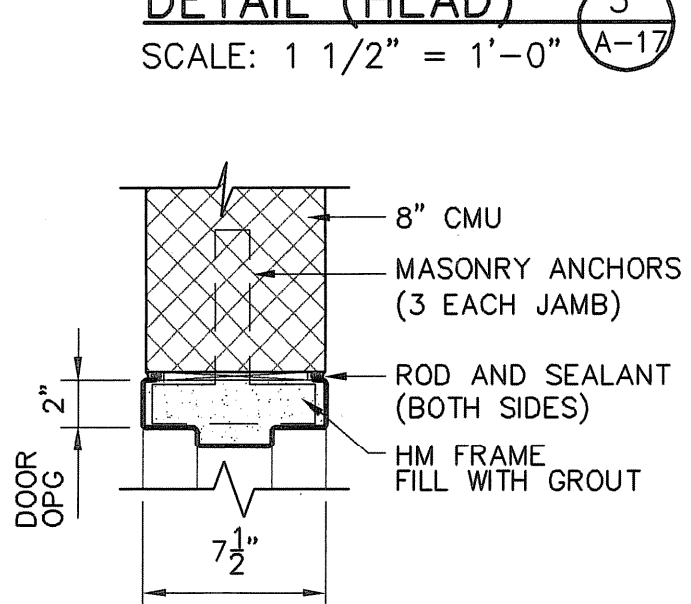


DETAIL (JAMB/SILL) 6
SCALE: 1 1/2" = 1'-0" (A-17)

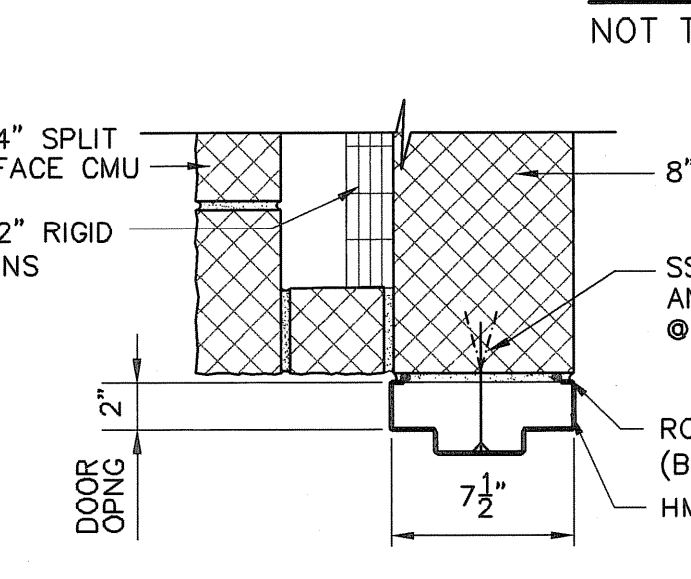


DETAIL (JAMB) 7
SCALE: 1 1/2" = 1'-0" (A-17)

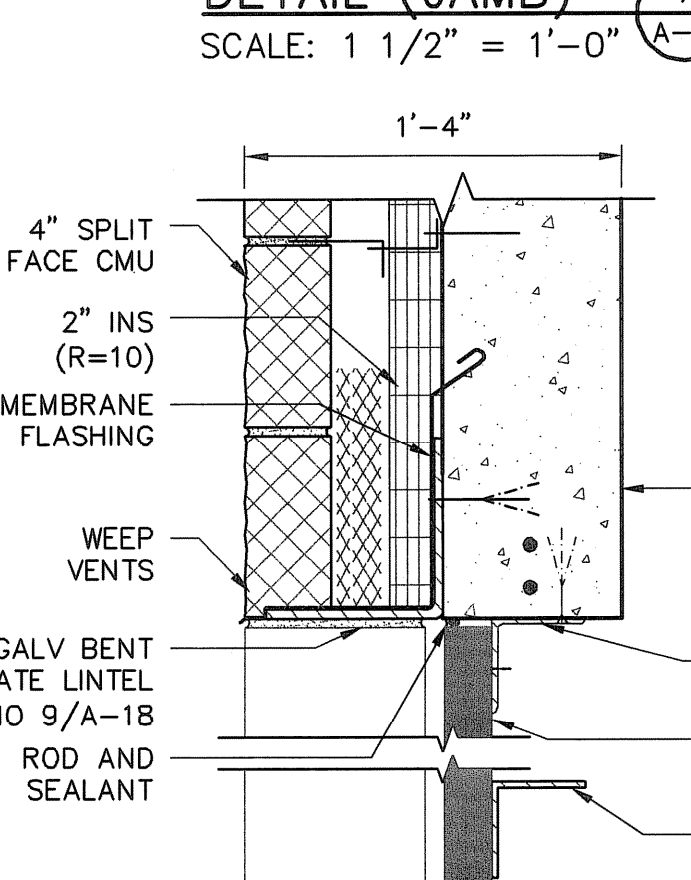



DETAIL (HEAD) 8
SCALE: 1 1/2" = 1'-0" (A-17)

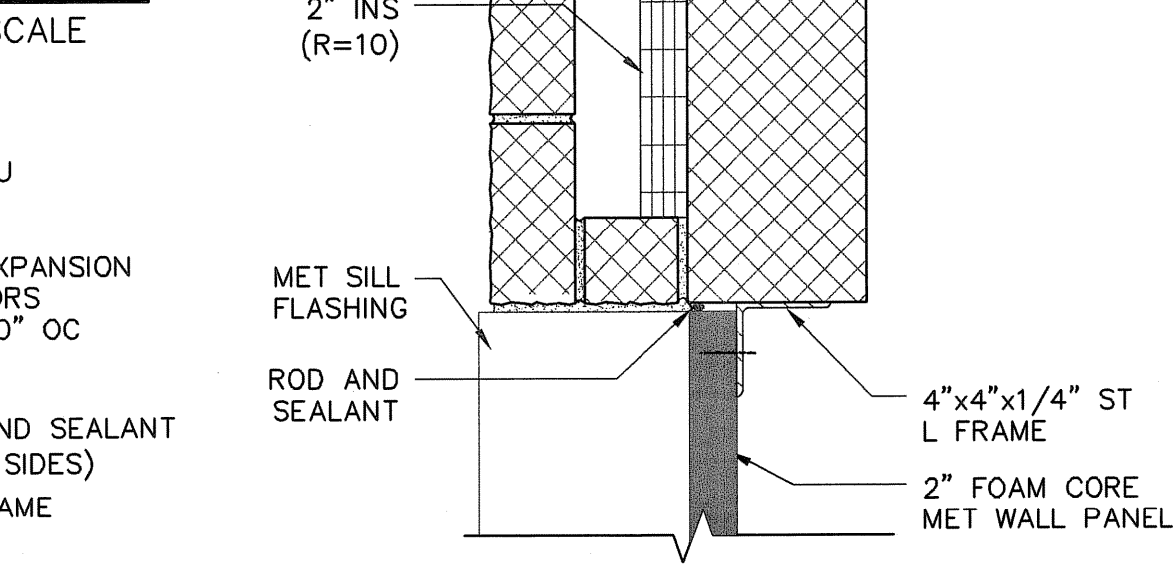


DETAIL (JAMB) 9
SCALE: 1 1/2" = 1'-0" (A-17)

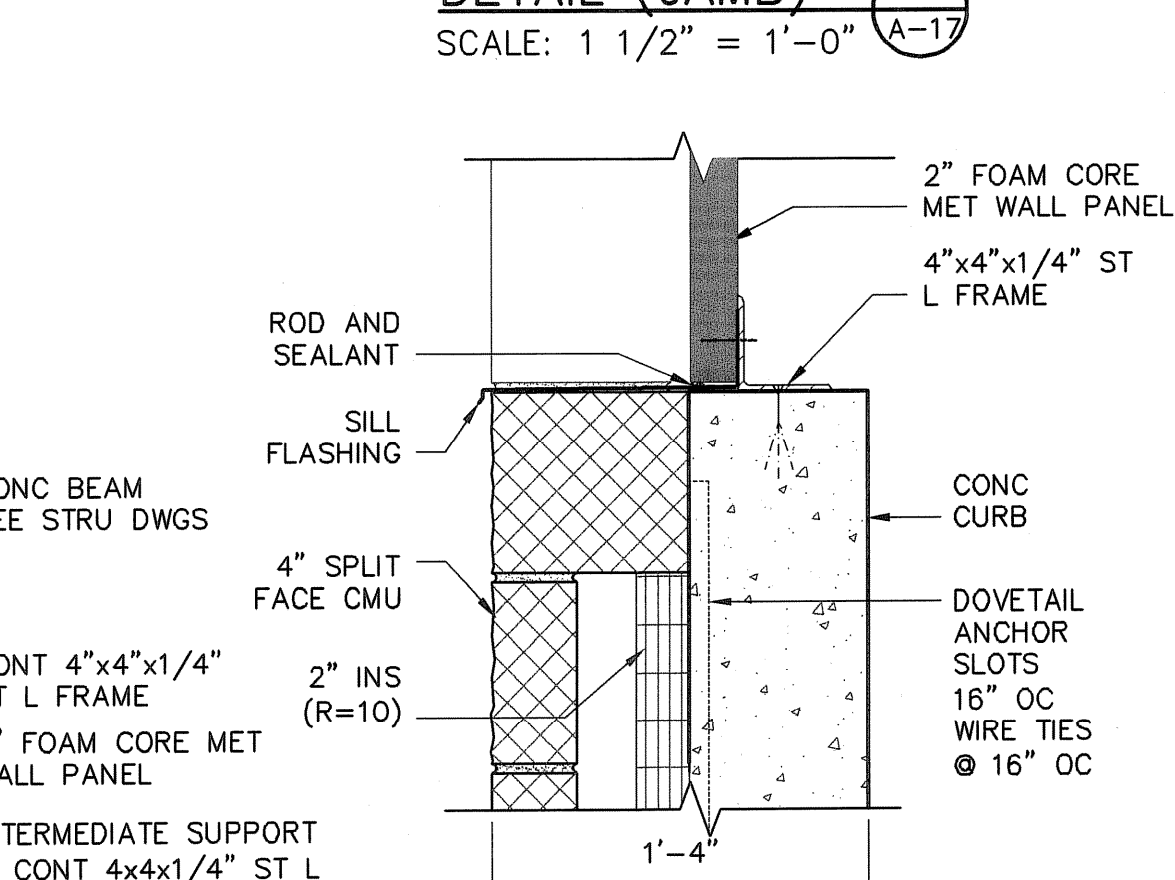

DETAIL (SILL) 10
SCALE: 1 1/2" = 1'-0" (A-17)

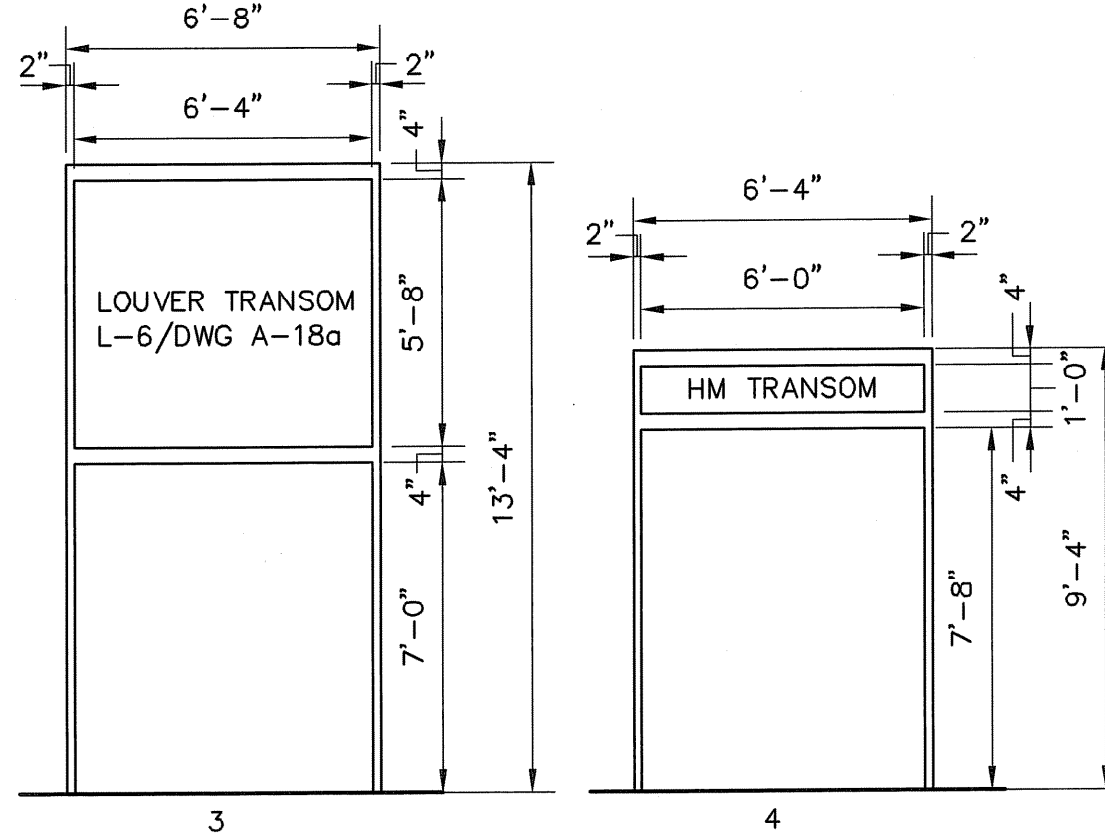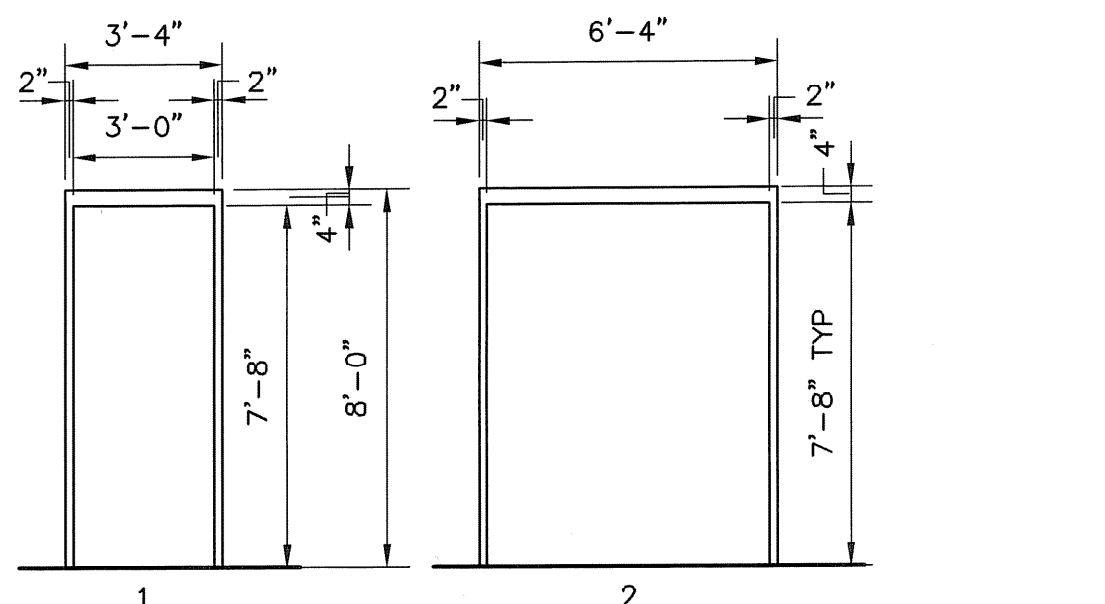

FRAME TYPES
SCALE: 1/4" = 1'-0"

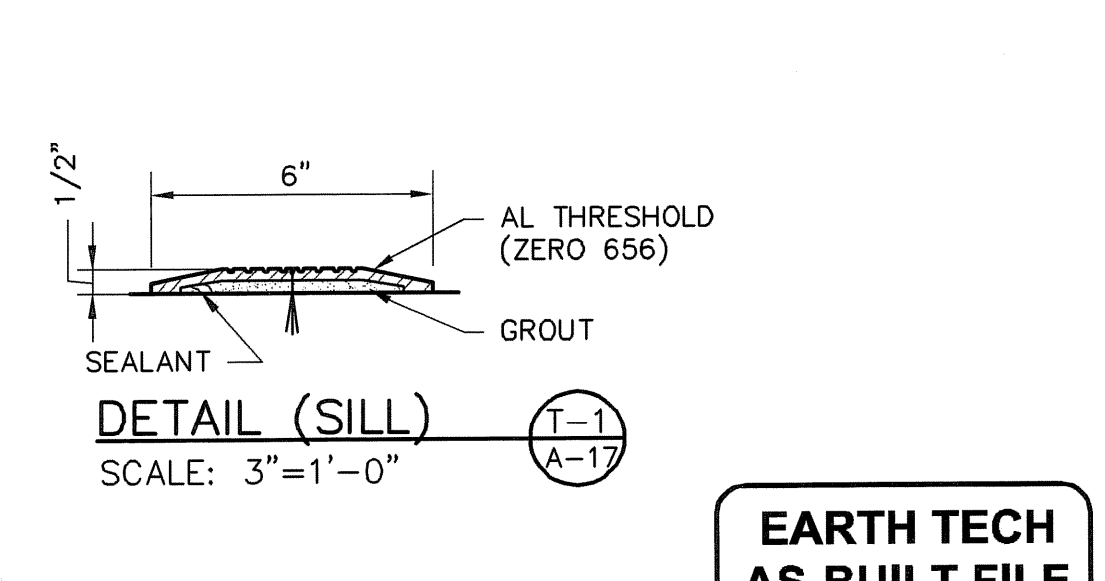

DETAIL (SILL) 11
SCALE: 3" = 1'-0" (A-17)

ROOM FINISH SCHEDULE									SUBSTRATE FINISH	
ROOM	ROOM NO.	FLOOR	BASE	N-WALL	E-WALL	S-WALL	W-WALL	CEILING	CLG. HT.	REMARKS
PUMP ROOM	101	CONC	CONC	CONC	CONC	CONC	CONC	CONC	-	(1)
		HARD	PNT	PNT	PNT	PNT	PNT	PNT	-	
CORRIDOR	201	CONC	CMU	CMU	CMU	CMU	CMU	CONC	-	(1)
		HARD	PNT	PNT	PNT	PNT	PNT	PNT	-	
STRIPPER ROOM	202	CONC	CMU	CMU	CMU	CMU	CMU	CONC	-	(1)
		HARD	PNT	PNT	PNT	PNT	PNT	PNT	-	
ELECTRICAL ROOM	203	CONC	CMU	CMU	CMU	CMU	CMU	CONC	-	(1)
		HARD	PNT	PNT	PNT	PNT	PNT	PNT	-	
CHEMICAL STORAGE ROOM	204	CONC	CMU	CMU	CMU	CMU	CMU	CONC	-	(1) (2)
		HARD	PNT	PNT	PNT	PNT	PNT	PNT	-	

ROOM FINISH SCHEDULE NOTES:

(1) PAINTED BASES ARE 8" HIGH (ONE BLOCK COURSE) AND ARE TO BE PAINTED A DIFFERENT COLOR THAN WALL.

(2) CHEMICAL CONTAINMENT AREAS (CCA) TO RECEIVE LINER SEE SPECIFICATION SECTION 09661



DOOR SCHEDULE										
DOOR NO.	OPENING SIZE WIDTH x HEIGHT	DOORS		FRAMES					LINTEL NO.	REMARKS
		MATERIAL	TYPE	HEAD	JAMB	SILL	TYPE	MATERIAL		
401	PR. 3'-2" x 7'-0"	HM	A	1/A-17	2/A-17	T-1/A-17	3	HM	9/A-18	
402	PR. 3'-2" x 7'-0"	HM	A	1/A-17	2/A-17	T-1/A-17	3	HM	9/A-18	
403	PR. 3'-0" x 7'-8"	HM	A	3/A-17	7/A-17	T-1/A-17	4	HM	10/A-18	
404	3'-0" x 7'-8"	HM	A	3/A-17	4/A-17	T-1/A-17	1	HM	2/A-14	
405	3'-0" x 7'-8"	HM	A	3/A-17	4/A-17	T-1/A-17	1	HM	2/A-14	
406	3'-0" x 7'-8"	HM	A	3/A-17	4/A-17	T-1/A-17	1	HM	2/A-14	
407	3'-0" x 7'-8"	HM	A	5/A-17	6/A-17	-	1	HM	4/A-14	1 1/2 HR FIRE RATING
408	3'-0" x 7'-8"	HM	A	5/A-17	6/A-17	-	1	HM	4/A-14	1 1/2 HR FIRE RATING
409	3'-0" x 7'-8"	HM	A	5/A-17	6/A-17	-	1	HM	4/A-14	1 1/2 HR FIRE RATING

AS-BUILT DRAWING FILE	DPB	MAY 2008
ISSUED FOR RFI POSTED SET	1	10/23/06
ISSUED FOR CONSTRUCTION	0	10/28/05
REV. B AGENCY REVIEW	B	8/16/05
REV. A CLIENT REVIEW	A	7/22/05
REVISIONS	BY	DATE
	ML	

ROBERT H. SHELDON
N.L.
4103
REGISTERED PROFESSIONAL ARCHITECT
STATE OF RHODE ISLAND


DESIGNED BY	ARN	DWG SCALE	AS NOTED
DRAWN BY	EDC	CONTRACT NO.	
CHECKED BY	ARN	DATE	OCTOBER 31, 2006

EARTH TECH
AS-BUILT FILE
MAY 2008

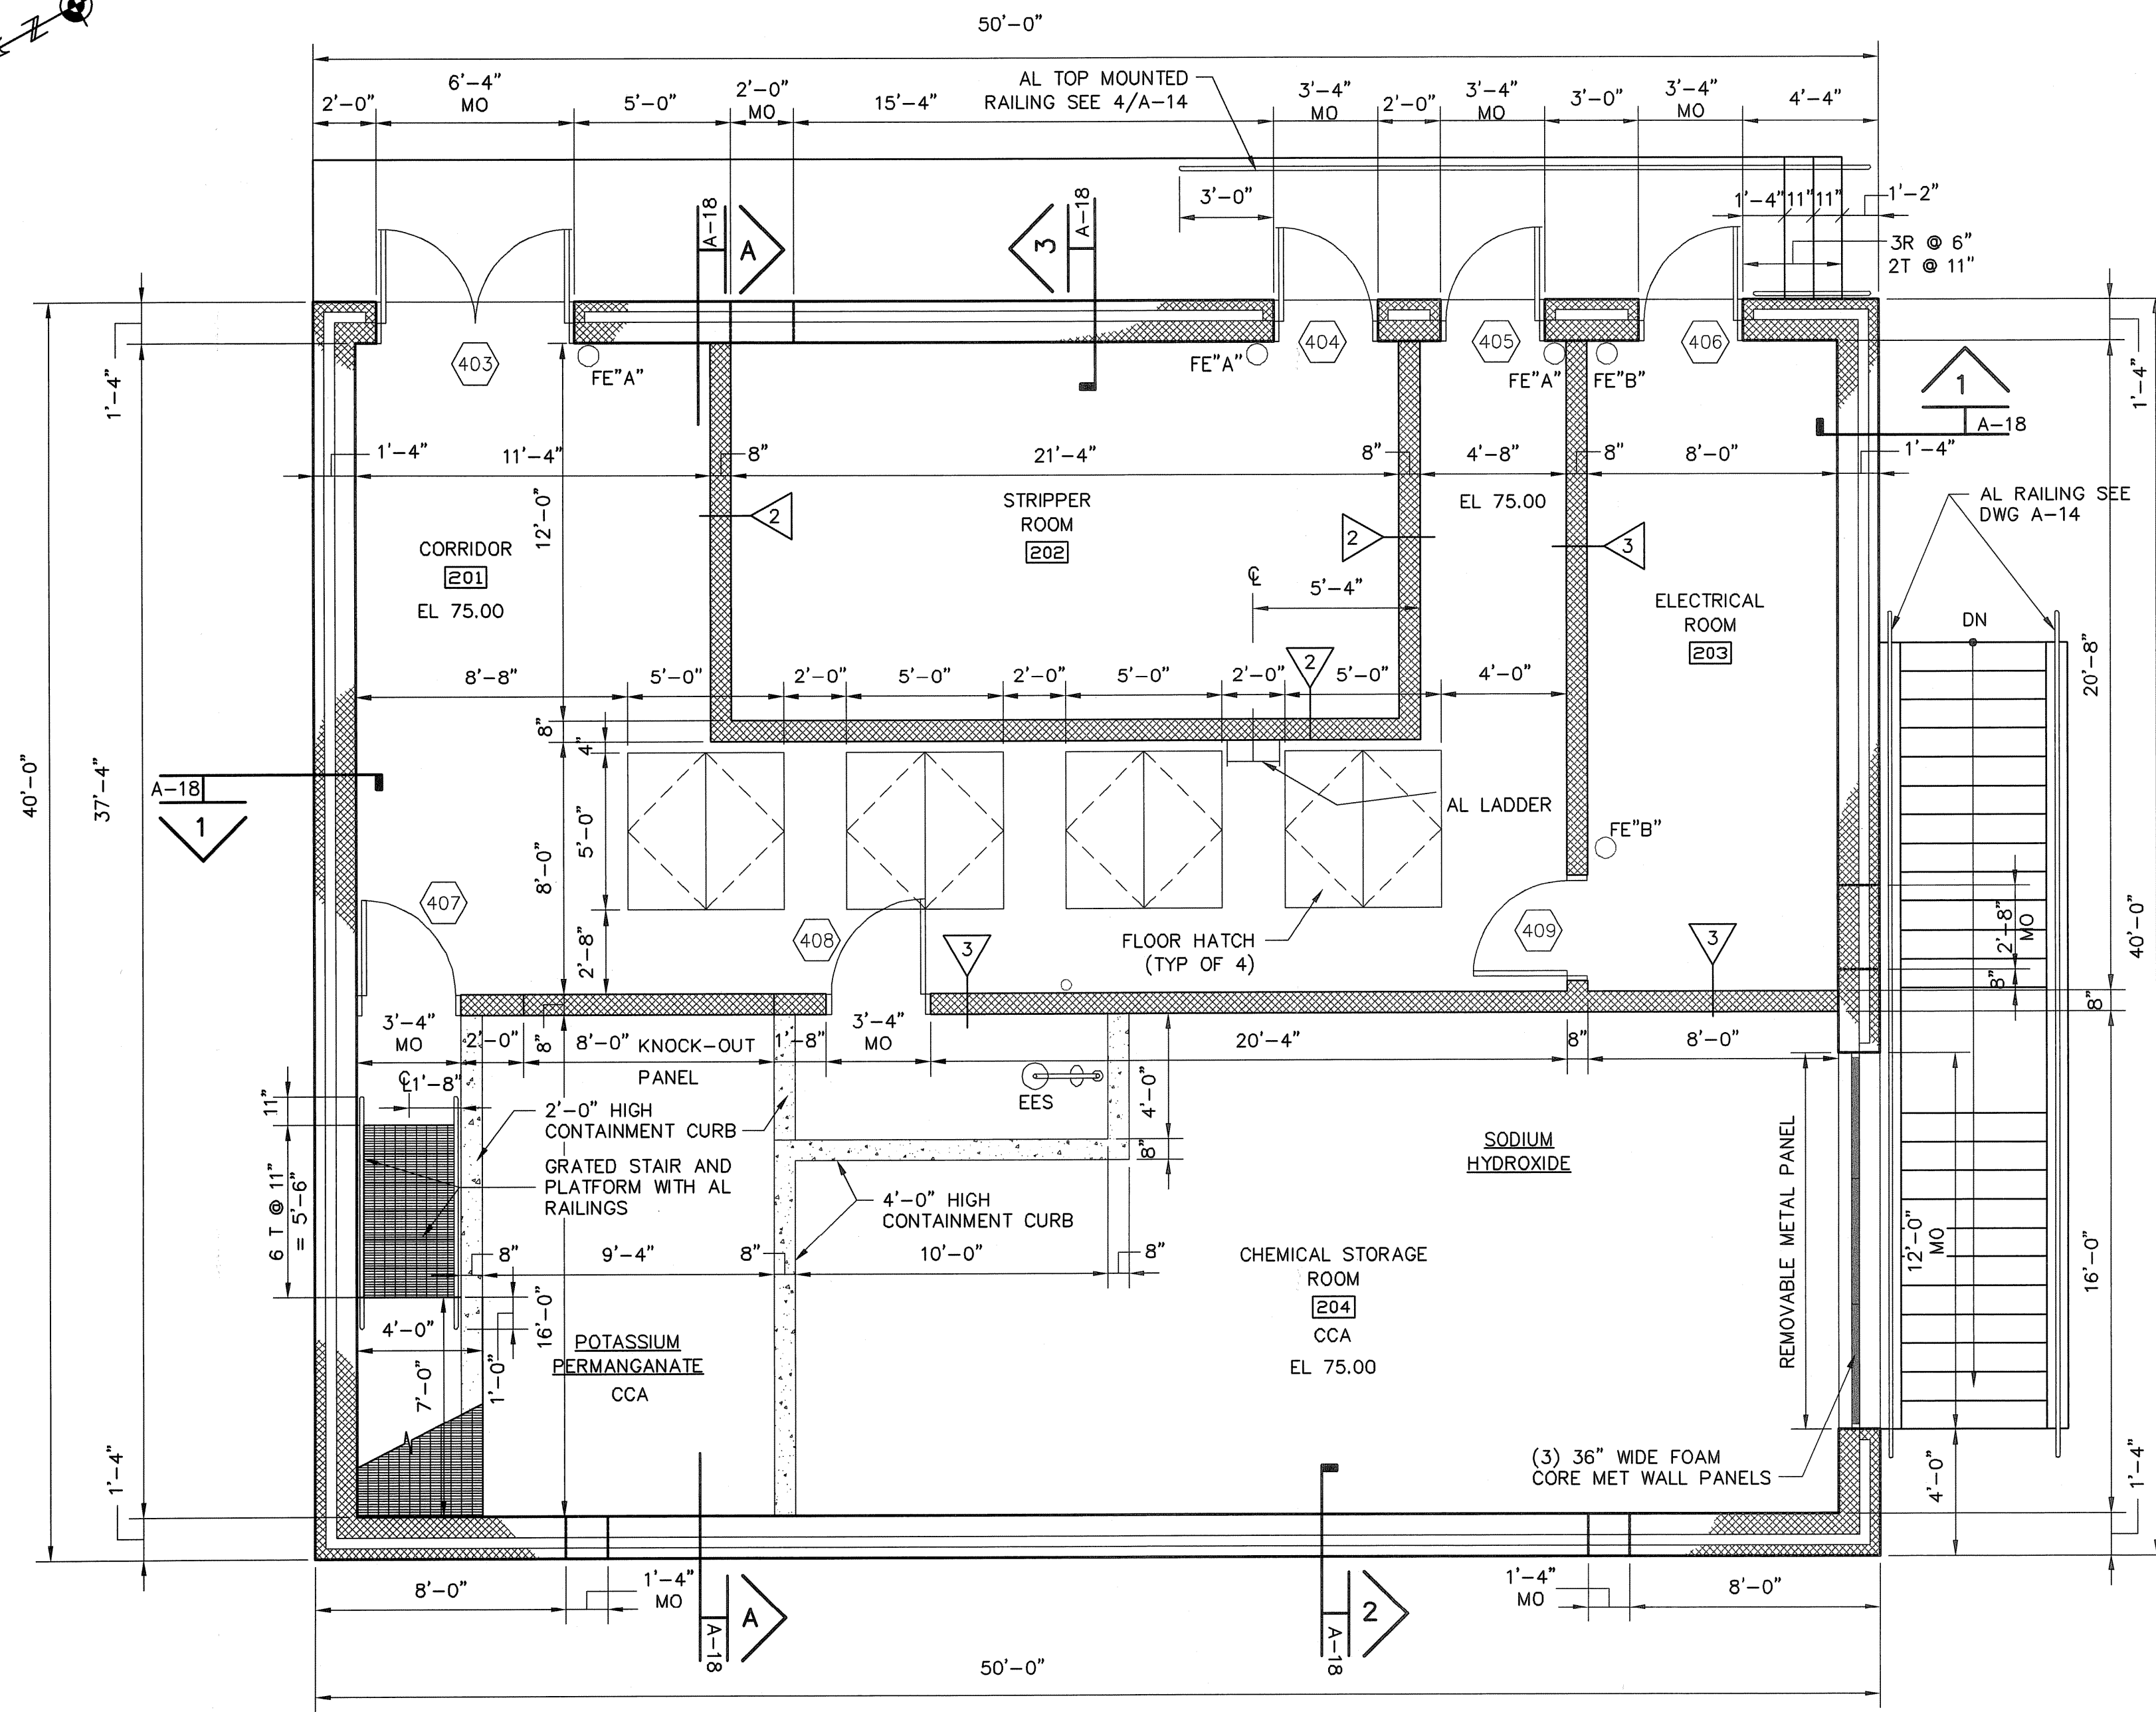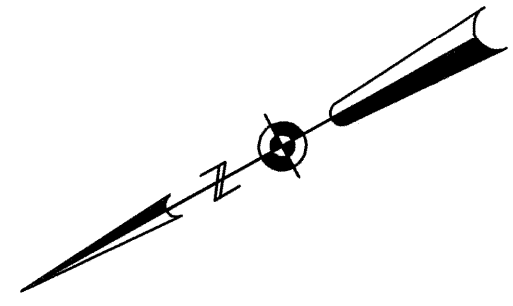


GROUND LEVEL FLOOR PLAN - EL. 75.00'
SCALE: 1/4" = 1'-0"


- *NOTES: 1. CCA CHEMICAL CONTAINMENT AREA WITH LINER SEE SPECIFICATION SECTION 09661- LINERS FOR CHEMICAL CONTAINMENT AREAS
2. SEE DWG A-1 FOR PARTITION TYPES
3. SEE DWG A-17 FOR ROOM FINISH SCHEDULE AND DOOR SCHEDULE

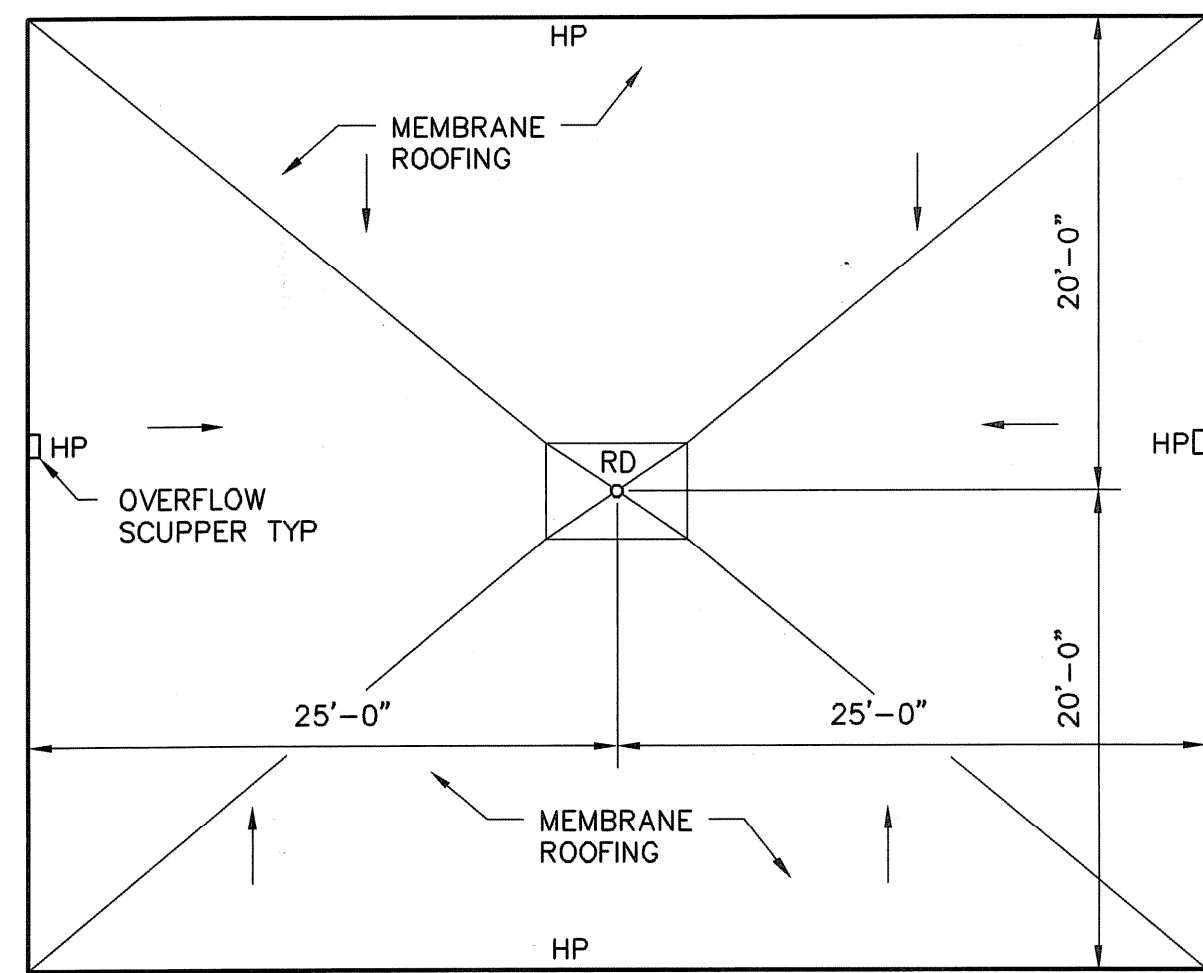


ROOF PLAN
SCALE: 1/8" = 1'-0"

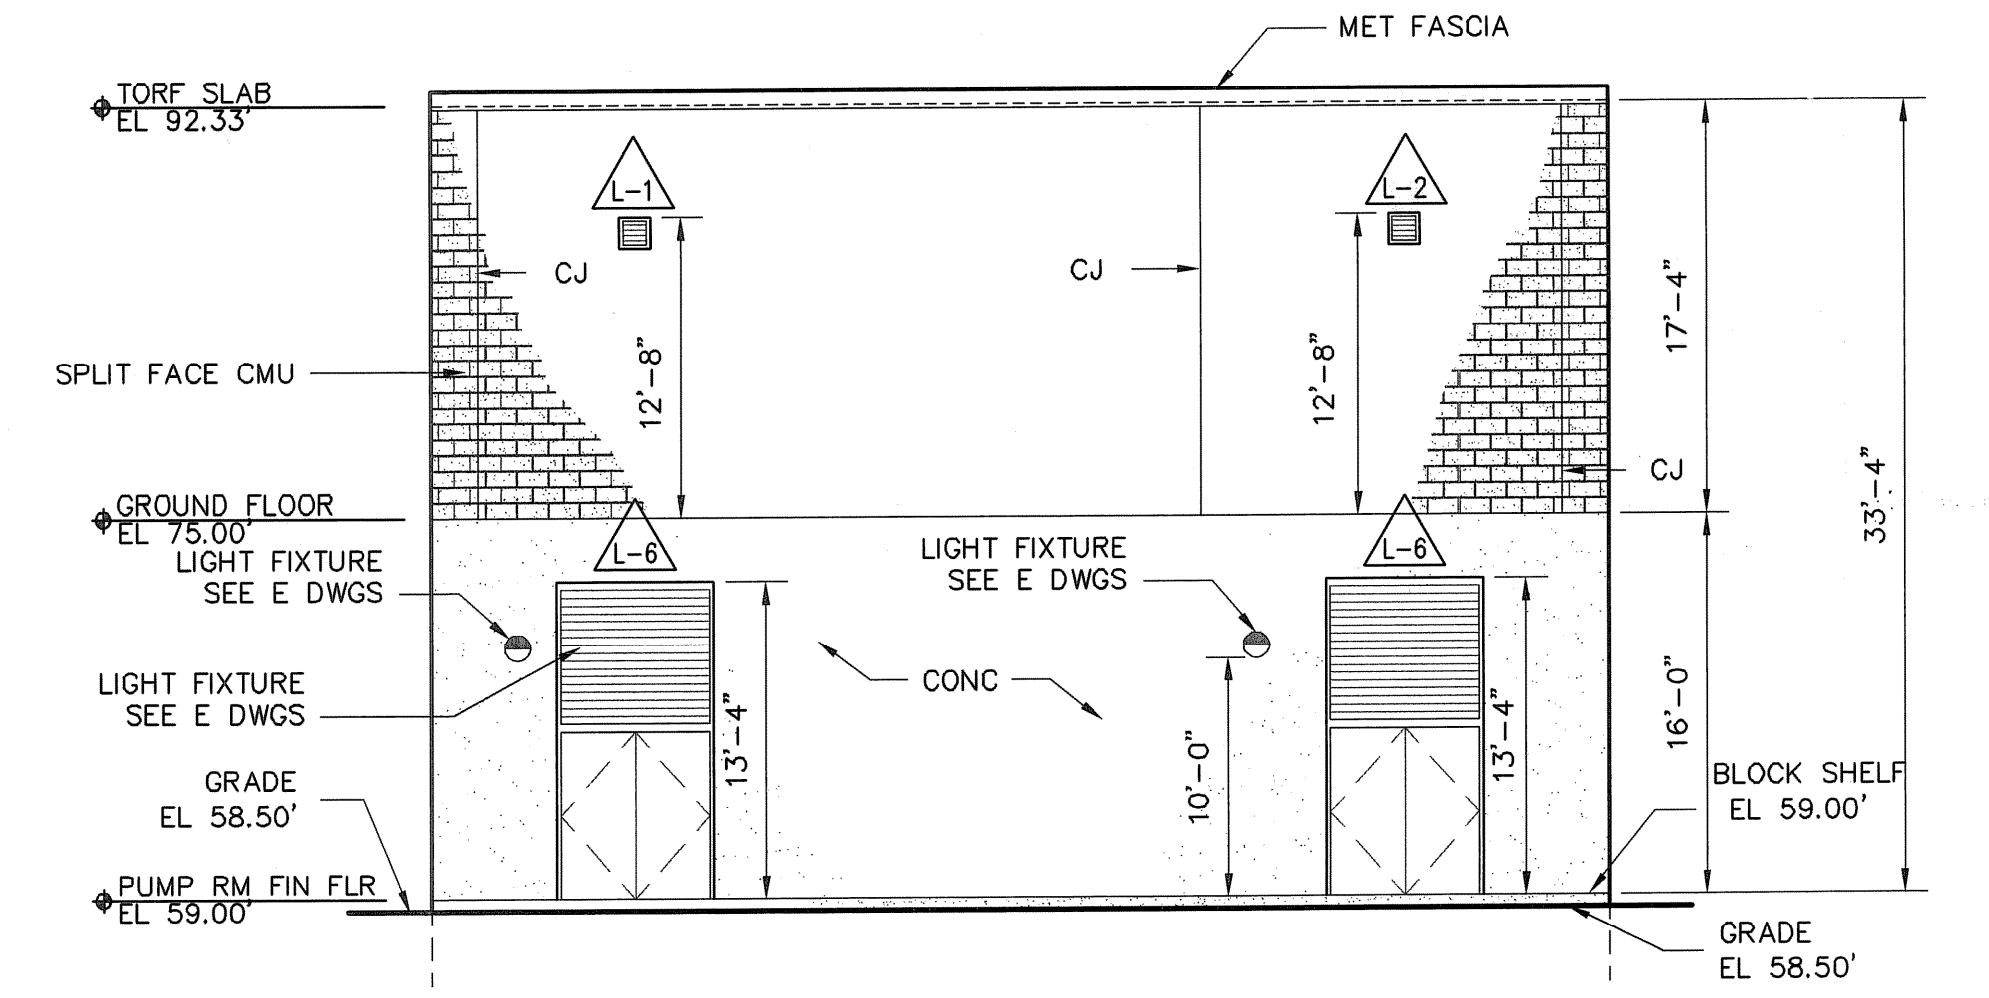


WEST ELEVATION
SCALE: 1/8" = 1'-0"

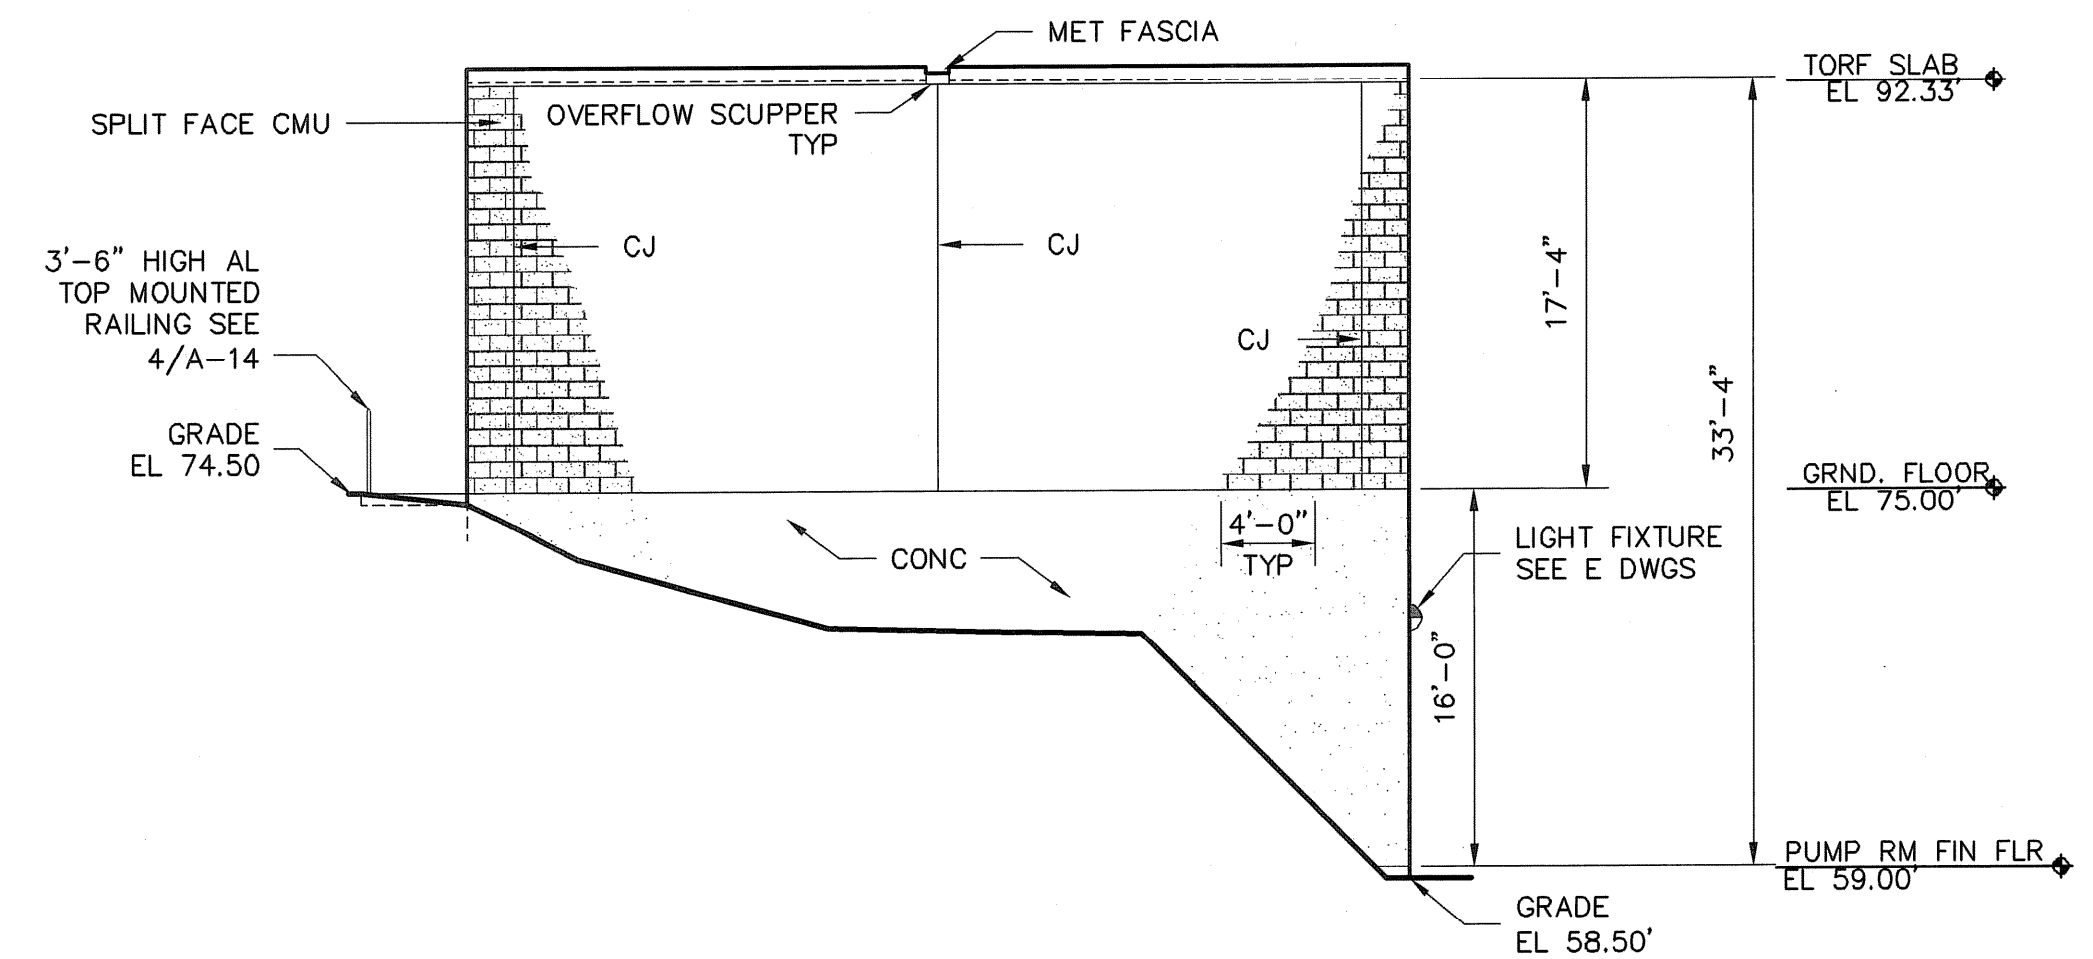

NORTH ELEVATION
SCALE: 1/8" = 1'-0"

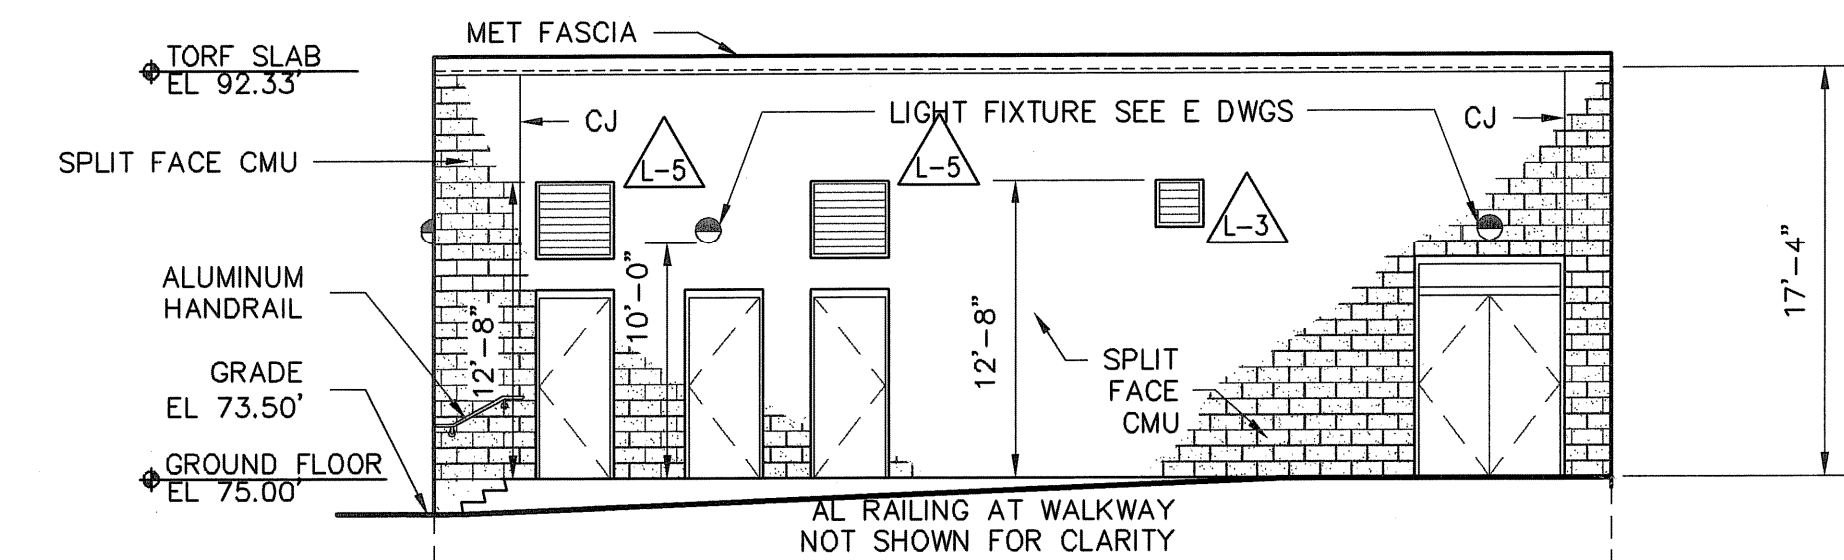

EAST ELEVATION
SCALE: 1/8" = 1'-0"

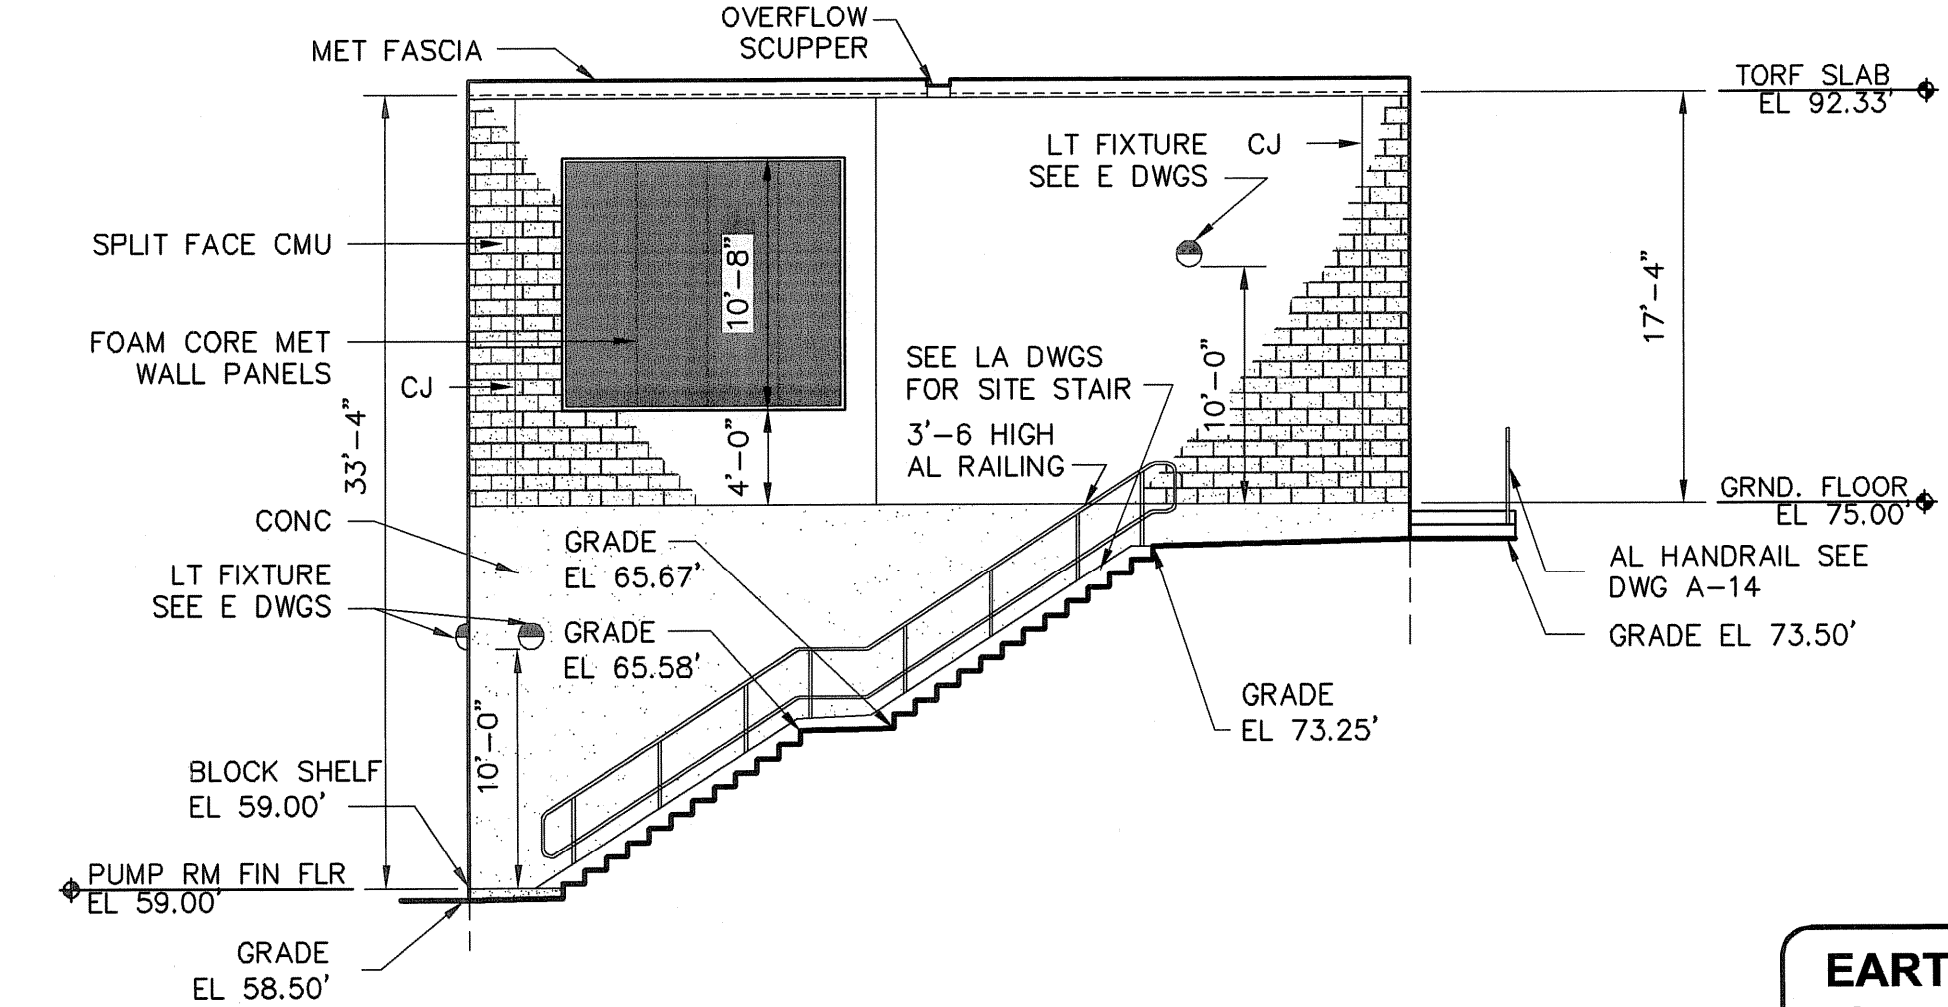

SOUTH ELEVATION
SCALE: 1/8" = 1'-0"

TAMS ARCHITECTS & ENGINEERS, INC.
AN EARTH TECH COMPANY - RI COA A-14,324

EarthTech
A Tyco International Ltd. Company
300 BAKER AVENUE SUITE 200 CONCORD MA 01742 (978) 371-4000

NO.	DATE	BY	REVISIONS
1	MAY 2008	ARN	AS-BUILT DRAWING FILE
2	10/31/05	DPB	ISSUED FOR POSTED SET
3	10/28/05	DPB	ISSUED FOR CONSTRUCTION
4	9/16/05	DPB	REV. B AGENCY REVIEW
5	7/22/05	DPB	REV. A CLIENT REVIEW

ROBERT H. SHELDON
No. 4103
Professional Engineer Seal


PAWTUCKET, RHODE ISLAND
PAWTUCKET REGIONAL WATER TREATMENT FACILITY
PKGS 11 & 12 - RAW WATER PUMP STATION
GROUND LEVEL PLAN, ELEVATIONS, AND DETAILS

DESIGNED BY ARN	DWG SCALE AS NOTED
DRAWN BY ECO	CONTRACT NO.
CHECKED BY ARN	DATE OCTOBER 31, 2008


EARTH TECH
AS-BUILT FILE
MAY 2008

A-17a
SHEET OF


Filename: L:\WORK\69993\CAD\AS-BUILT\11-12\RWTP\ARCH\69993A-18.DWG
 Plot File Date Created: Sep/22/2008 11:34 AM

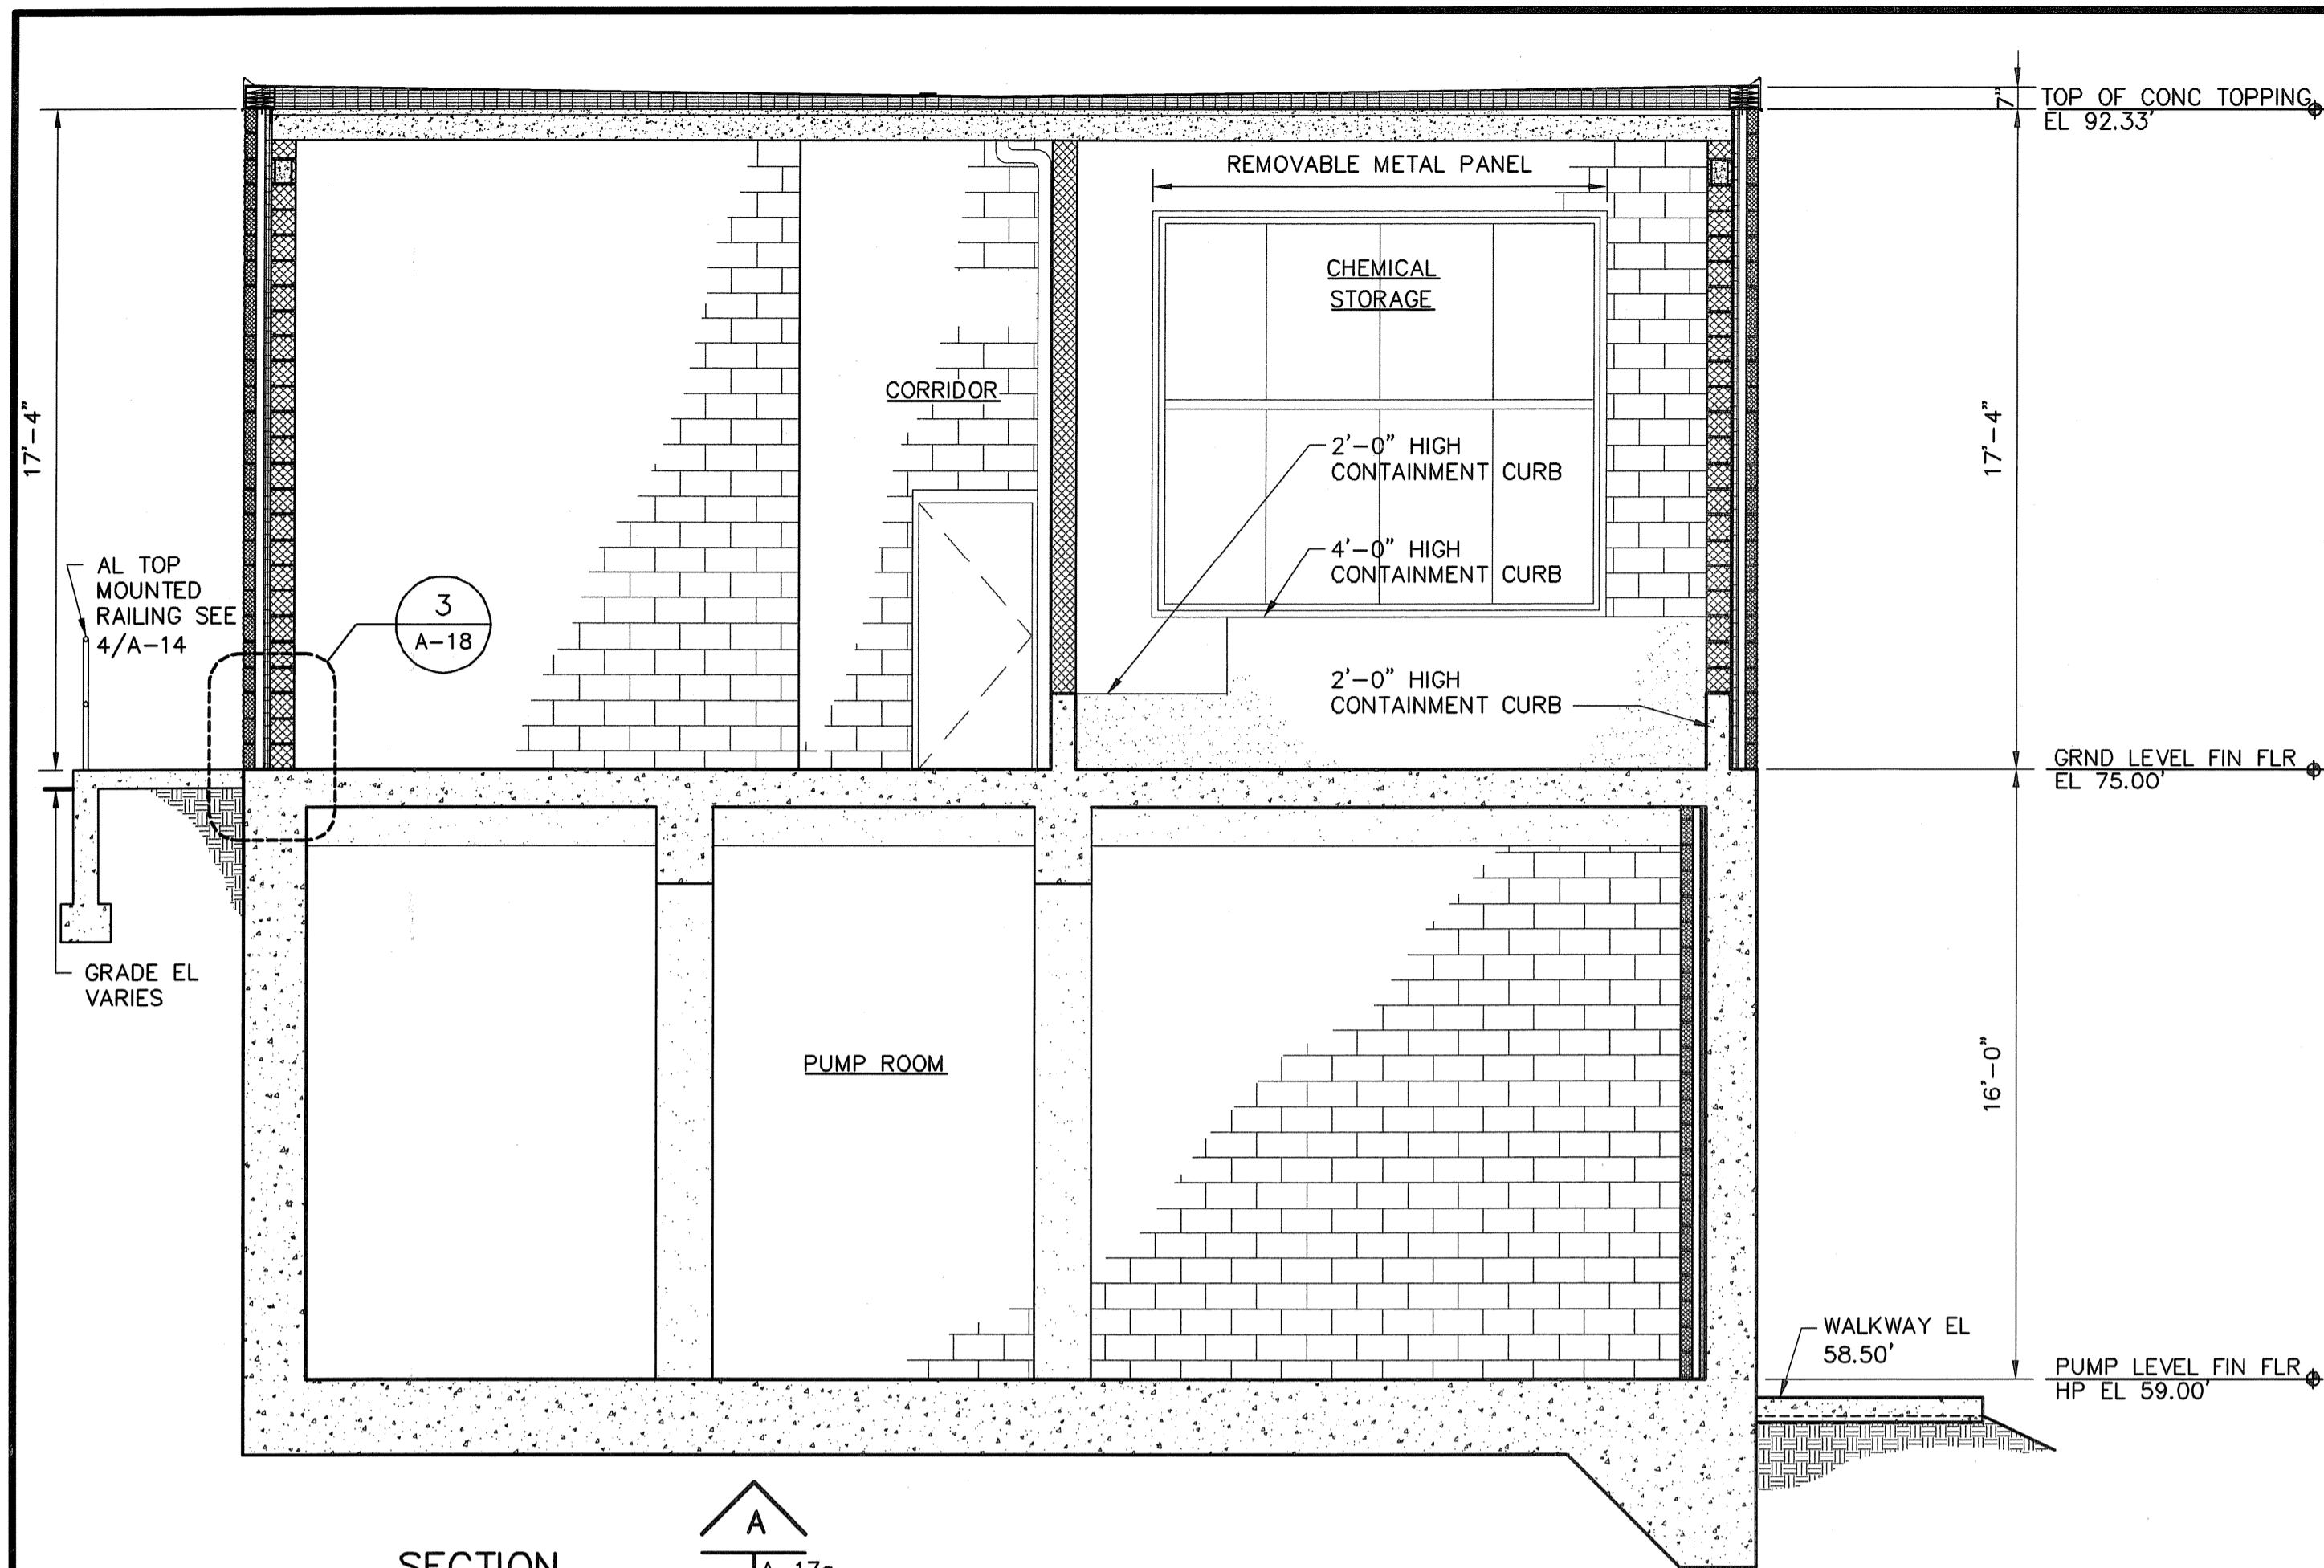


SECTION A-17
 SCALE: 1/4" = 1'-0"

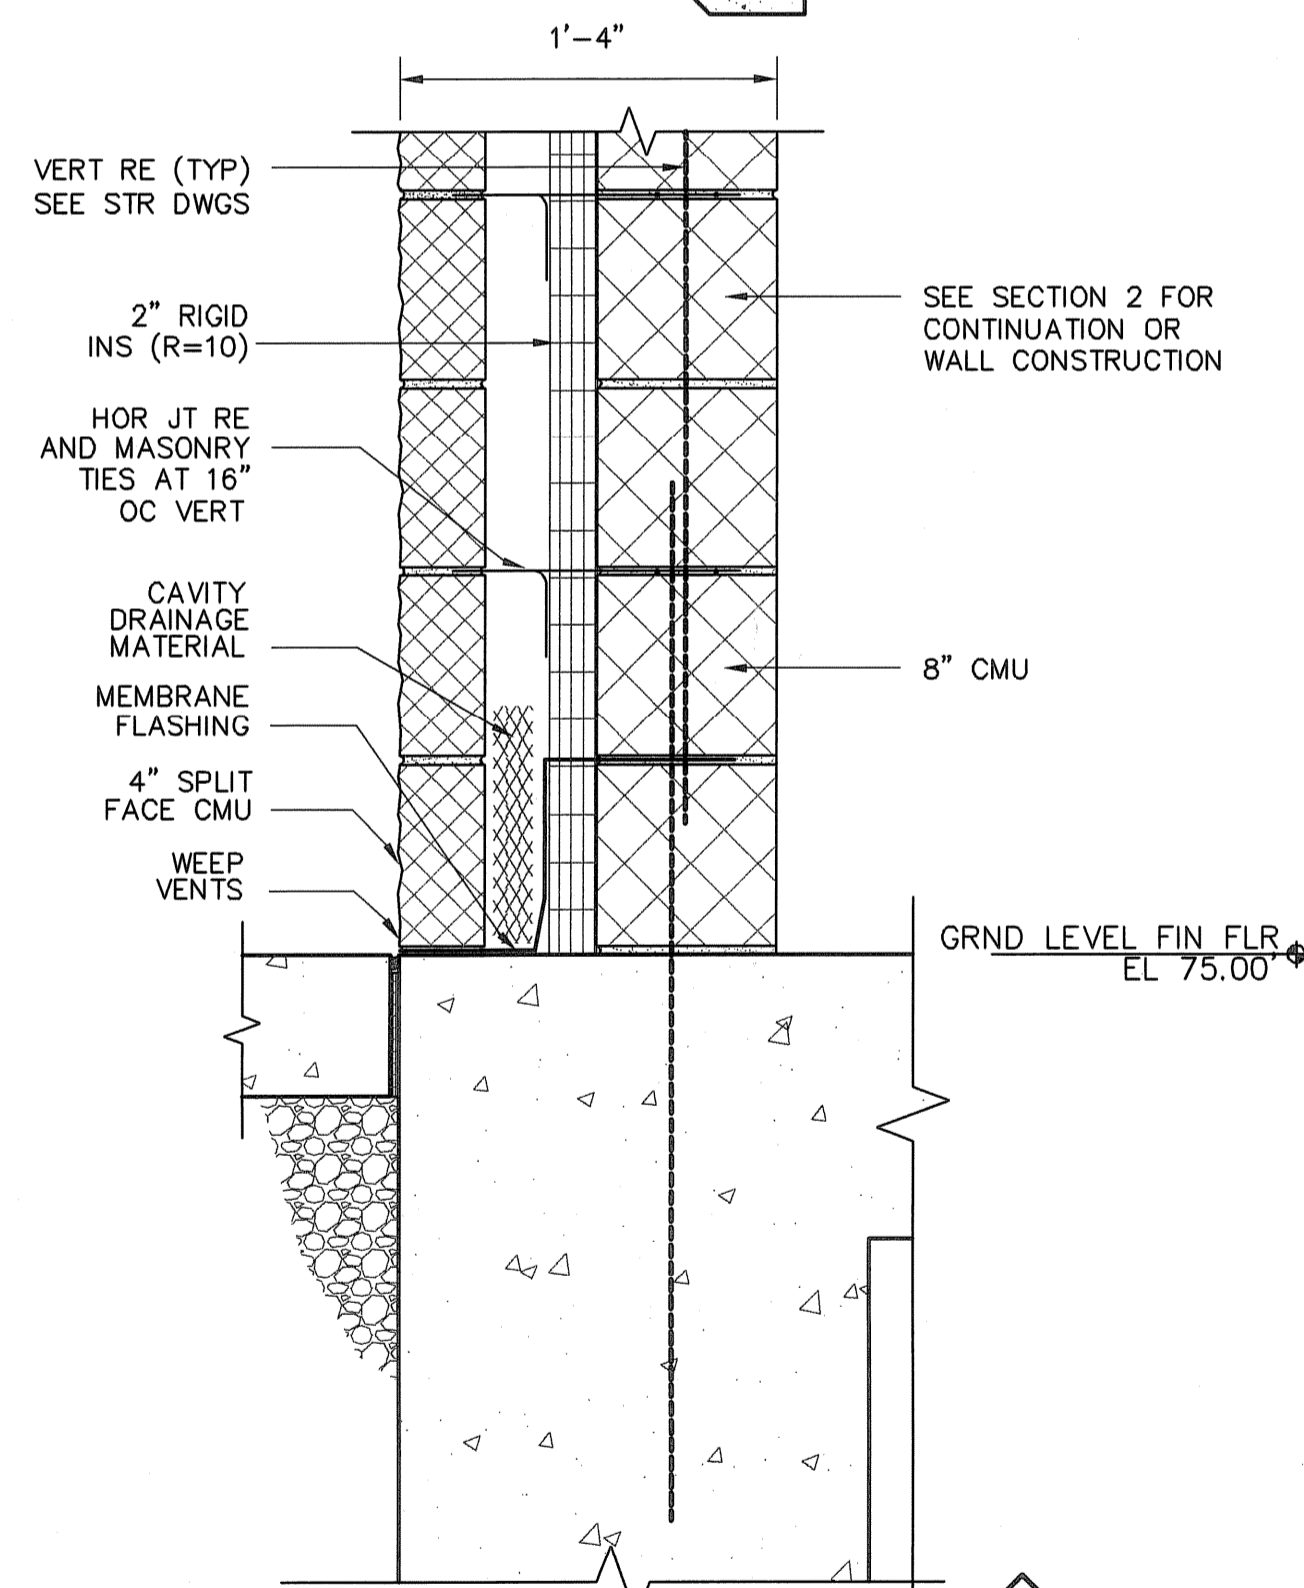


PARTIAL WALL SECTION 3 A-18
 SCALE: 1 1/2" = 1'-0"

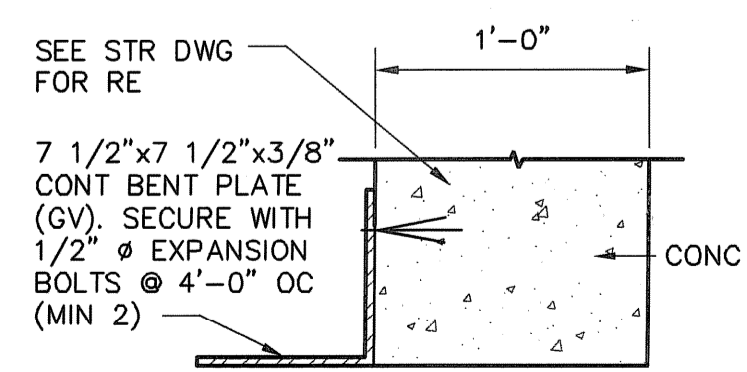


CONCRETE LINTEL SCHEDULE NO. 9
 SCALE: 1 1/2" = 1'-0"

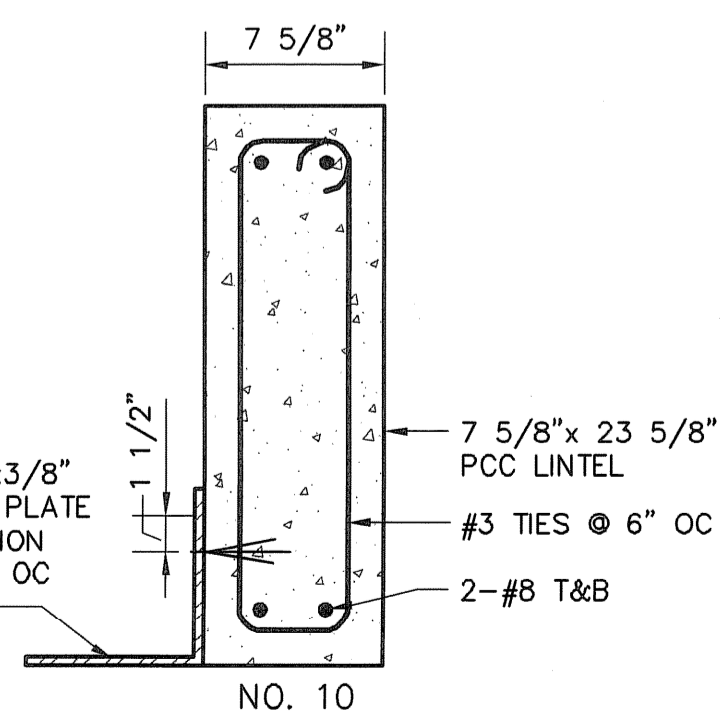

CONCRETE LINTEL SCHEDULE NO. 10

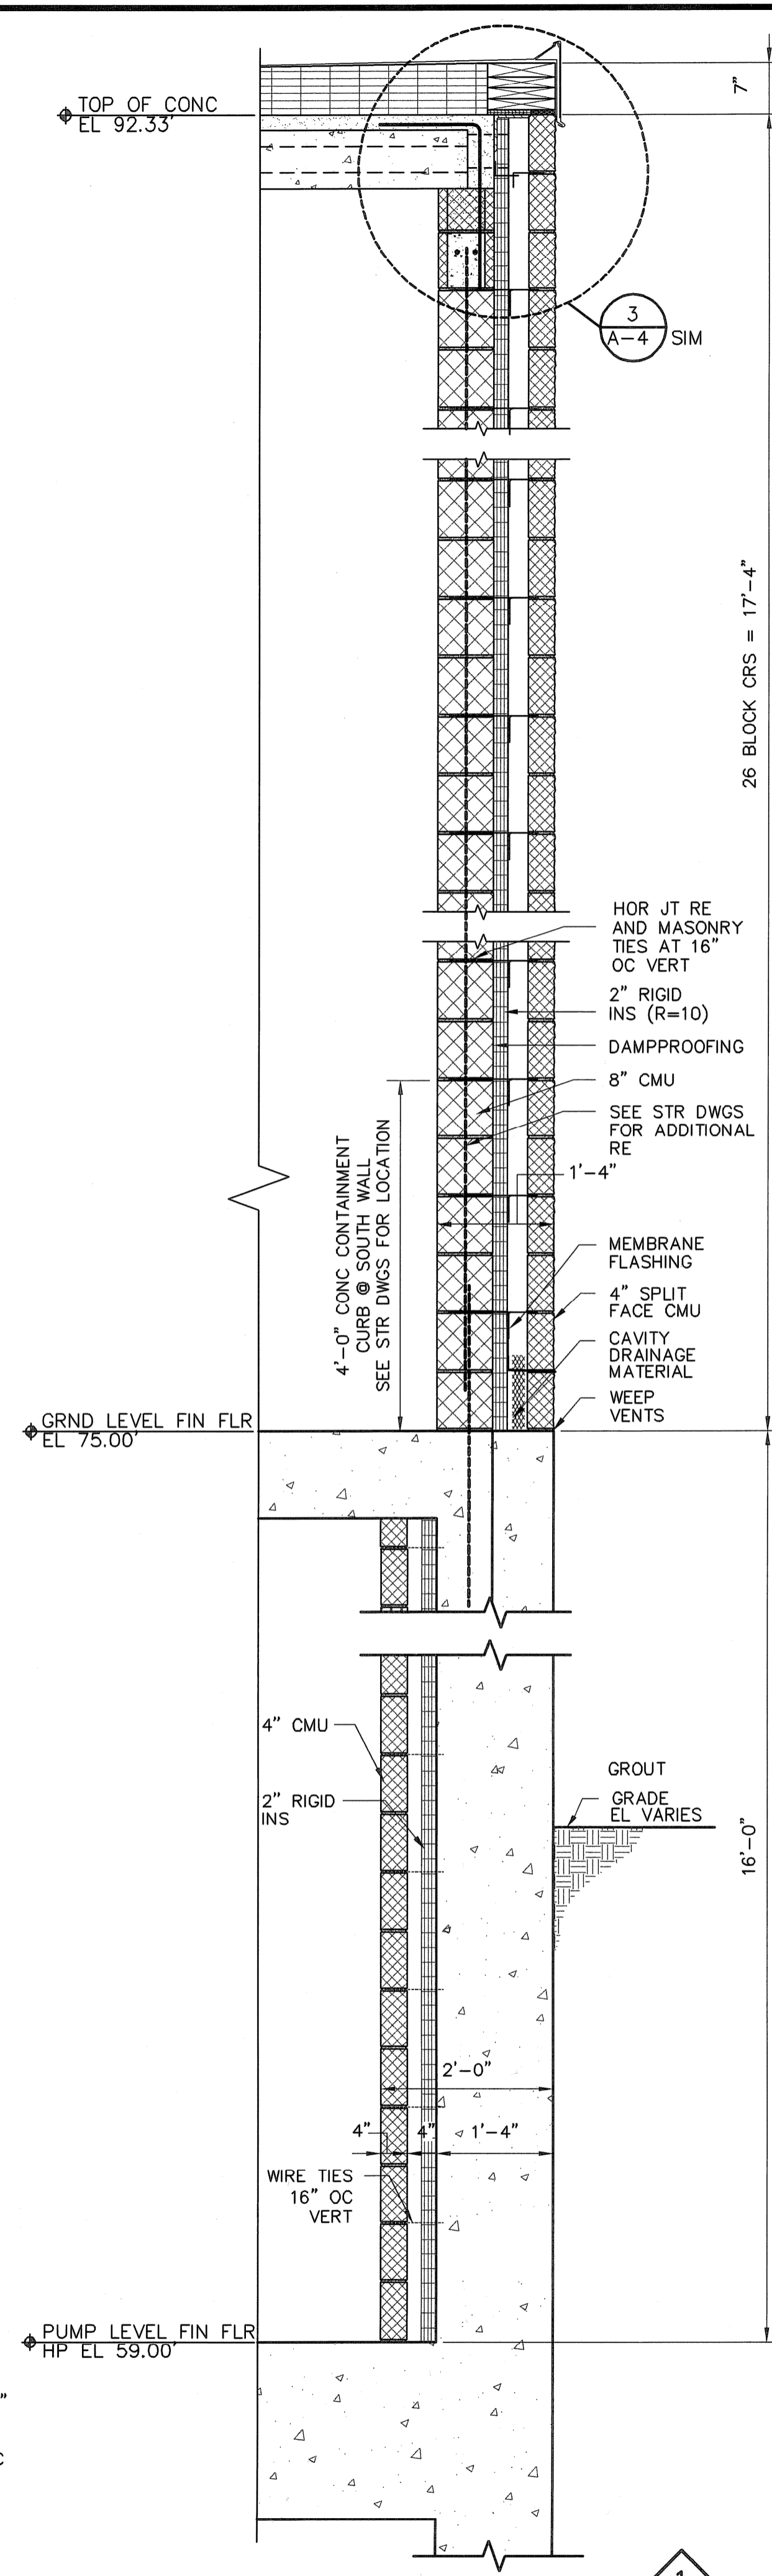

SECTION THRU NORTH AND SOUTH WALL 1 A-17, A-17a
 EAST WALL SIMILAR
 SCALE: 3/4" = 1'-0"

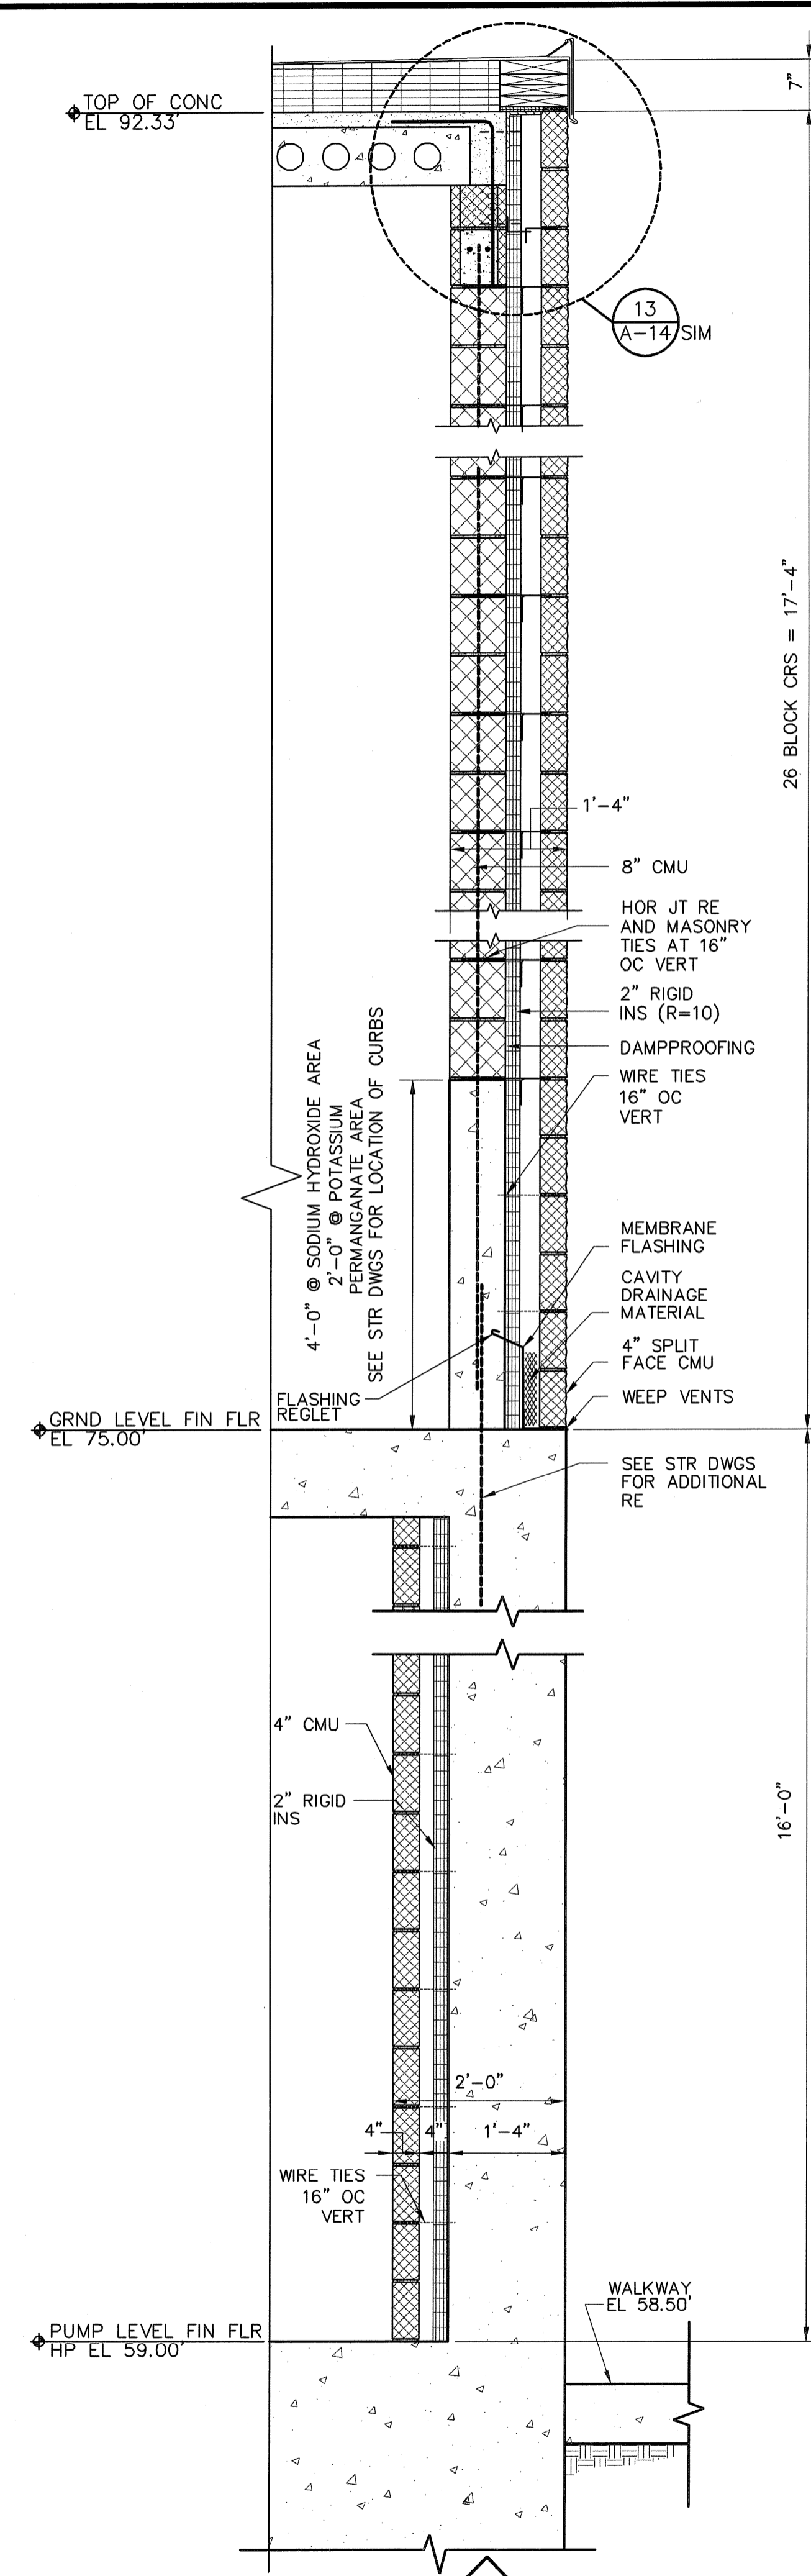

SECTION THRU WEST WALL 2 A-17, A-17a
 SCALE: 3/4" = 1'-0"

EARTH TECH AS-BUILT FILE MAY 2008

TAMS ARCHITECTS & ENGINEERS, INC.
 AN EARTH TECH COMPANY - RI COA A-14,324

EarthTech
 A Tyco International Ltd. Company
 300 BAKER AVENUE SUITE 200 CONCORD MA 01742 (978) 371-4000

NO.	DATE	BY	REVISIONS
2	MAY 2008	DPB	AS-BUILT DRAWING FILE
1	10/23/06		ISSUED FOR RFI POSTED SET
0	10/29/05		ISSUED FOR CONSTRUCTION
B	8/16/05		REV. B AGENCY REVIEW
A	7/22/05		REV. A CLIENT REVIEW


ROBERT H. SHELDON
 No. 4103
 3/10/08

PAWTUCKET, RHODE ISLAND
PAWTUCKET REGIONAL WATER TREATMENT FACILITY
PKGS 11 & 12 - RAW WATER PUMP STATION


SECTIONS AND DETAILS

DESIGNED BY	DWG SCALE
MIN	AS NOTED
DRAWN BY	CONTRACT NO.
ECD	
CHECKED BY	DATE
MIN	OCTOBER 31, 2008


A-18
 SHEET OF

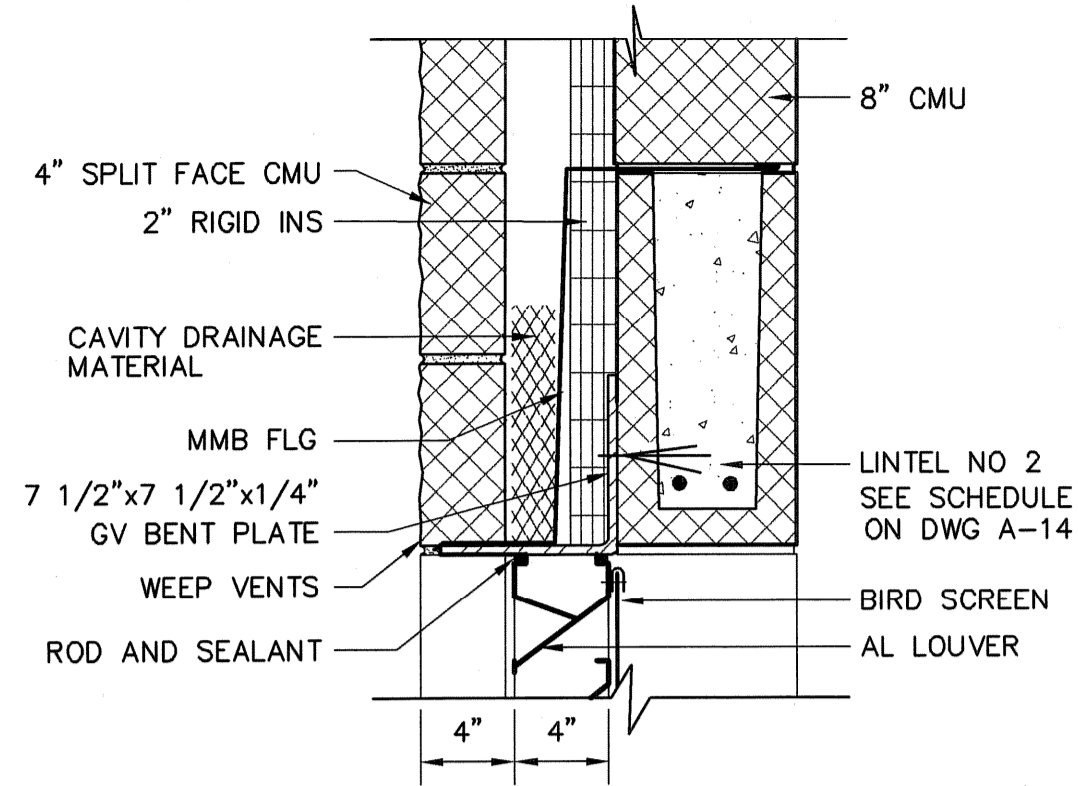


DETAIL (HEAD) 1
SCALE: 1 1/2" = 1'-0" (A-18a)

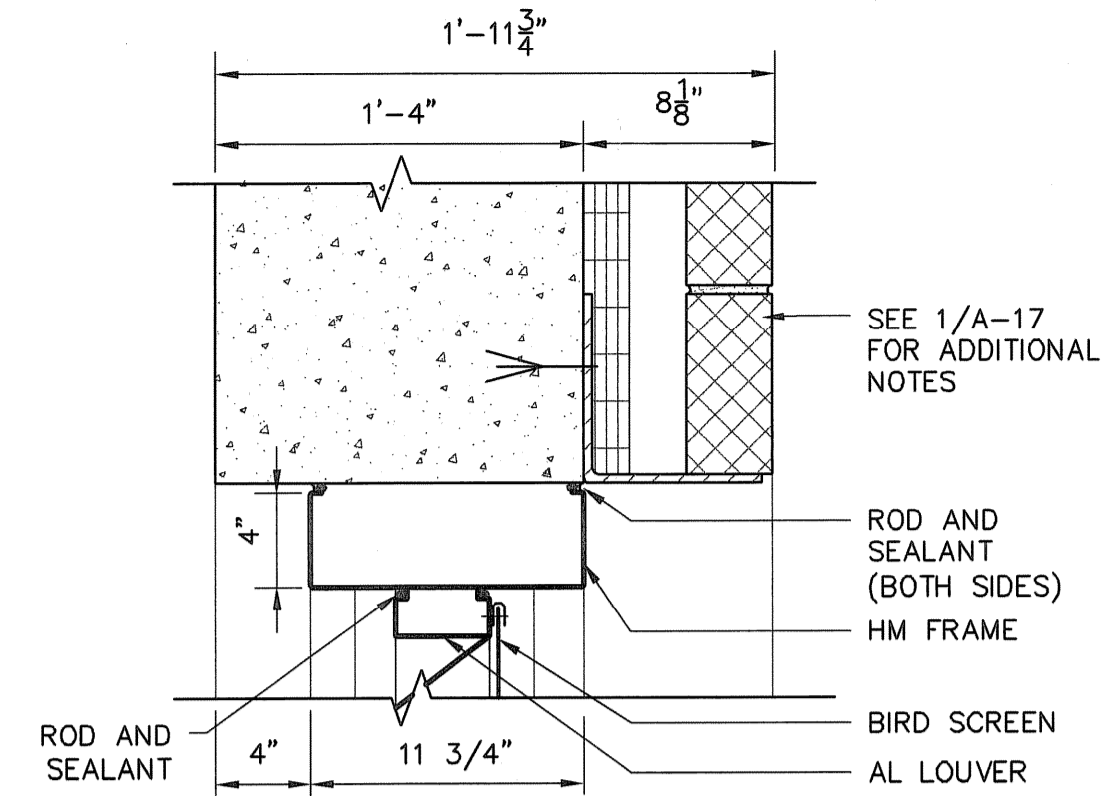


DETAIL (HEAD) 4
SCALE: 1 1/2" = 1'-0" (A-18a)

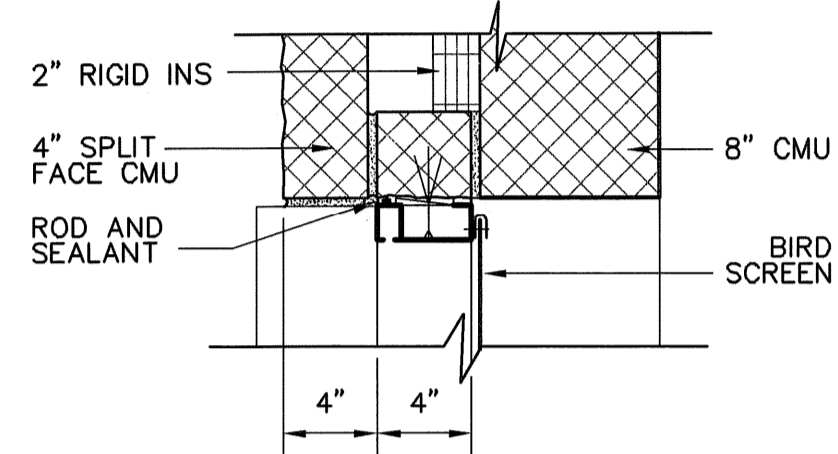


DETAIL (JAMB) 2
SCALE: 1 1/2" = 1'-0" (A-18a)

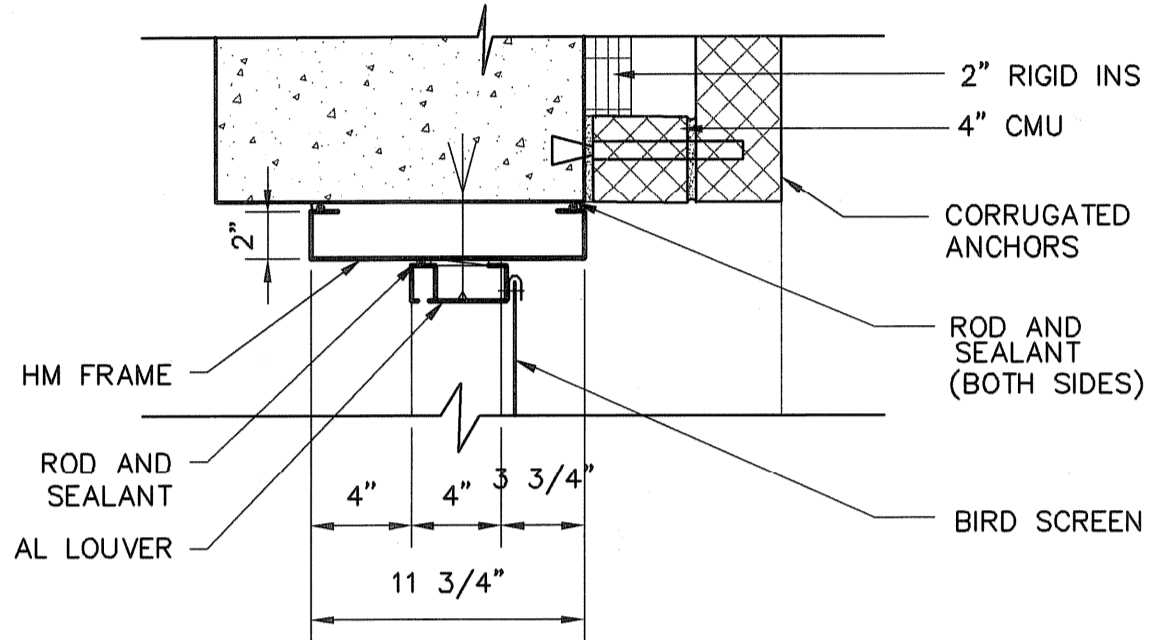


DETAIL (JAMB) 4
SCALE: 1 1/2" = 1'-0" (A-18a)

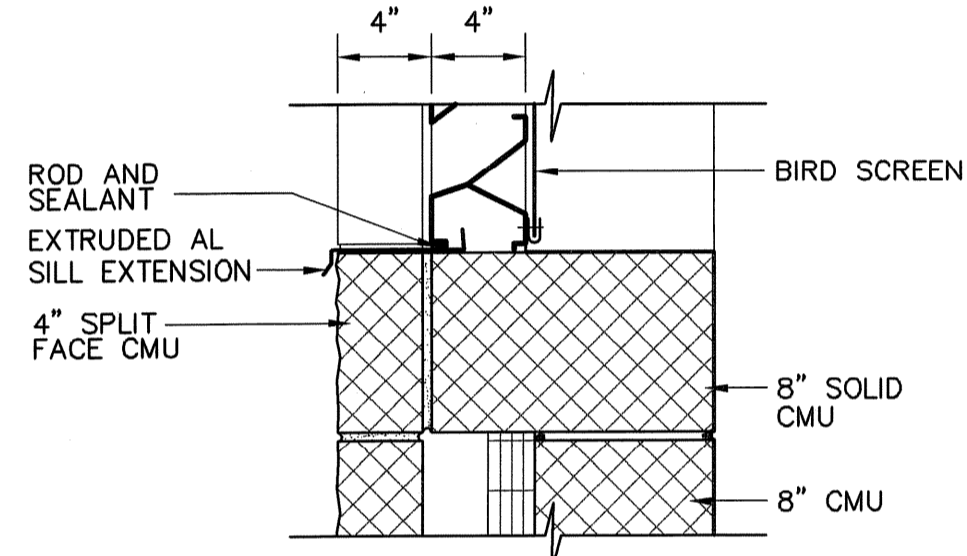

DETAIL (SILL) 3
SCALE: 1 1/2" = 1'-0" (A-18a)

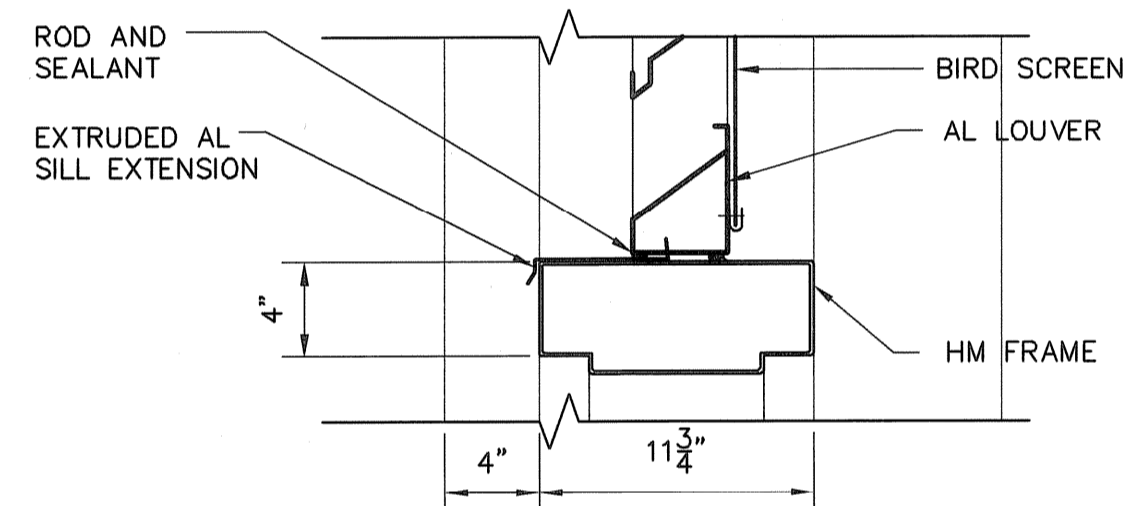

DETAIL (SILL) 5
SCALE: 1 1/2" = 1'-0" (A-18a)

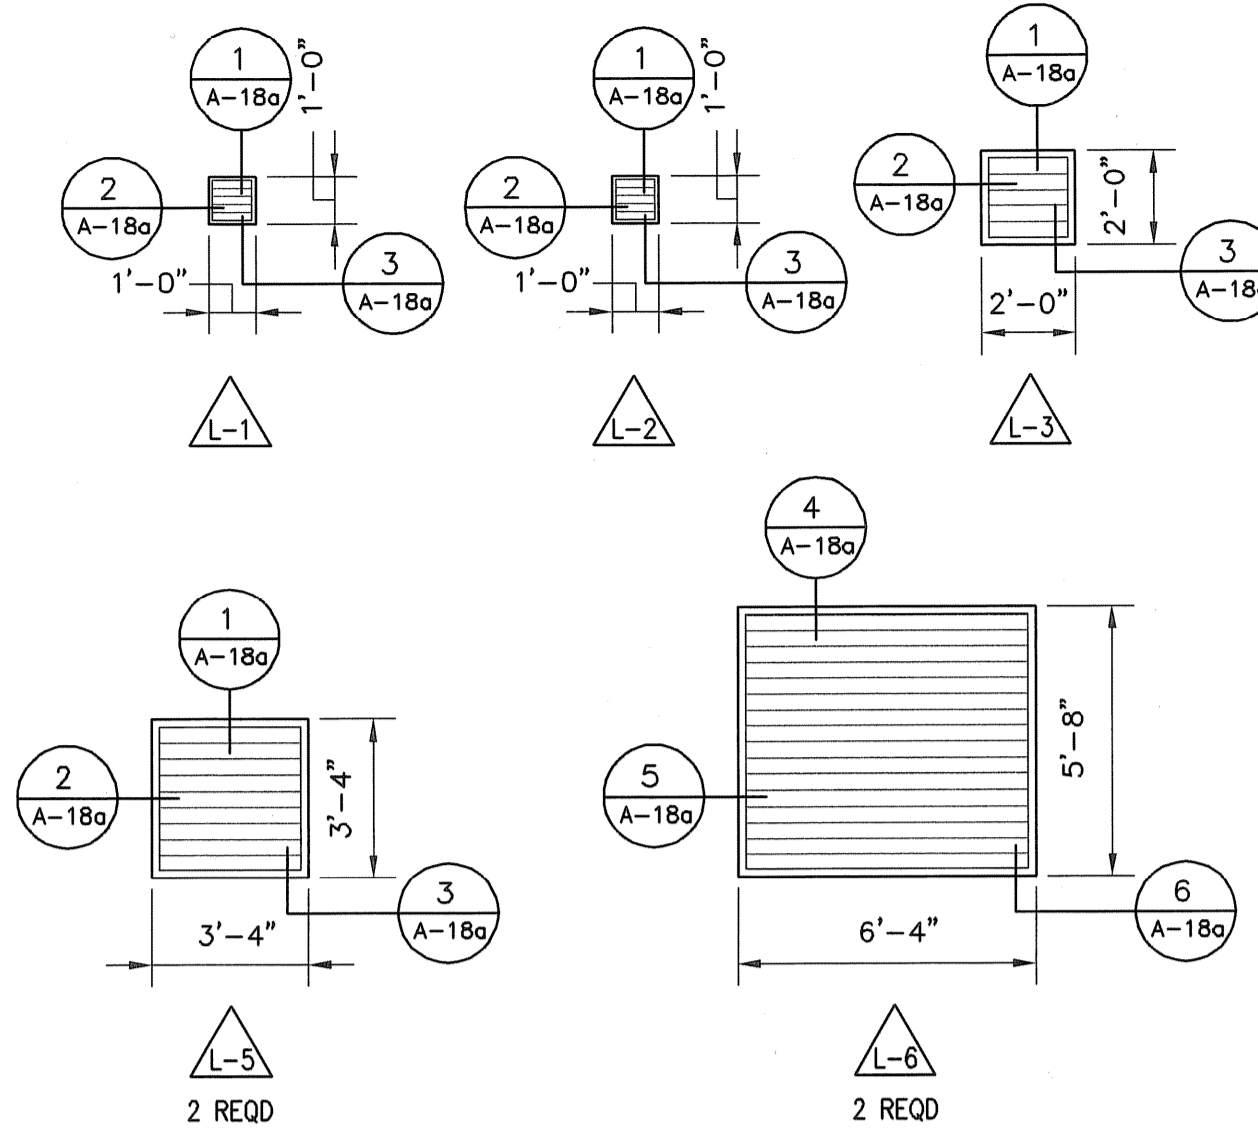

LOUVER TYPES
SCALE: 1/4" = 1'-0"

TAMS ARCHITECTS & ENGINEERS, INC.
AN EARTH TECH COMPANY - RI COA A-14-324

EarthTech
A Tyco International Ltd. Company
300 BAKER AVENUE SUITE 200 CONCORD MA 01742 (978) 371-6000

NO.	DATE	BY	REVISIONS
2	08/15/08	AR	AS-BUILT DRAWING FILE
1	10/27/06	AR	ISSUED FOR RFI POSTED SET
0	10/28/05	AR	ISSUED FOR CONSTRUCTION
B	8/16/05	AR	REV. B AGENCY REVIEW
A	7/22/05	AR	REV. A CLIENT REVIEW

ROBERT H. SHELDON
No. 4103
[Signature]

PAWTUCKET, RHODE ISLAND
**PAWTUCKET REGIONAL
WATER TREATMENT FACILITY**
PKGS 11 & 12 - RAW WATER PUMP STATION
LOUVER DETAILS


DESIGNED BY ARN	DWG SCALE AS NOTED
DRAWN BY ECO	CONTRACT NO.
CHECKED BY ARN	DATE OCTOBER 31, 2006

EARTH TECH
AS-BUILT FILE
MAY 2008

A-18a
SHEET OF


PLU FILE DATE CREATED: 3/21/2008 11:37 AM

Filename: L:\WORK\69993\CAD\AS-BUILT\11-12 RWTP\STRUC\69993-11_S1-3.DWG
 Plot File Date Created: Sep/22/2008 11:34 AM

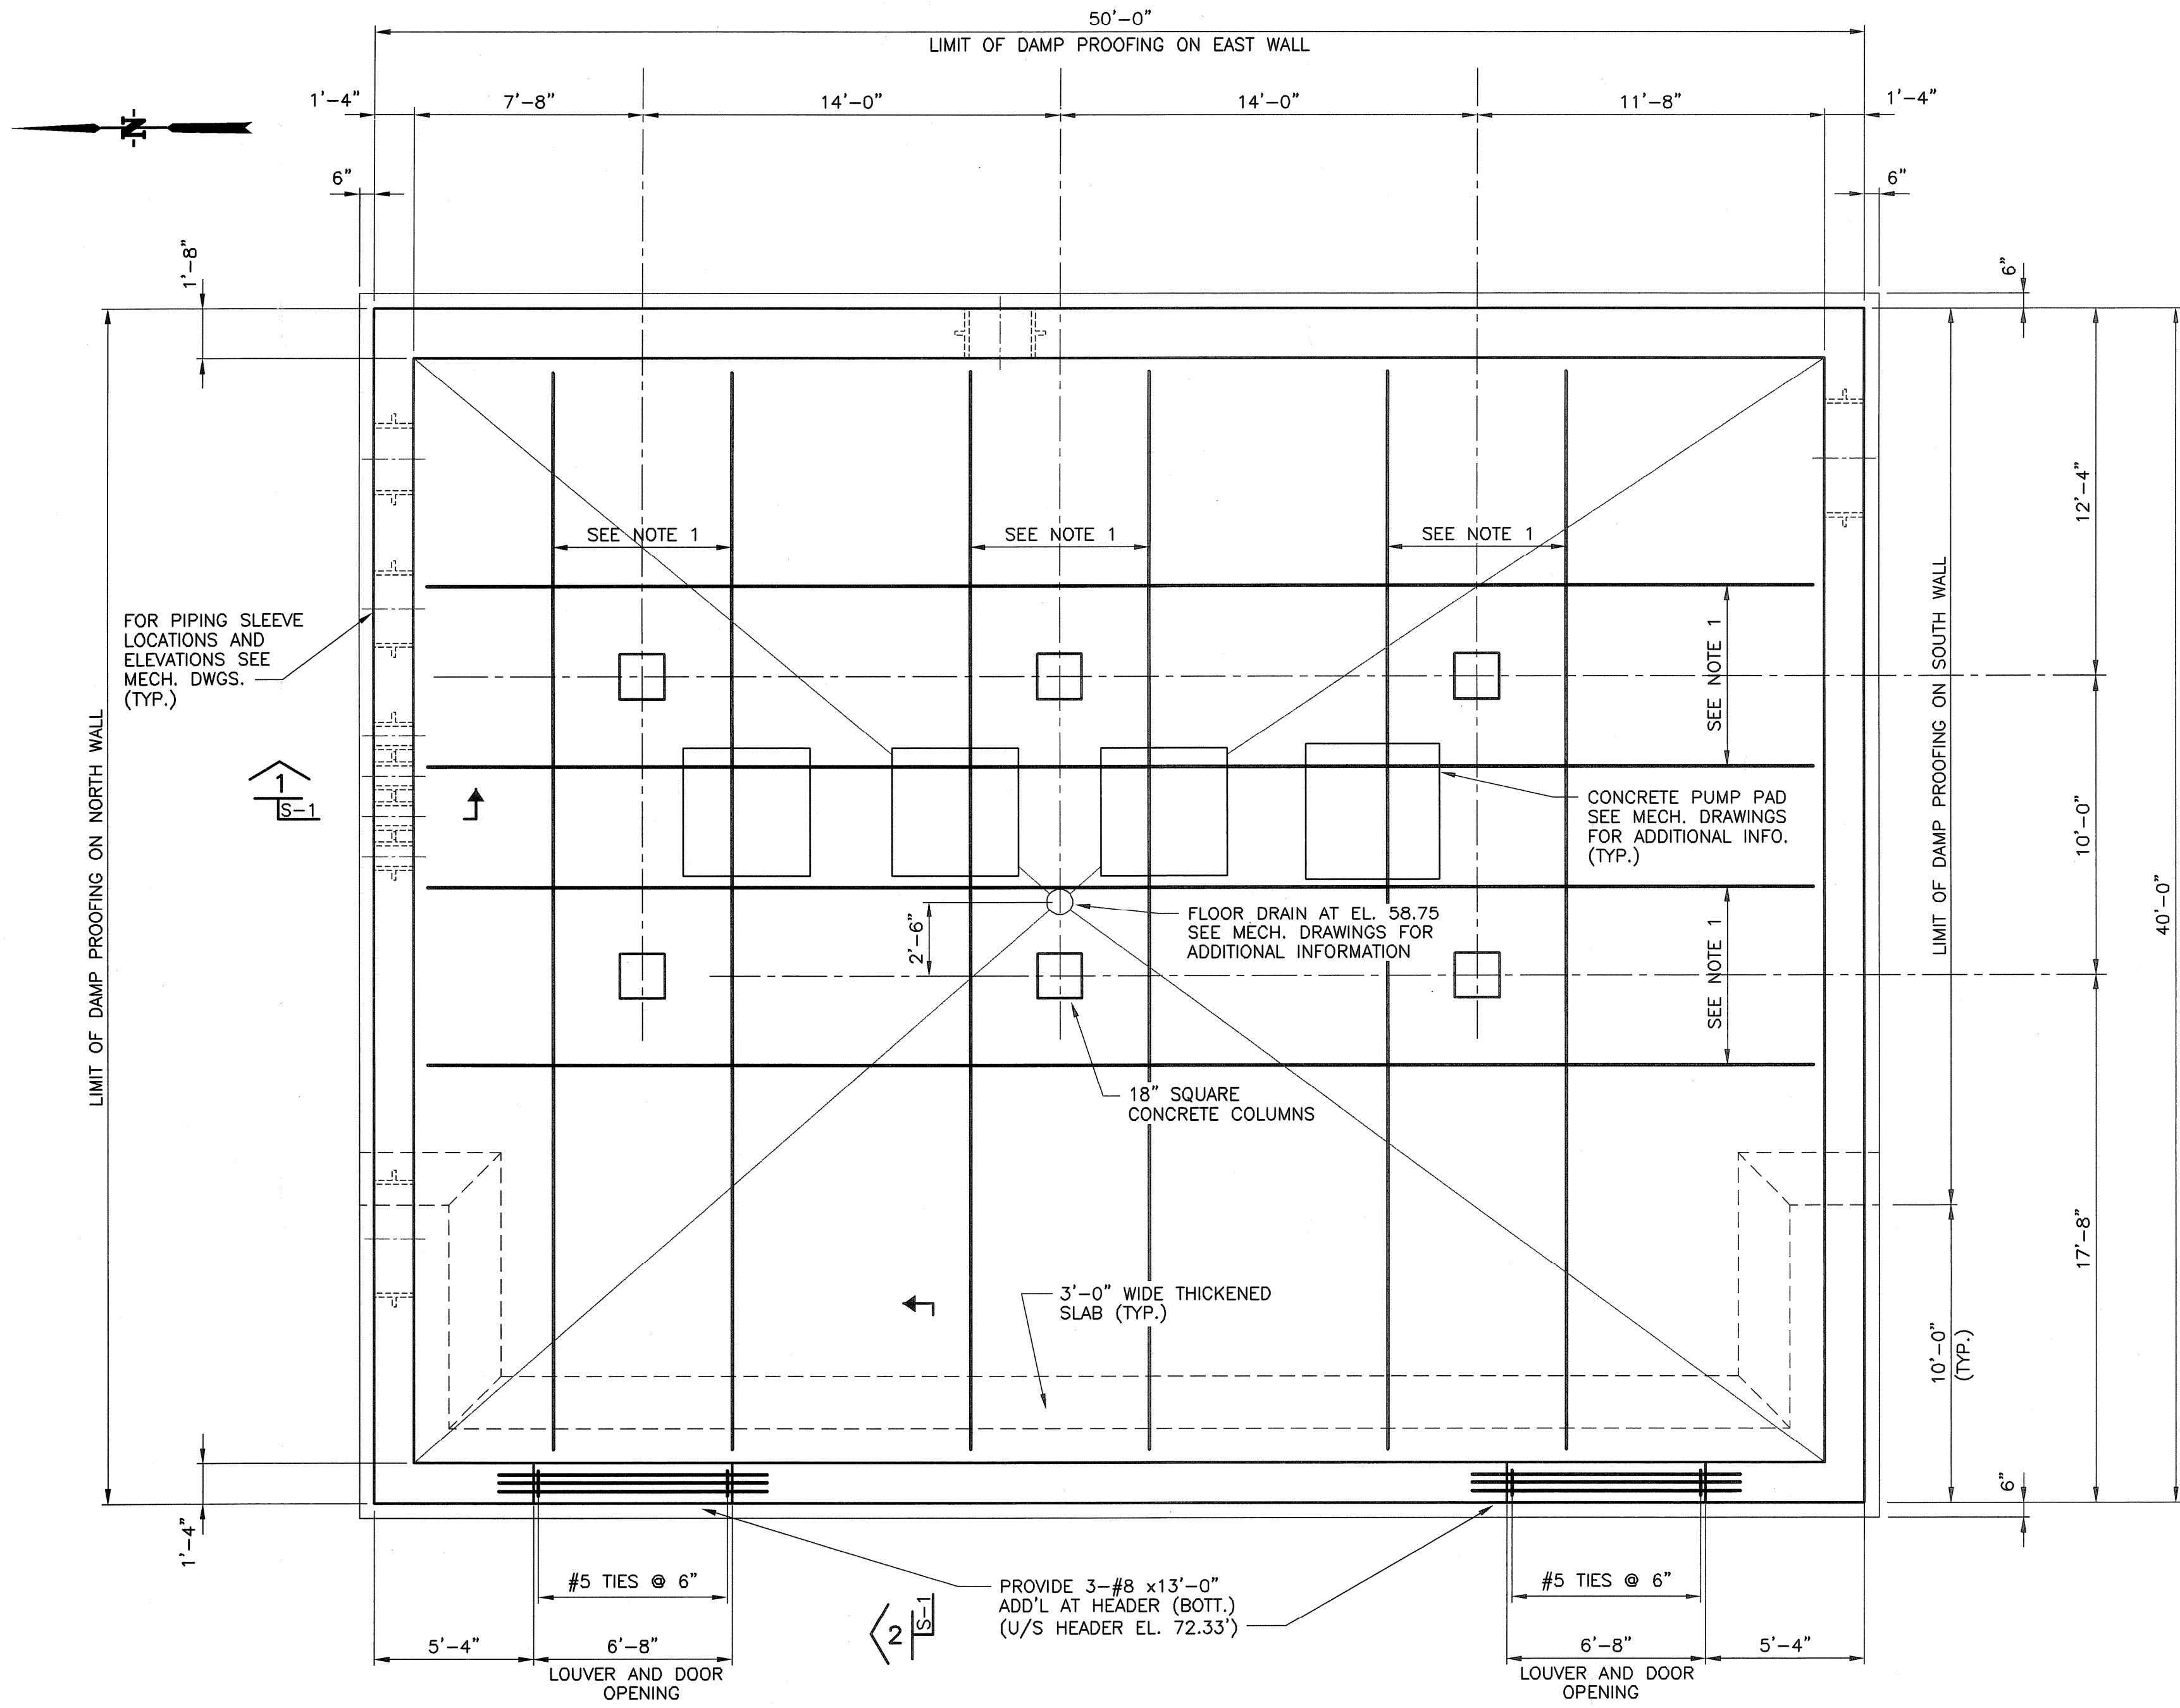


FOUNDATION PLAN AT ELEV. 59.00
 SCALE: 1/4" = 1'-0"


- NOTES:
1. PROVIDE 7-#9@12 ADDITIONAL REINFORCING TOP AND BOTTOM CENTERED ON COLUMNS, ALTERNATE WITH TYPICAL SLAB REINFORCING.
 2. MINIMUM CONCRETE FLOOR SLAB THICKNESS TO BE 2'-0".

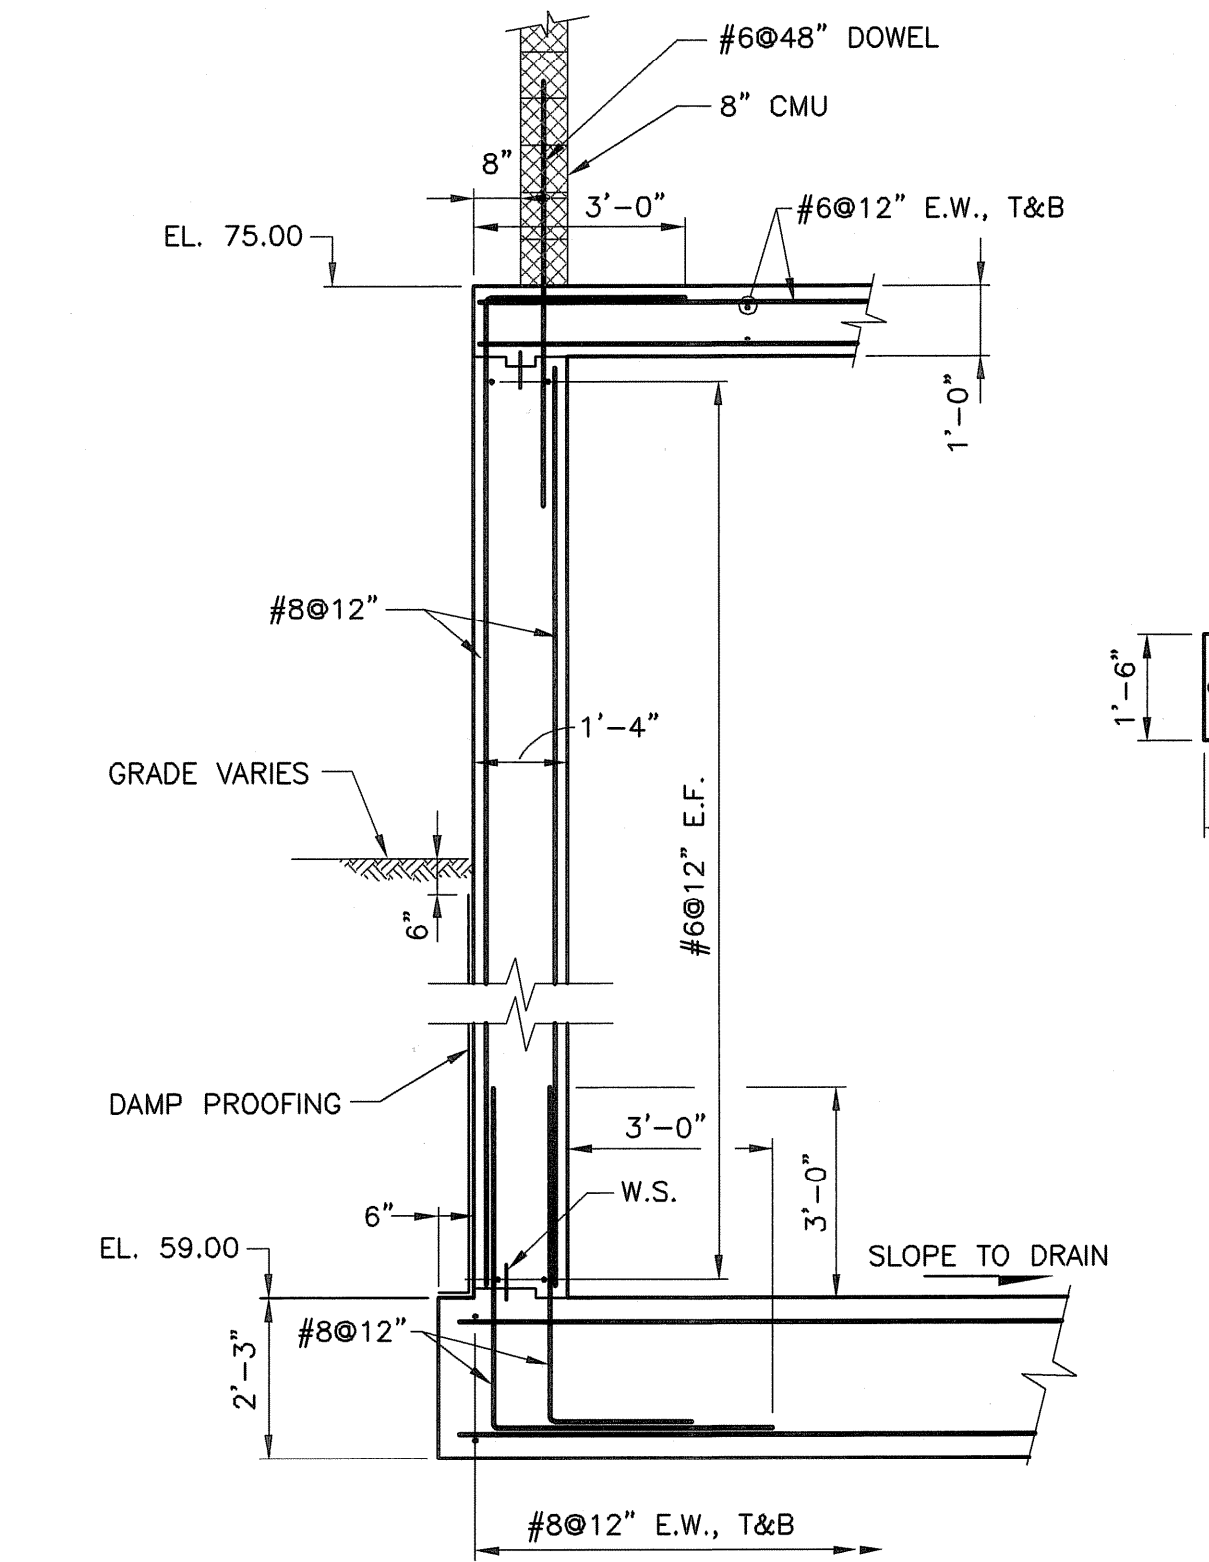


SECTION 1-1
 SCALE: 3/8" = 1'-0"

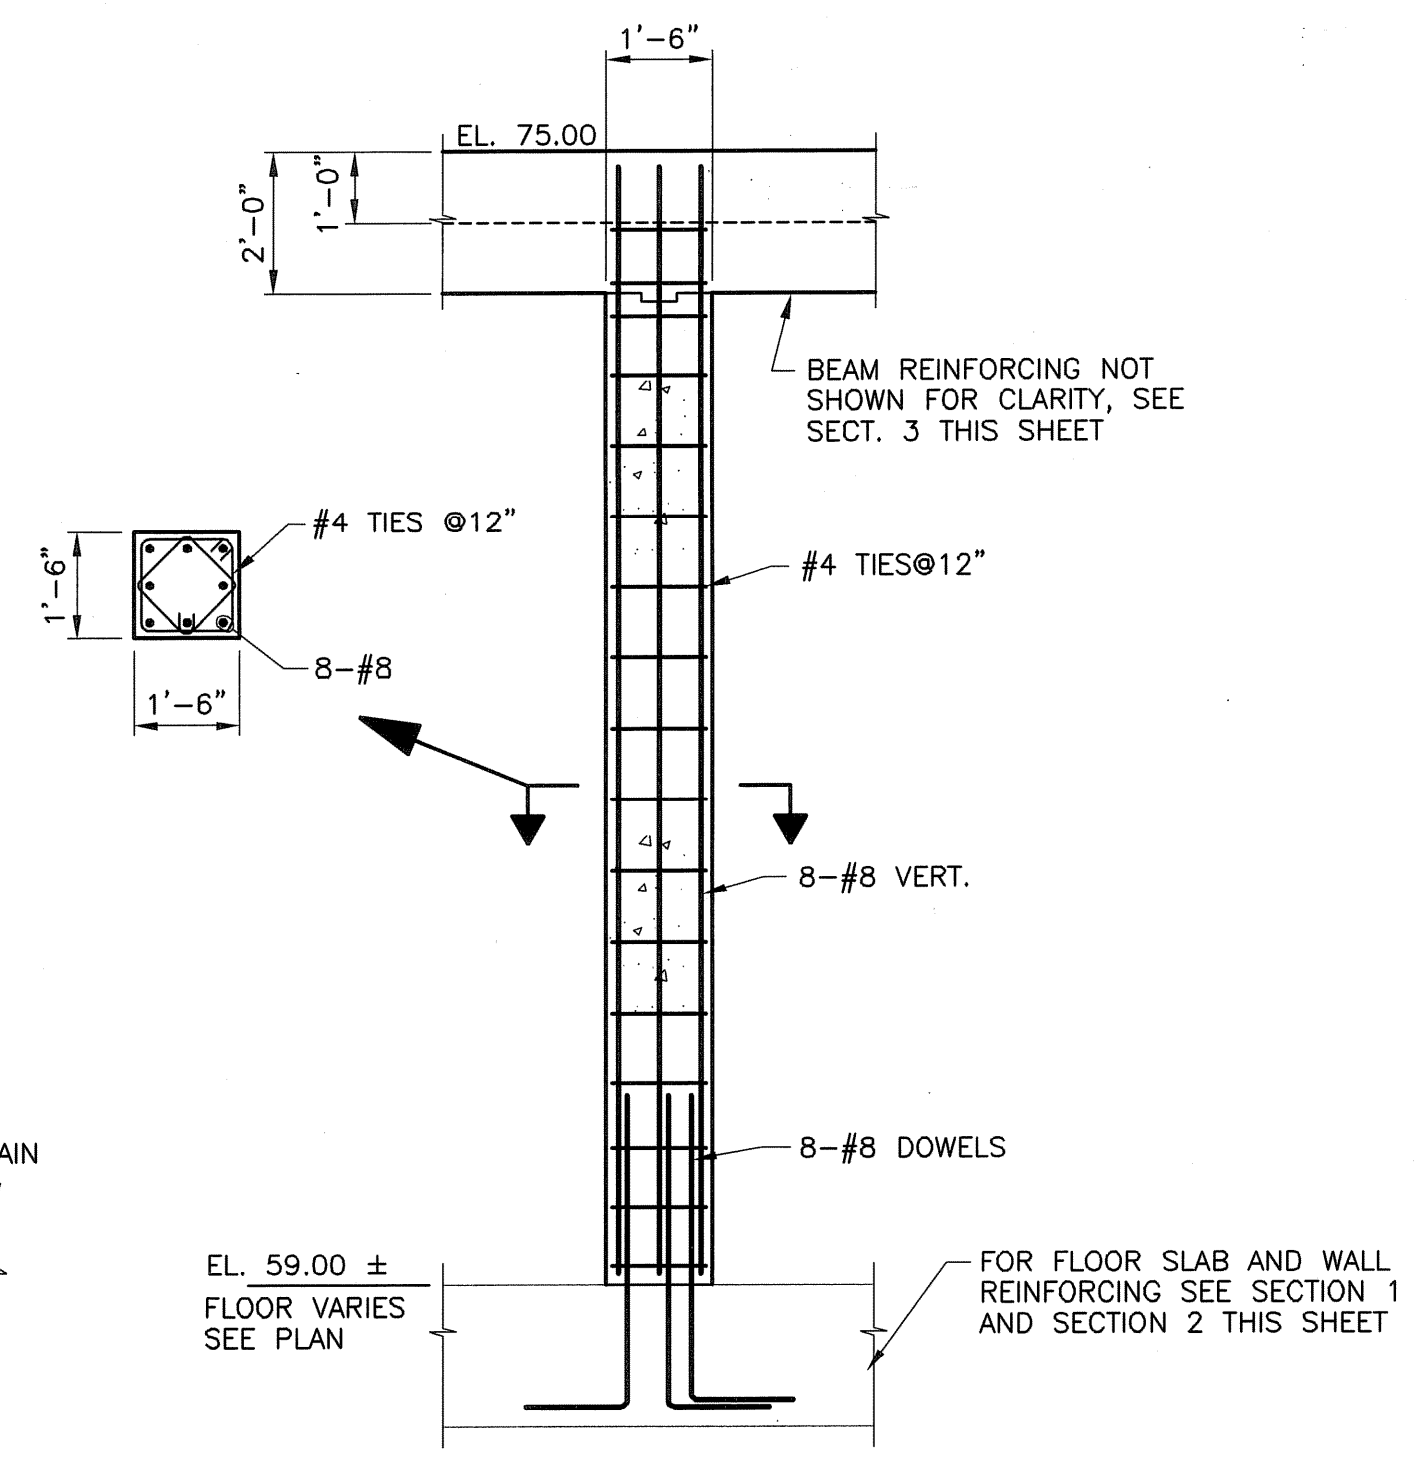

TYPICAL COLUMN REINFORCING DETAIL
 NOT TO SCALE

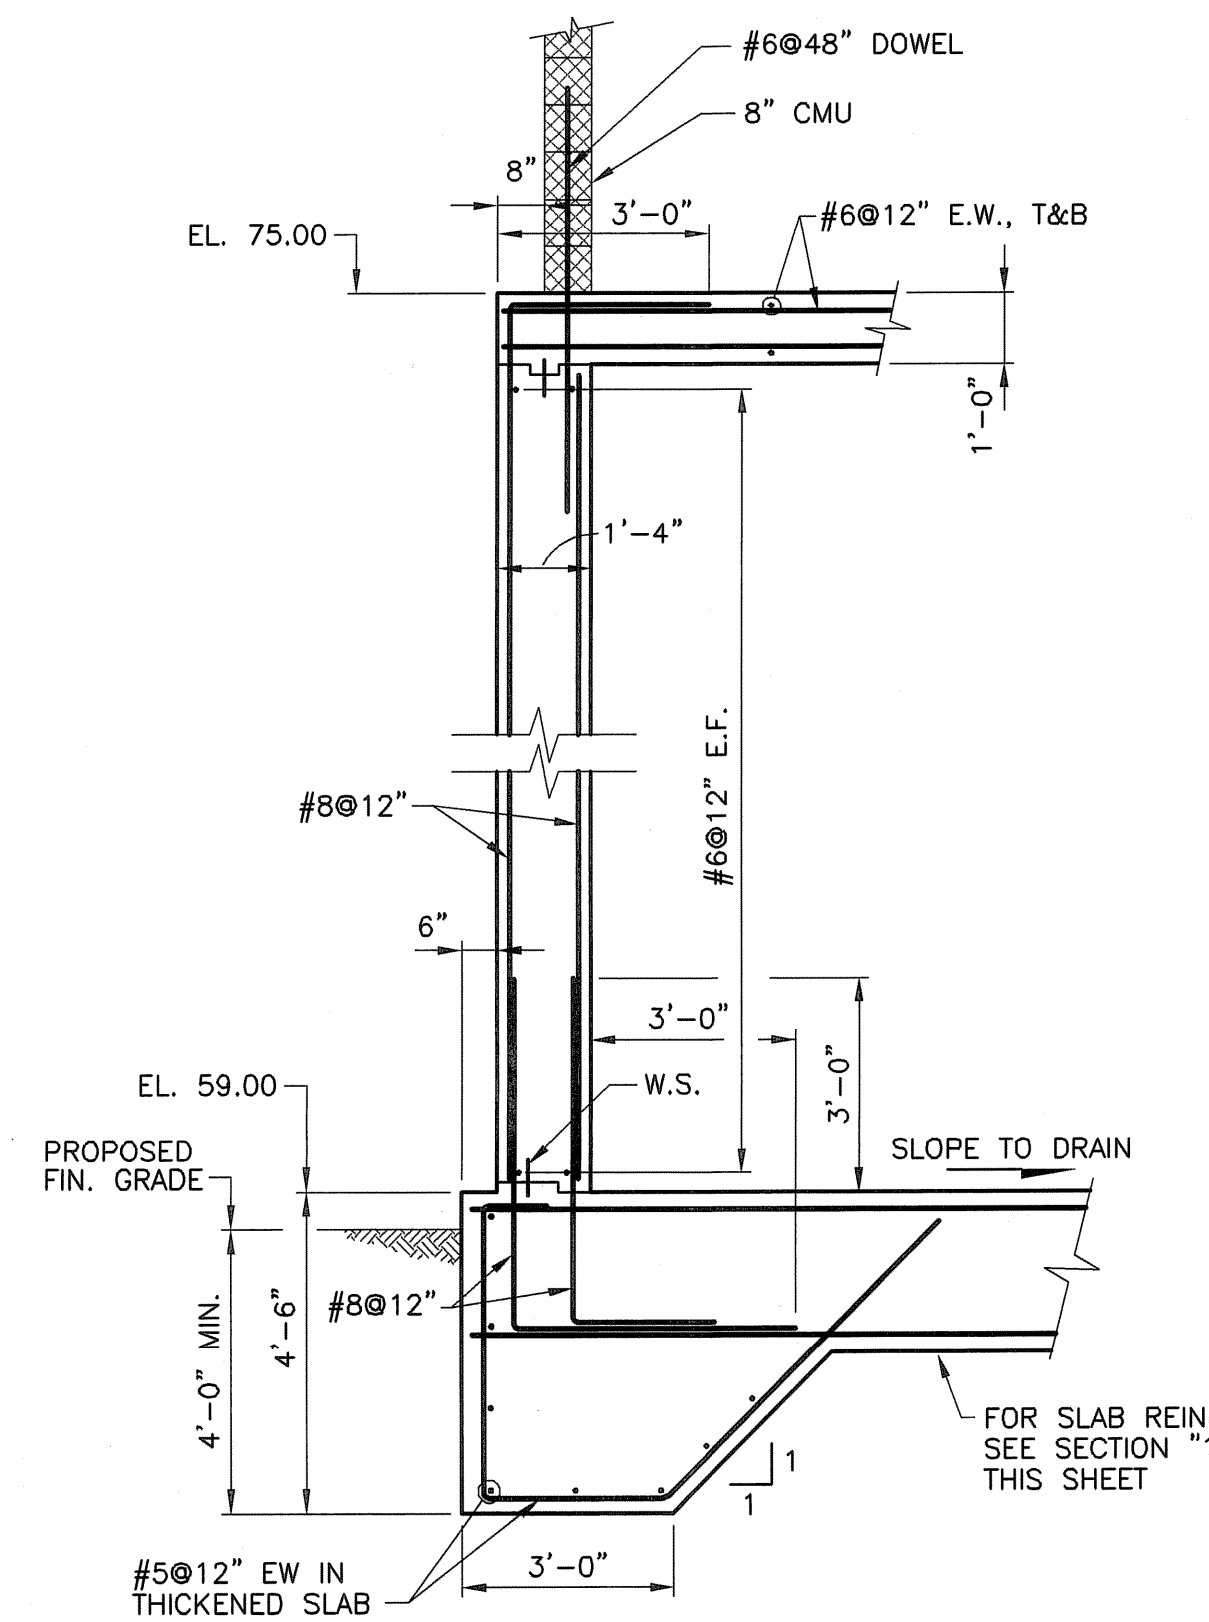

SECTION 2-1
 SCALE: 3/8" = 1'-0"

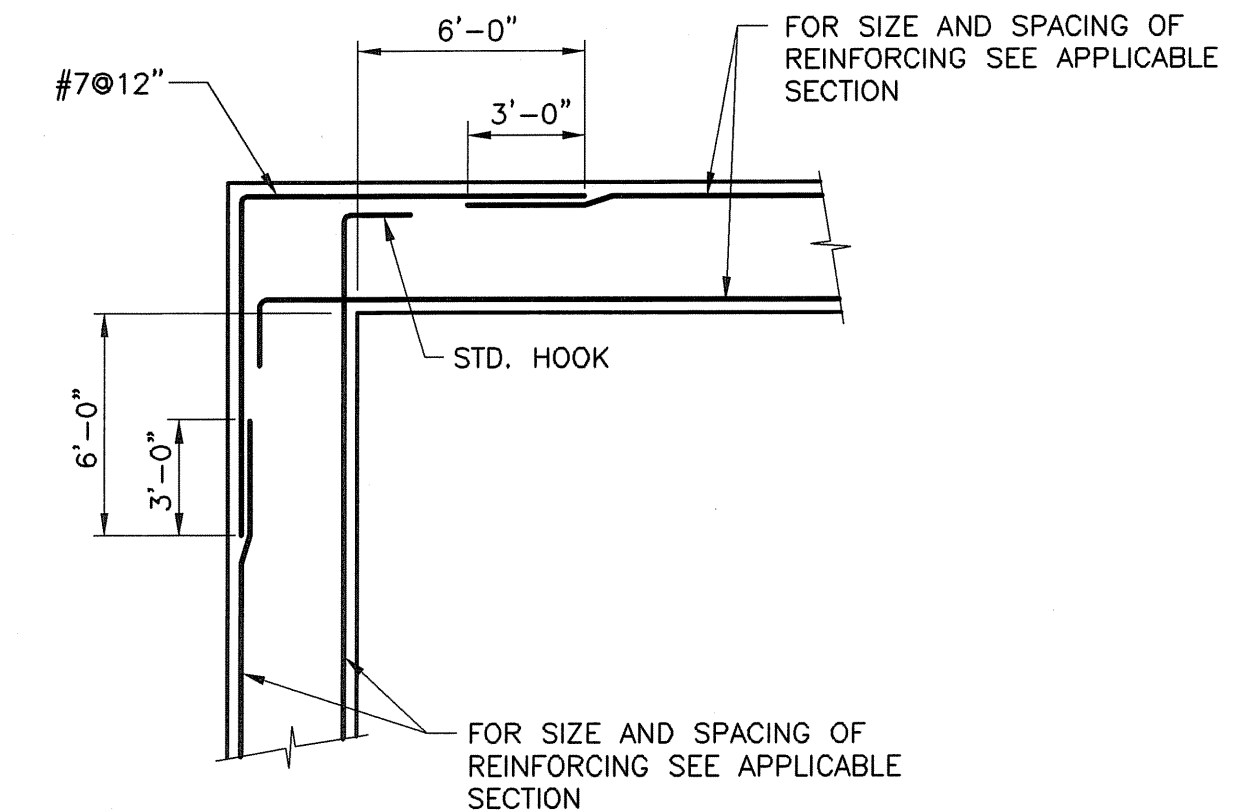

TYPICAL CORNER REINFORCING DETAIL
 NOT TO SCALE

ROBERT H. SHELDON
 No. 4103
 3/17/09


PAWTUCKET, RHODE ISLAND
**PAWTUCKET REGIONAL
 WATER TREATMENT FACILITY**
PKGS 11 & 12 - RAW WATER PUMP STATION
 STRUCTURAL PLANS AT EL. 59.00

DESIGNED BY	DWG SCALE
DRAWN BY	AS NOTED
CHECKED BY	CONTRACT NO.
	DATE
	OCTOBER 31, 2008

EARTH TECH
AS-BUILT FILE
 MAY 2008


AS-BUILT DRAWING FILE	DPB	MAY 2008
ISSUED FOR RFI POSTED SET	1	10/31/05
ISSUED FOR CONSTRUCTION	0	10/28/05
REV. B AGENCY REVIEW	B	8/16/05
REV. A CLIENT REVIEW	A	7/22/05
REVISIONS	BY	DATE

Filename: L:\WORK\69993\CAD\AS-BUILT\11-12 RWTP\STRUC\69993-11_S1-3.DWG
 Plot File Date Created: Sep/22/2008 11:34 AM

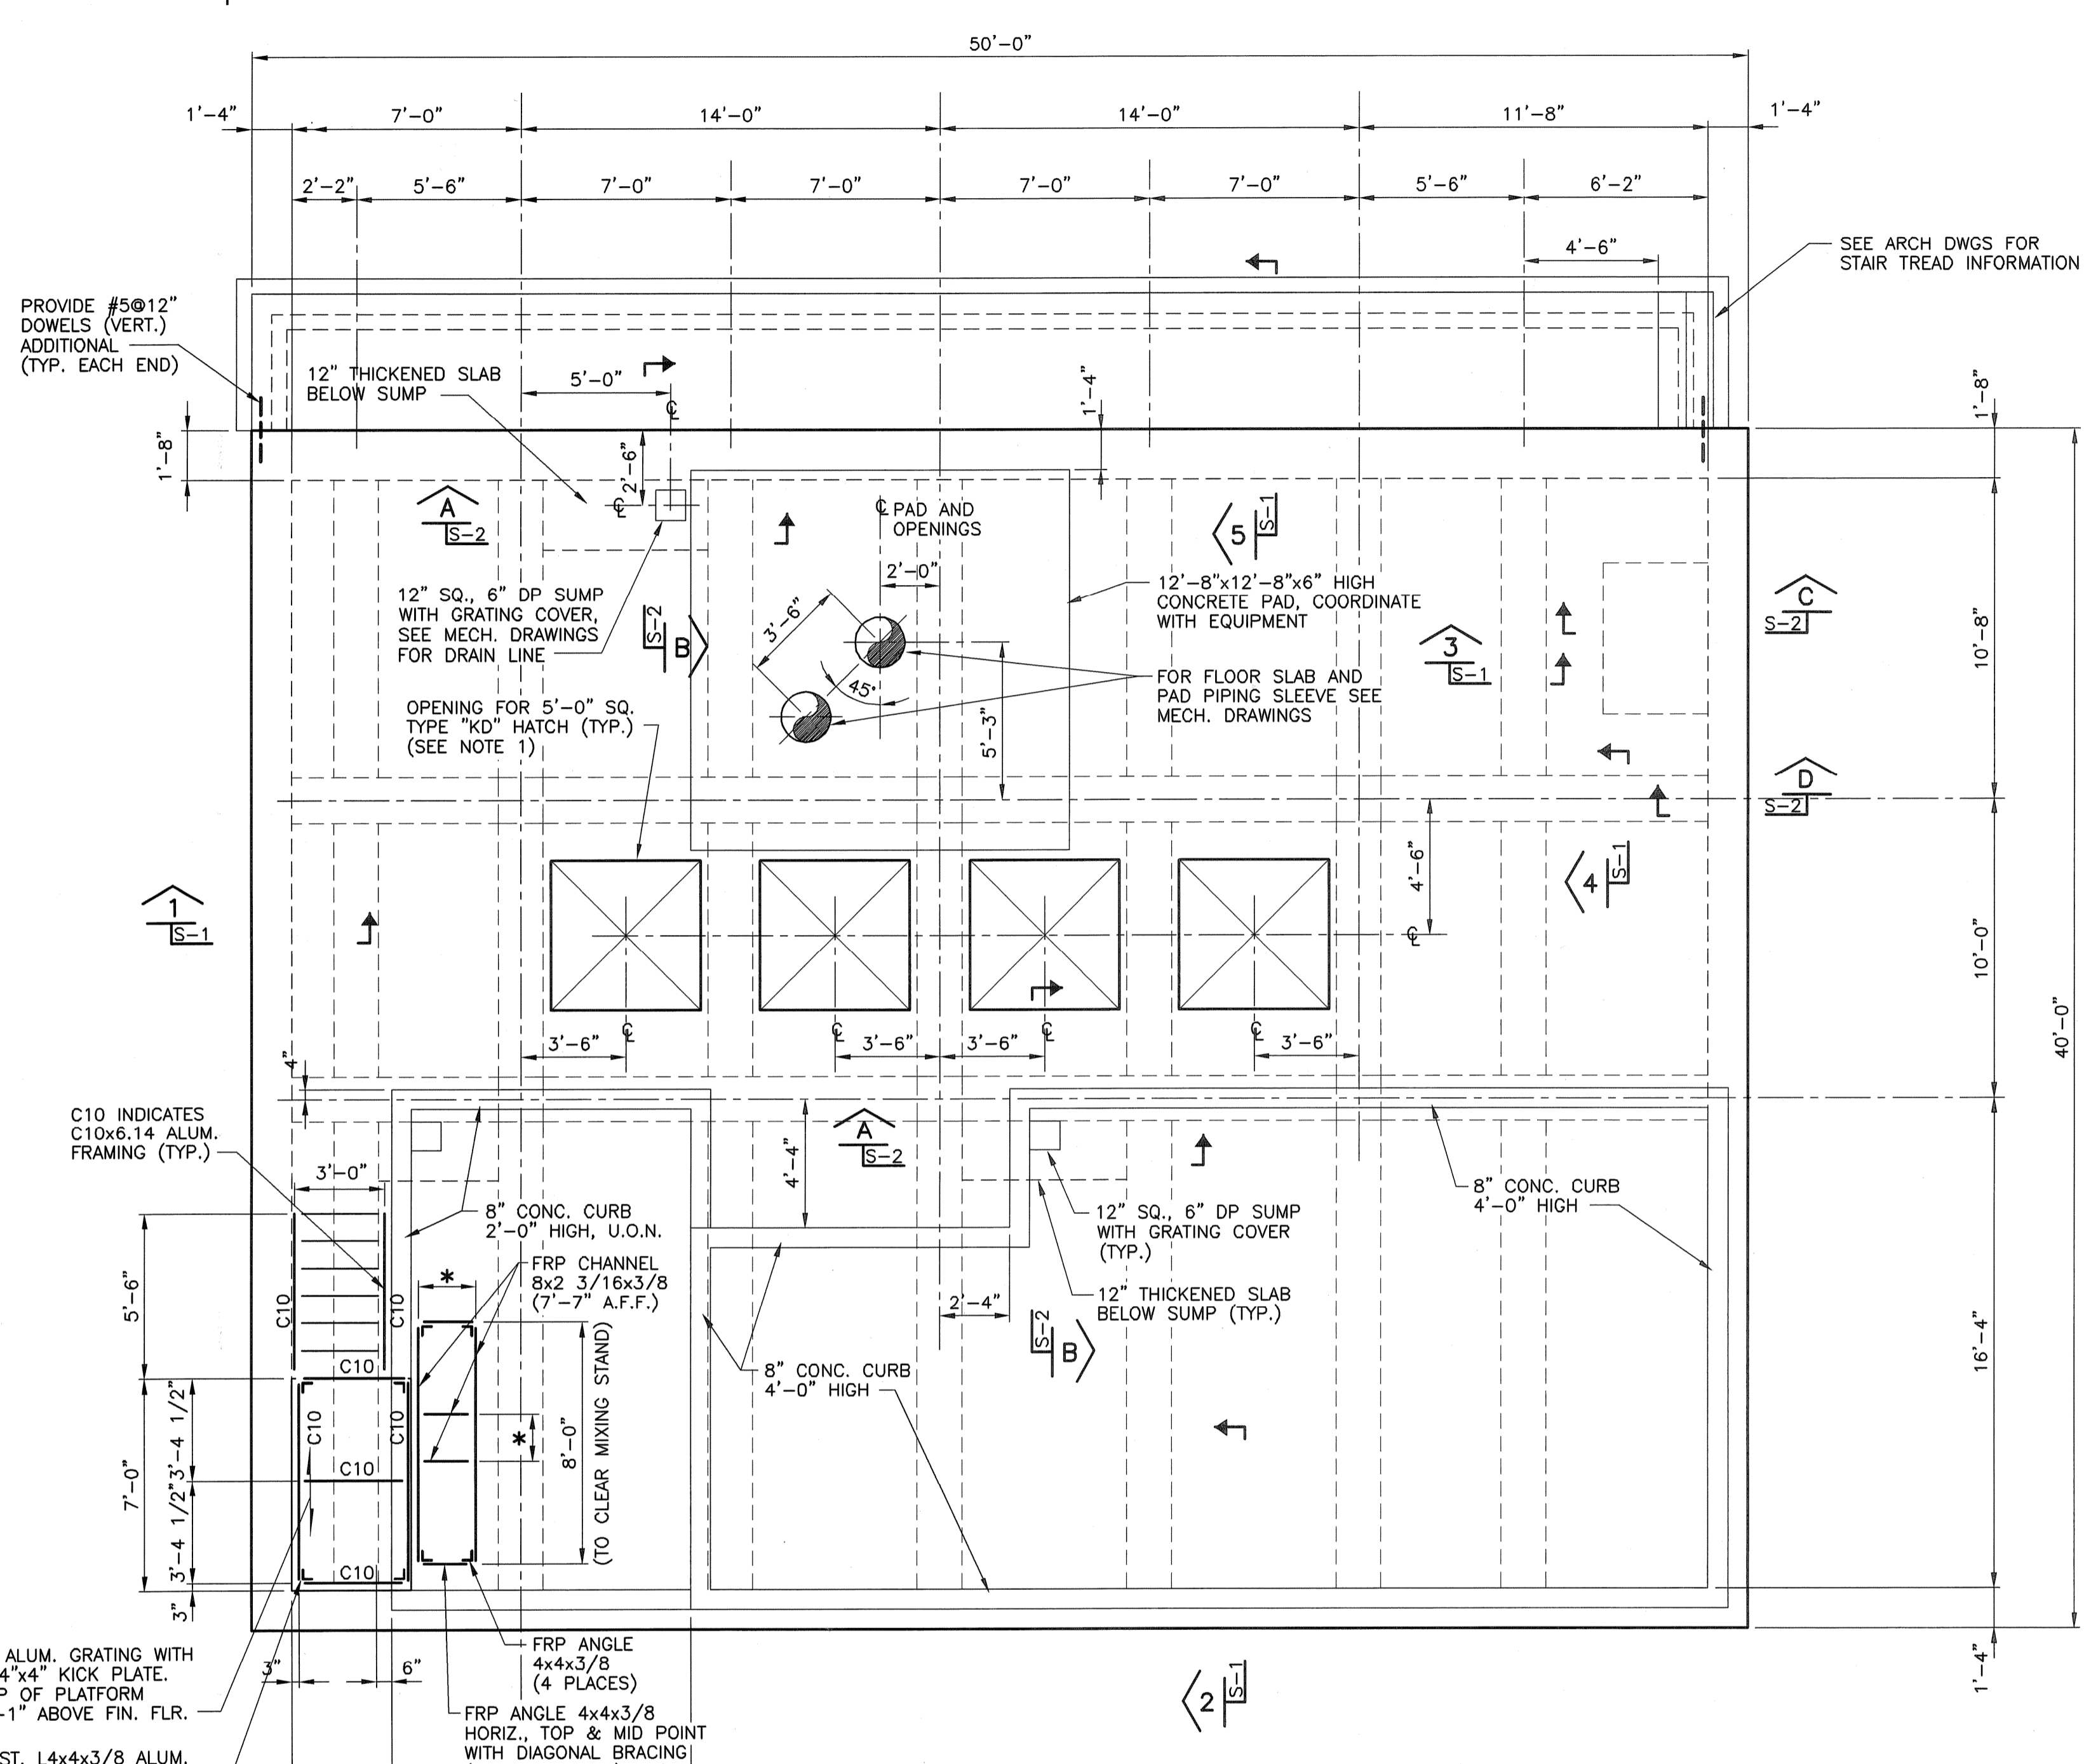

GROUND FLOOR PLAN AT ELEV. 75.00


- NOTE:
 1. HATCH COVERS TO BE DESIGNED FOR 7,200 LBS WHEEL LOAD.
 2. * - INDICATES DIMENSIONS TO BE COORDINATED WITH EQUIPMENT MANUFACTURER.

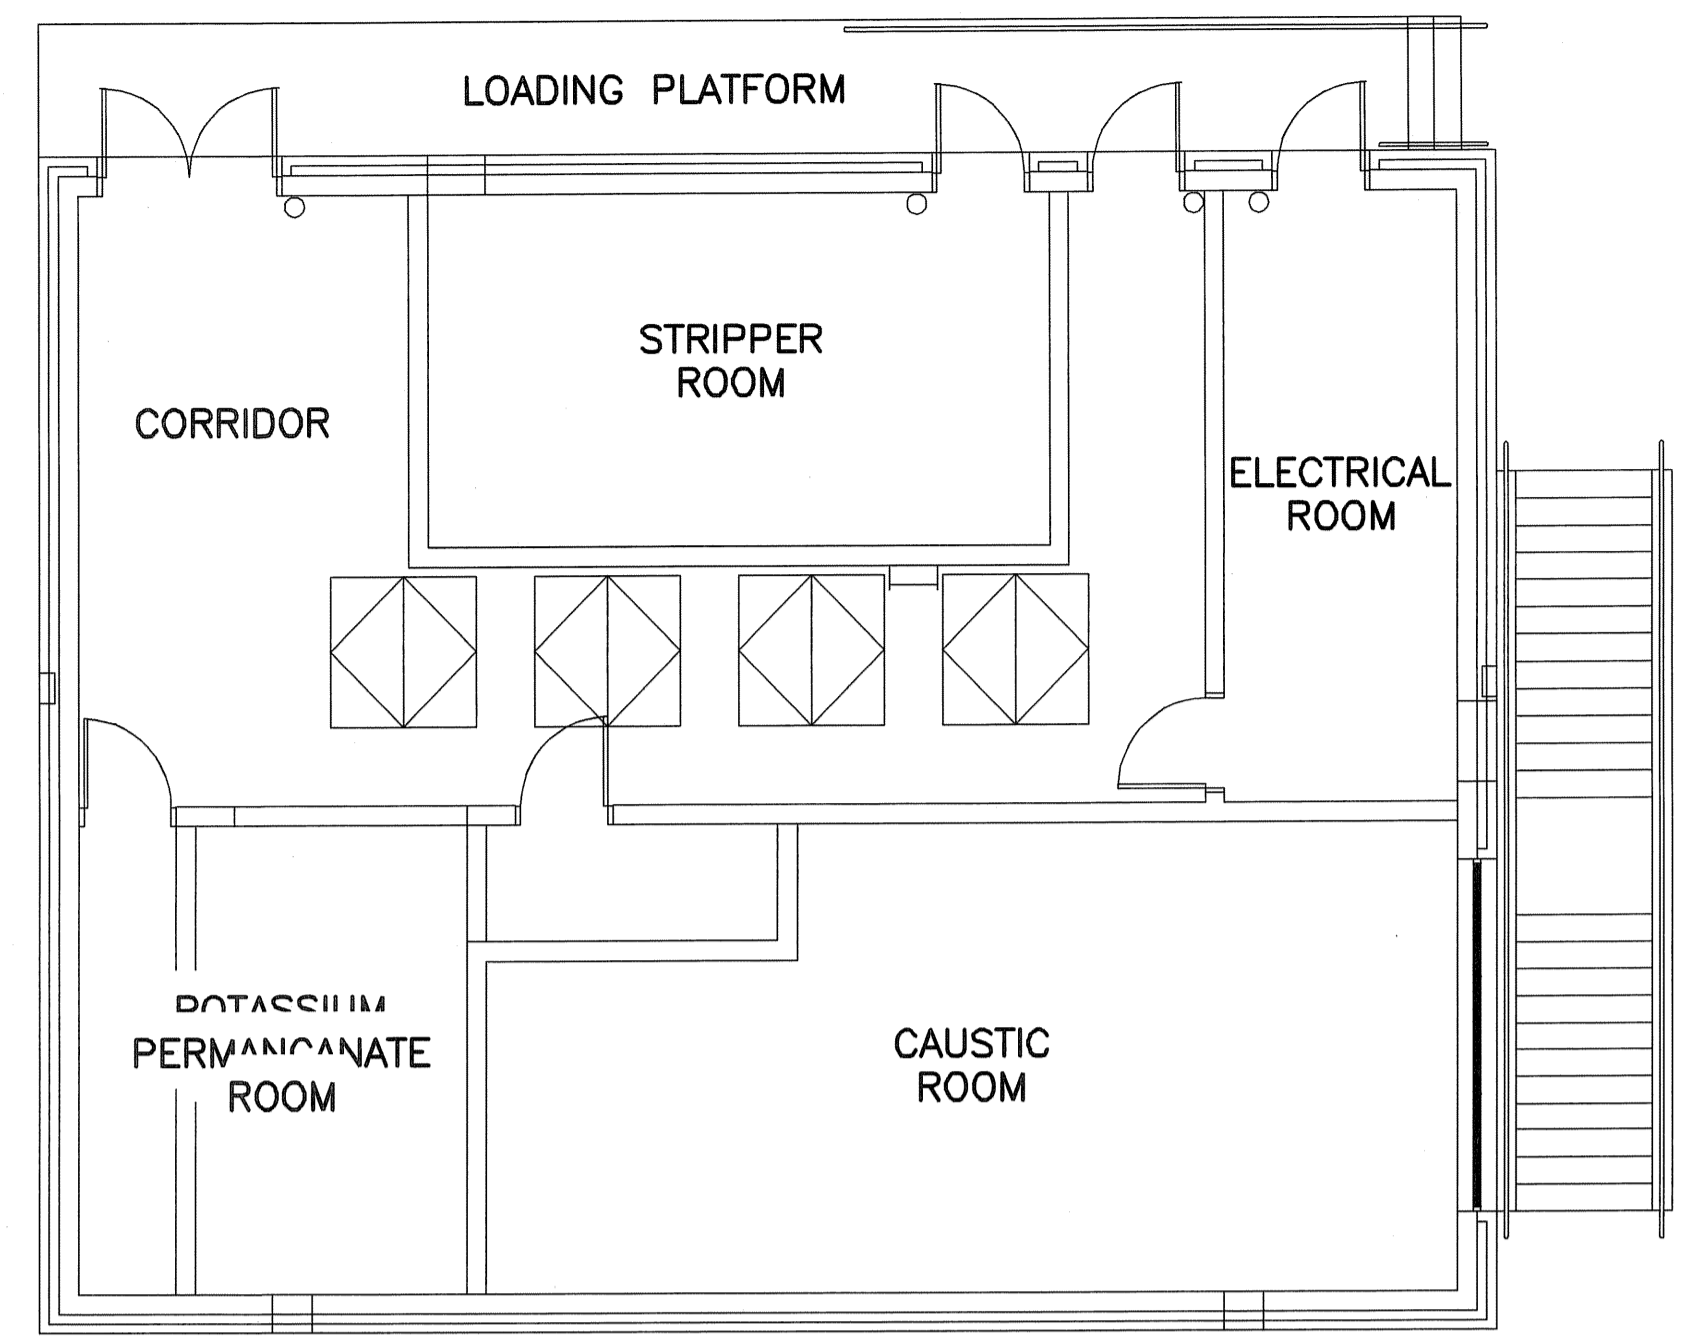


FLOOR LOADING PLAN
NOT TO SCALE

FLOOR LIVE LOADS:


CAUSTIC SODA ROOM	500 PSF
POTASSIUM PERMANGANATE ROOM	300 PSF
LOADING PLATFORM	200 PSF
STRIPPER ROOM	3500 LB
CORRIDOR	7,200 LB WHEEL LOAD
ELECTRICAL ROOM	250 PSF

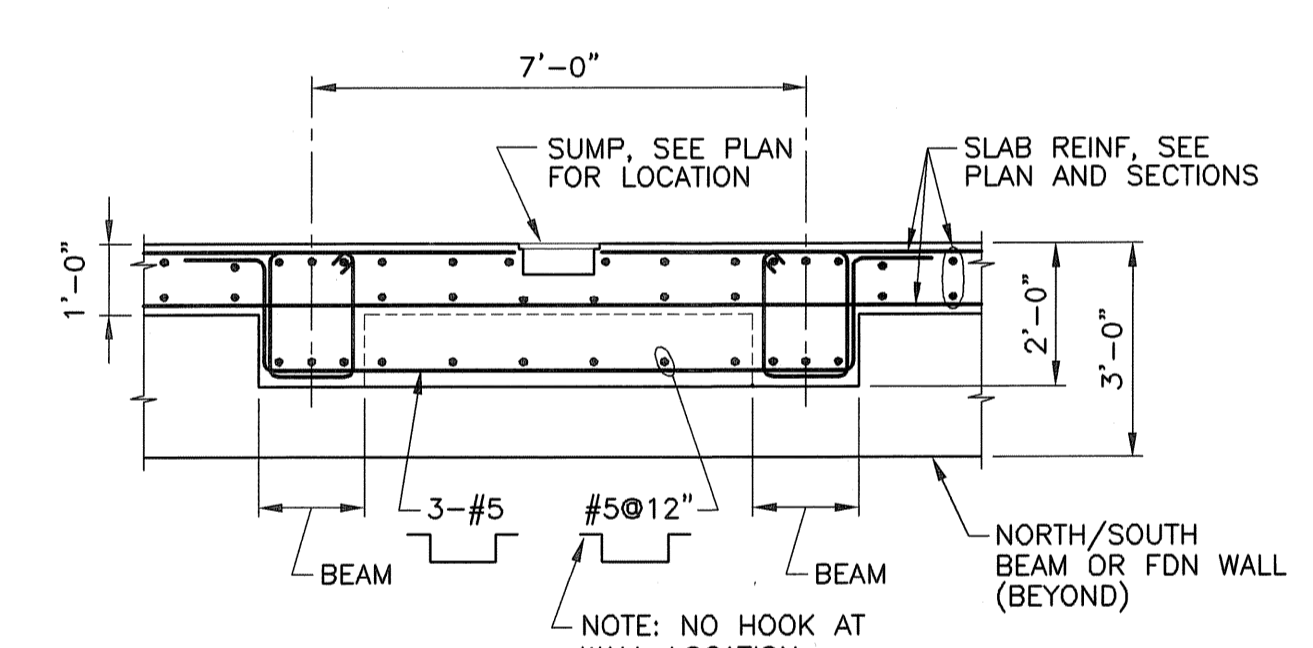

SECTION A-S-2
SCALE: 3/8" = 1'-0"

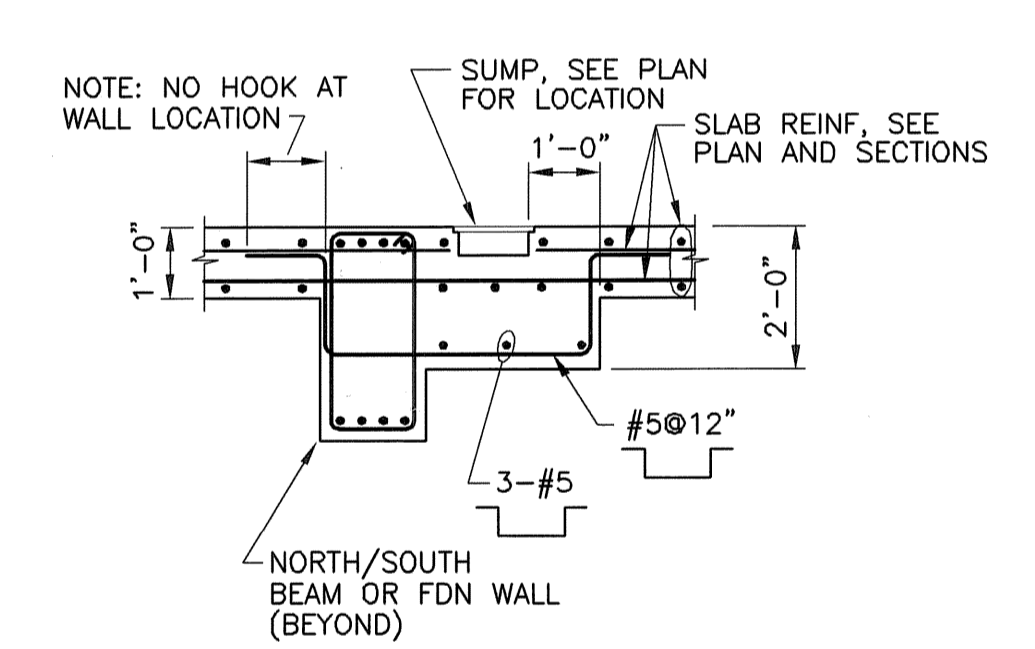


SECTION B-S-2
SCALE: 3/8" = 1'-0"

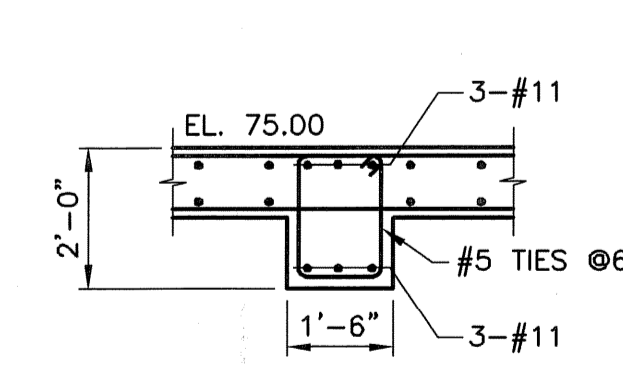


SECTION 3-S-2
SCALE: 3/8" = 1'-0"

NOTE:
TYPICAL FOR ALL EAST-WEST BEAMS.

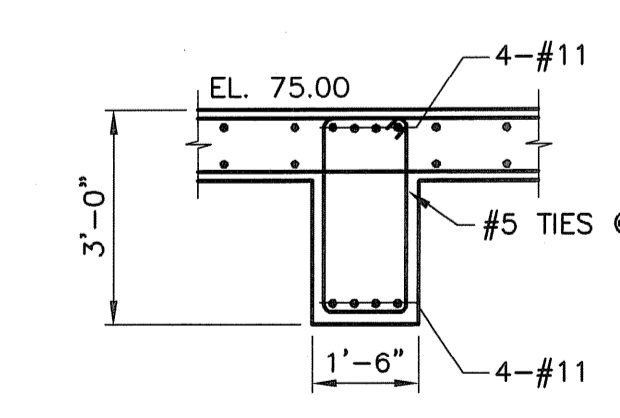


SECTION 4-S-2
SCALE: 3/8" = 1'-0"


NOTE:
TYPICAL FOR ALL NORTH-SOUTH BEAMS.

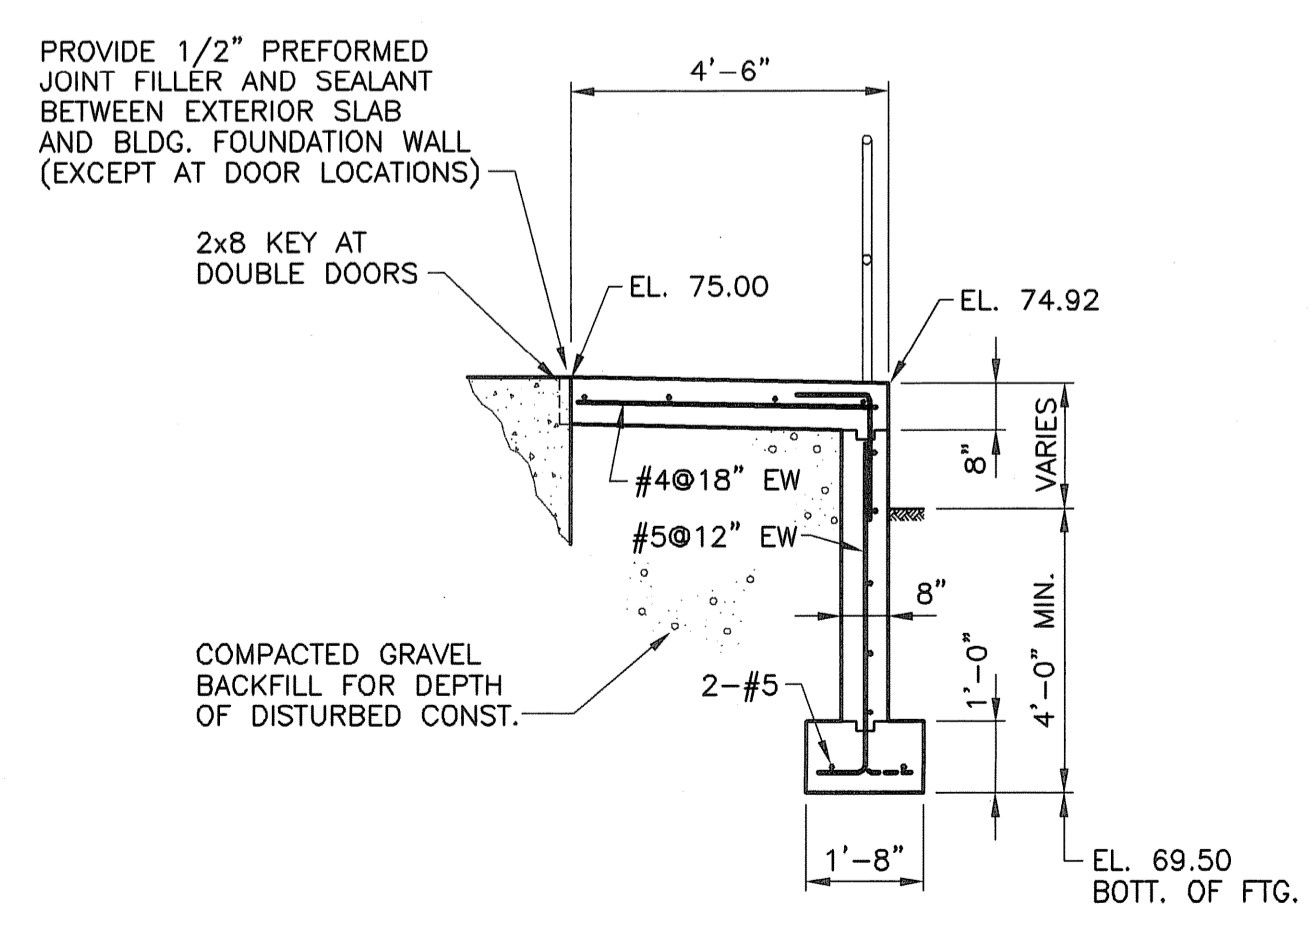

SECTION 5-S-2
SCALE: 3/8" = 1'-0"

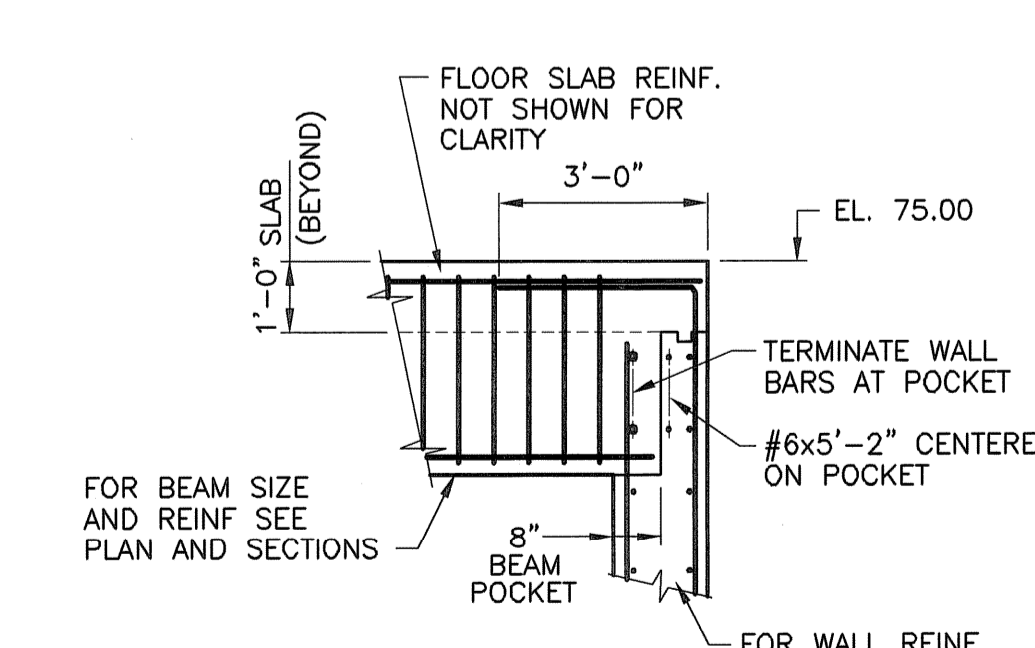

SECTION C-S-2
SCALE: 3/8" = 1'-0"

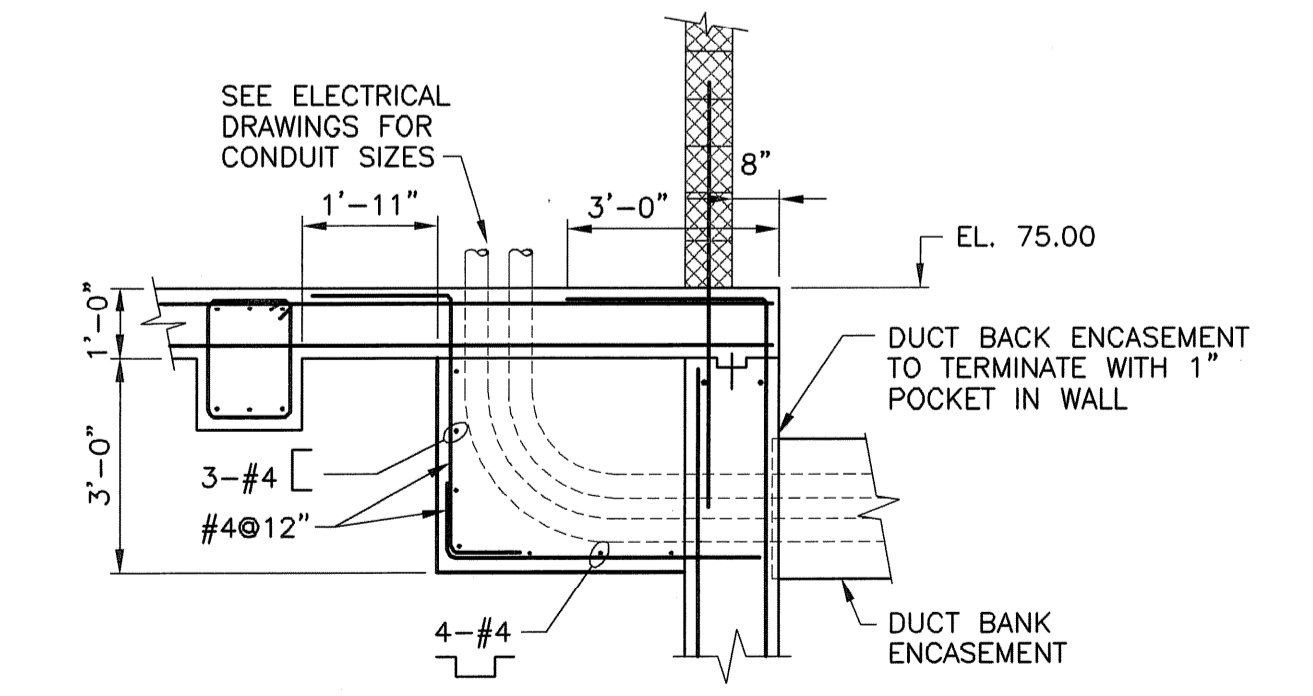

SECTION D-S-2
SCALE: 3/8" = 1'-0"

ROBERT H. SHELDON
 No. 4103
 REGISTERED PROFESSIONAL ENGINEER
 3/1/09


PAWTUCKET, RHODE ISLAND
PAWTUCKET REGIONAL WATER TREATMENT FACILITY
PKGS 11 & 12 - RAW WATER PUMP STATION
 STRUCTURAL PLAN AT EL. 75.00

DESIGNED BY	DWG SCALE AS NOTED
DRAWN BY	CONTRACT NO.
CHECKED BY	DATE
	OCTOBER 31, 2008

EARTH TECH
AS-BUILT FILE
 MAY 2008

DATE	BY	REVISIONS
MAY 2008		
10/21/06		AS-BUILT DRAWING FILE
10/28/05		ISSUED FOR RFI POSTED SET
8/16/05		ISSUED FOR CONSTRUCTION
7/22/05		REV. B AGENCY REVIEW
		REV. A CLIENT REVIEW




Filename: L:\WORK\69993\CAD\AS-BUILT\11-12\RWTP\STRUC\69993-11_S1-3.DWG
 Plot File Date Created: Sep/22/2008 11:34 AM

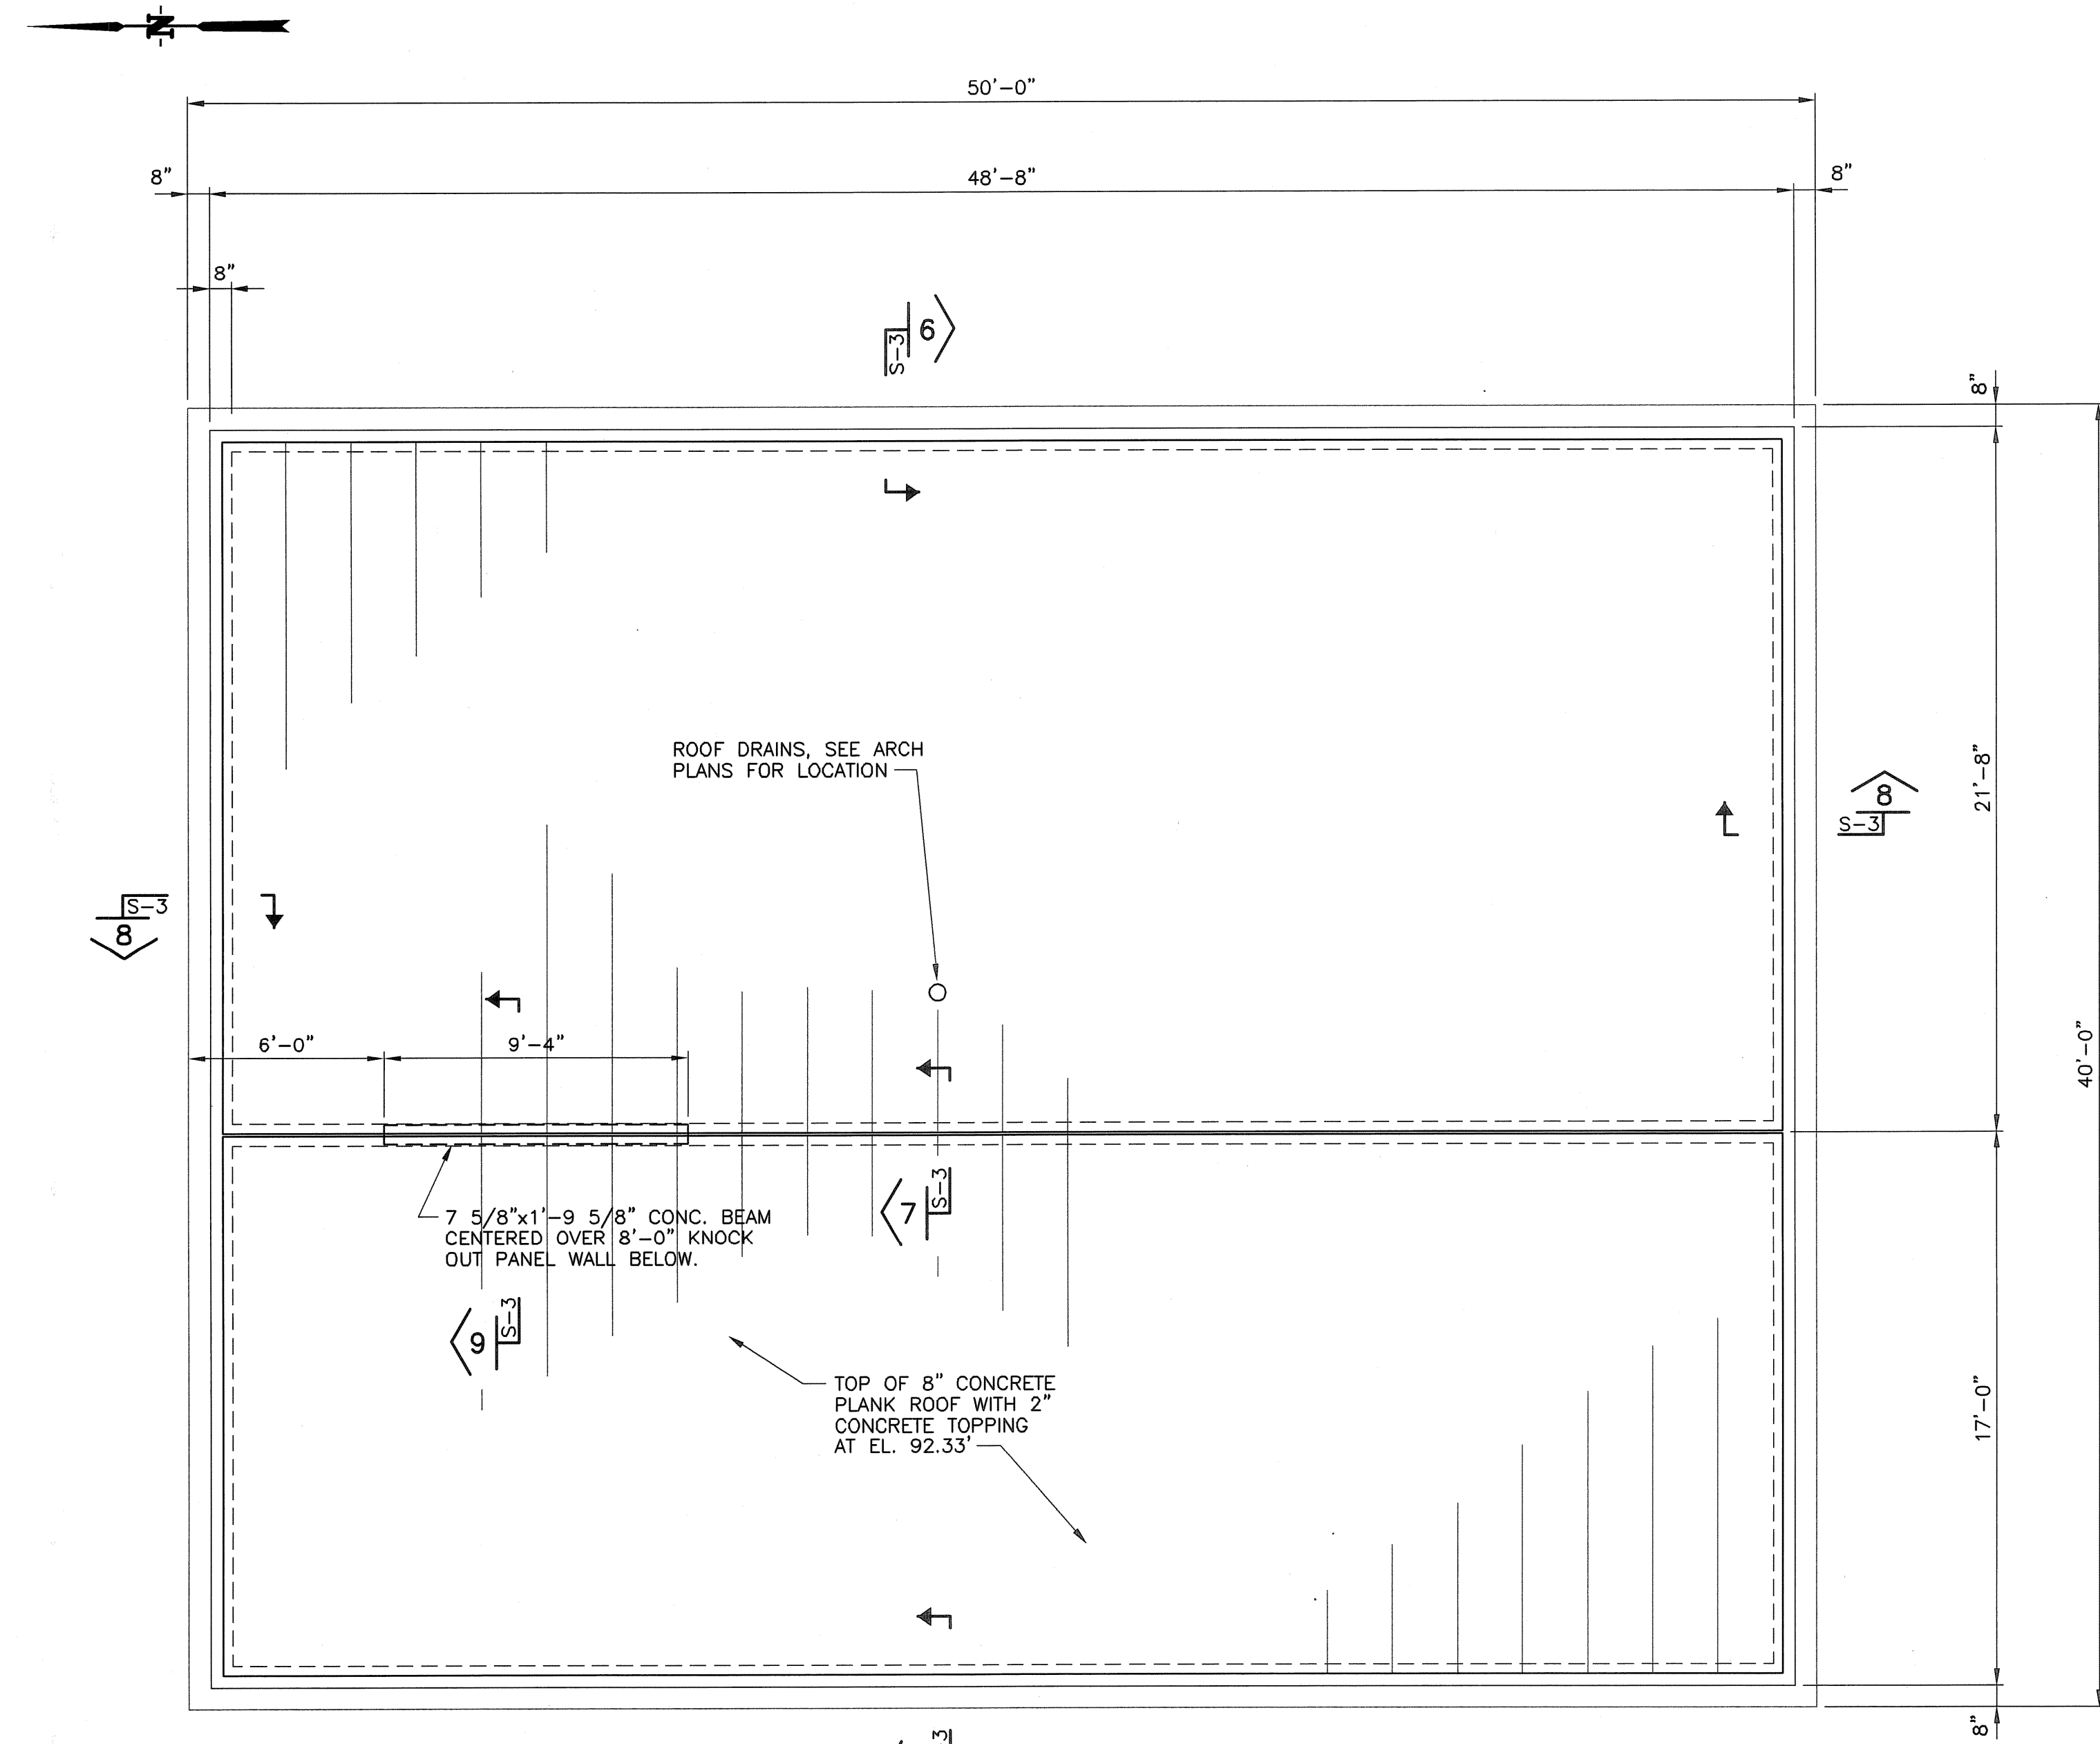

ROOF PLAN
 SCALE: 1/4" = 1'-0"

ROOF PLANK DESIGN LOADS

PLANK AND TOPPING	82 LBS PER SQ. FT.
INSULATION AND MEMBRANE	6 LBS PER SQ. FT.
SUSPENDED MECHANICAL	10 LBS PER SQ. FT.
LIVE LOAD	30 LBS PER SQ. FT.
EYE BOLT HANGER LOAD	7,200 LBS

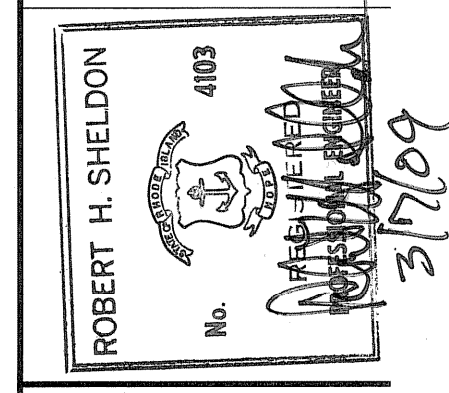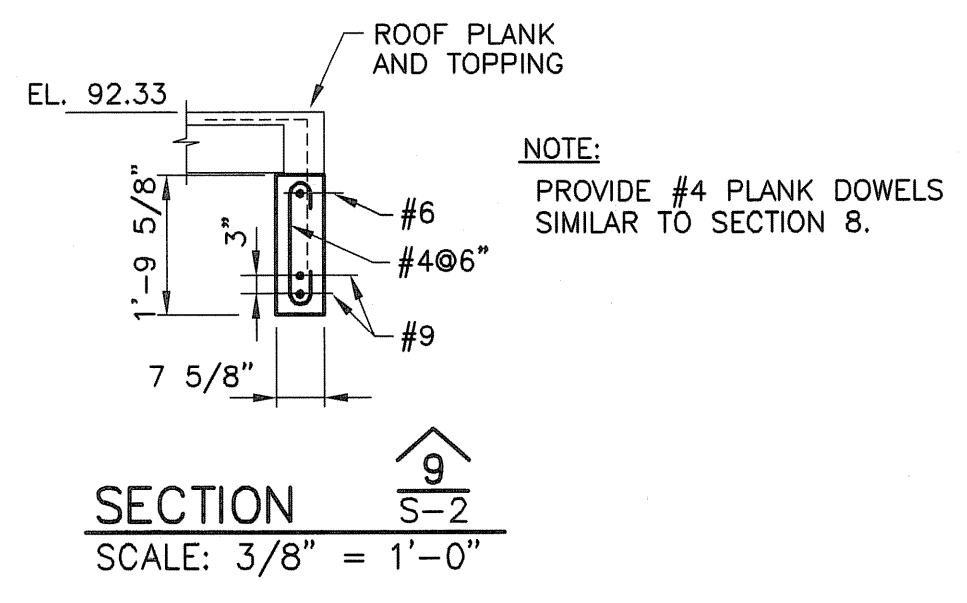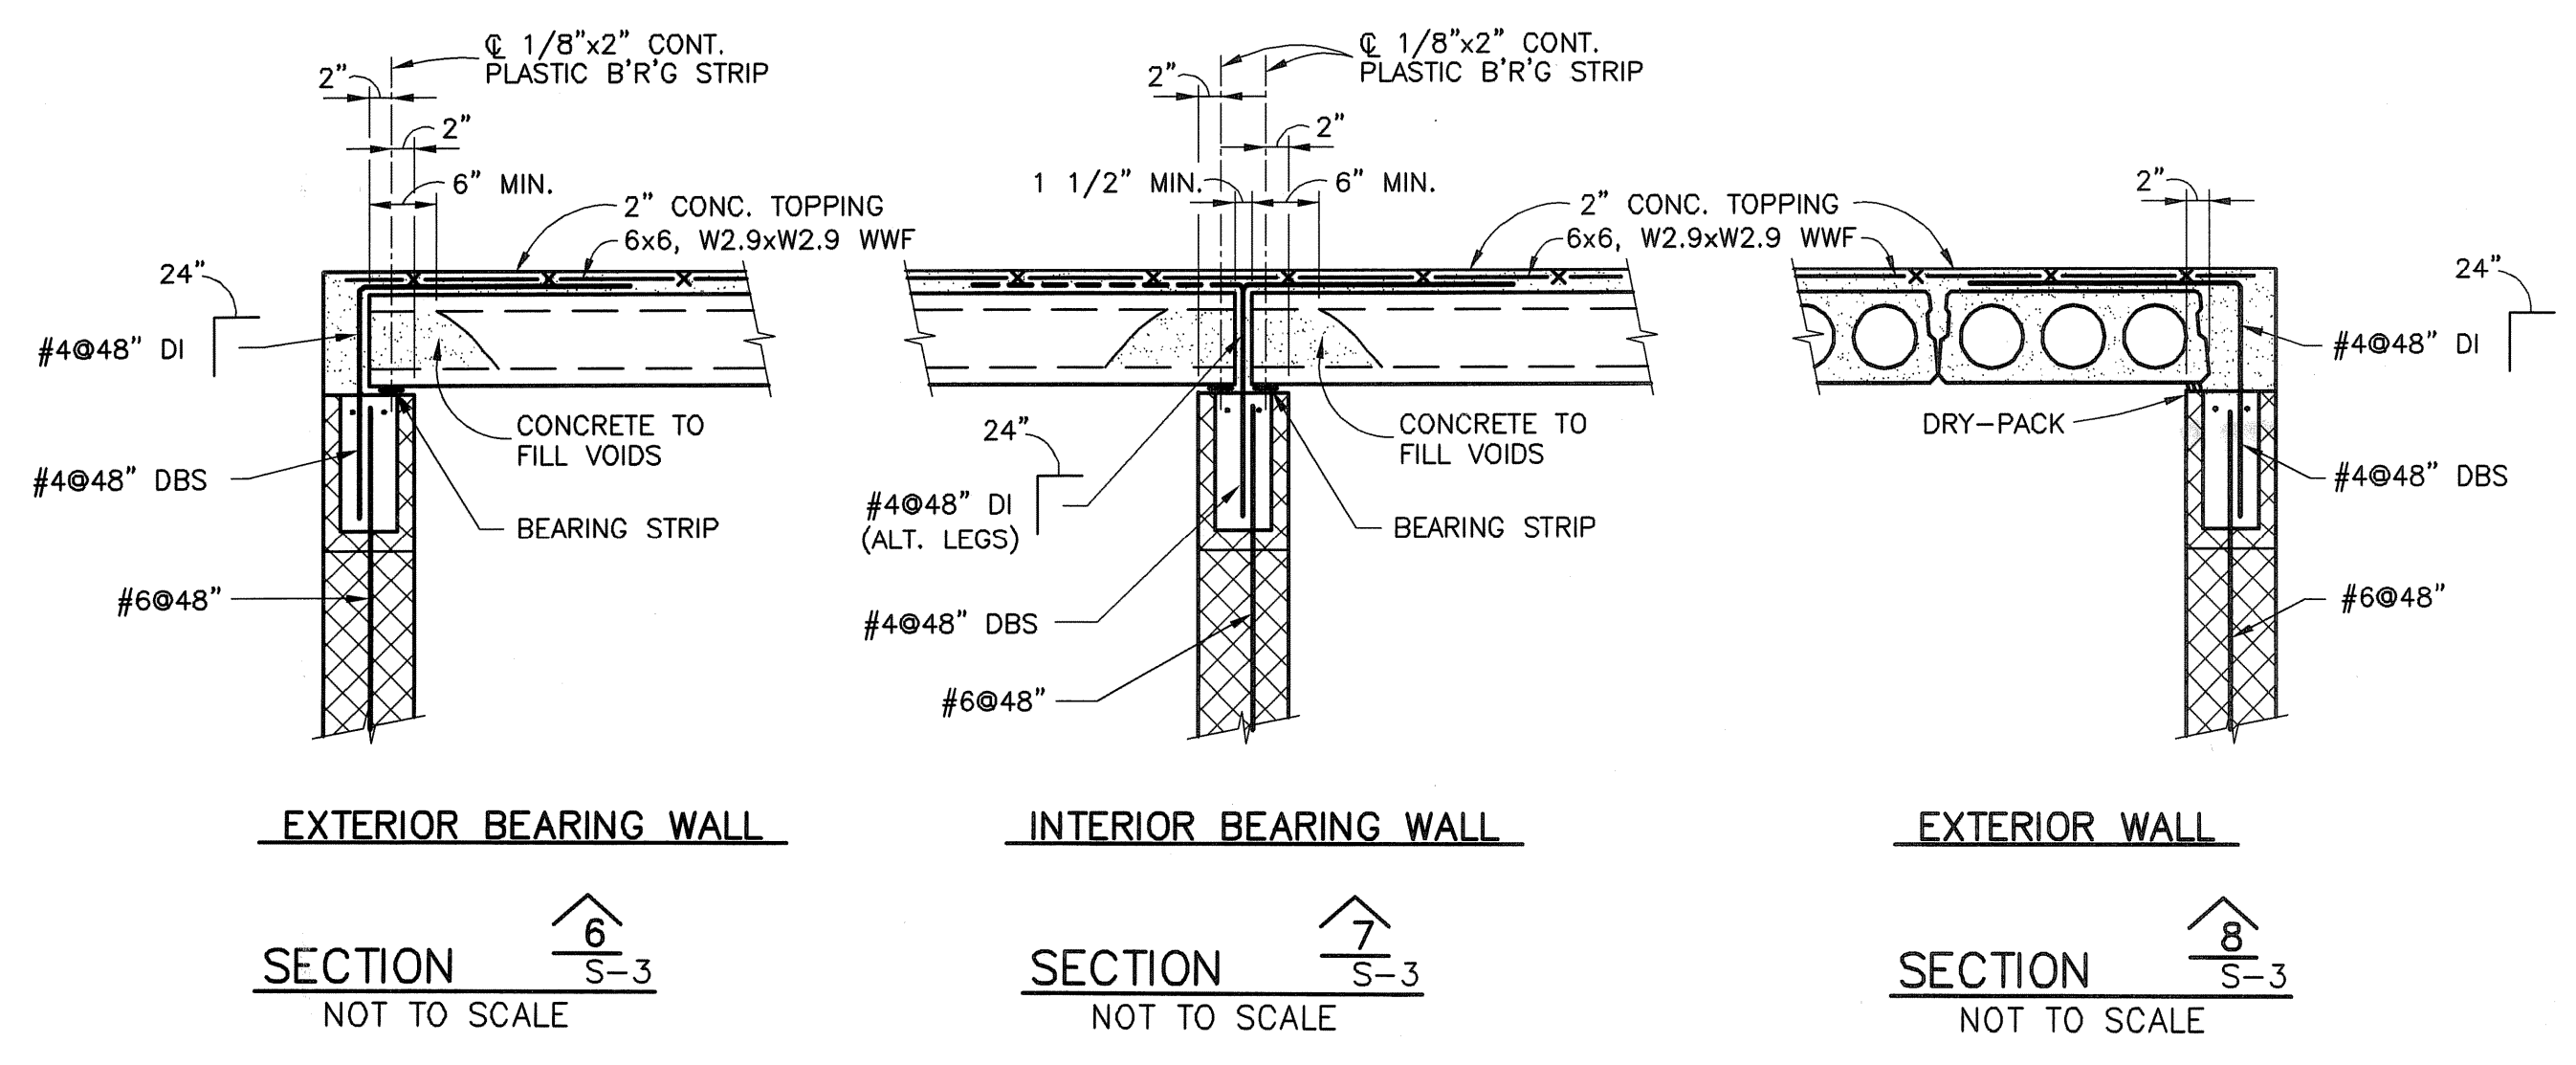

PAWTUCKET, RHODE ISLAND
**PAWTUCKET REGIONAL
 WATER TREATMENT FACILITY**
PKGS 11 & 12 - RAW WATER PUMP STATION
 STRUCTURAL ROOF PLAN

DESIGNED BY	DWG SCALE
DRAWN BY	AS NOTED
CHECKED BY	CONTRACT NO.
	DATE
	OCTOBER 31, 2008

EARTH TECH
 AS-BUILT FILE
 MAY 2008



FULL SIZE DRAWING = 4"		
NO.	BY	DATE
2	DPB	MAY 2008
1		10/31/08
0		10/28/05
B		8/16/05
A		7/22/05
REVISIONS		

CONCRETE PROTECTION FOR REINFORCEMENT(A)				
MEMBER	EXPOSED TO			
	AIR	WEATHER & AIR OVER LIQUID	EARTH & LIQUID	SALT WATER
FOOTING	—	—	2"(B)	4"
WALL COLUMN BEAM	1 1/2"	2"	2"(B)	3"(B)
SLAB	TOP	1 1/2"(C)	2"	3"
	BOTTOM	3/4"(D)	2"	3"(B)


- (A) APPLICABLE TO ALL CAST-IN-PLACE CONCRETE, EXCEPT AS OTHERWISE SHOWN ON THE DRAWINGS.
 (B) INCREASE 1" WHEN CAST AGAINST EARTH.
 (C) 3/4" WHEN MEMBRANE OR WEARING SURFACE USED.
 (D) 1 1/2" WHERE REQ'D TO CLEAR WATERSTOP.

MINIMUM RE-BAR SPLICE LENGTHS (in.)*		
fy=60,000 fc=4,500		
BAR SIZE	TOP BARS**	OTHER BARS
4	20	16
5	24	18
6	26	20
7	39	30
8	46	35
9	52	40
10	57	44
11	64	49


* THIS TABLE IS BASED ON NORMAL WEIGHT CONCRETE, UNCOATED BARS, CLEAR SPACING NOT LESS THAN FOUR BAR DIAMETERS, AND CLEAR COVER NOT LESS THAN TWO BAR DIAMETERS.
 ** WHERE SPACING BETWEEN BARS IS LESS THAN FOUR BAR DIAMETERS, OR CLEAR COVER IS LESS THAN TWO BAR DIAMETERS, INCREASE SPLICE LENGTHS SHOWN BY 67%.
 *** HORIZONTAL BARS WITH MORE THAN 12" OF CONCRETE CAST BELOW THE BARS AS DEFINED BY A.C.I. 318-95.

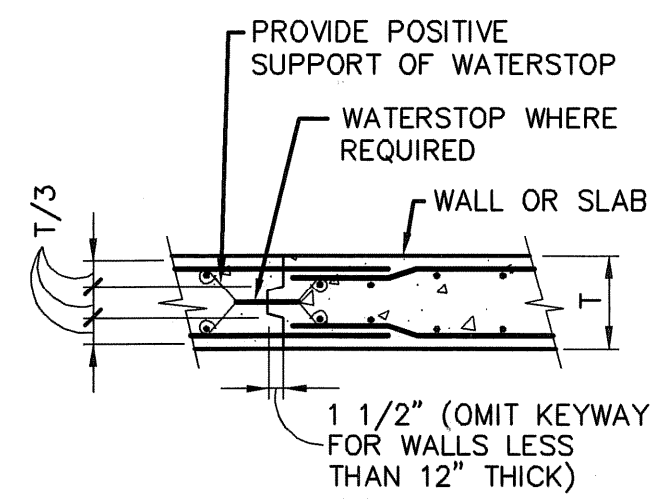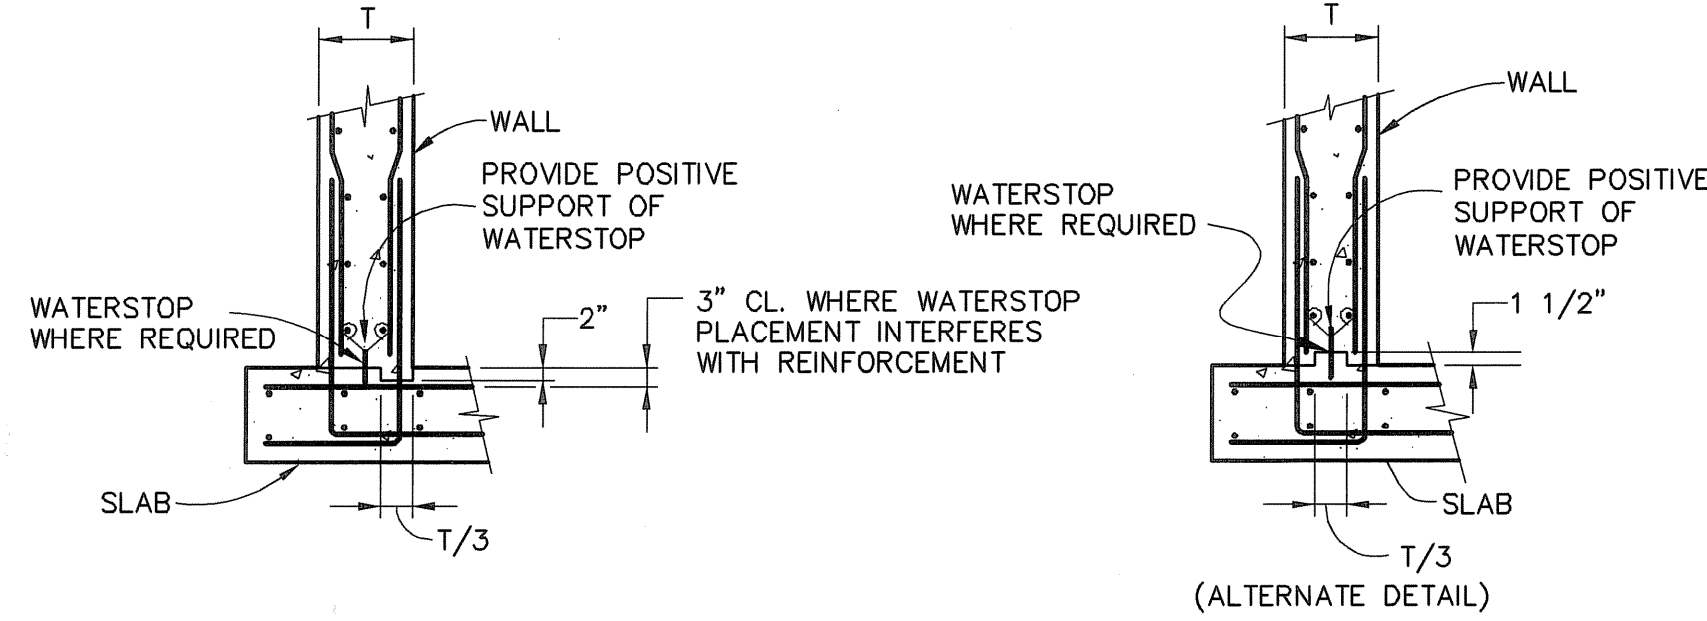


TYPICAL KEYWAY DETAIL
(UNLESS OTHERWISE NOTED)

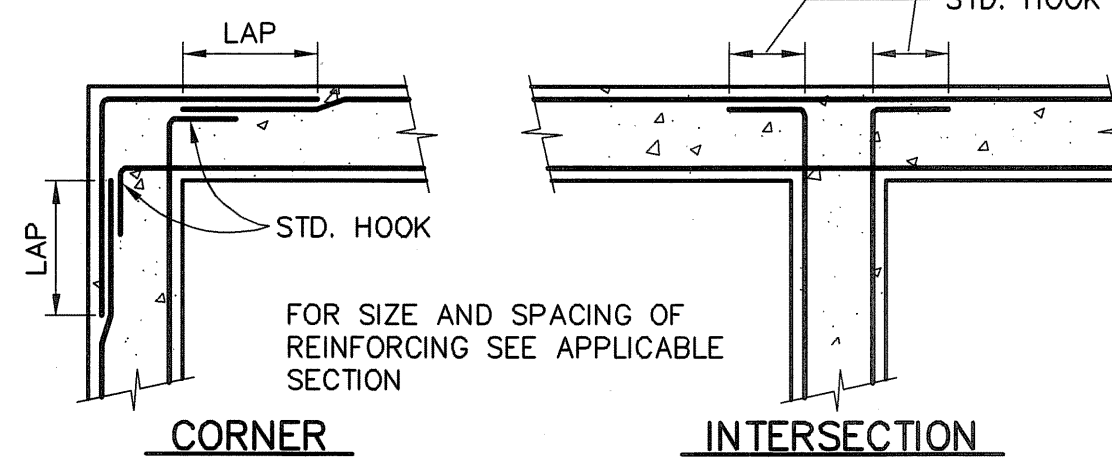


CORNER INTERSECTION
 WALL REINFORCING DETAILS
 (UNLESS OTHERWISE NOTED)
 NOTE: VERTICAL REINFORCING NOT SHOWN.

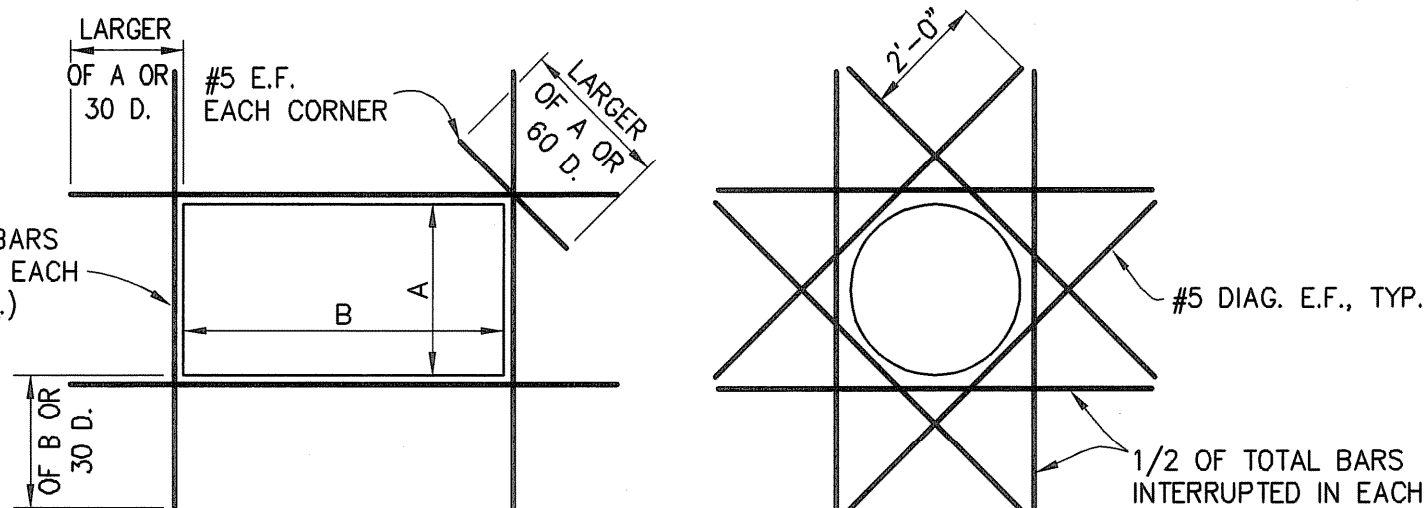




ADDITIONAL REINFORCING AROUND OPENINGS GREATER THAN 1'-0"
(UNLESS OTHERWISE NOTED)

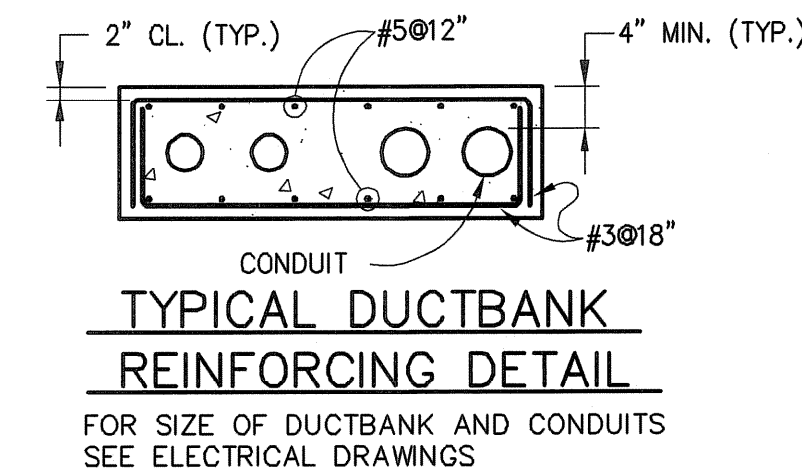

TYPICAL DUCTBANK REINFORCING DETAIL
 FOR SIZE OF DUCTBANK AND CONDUITS SEE ELECTRICAL DRAWINGS

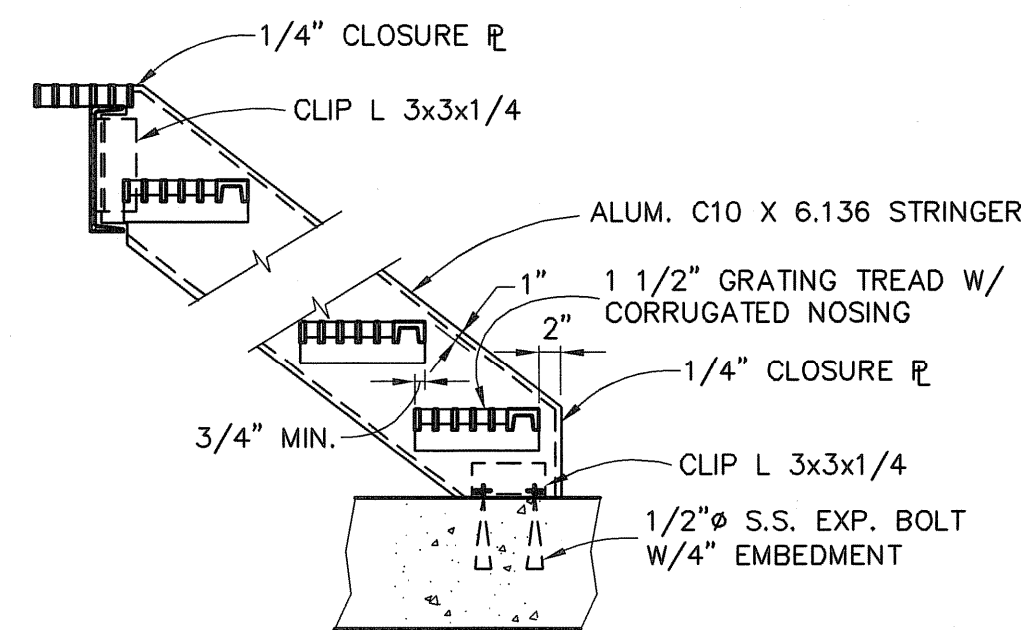


TYPICAL GRATING STAIR DETAIL
 NOT TO SCALE
 NOTE: ALL ALUMINUM CONSTRUCTION

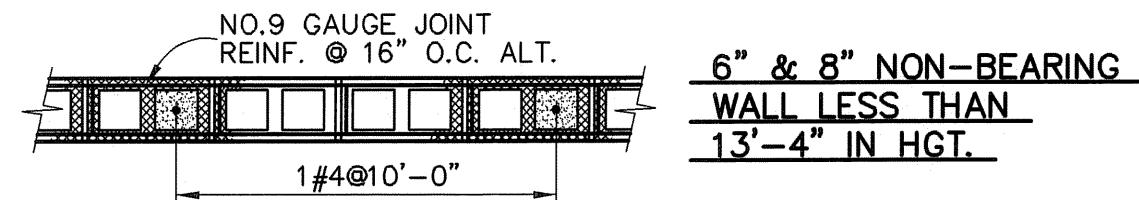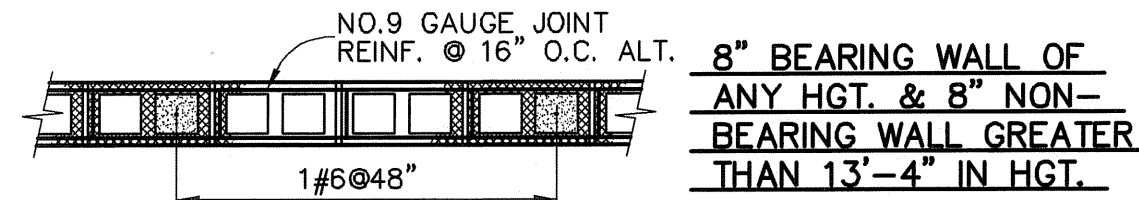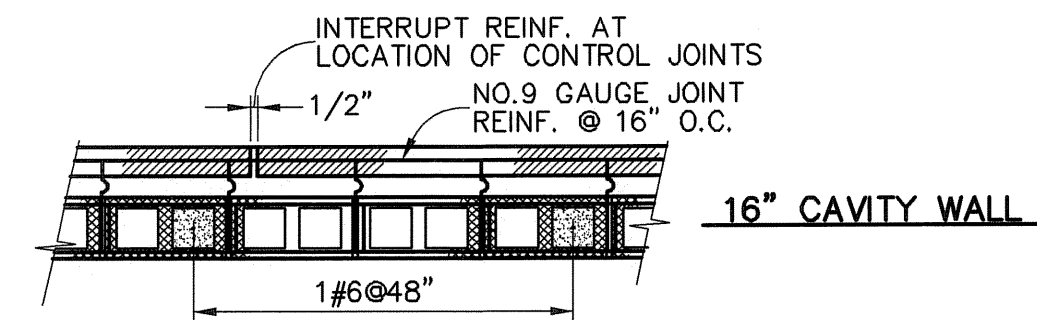


TYPICAL MASONRY REINFORCING DETAILS
 NOT TO SCALE


- NOTES:
- VERTICAL REINFORCING SHALL BE LAID OUT SUCH THAT EACH SIDE OF OPENINGS, CORNERS, INTERSECTIONS AND ENDS OF WALLS ARE REINFORCED.
 - VERTICAL REINFORCING AT SIDE OF OPENINGS SHALL BE CONTINUOUS THROUGH LINTELS.
 - PROVIDE 2-#5 HORZ. BARS AT TOP AND BOTTOM OF OP'NGS (EXTEND 25" PAST FACE OF OP'NG), AND AT KNOCK-OUT BLOCK BOND BEAM AT TOP OF WALL.

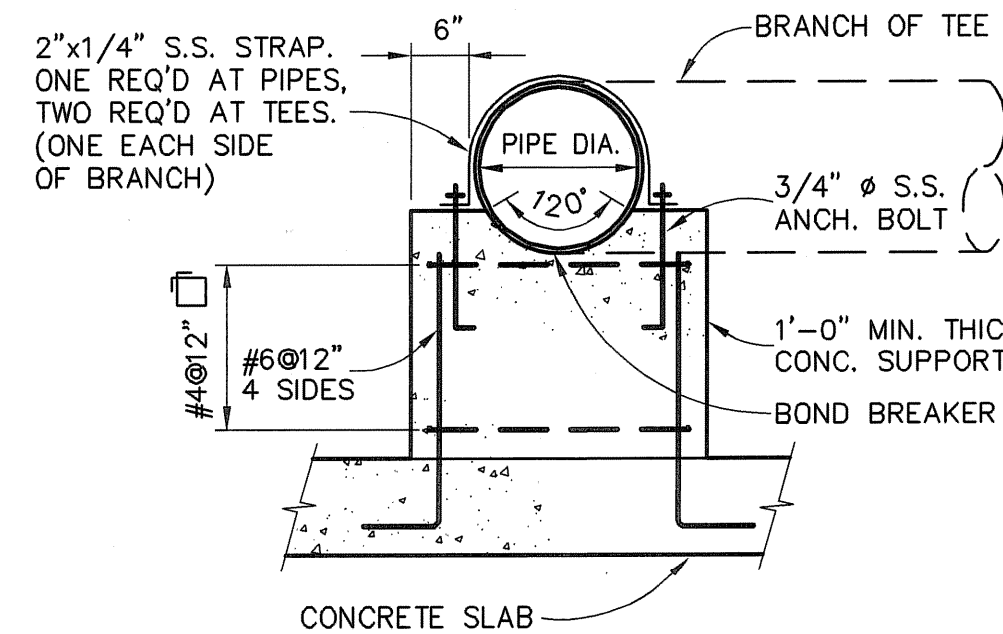


AT STRAIGHT PIPE OR TEE
 TYPICAL PIPE SUPPORT DETAIL
 NOT TO SCALE

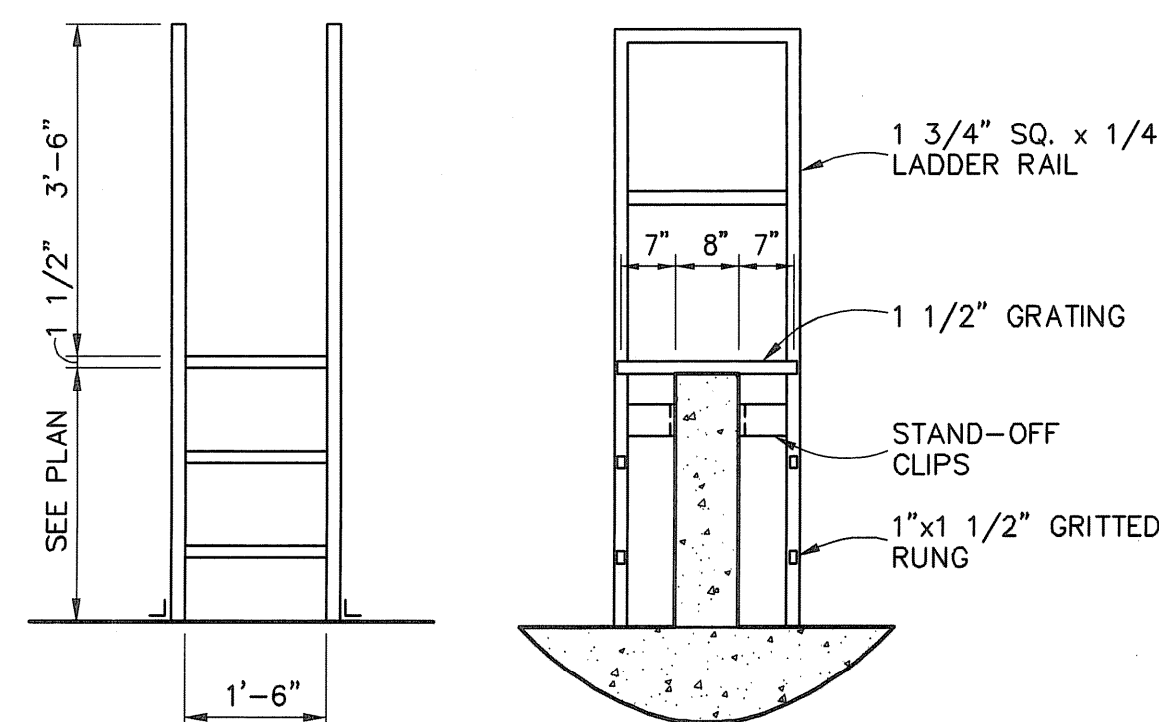

ELEVATION SECTION
 EXTENDED WALKTHRU FRP LADDER
 SCALE: 1/2"=1'-0"

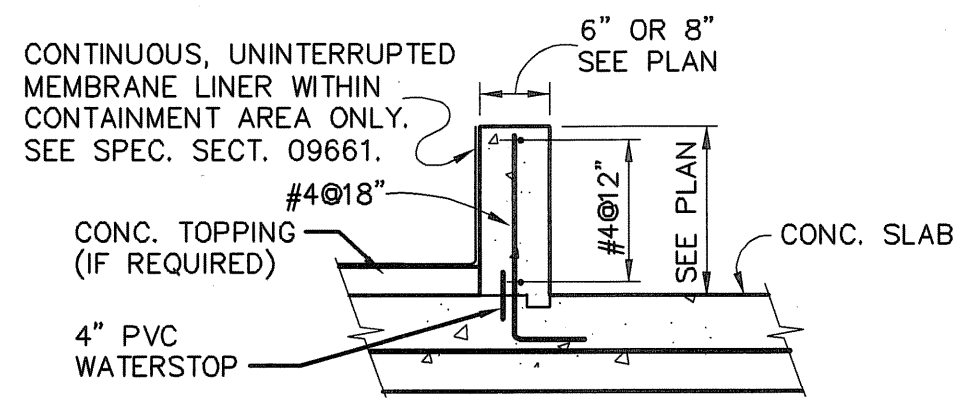

TYPICAL CONTAINMENT WALL DETAIL
 NOT TO SCALE

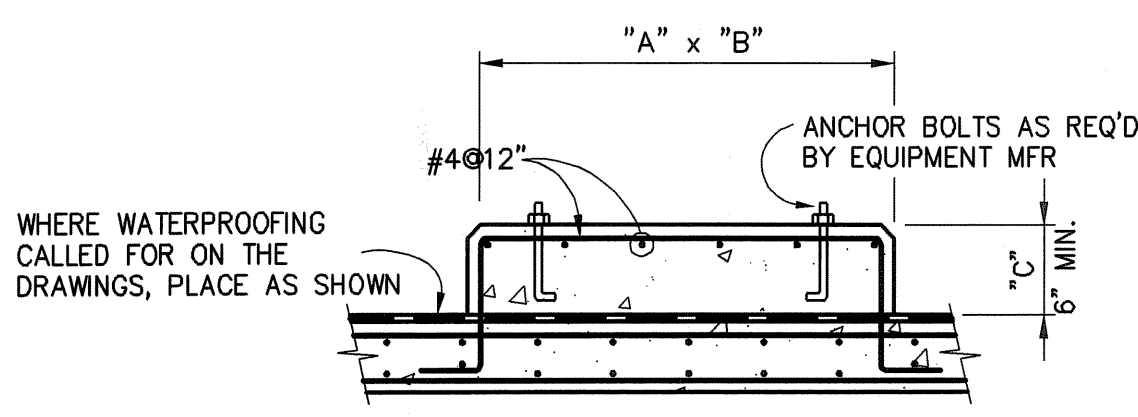

EQUIPMENT PAD DETAIL
 NOT TO SCALE

NOTE: CHEMICAL PUMP SUPPORTS TO BE FABRICATED FROM FRP MATERIALS.

STRUCTURAL NOTES

- GENERAL
- THESE NOTES AND TYPICAL DETAILS SHALL APPLY TO ALL STRUCTURES IN THE PROJECT, AS APPLICABLE.
 - STRUCTURAL DRAWINGS SHALL BE USED IN CONJUNCTION WITH ARCHITECTURAL, MECHANICAL, ELECTRICAL, PLUMBING, HEATING AND VENTILATING DRAWINGS AND SPECIFICATIONS. DRAWINGS SHALL BE REFERRED TO FOR SIZE AND LOCATION OF OPENINGS FOR VENTS, PIPES, DUCTS, ETC.
 - ALL DIMENSIONS AND CONDITIONS MUST BE VERIFIED IN THE FIELD AND ANY DISCREPANCIES SHALL BE BROUGHT TO THE ATTENTION OF THE ENGINEER BEFORE PROCEEDING WITH THE AFFECTED PORTION OF WORK.
 - BUILDING CODE: RHODE ISLAND STATE BUILDING CODE (1998) AND AMENDMENTS.
 - DESIGN LIVE LOADS: ROOF -30 PSF FLOORS -AS INDICATED ON PLANS
- EARTHQUAKE
- | | |
|--------------------------------------|----------------------------------|
| SEISMIC HAZARD GROUP | II |
| SEISMIC PERFORMANCE | C |
| CATEGORY | |
| SOIL PROFILE TYPE | S1 |
| BASIC STRUCTURAL SYSTEM | LOAD BEARING MASONRY SHEAR WALLS |
| RESPONSE MODIFICATION FACTOR (R) | 3 1/2 |
| DEFLECTION AMPLIFICATION FACTOR (Cd) | 3 |
| ANALYSIS PROCEDURE | EQUIVALENT LATERAL FORCE |


FOUNDATIONS

- NO BACKFILL SHALL BE PLACED AGAINST FOUNDATION WALLS WHICH HAVE NOT BEEN CURED FOR AT LEAST 7 DAYS.
- BACKFILL SHALL NOT BE PLACED AGAINST FOUNDATION WALLS UNTIL SUPPORTING FRAMED SLABS HAVE BEEN PLACED AND THE FORMS REMOVED. BACKFILL SHALL BE PLACED AND COMPACTED ON ALL SIDES OF STRUCTURE SIMULTANEOUSLY.
- NO FOOTINGS SHALL BE PLACED ON LOOSE OR DISTURBED SOILS, IN WATER NOR ON FROZEN GROUND.
- FOUNDATION MAT SHALL BE PLACED ON UNDISTURBED MATERIAL. A MINIMUM OF 12 INCHES OF COMPACTED GRAVEL SHALL BE PLACED BENEATH ALL OTHER FOUNDATION MATS, FOOTINGS, AND SLAB-ON-GRADE, UNLESS OTHERWISE NOTED.
- COMPACT ALL FILL UNDER THE SLAB-ON-GRADE AND ANY OTHER AREAS NOTED TO AT LEAST 95% OF MAXIMUM DENSITY AS SPECIFIED. VERIFY FIELD DENSITY AS SPECIFIED.
- STRUCTURES MUST BE PROTECTED AGAINST BUOYANCY AT ALL TIMES DURING CONSTRUCTION.

CONCRETE

- ALL CONCRETE SHALL HAVE A MINIMUM 28-DAY COMPRESSIVE STRENGTH OF 4500 PSI, UNLESS OTHERWISE NOTED.
- REINFORCING STEEL SHALL COMPLY WITH THE FOLLOWING:
 - ASTM DESIGNATION A615 GRADE 60.
 - REINFORCEMENT SHALL COMPLY WITH THE TABLE, "CONCRETE PROTECTION FOR REINFORCEMENT", UNLESS OTHERWISE NOTED.
 - FOR MINIMUM BAR SPLICE LENGTHS SEE TABLE SHOWN ON THIS DRAWING.
- WELDED WIRE FABRIC SHALL CONFORM TO ASTM A-185.
- CONTRACTOR SHALL COORDINATE LOCATIONS OF FLOOR DRAINS, PIPING, ELECTRICAL CONDUITS, GROUNDS, SLEEVES, INSERTS, ETC. WITH CONCRETE CONSTRUCTION.
- CONSTRUCTION JOINTS IN WALLS AND SLABS SHALL BE KEYS. USE OF CONSTRUCTION JOINTS OTHER THAN THOSE SHOWN ON THE DRAWINGS WILL REQUIRE APPROVAL OF THE ENGINEERS.
- WATERSTOPS ARE NOT NECESSARILY SHOWN AT EVERY JOINT; BUT WHERE THEY ARE SHOWN, IT IS INTENDED THAT THEY BE COMPLETE AND CONTINUOUS THROUGHOUT THAT PARTICULAR STRUCTURE. WATERSTOPS IN VERTICAL JOINTS SHALL EXTEND TO THE ELEVATION OF FINISH GROUND GRADE, EXCEPT FOR TANKS THEY SHALL EXTEND FULL HEIGHT.
- PROVIDE WALL SLEEVES WITH INTERMEDIATE WALL COLLARS AT ALL CAST/DUCTILE IRON AND PLASTIC PIPE PENETRATIONS, UNLESS OTHERWISE INDICATED.
- PROVIDE ALL NECESSARY CHAIRS, CHAIR BARS, SPACERS ETC. WIRED SECURELY TO HOLD REINFORCING IN POSITION. THESE ACCESSORIES SHALL BE PLASTIC BOOTED WHERE CONCRETE IS TO BE EXPOSED TO WEATHER OR MOISTURE.
- BEAMS AND COLUMNS SHALL NOT BE PENETRATED UNLESS SPECIFICALLY SHOWN ON STRUCTURAL DRAWINGS OR APPROVED BY THE ENGINEER.
- ALL EXPOSED CORNERS OF CONCRETE BEAMS AND WALLS SHALL HAVE A 3/4" CHAMFER UNLESS OTHERWISE NOTED.

2	AS-BUILT DRAWING FILE	10/27/08	DATE
1	ISSUED FOR RFI POSTED SET	10/29/08	DATE
0	ISSUED FOR CONSTRUCTION	8/16/05	DATE
B	REV. B AGENCY REVIEW	7/22/05	DATE
A	REV. A CLIENT REVIEW		DATE

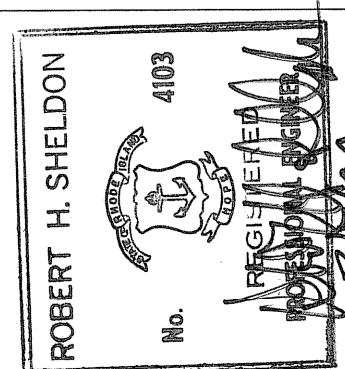





PAWTUCKET, RHODE ISLAND
 PAWTUCKET REGIONAL
 WATER TREATMENT FACILITY
 PKGS 11 & 12 - RAW WATER PUMP STATION
 STRUCTURAL DETAILS AND NOTES

DESIGNED BY	DWG SCALE AS NOTED
DRAWN BY	CONTRACT NO
DPB	
CHECKED BY	DATE
	OCTOBER 31, 2008


EARTH TECH
 AS-BUILT FILE
 MAY 2008

Filename: L:\WORK\69993\CAD\AS-BUILT\11-12 RWTP\STRUC\69993-11_S-4.DWG
 Plot File Date Created: Sep/22/2008 11:34 AM

Filename: L:\WORK\68993\CAD\AS-BUILT\11-12\RWTP\MECH\68993M16-17.DWG
 Plot File Date Created: Sep/22/2008 11:34 AM

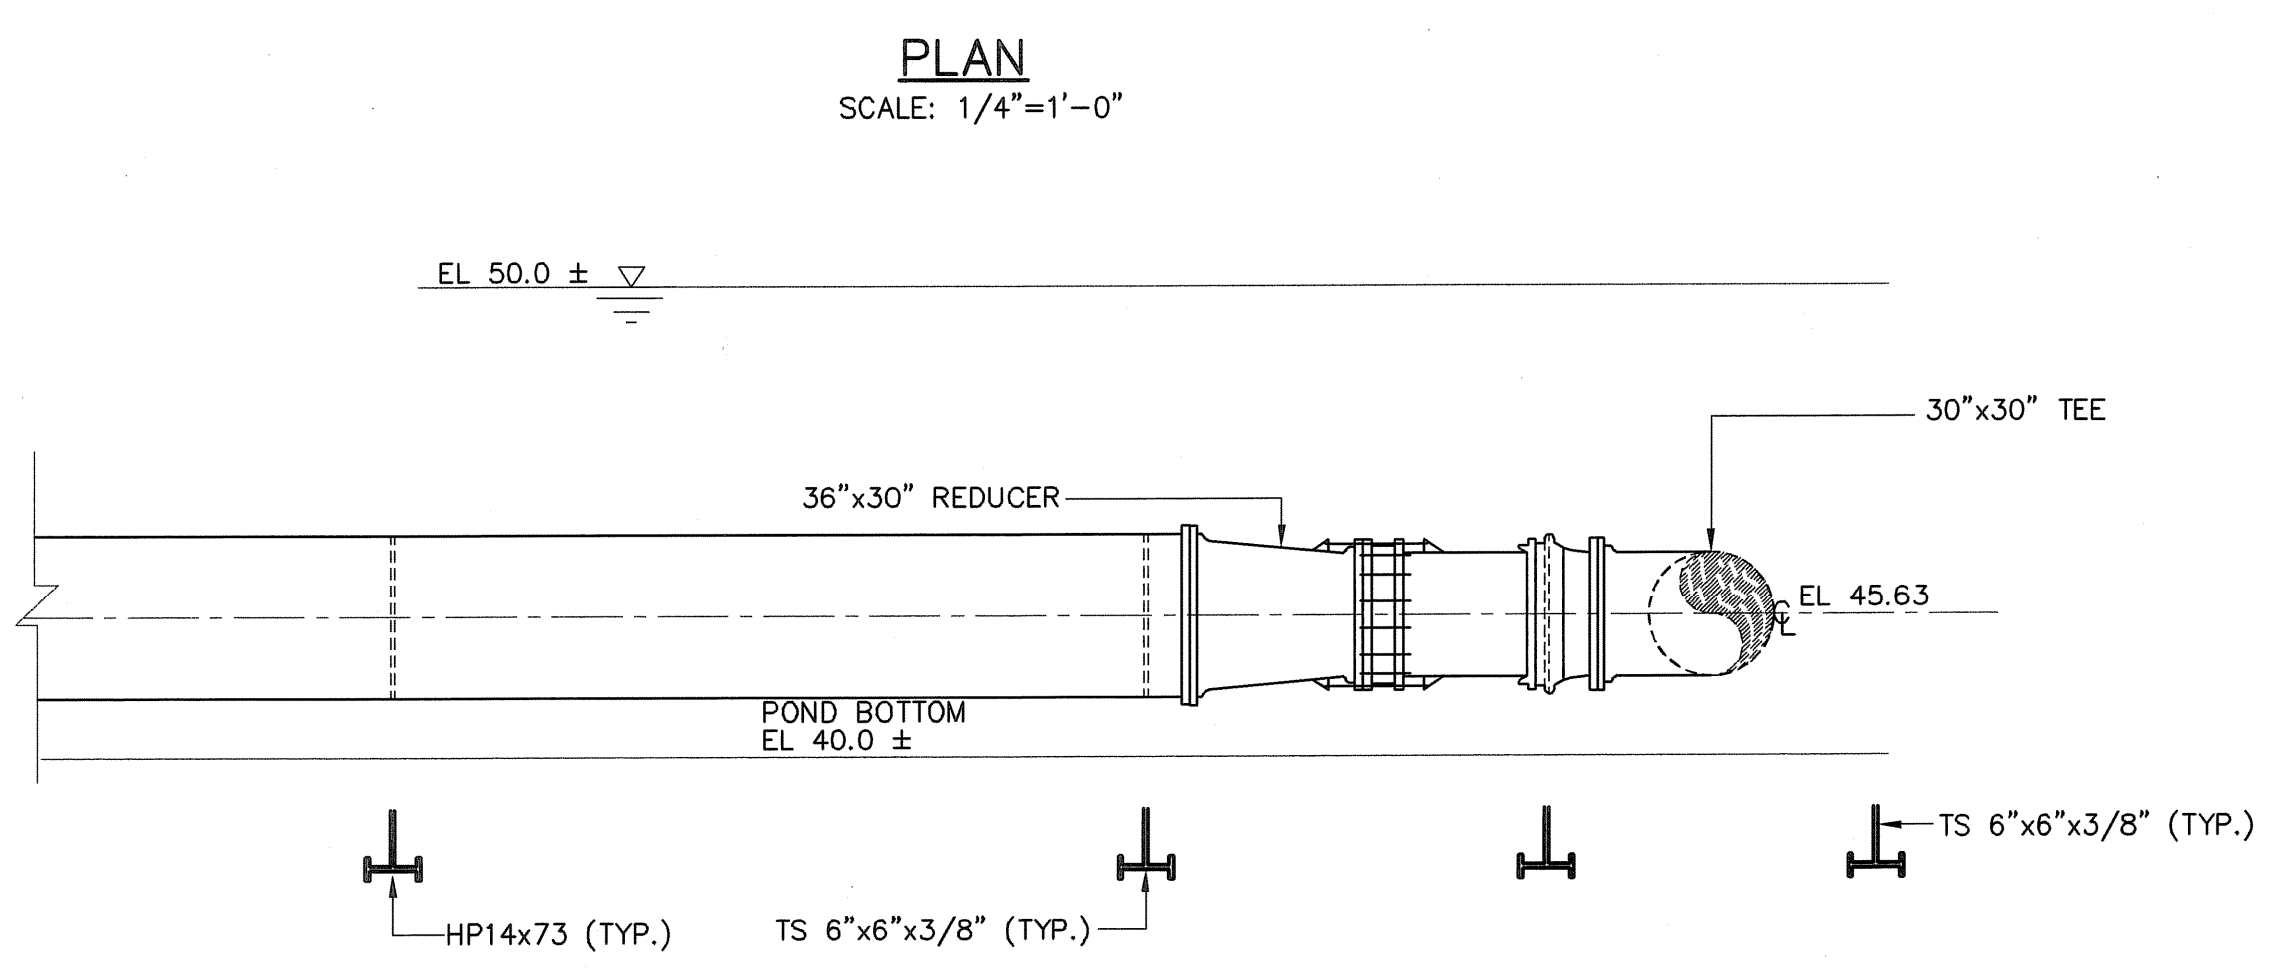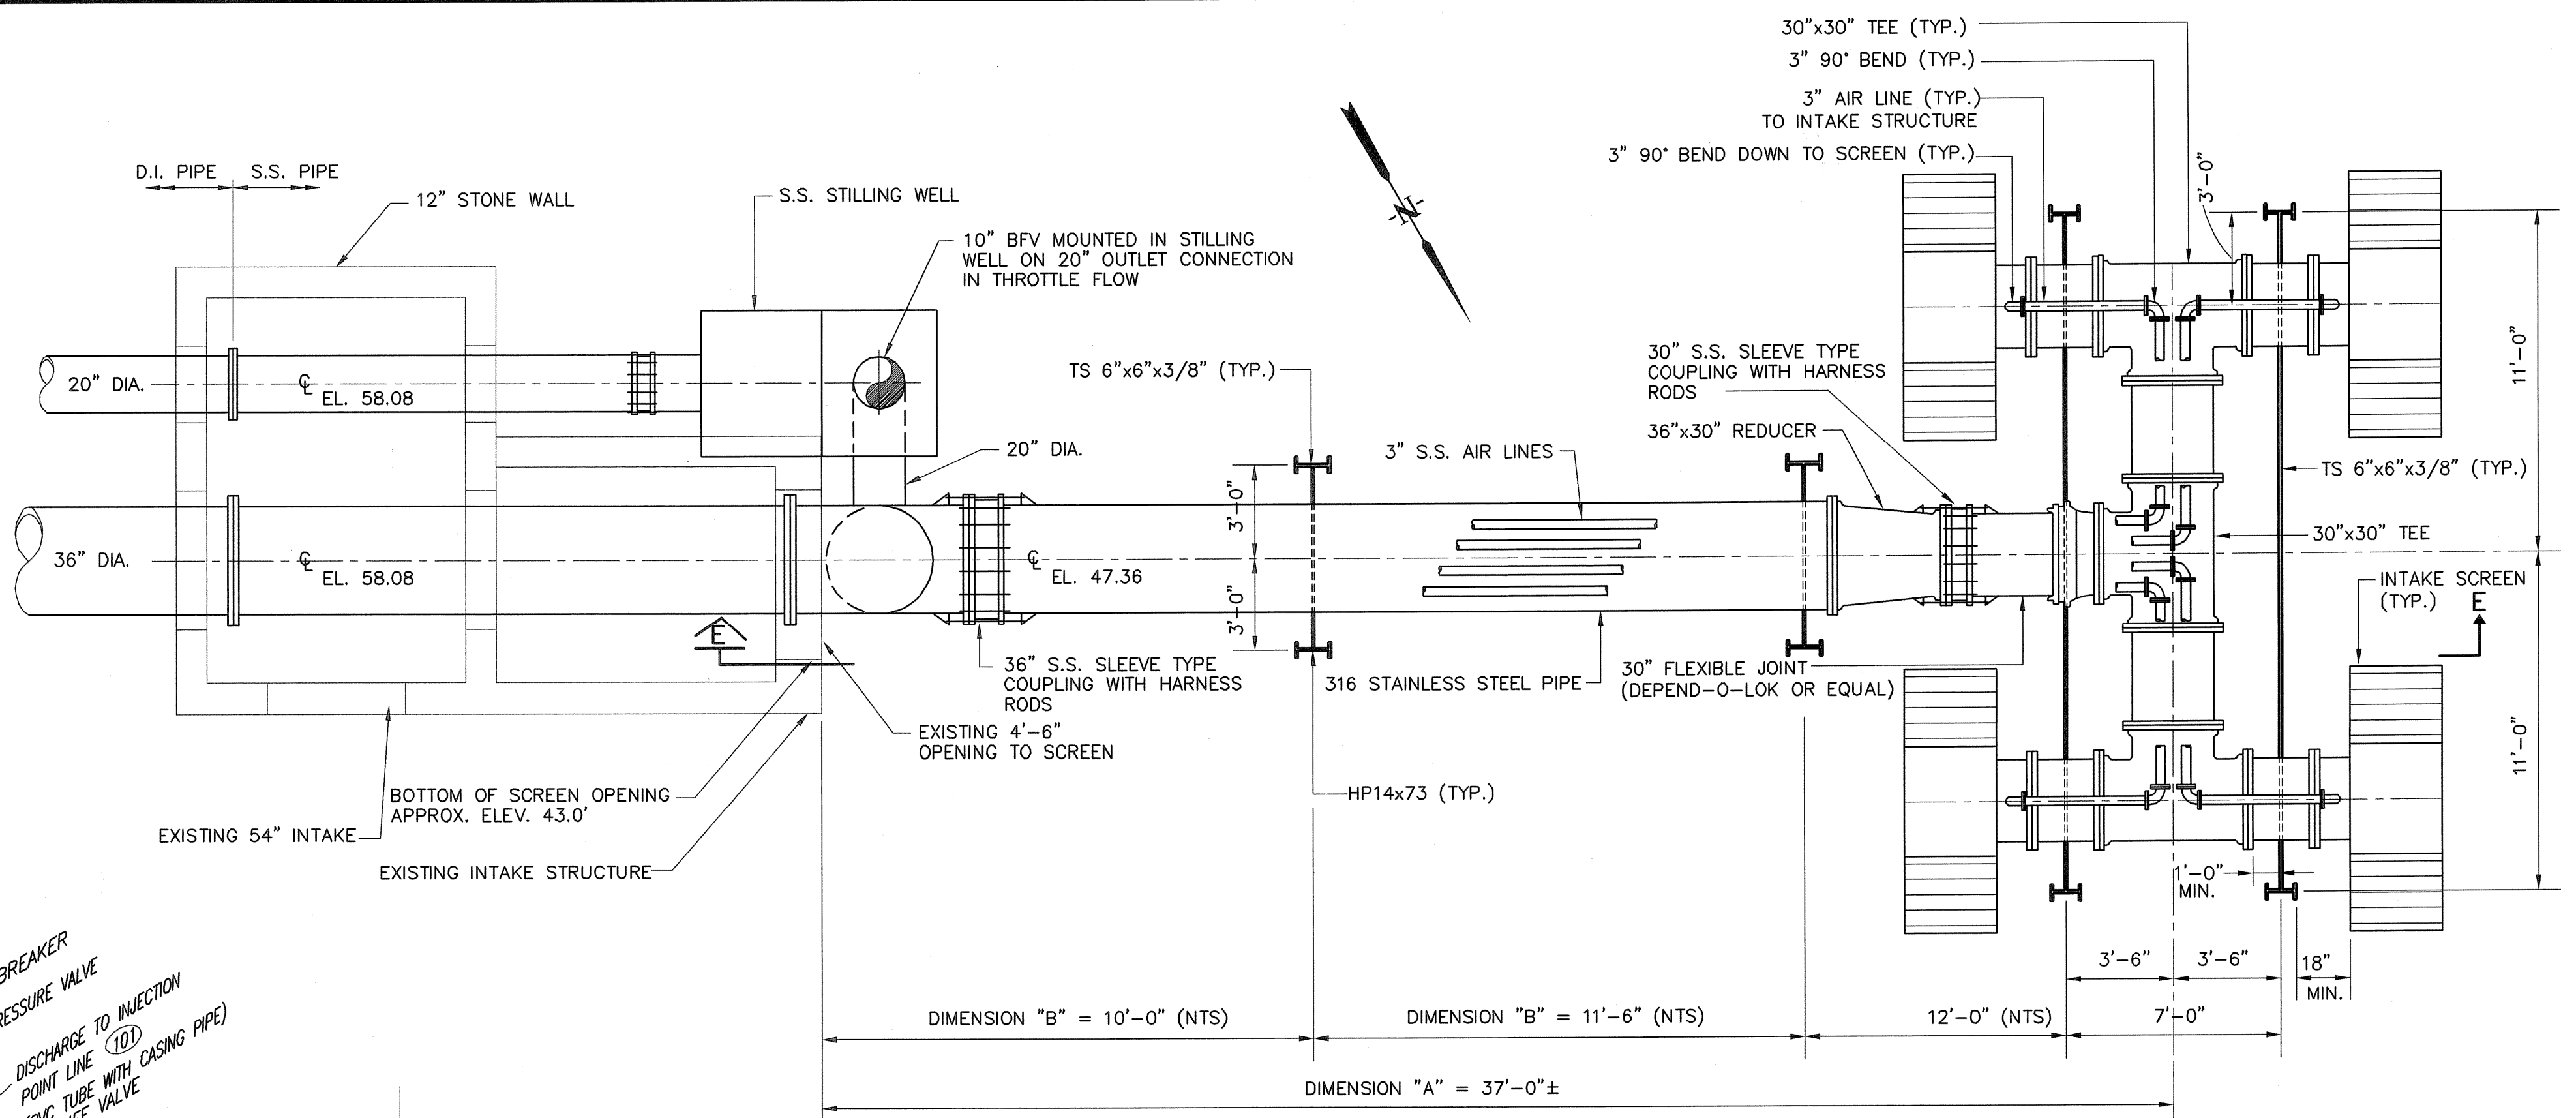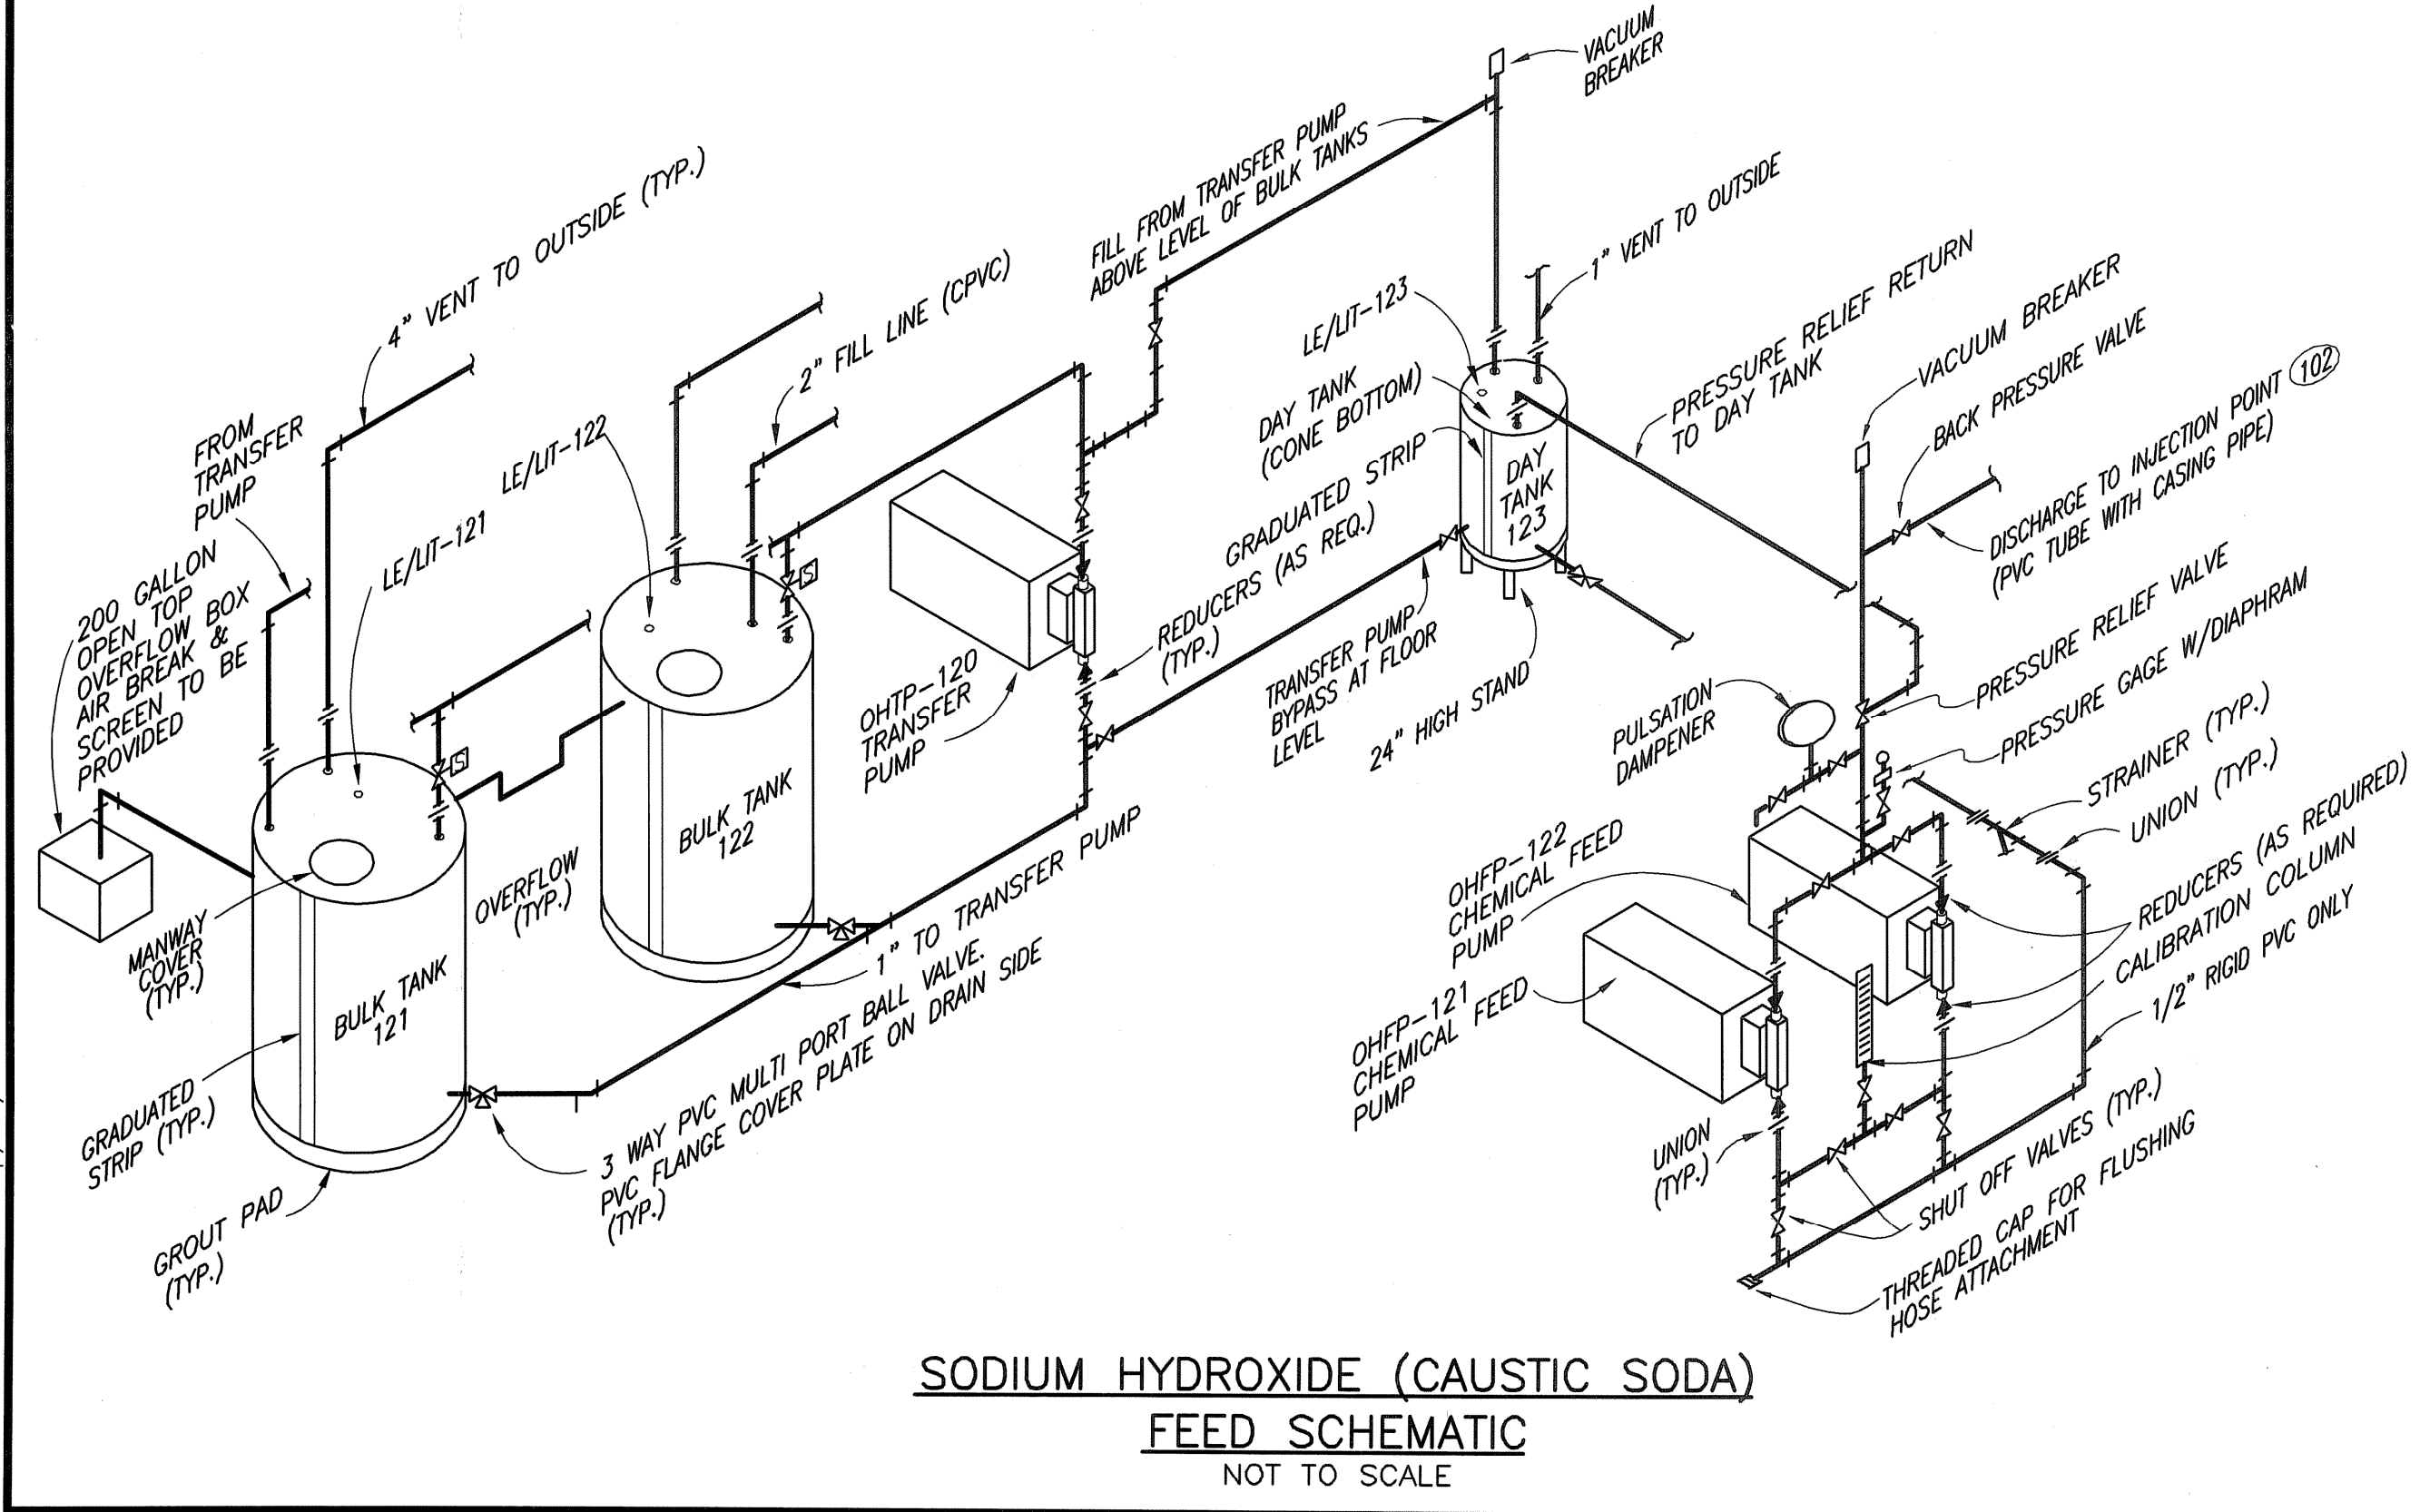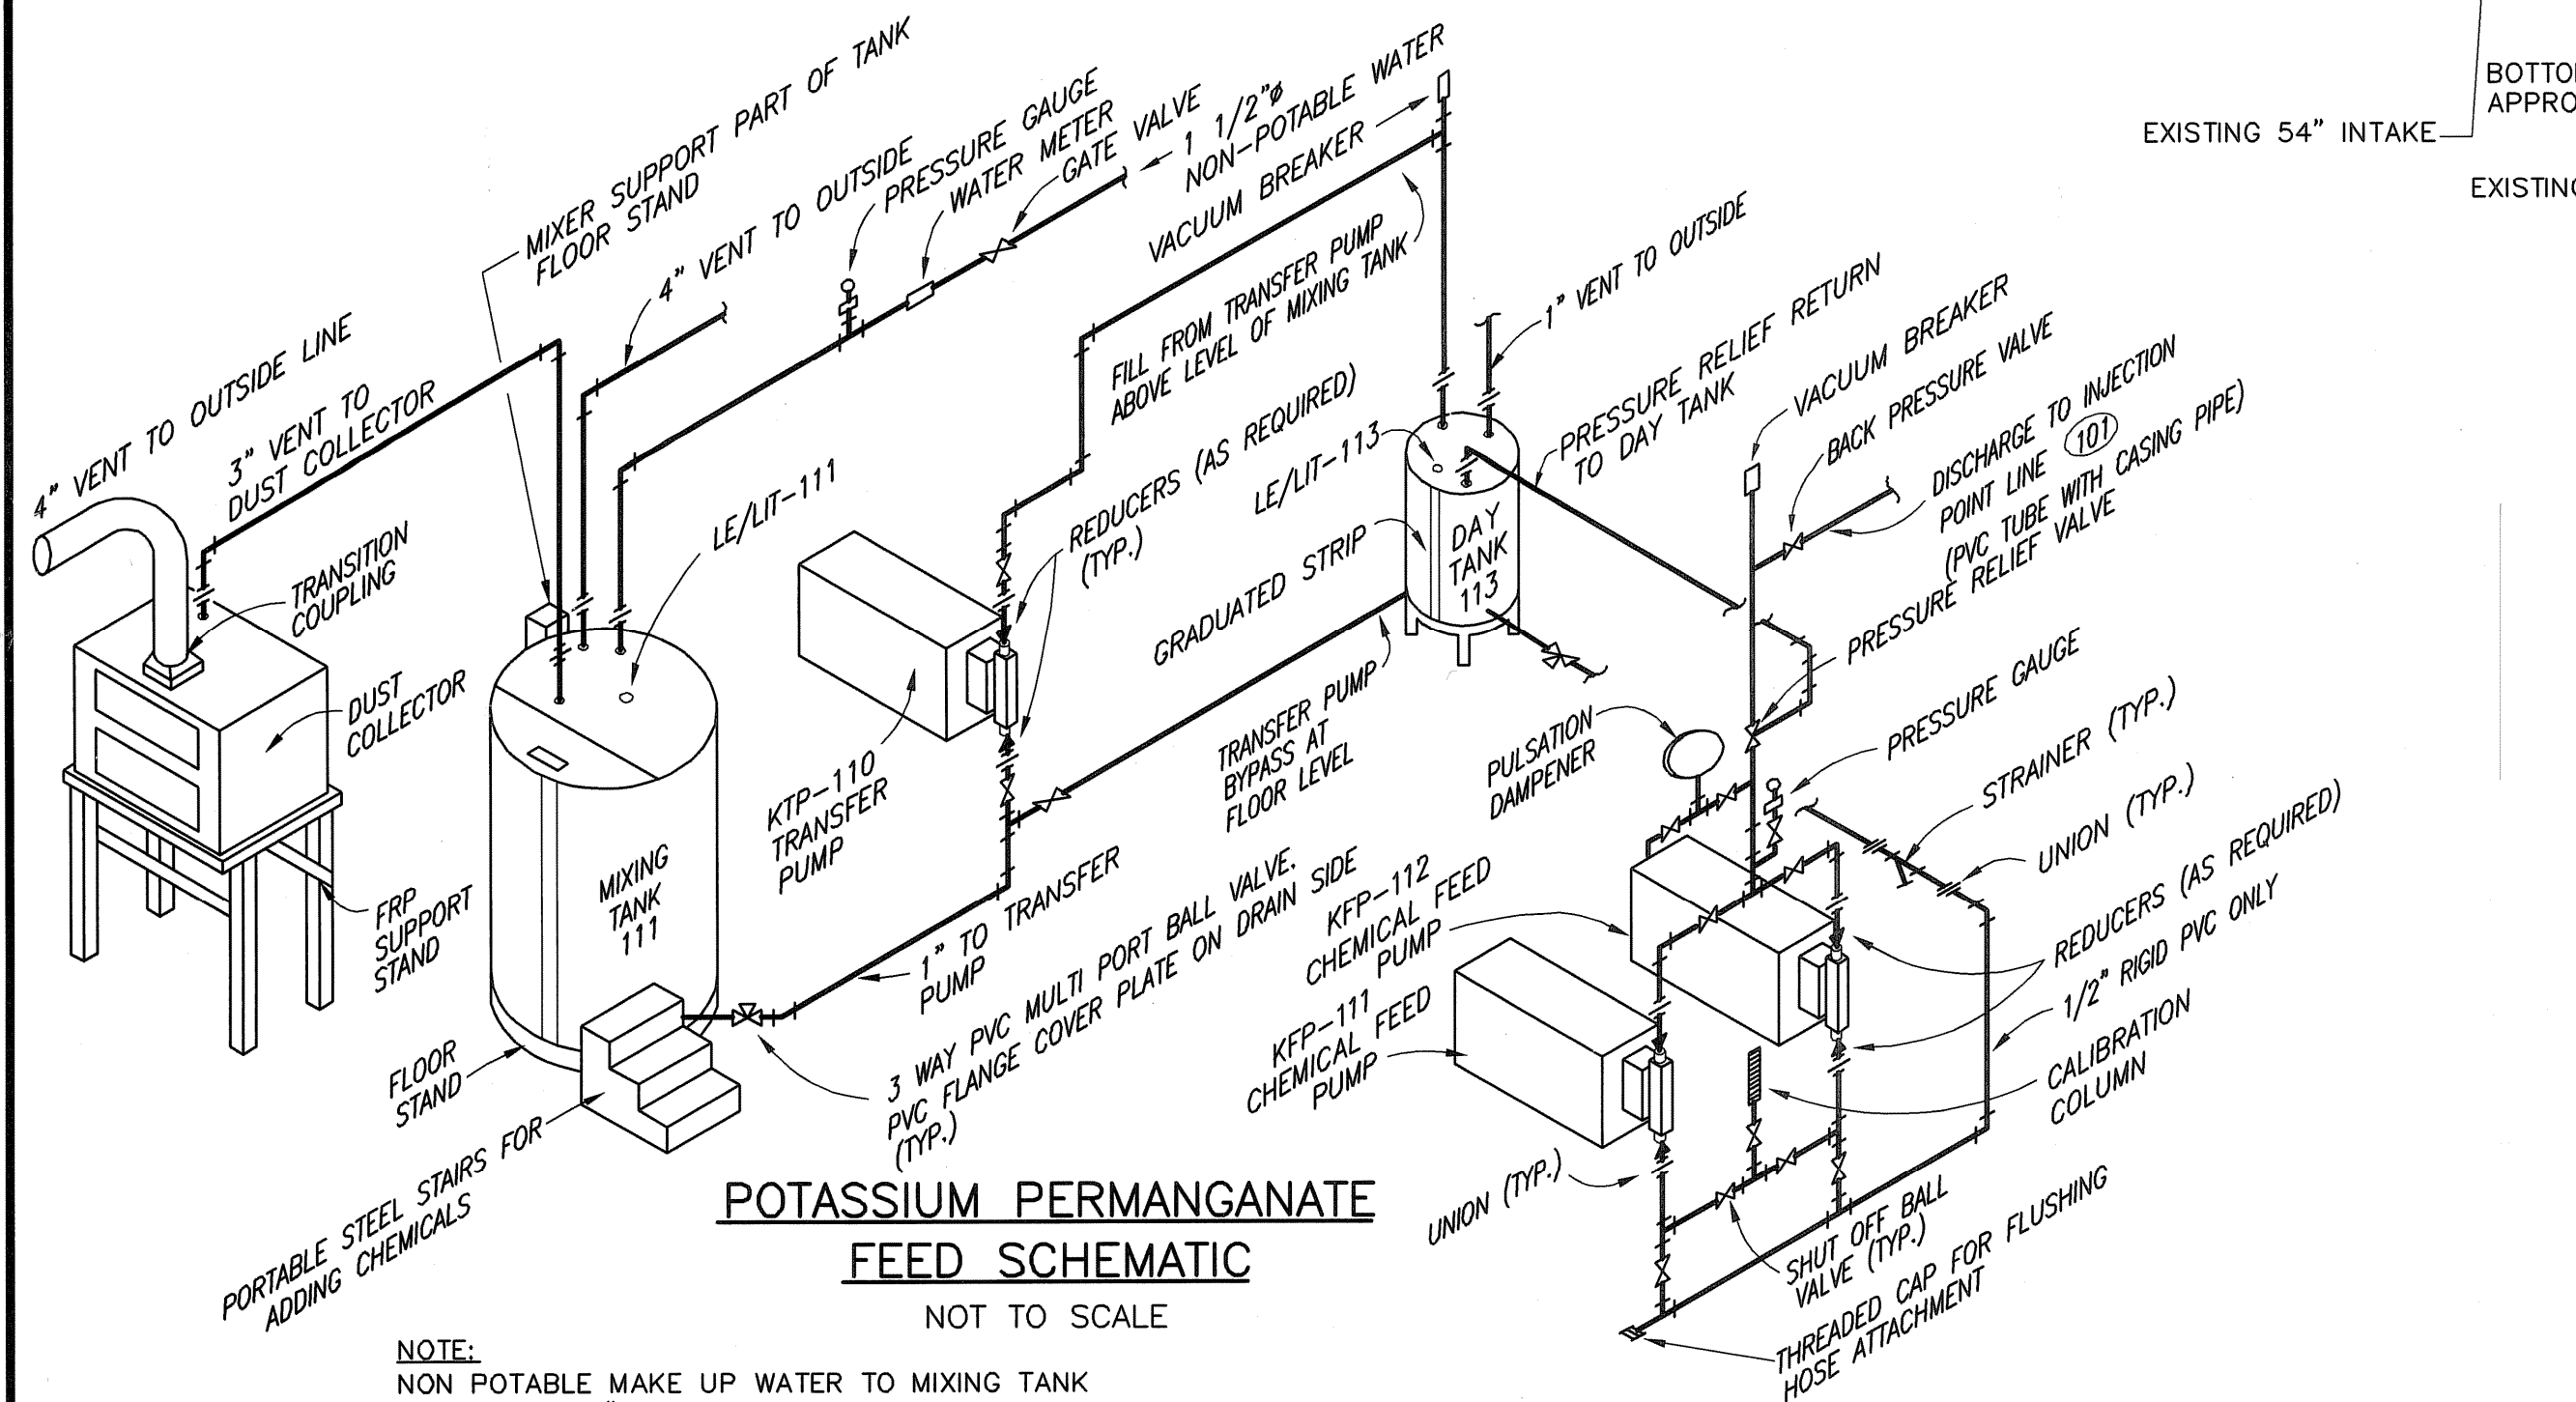

NOTE:
 DUE TO SLOPE IN RESERVOIR BOTTOM CONTRACTOR IS REQUIRED TO PLACE OFFSET EXPANSION JOINTS, WEDGES, OR BENDS TO MEET CONNECTION AT PROPOSED INTAKE STRUCTURE.

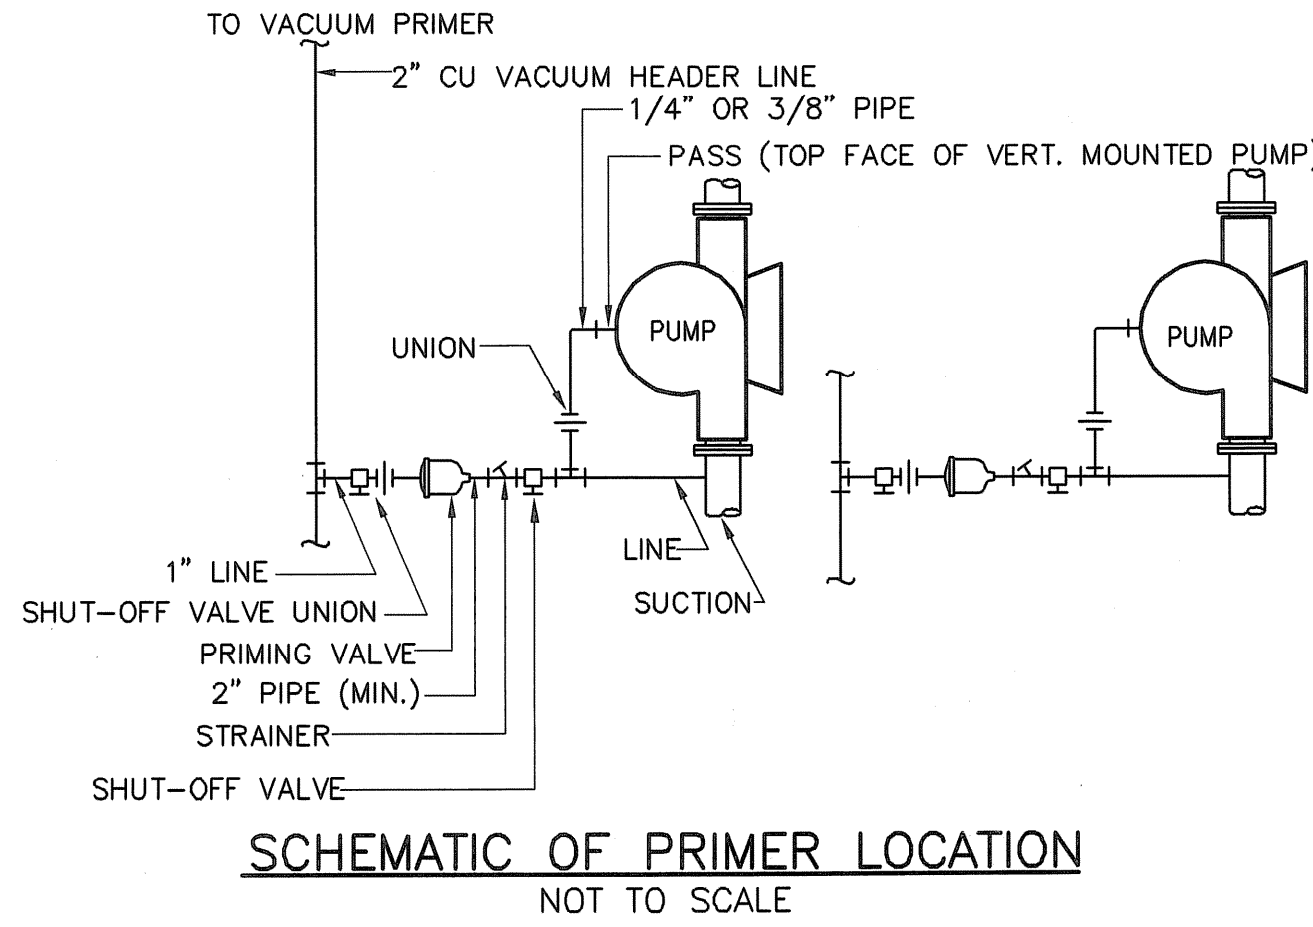

FULL SIZE DRAWING = 4"

NO.	DATE	BY	REVISIONS
2	MAY 2008		AS-BUILT DRAWING FILE
1	10/31/06		ISSUED FOR RFI POSTED SET
0	10/28/05		ISSUED FOR CONSTRUCTION
B	8/16/05		REV. B AGENCY REVIEW
A	7/22/05		REV. A CLIENT REVIEW

ROBERT H. SHELDON
 No. 4103
 Professional Engineer
 State of Rhode Island
 License No. 00000000

PAWTUCKET, RHODE ISLAND
PAWTUCKET REGIONAL WATER TREATMENT FACILITY
PKGS 11 & 12 - RAW WATER PUMP STATION
 CHEMICAL SCHEMATICS,
 INTAKE STRUCTURE PLAN AND SECTION


DESIGNED BY	DWG SCALE
DRAWN BY	AS NOTED
CHECKED BY	CONTRACT NO.
	DATE
	OCTOBER 31, 2008

EARTH TECH
 AS-BUILT FILE
 MAY 2008


M-17
 SHEET OF

LEGEND


DUCTWORK

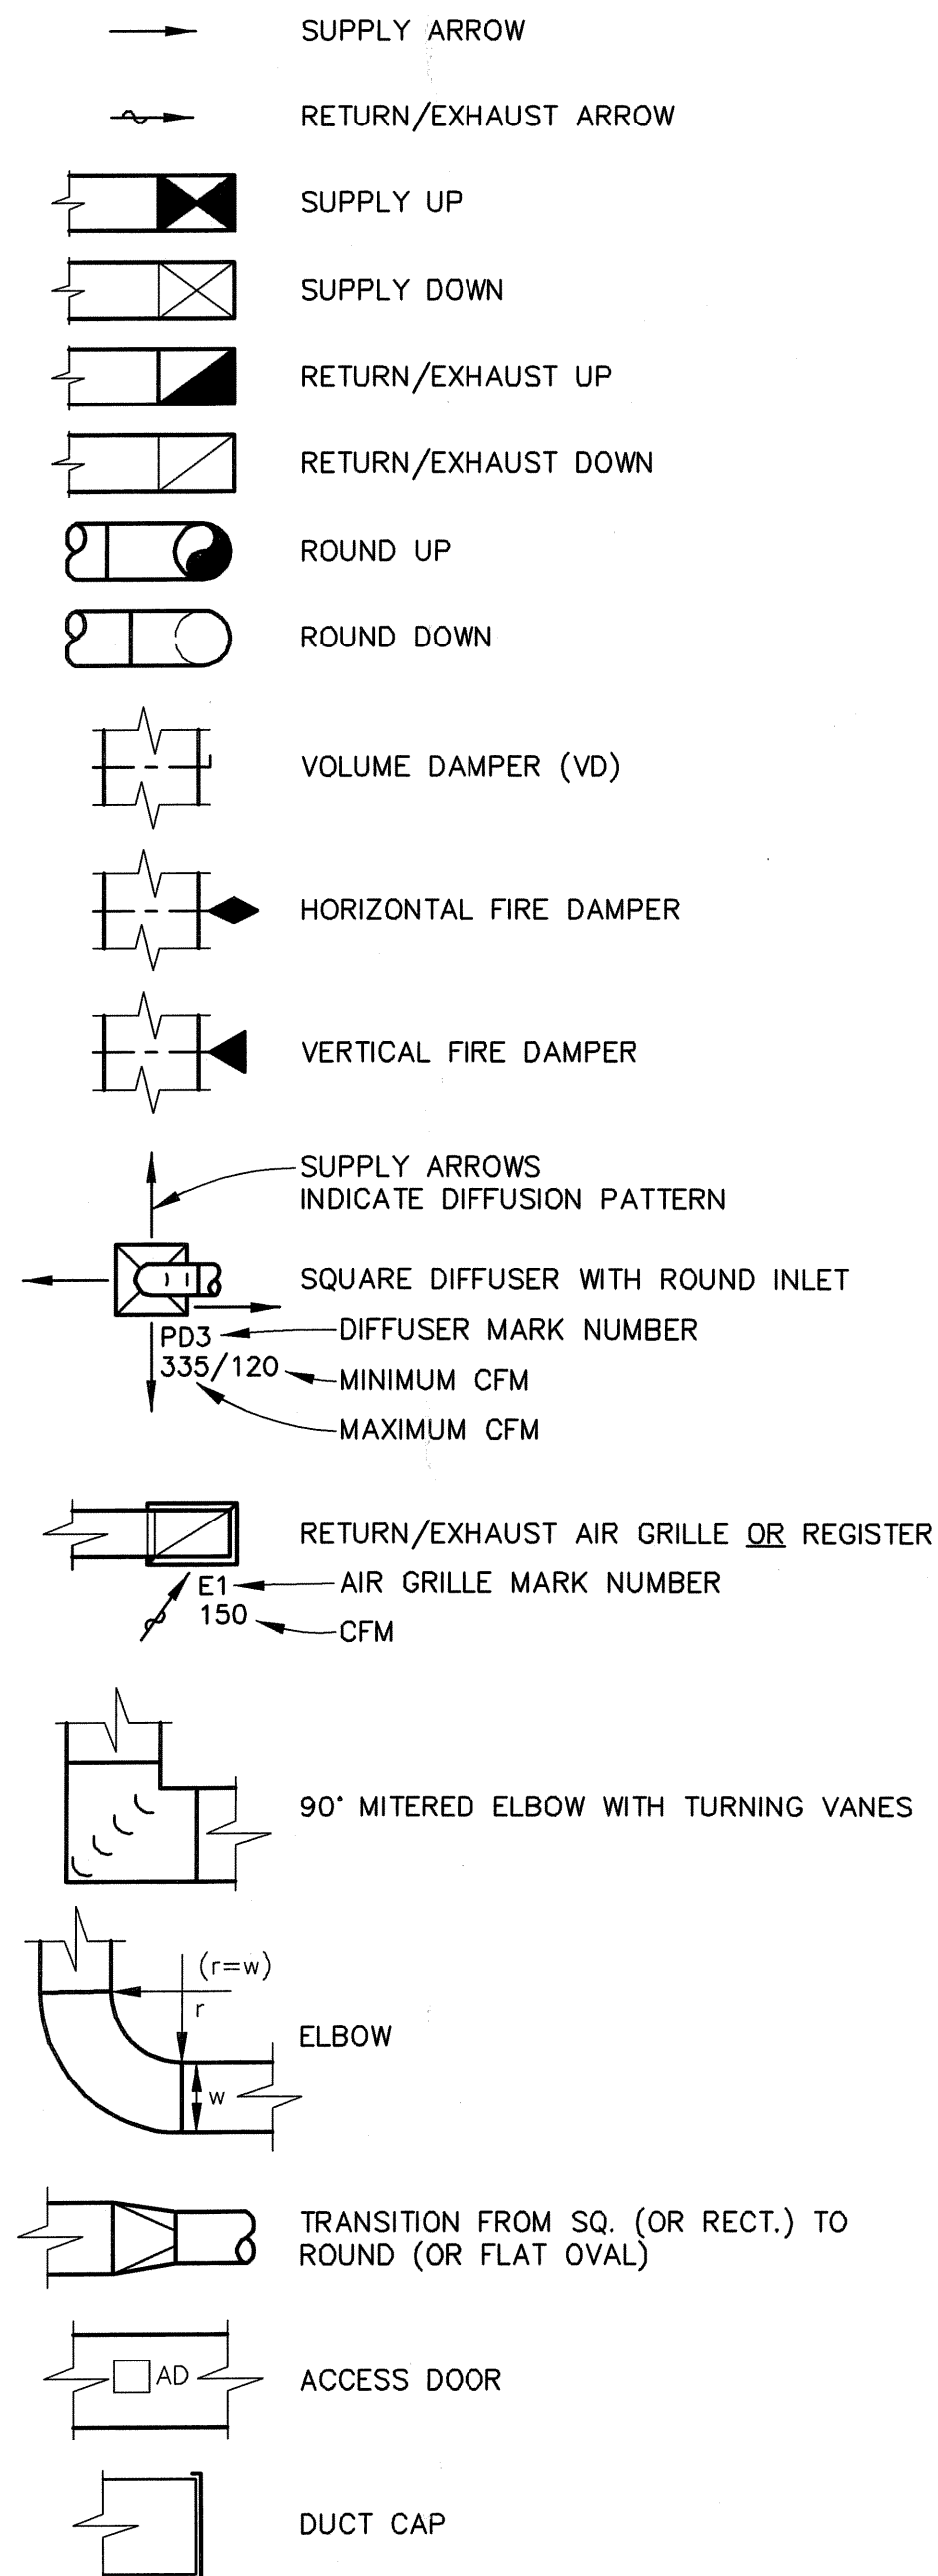

STANDARD KEY

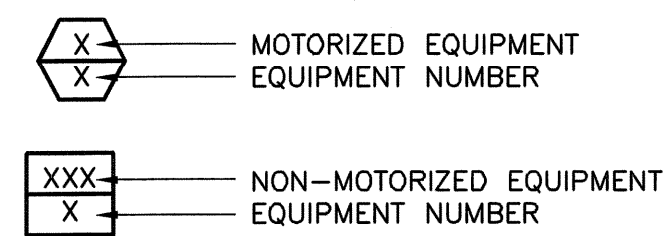

MISCELLANEOUS

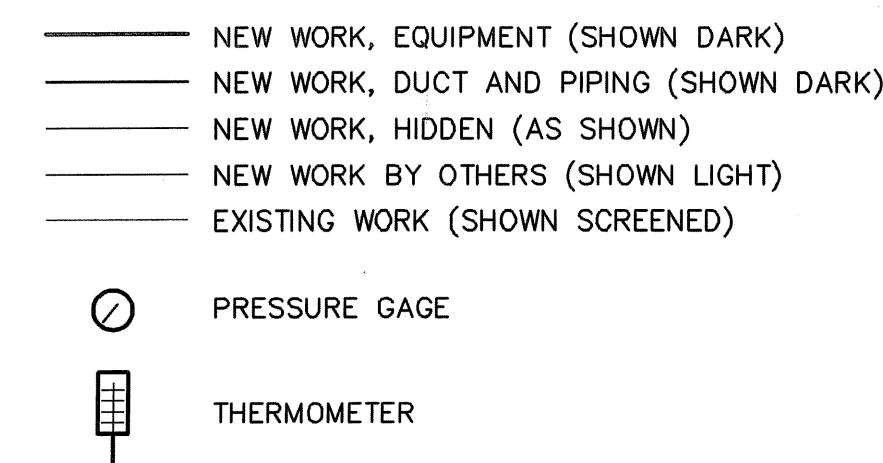

ABBREVIATIONS

A/C	AIR CONDITIONING
AD	ACCESS DOOR
AFF	ABOVE FINISHED FLOOR
AFG	ABOVE FINISHED GRADE
AHU	AIR HANDLING UNIT
APD	AIR PRESSURE DROP
BHP	BRAKE HORSEPOWER
BLDG	BUILDING
BOD	BOTTOM OF DUCT
BOS	BOTTOM OF STEEL
BTUH	BRITISH THERMAL UNIT PER HOURS
CD	CONDENSATE DRAIN
CFM	CUBIC FEET PER MINUTE
CO	CLEANOUT
CONN	CONNECTION
CONT	CONTINUATION
DB	DRY BULB
DEG	DEGREES
DIA	DIAMETER
DN	DOWN
DWG	DRAWING
EAD	EXHAUST AIR DUCT
EAT	ENTERING AIR TEMPERATURE
EF	EXHAUST FAN
EFF	EFFICIENCY
EG	EXHAUST GRILLE
ESP	EXTERNAL STATIC PRESSURE DROP
EUH	ELECTRIC UNIT HEATER
EWT	ENTERING WATER TEMPERATURE
FAD	FRESH AIR DUCT
FAI	FRESH AIR INTAKE
FD	FIRE DAMPER
FLA	FULL LOAD AMPS
FPI	FINS PER INCH
FPM	FEET PER MINUTE
FT	FEET/FOOT
GAL	GALLONS
GALV	GALVANIZED
GC	GENERAL CONTRACTOR
HC	HEATING COIL
HGT	HEIGHT
HOA	HAND-OFF-AUTO
HORIZ	HORIZONTAL
HP	HORSEPOWER
IN	INCHES
IN.WG.	INCHES WATER GAGE
L	LONG
LWT	LEAVING WATER TEMPERATURE
KW	KILOWATTS
LAT	LEAVING AIR TEMPERATURE
LRA	LOCKED ROTOR AMPS
MAV	MANUAL AIR VENT
MBH	THOUSAND BRITISH THERMAL UNITS PER HOUR
MCA	MINIMUM CIRCUIT AMPS
MFR	MANUFACTURER
MIN	MINIMUM
MAX	MAXIMUM
MOC	MAXIMUM OVERCURRENT PROTECTION
MOD	MOTOR OPERATOR DAMPER
MTR	MOTOR
NC	NORMALLY CLOSED
NO	NORMALLY OPEN, NUMBER
NTS	NOT TO SCALE
OBD	OPPOSED BLADE DAMPER
P	PUMP
PCT	PERCENT
PD	PRESSURE DROP
PLBG	PLUMBING
PSIG	POUNDS PER SQUARE INCH GAUGE
QTY	QUANTITY
RAD	RETURN AIR DUCT
RDU	REFRIGERATION DEHUMIDIFICATION UNIT
RL	REFRIGERANT LIQUID
RLA	RATED LOAD AMPS
RPM	REVOLUTIONS PER MINUTE
RS	REFRIGERANT SUCTION
SAD	SUPPLY AIR DUCT
SF	SUPPLY FAN, SQUARE FEET
SENS	SENSIBLE
SQ	SQUARE
SR	SUPPLY REGISTER
SST	STAINLESS STEEL
STL	STEEL
SW	SERVICE WATER
TFC	TOTALLY ENCLOSED FAN COOLED
TEMP	TEMPERATURE
TSP	TOTAL STATIC PRESSURE
UH	UNIT HEATER
VERT	VERTICAL
VD	VOLUME DAMPER
W	WATTS, WIDE
WB	WET BULB
WMS	WIRE MESH SCREEN
WPD	WATER PRESSURE DROP
W/O	WITHOUT

GENERAL NOTES

1. THE DRAWINGS ARE DIAGRAMMATIC ONLY TO SHOW THE SCOPE OF THE WORK INVOLVED. ANY WORK INSTALLED CONTRARY TO OR WITHOUT APPROVAL SHALL BE SUBJECT TO CHANGE. NO EXTRA COMPENSATION WILL BE ALLOWED. DO NOT SCALE DRAWINGS FOR FABRICATION PURPOSES.
2. PERFORM ALL WORK IN STRICT ACCORDANCE WITH LAWS, REGULATIONS, AND STANDARDS OF LOCAL, STATE AND FEDERAL GOVERNMENTS AND INSURANCE REQUIREMENTS.
3. GIVE ALL NOTICES, FILE PLANS, OBTAIN PERMITS AND LICENSES, PAY FEES AND BACKCHARGES, AND OBTAIN NECESSARY APPROVALS FROM AUTHORITIES HAVING JURISDICTION AS REQUIRED TO PERFORM WORK.
4. COOPERATE AND COORDINATE WITH OTHER TRADES IN EXECUTING THE WORK. PERFORM WORK SO THAT PROGRESS OF ENTIRE PROJECT SHALL NOT BE DELAYED. PROVIDE INFORMATION TO OTHER TRADES, AS REQUESTED. OBTAIN FINAL ROUGHING DIMENSIONS AS REQUIRED TO COMPLETE WORK.
5. PERFORM WORK REQUIRED SO AS TO PROVIDE PROPER ACCESS TO MATERIAL AND EQUIPMENT REQUIRING INSPECTION, MAINTENANCE OR SERVICE.
6. DUCTWORK, PIPING AND EQUIPMENT LAYOUT SHOWN IS DIAGRAMMATIC, LOCATION SHALL BE DETERMINED IN FIELD.
7. SUBMIT SHOP DRAWINGS AND PRODUCT INFORMATION. NO WORK SHALL PROCEED WITHOUT WRITTEN APPROVAL ON EACH ITEM SCHEDULED, SPECIFIED OR SHOWN ON PLAN.
8. SUBMIT (2) COPIES OF A CERTIFIED AIR AND WATER BALANCING REPORT, PREPARED BY AN INDEPENDENT TESTING, ADJUSTING AND BALANCING AGENCY, NOT THE CONTRACTOR.
9. ALL EQUIPMENT SHALL BE AS SHOWN ON EQUIPMENT SCHEDULES.

HVAC NOTES

1. DUCTWORK AND ACCESSORIES
 - A. DUCTWORK SHALL FOLLOW THE GENERAL ROUTING INDICATED ON THE DRAWINGS. COORDINATE LOCATION WITH PIPING AND EQUIPMENT.
 - B. DUCTWORK SHALL BE FREE FROM VIBRATION. MAKE AND SEAL DUCT JOINTS AS SPECIFIED.
 - C. ALL RECTANGULAR DUCT ELBOWS SHALL HAVE TURNING VANES.
 - D. PROVIDE SEISMIC RESTRAINTS FOR DUCTWORK AND EQUIPMENT WHERE REQUIRED BY THE BUILDING CODE.
 - E. REFER TO ARCHITECTURAL DRAWINGS FOR EXACT LOUVER LOCATIONS.
2. INSULATION
 - A. INSULATE ALL EXHAUST AIR DUCTWORK BETWEEN THE OUTDOOR DISCHARGE AND CONTROL DAMPER. INSULATE ALL PLENUMS.
3. ELECTRICAL ENCLOSURES
 - A. ALL ENCLOSURES SHALL BE NEMA TYPE 1 UNLESS OTHERWISE INDICATED. "ENCLOSURES" SHALL MEAN ELECTRICAL EQUIPMENT ENCLOSURES AND ASSOCIATED CONDUIT.

FULL SIZE DRAWING = 4"

NO.	DATE	BY	REVISIONS
2	AS-BUILT DRAWING FILE	DPB	MAY 2008
1	ISSUED FOR PERMITS SET	AH	10/25/05
0	ISSUED FOR CONSTRUCTION	AAS	10/28/05
6	ISSUED FOR REV. APPROBATION REVIEW	AAS	8/16/05
R	ISSUED FOR REVISION REVIEW	AAS	7/22/05


ROBERT H. SHELDON
 No. 4103
 5/17/05

PAWTUCKET, RHODE ISLAND
**PAWTUCKET REGIONAL
 WATER TREATMENT FACILITY**
PKGS 11 & 12 - RAW WATER PUMP STATION
 HVAC LEGENDS, ABBREVIATIONS, AND GENERAL NOTES


DESIGNED BY CVA	DWG SCALE AS NOTED
DRAWN BY CVA	CONTRACT NO.
CHECKED BY AG	DATE OCTOBER 31, 2008

EARTH TECH
AS-BUILT FILE
 MAY 2008


FULL FILE DATE UPLOADED: 05/17/2008 11:04 AM

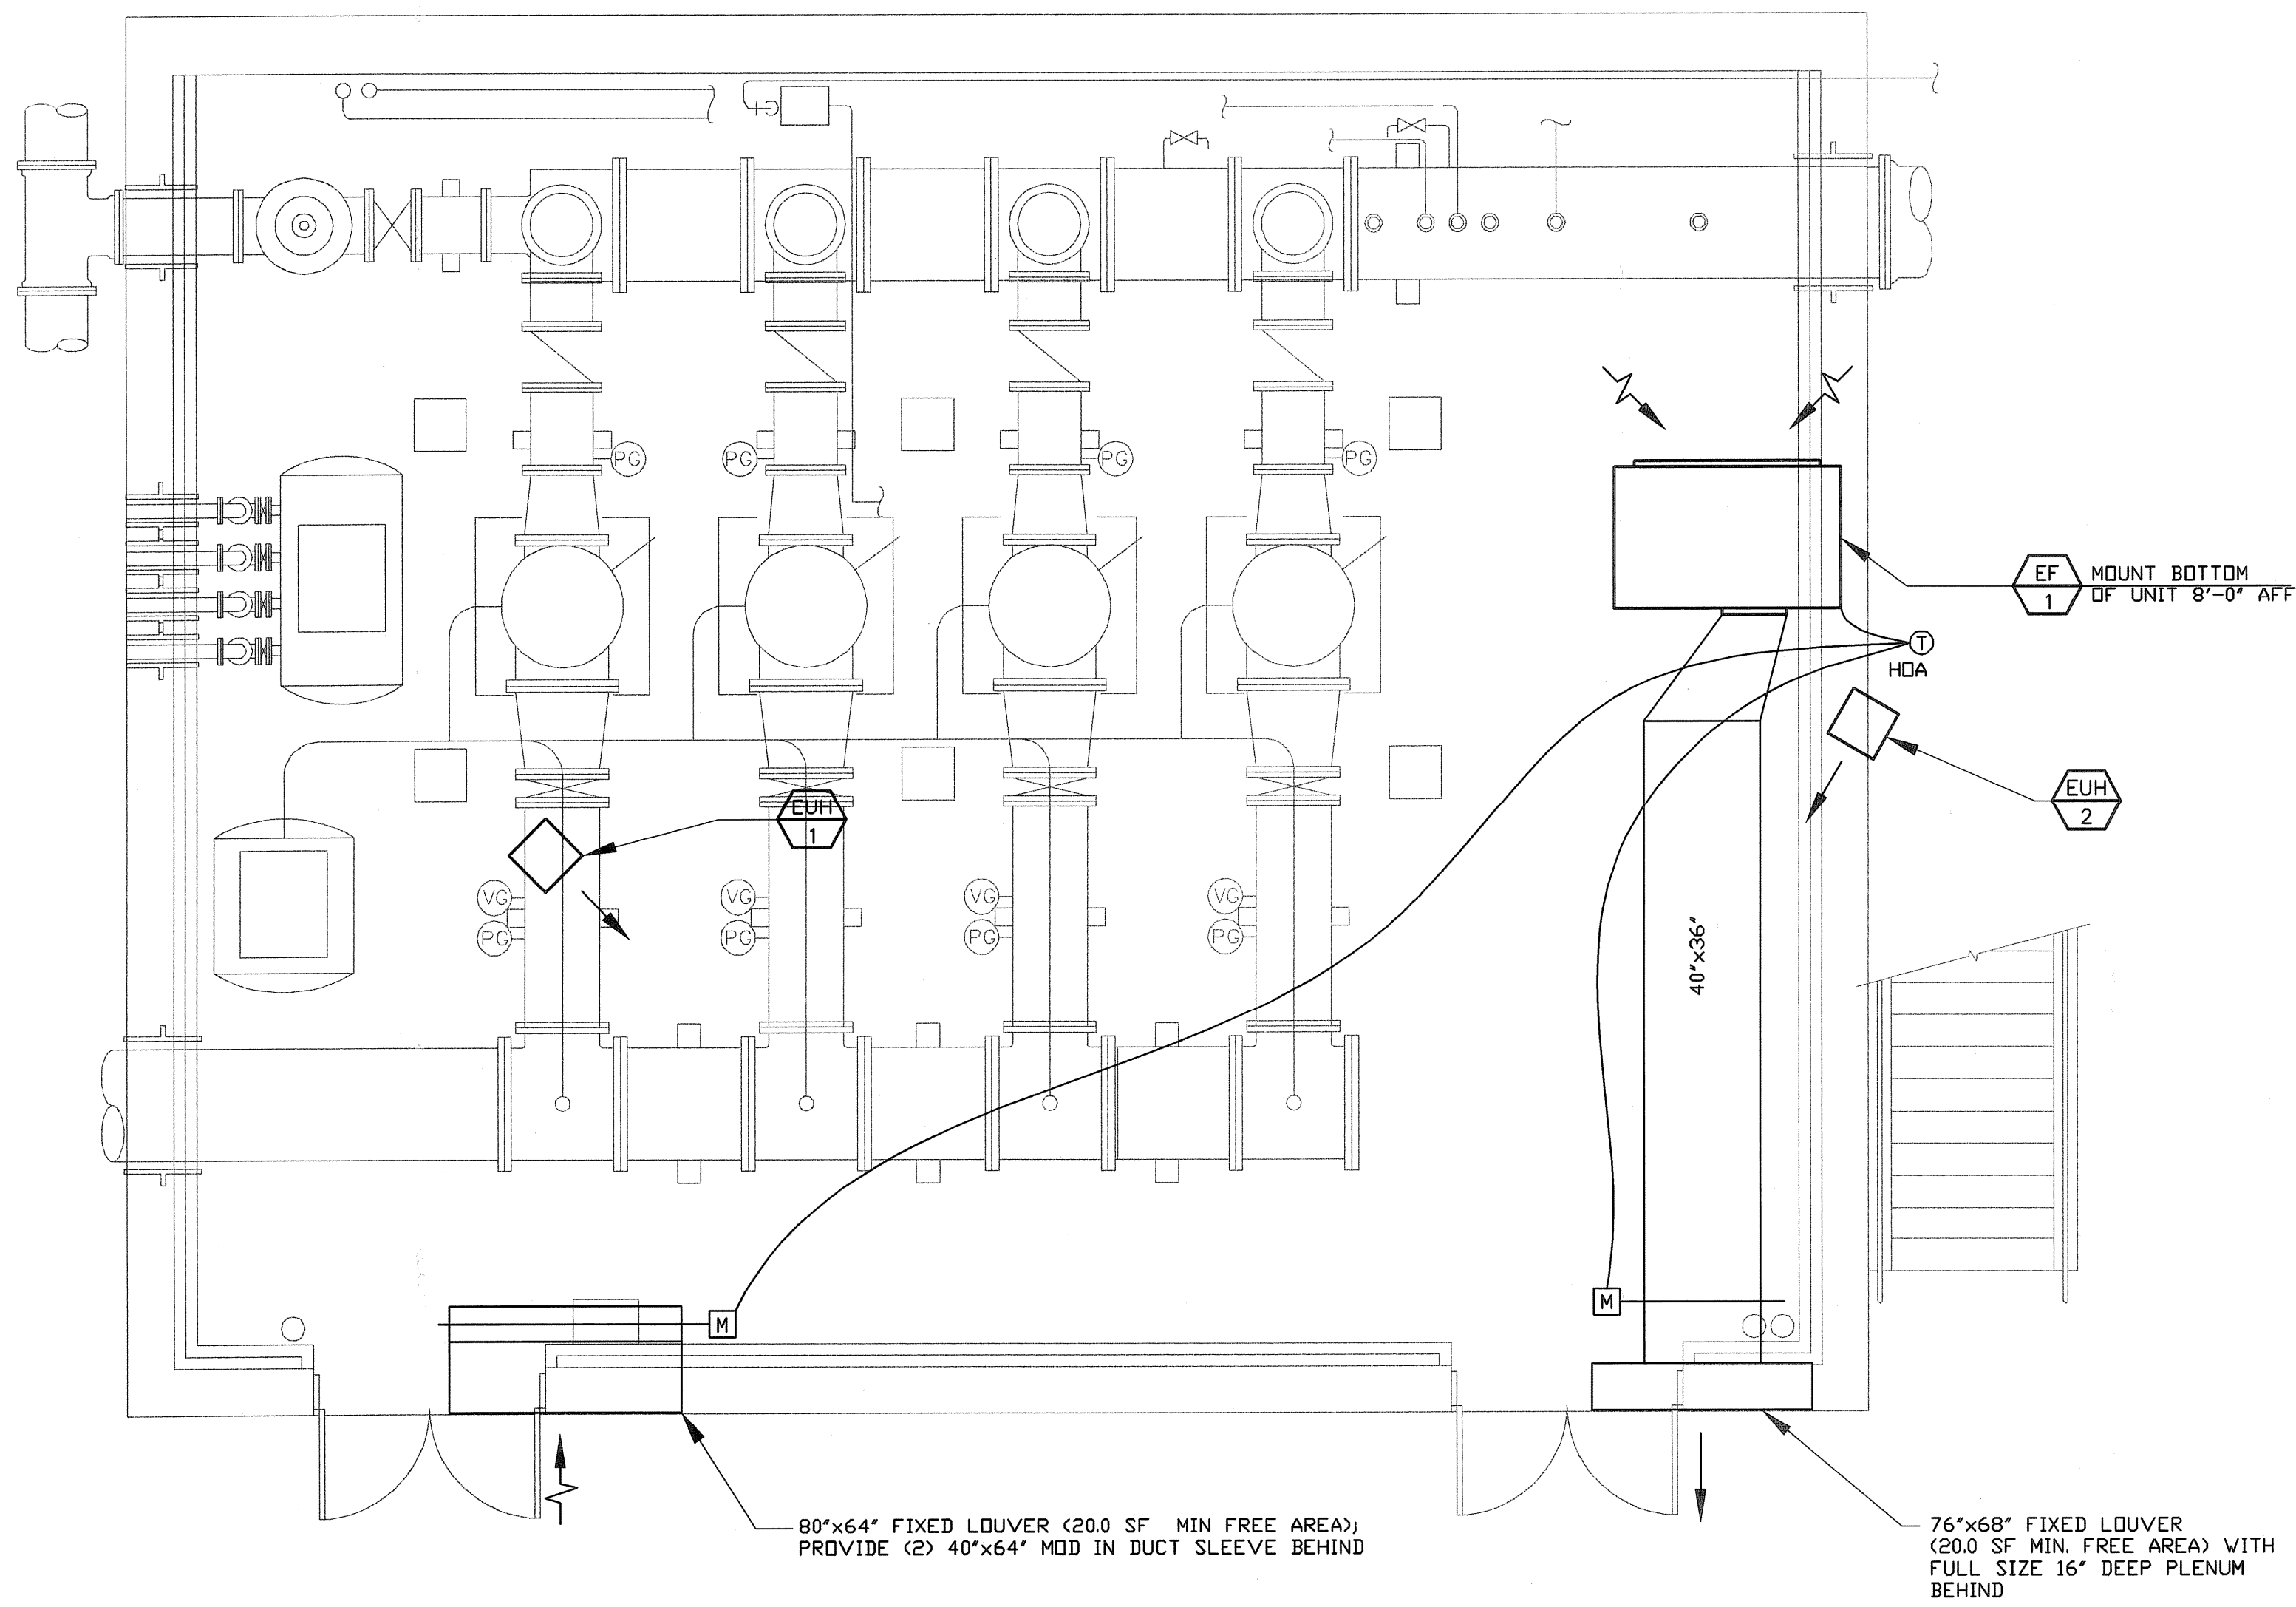


PUMP LEVEL FLOOR PLAN - EL. 59.00'
SCALE: 1/4" = 1'-0"

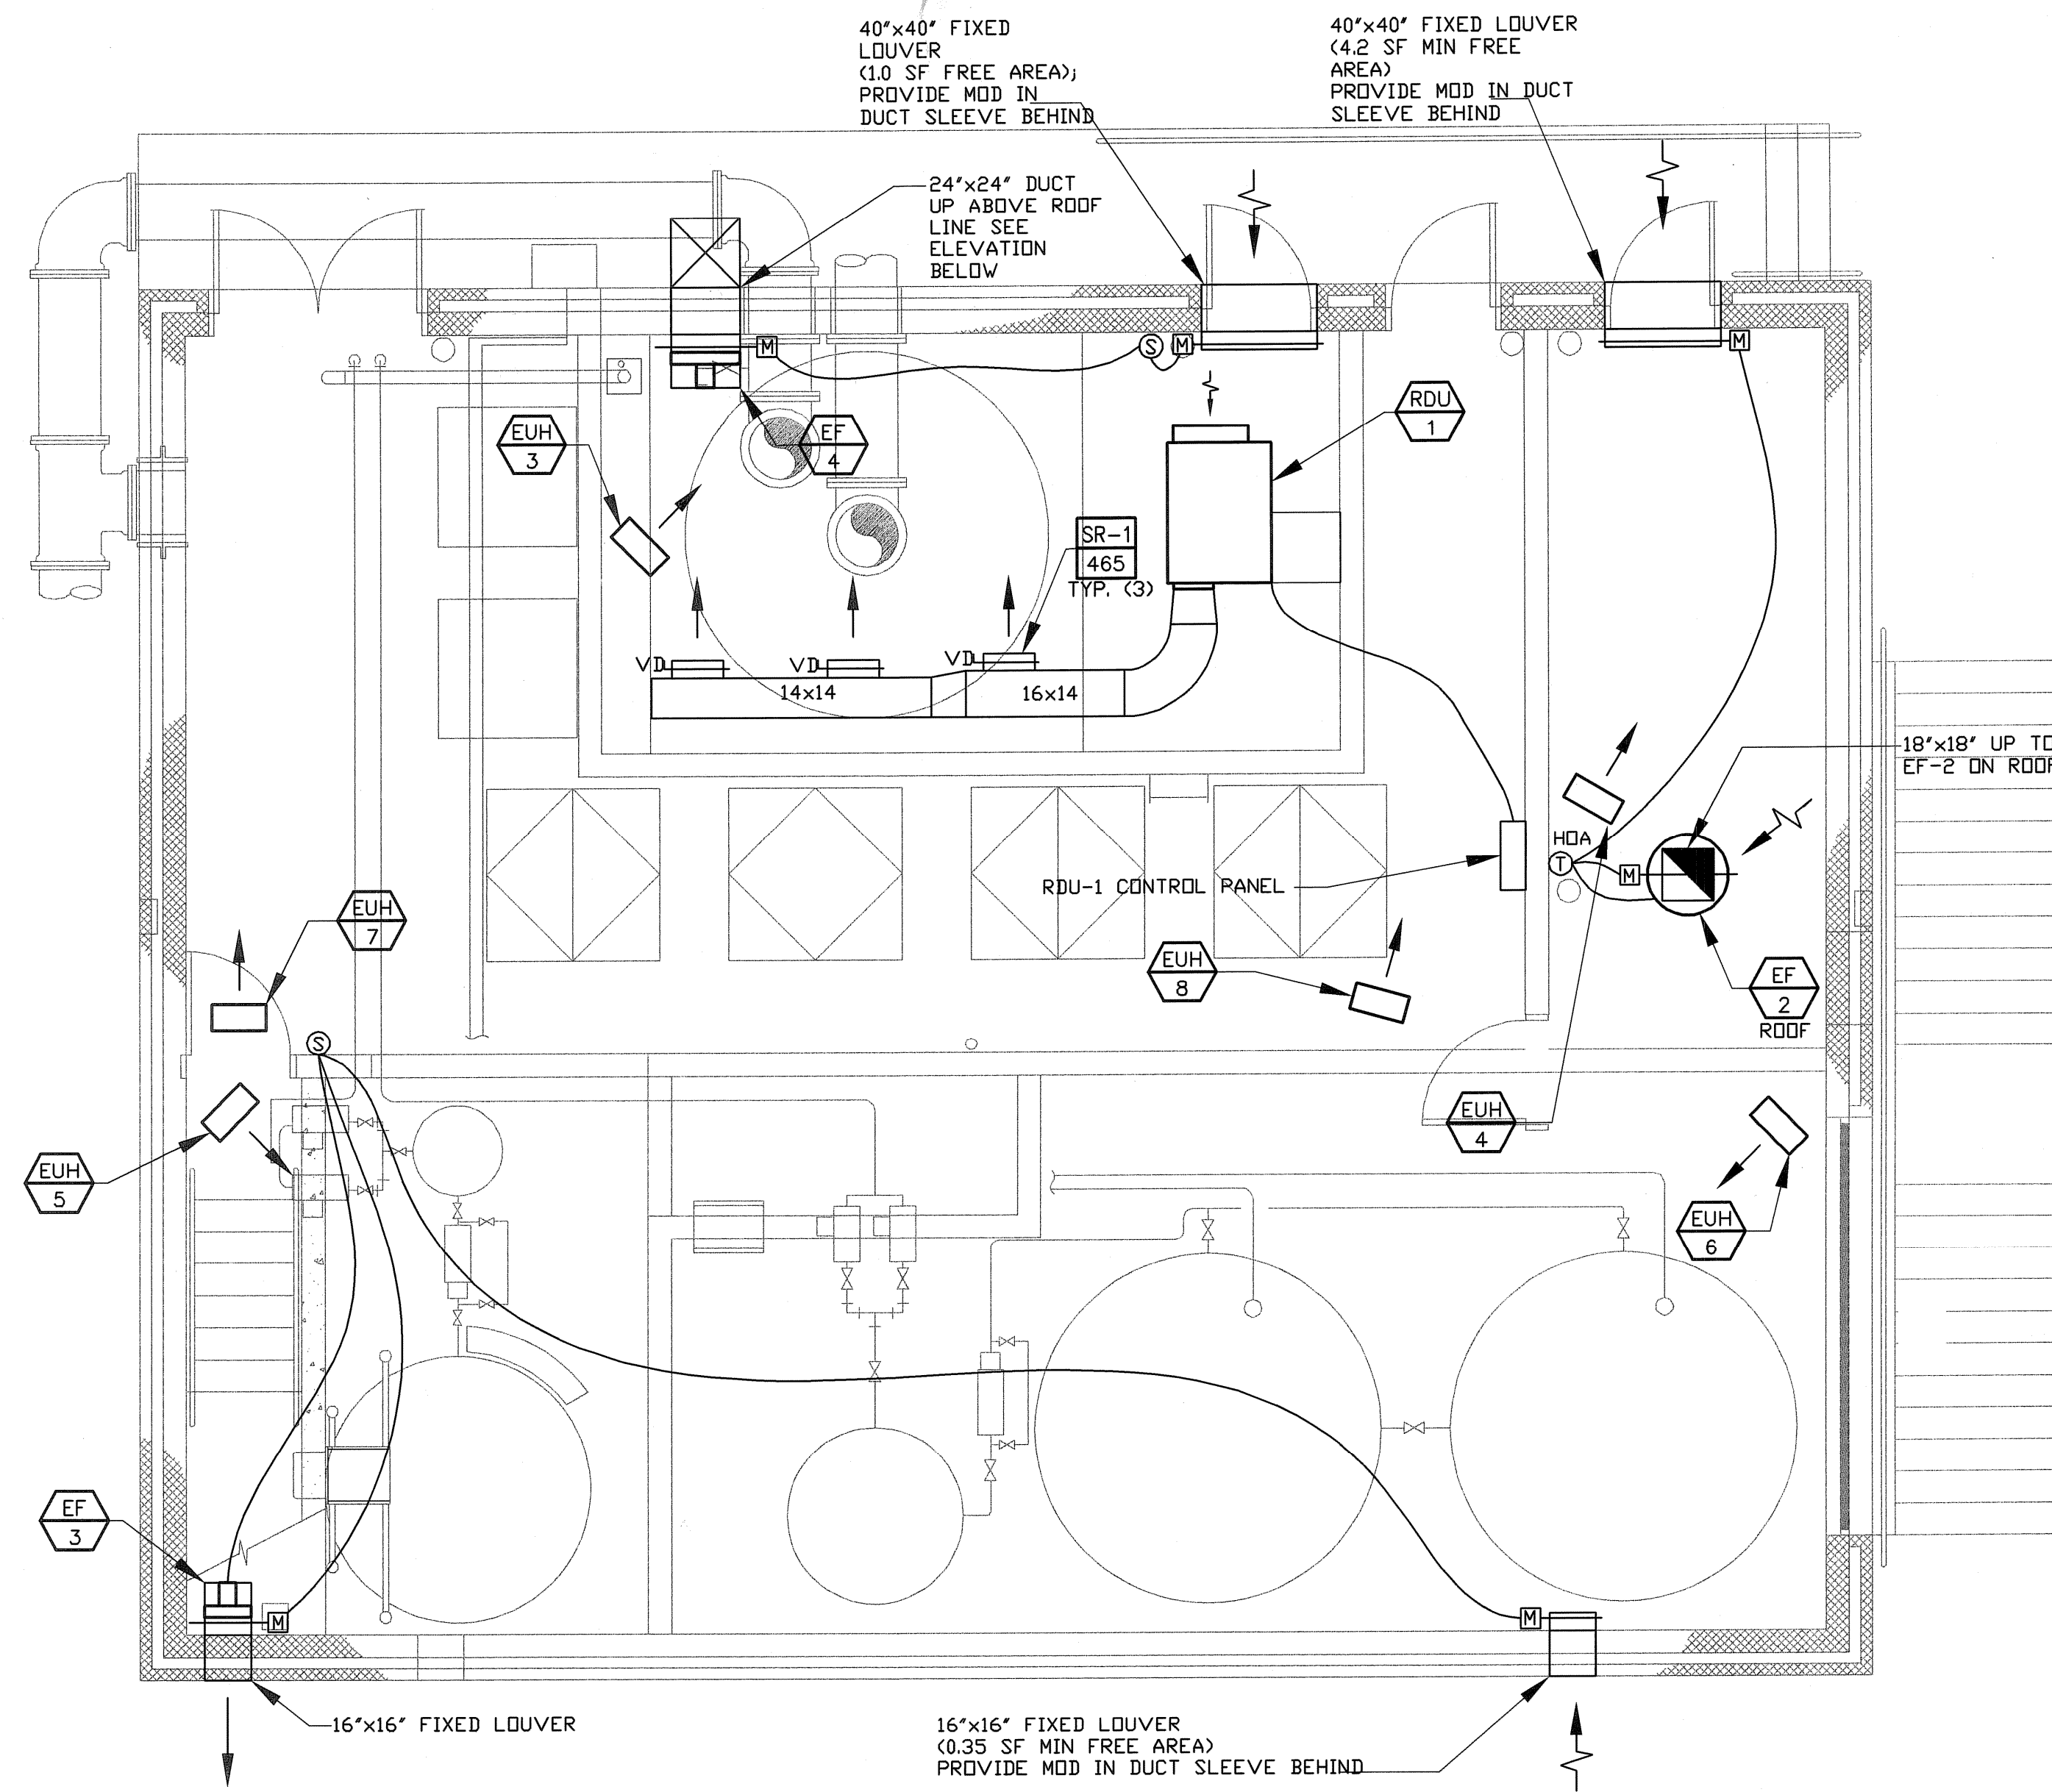

GROUND LEVEL FLOOR PLAN - EL. 79.00'
SCALE: 1/4" = 1'-0"

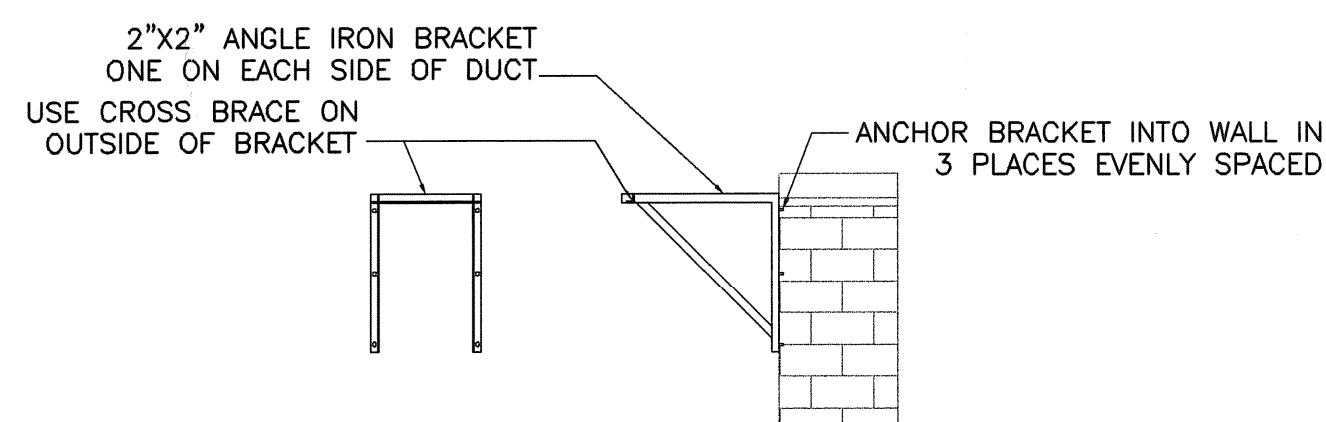

STRIPPER ROOM EXHAUST SUPPORT DETAIL
SCALE: 1/4" = 1'-0"

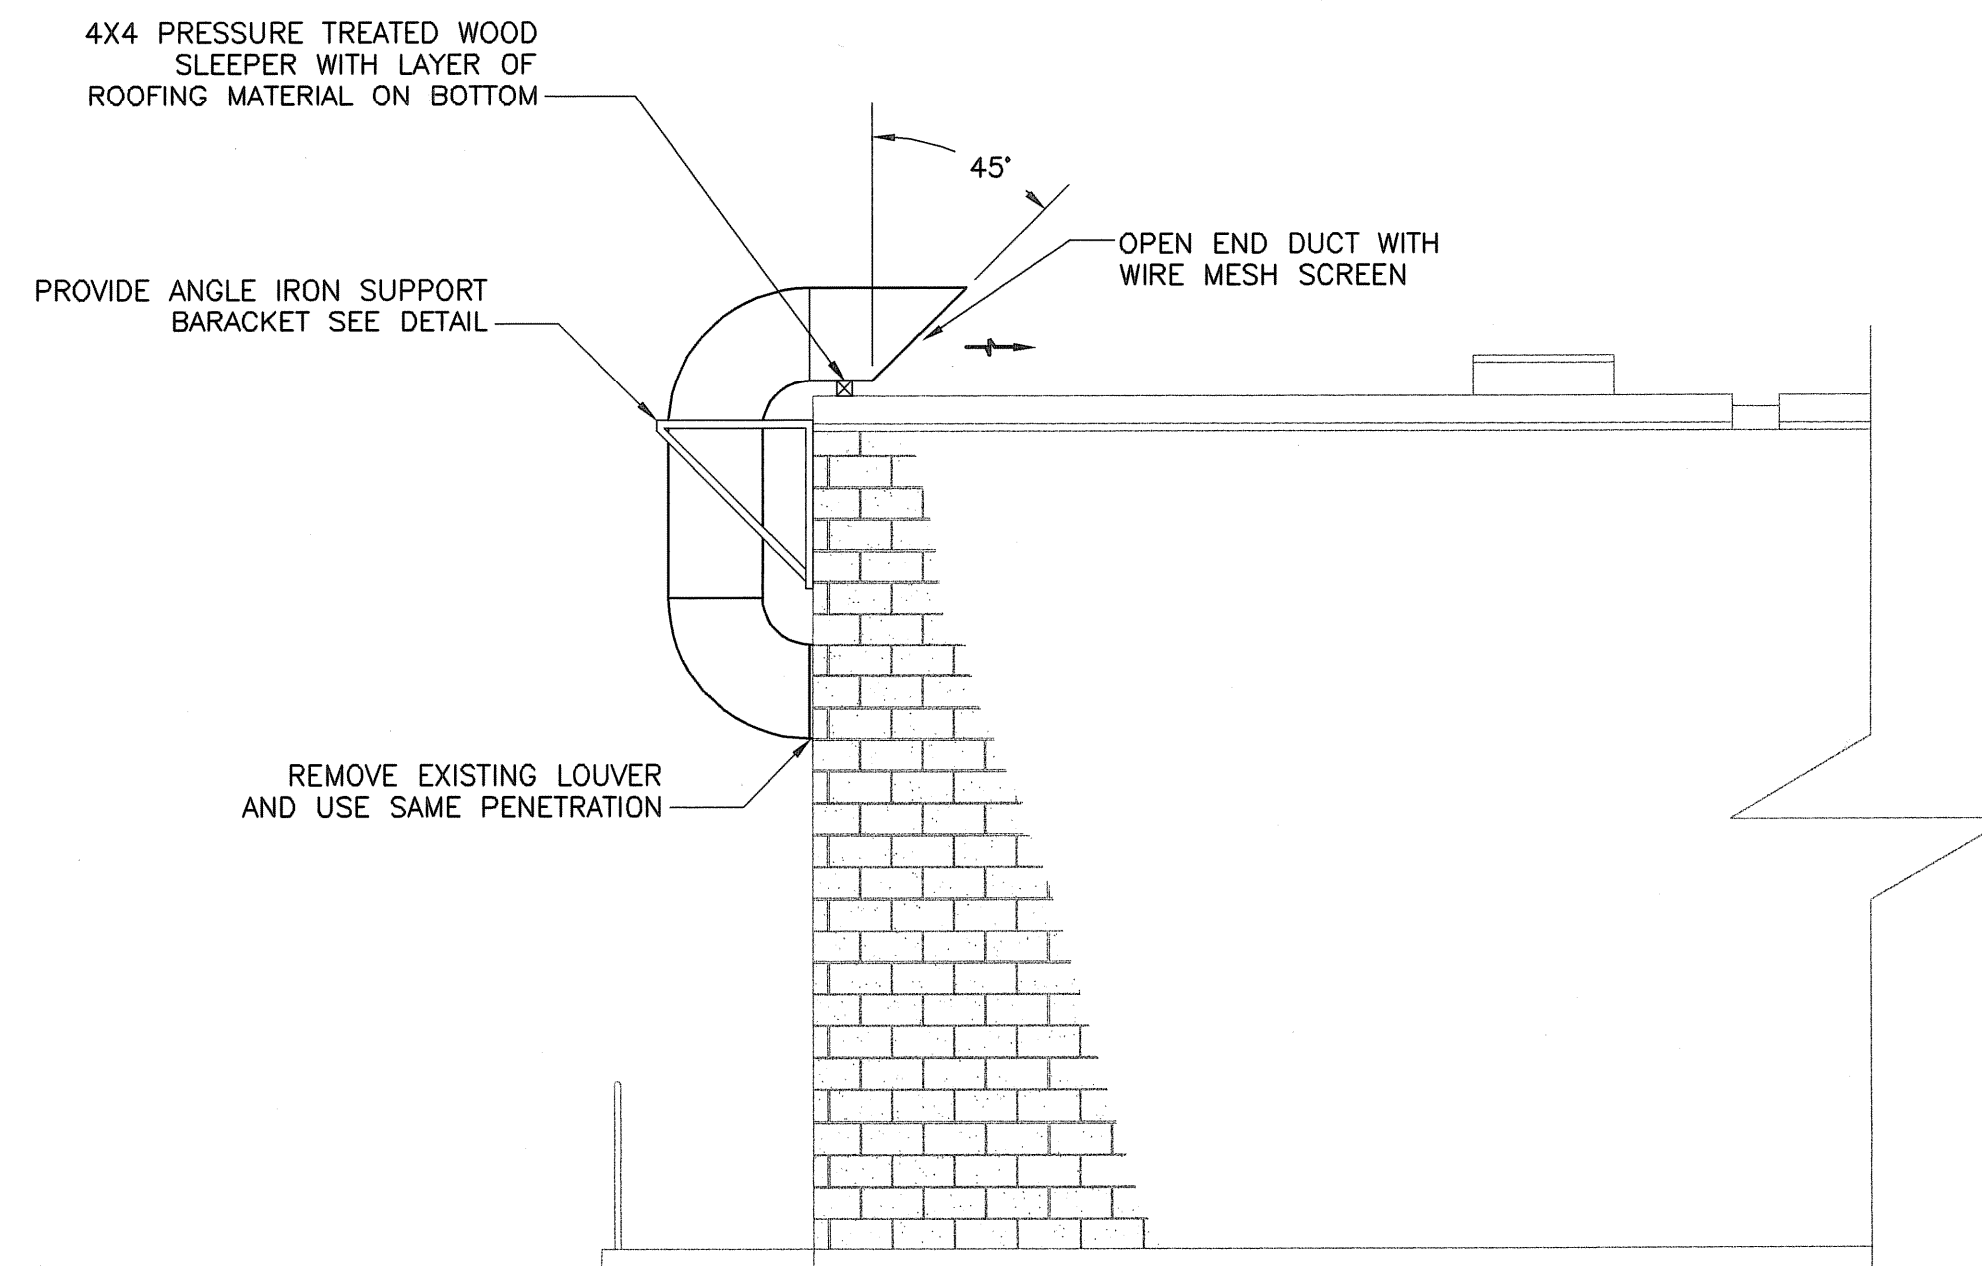

STRIPPER ROOM EXHAUST ELEVATION
SCALE: 1/4" = 1'-0"

AS-BUILT DRAWING FILE

ISSUED FOR PER POSTED SET

ISSUED FOR CONSTRUCTION

REV. B AGENCY REVIEW

REV. A CLIENT REVIEW

NO. DATE

2 MAY 2008

1 10/27/05

0 10/28/05

8 8/16/05

4 7/22/05

BY

ROBERT H. SHELDON

4103

Professional Engineer

State of Rhode Island

3/1/08

PAWTUCKET, RHODE ISLAND

PAWTUCKET REGIONAL WATER TREATMENT FACILITY

PKGS 11 & 12 - RAW WATER PUMP STATION

DUCTWORK PLANS

DESIGNED BY CVA

DWG SCALE AS NOTED

DRAWN BY CVA

CONTRACT NO.

CHECKED BY AG

DATE OCTOBER 31, 2008

EARTH TECH

AS-BUILT FILE

MAY 2008

REFRIGERATION DEHUMIDIFIER UNIT																		
TAG NO.	MANUFACTURER MODEL NO. OR EQUAL	AREA SERVED	MTG. HT. (FT.) *	CFM	RATED CAPACITY ROOM CONDITIONS (DB / RH)	DEHUMIDIFICATION CAPACITY (LB/HR)	TOTAL COOLING CAPACITY (MBH)	SENSIBLE COOLING CAPACITY (MBH)	BLOWER		COMPRESSOR		ELECTRICAL DATA				REMARKS	
									HP (0.5" ESP)	FLA	NOMINAL TONNAGE	RLA/LRA	KW	MCA/MOCP	VOLTS	PHASE		HERTZ
RDU-1	DESERT AIRE IH-300	202 - STRIPPER ROOM	10'-0"	1400	82 °F DB / 60% RH	18	41	22	0.5	1.1	3	6.4/44	3.5	11/15	460	3	60	① ② ③

* MOUNTING HEIGHT IS TO BOTTOM OF UNIT FROM FINISHED FLOOR

- ① FIELD-INSTALLED CA2300 CONTROLLER PACKAGE
- ② ELECTROFIN E-COATING COIL FOR CORROSIVE ENVIRONMENTS
- ③ ELECTRICAL DISCONNECT

FAN SCHEDULE											
TAG NO.	MANUFACTURER MODEL NO. OR EQUAL	AREA SERVED	TYPE	DRIVE	CFM	ESP (IN. WG.)	MOTOR DATA				REMARKS
							HP	VOLT	PHASE	RPM	
EF-1	CARRIER 39LG-25	101 - PUMP ROOM	CENTRIFUGAL ENCLOSED	BELT	14,000	0.5	7 1/2	460	3	1725/850	③ ④
EF-2	PENN VENT #DX14B	203 - ELECTRICAL ROOM	ROOF-MOUNTED CENTRIFUGAL	BELT	2000	0.13	1/3	115	1	815	① ⑤ ⑥ ⑦
EF-3	PENN VENT #P10VA	204 - CAUSTIC ROOM / 205 - POTASSIUM PERMANGANATE	PROPELLER WALL EXHAUST	DIRECT	192	0.13	1/30	115	1	842	① ② ⑧
EF-4	PENN VENT #P10VA	202 - STRIPPER ROOM	PROPELLER WALL EXHAUST	DIRECT	430	0.13	1/30	115	1	1026	① ② ⑧


- ① MOTOR OPERATED DAMPER
- ② WALL HOUSING WITH GUARD
- ③ 1/2"x 1/2" ALUMINUM WELDED WIRE MESH INLET SCREEN
- ④ DOUBLE WINDING, 2-SPEED TEFC MOTOR
- ⑤ 12" HIGH PREFABRICATED ROOF CURB
- ⑥ DISCONNECT SWITCH
- ⑦ TEFC MOTOR
- ⑧ LEK-TROL ELECTRONIC SPEED CONTROLLER

ELECTRIC UNIT HEATER SCHEDULE										
TAG NO.	MANUFACTURER MODEL NO. OR EQUAL	AREA SERVED	CFM	MTG. HT. (FT.) *	ELECTRICAL DATA					REMARKS
					KW	STAGES	AMPS	VOLTS	PHASE	
EUH-1	BERKO HUHA748	101 - PUMP ROOM	650	7'-0"	7.5	2	9	460	3	② ③
EUH-2	BERKO HUHA748	101 - PUMP ROOM	650	7'-0"	7.5	2	9	460	3	② ③
EUH-3	RUFFNECK MOD #CRI-480360-100	202 - STRIPPER ROOM	-	7'-0"	10	2	13	460	3	② ③ ④
EUH-4	BERKO HUHA348	203 - ELECTRICAL ROOM	350	7'-0"	3	1	3.6	460	3	① ③
EUH-5	BERKO HUHA348	204 - CAUSTIC ROOM / 205 - POTASSIUM PERMANGANATE	350	7'-0"	3	1	3.6	460	3	① ③
EUH-6	BERKO HUHA348	204 - CAUSTIC ROOM / 205 - POTASSIUM PERMANGANATE	350	7'-0"	3	1	3.6	460	3	① ③
EUH-7	BERKO HUHA348	201 - CORRIDOR	350	7'-0"	3	1	3.6	460	3	① ③
EUH-8	BERKO HUHA348	201 - CORRIDOR	350	7'-0"	3	1	3.6	460	3	① ③


* MOUNTING HEIGHT IS TO BOTTOM OF UNIT FROM FINISHED FLOOR

- ① SINGLE STAGE INTERNAL THERMOSTAT
- ② TWO STAGE INTERNAL THERMOSTAT
- ③ MOUNTING KIT
- ④ STAINLESS STEEL ENCLOSURE

DIFFUSER AND REGISTER SCHEDULE						
TAG NO.	MANUFACTURER AND MODEL NO.	NECK SIZE	CFM	FUNCTION	TYPE	REMARKS

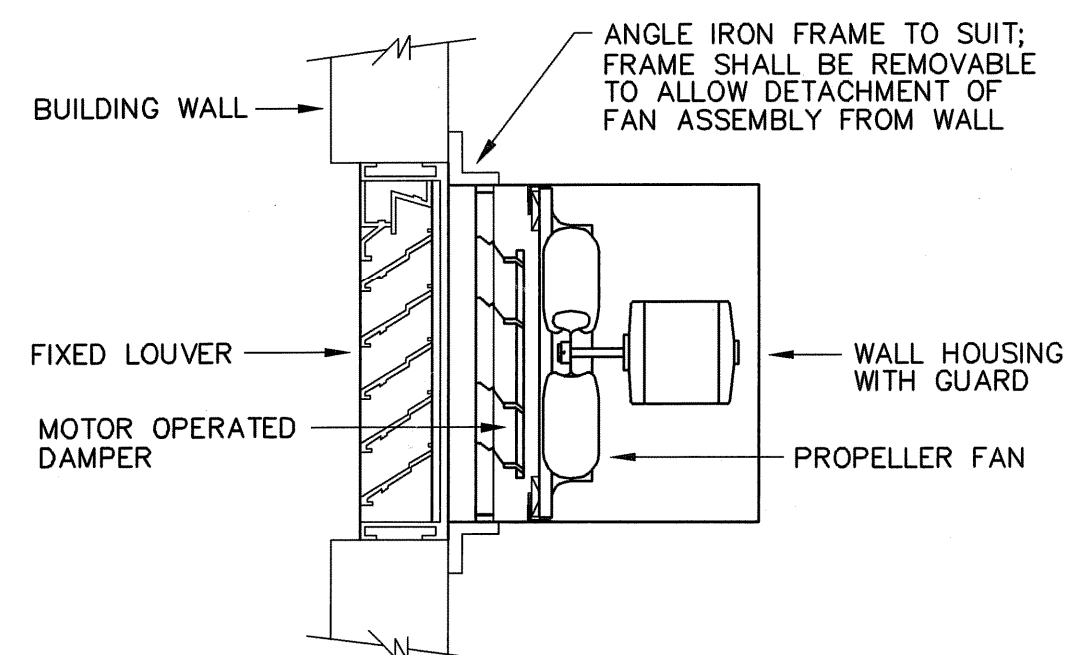

**WALL MOUNTED
PROPELLER EXHAUST FAN DETAIL**
NOT TO SCALE

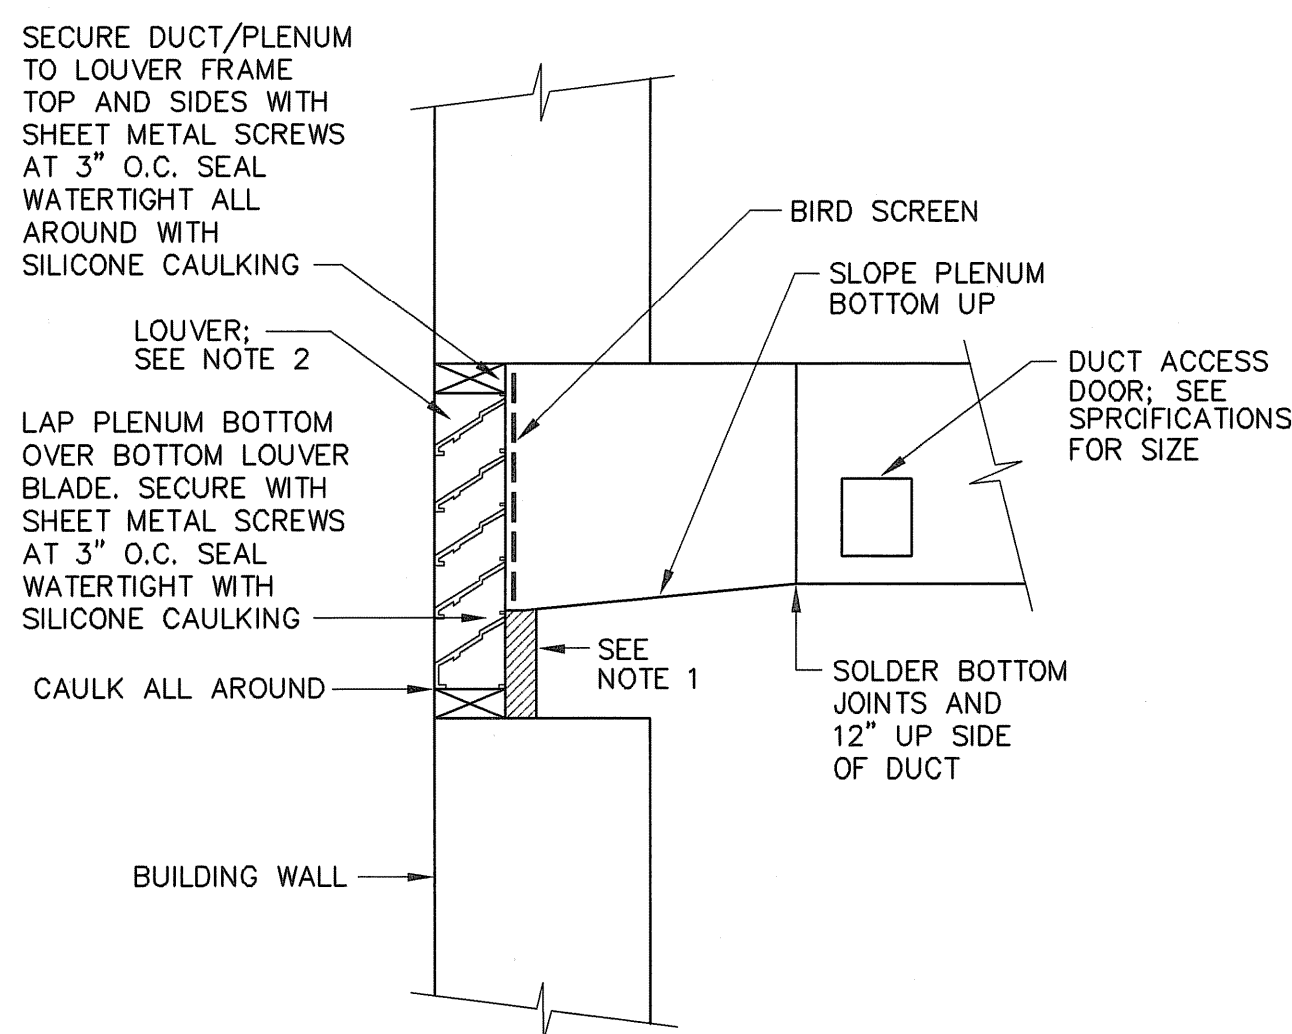

- NOTES:**
- BLOCK UNUSED PORTION OF LOUVER WITH 2" THICK INSULATED METAL PANEL.
 - LOUVERS BY GENERAL CONTRACTOR; SEE ARCHITECTURAL PLANS.

LOUVER/PLENUM CONNECTION DETAIL
NOT TO SCALE

HVAC CONTROL NOTES:

- ELECTRIC UNIT HEATERS AND DEHUMIDIFIERS HAVE INTEGRAL CONTROLS AND ARE NOT PART OF THE AUTOMATIC CONTROLS WORK EXCEPT MOUNTING AND WIRING OF DEHUMIDIFIER FACTORY-FURNISHED, FIELD-INSTALLED CONTROL PANEL.
- PROVIDE ALL WIRING AND COMPONENTS SHOWN AND NOT SHOWN TO ACCOMPLISH THE SPECIFIED CONTROL SEQUENCES.
- ALL CONTROL DAMPERS SHALL BE 2-POSITION SPRING RETURN WIRED FOR POWER OPEN/FAIL CLOSE. SPRING RETURN SHALL BE UTILIZED FOR FAIL MODE.
- WALL-MOUNT ALL THERMOSTATS, CONTROL PANELS, AND MANUAL SWITCHES 5'-0" AFF TO CENTERLINE.
- PROVIDE INSULATED BACKING ON ALL THERMOSTATS MOUNTED ON EXTERIOR WALLS.
- PROVIDE FAN "ON/OFF/AUTO" SUB-BASE ON EACH EXHAUST FAN THERMOSTAT.
- ELECTRICAL ENCLOSURES: ALL ENCLOSURES SHALL BE NEMA TYPE 1 UNLESS OTHERWISE INDICATED. "ENCLOSURES" SHALL MEAN ELECTRICAL EQUIPMENT ENCLOSURES AND ASSOCIATED CONDUIT.

HVAC CONTROL SEQUENCES

A. PUMP ROOM - VENTILATION (EF-1)

- WHEN THE ON/OFF/AUTO SUB-BASE IS SET TO "AUTO", UPON A RISE IN SPACE TEMPERATURE ABOVE 90 DEGREES F (ADJUSTABLE) AS SENSED BY THE FIRST STAGE OF A 2-POSITION 2-STAGE REVERSE ACTING THERMOSTAT, BOTH THE 2-POSITION OUTDOOR AIR MOTOR-OPERATED DAMPERS AND THE 2-POSITION EXHAUST AIR MOTOR-OPERATED DAMPER SHALL OPEN, AFTER WHICH THE 2-SPEED EXHAUST FAN SHALL START AND RUN AT LOW SPEED.

UPON A FURTHER RISE IN SPACE TEMPERATURE ABOVE 94 DEGREES F (ADJUSTABLE) AS SENSED BY THE SECOND STAGE OF THE 2-POSITION 2-STAGE REVERSE ACTING THERMOSTAT, THE 2-SPEED EXHAUST FAN SHALL GO TO HIGH SPEED. UPON A DROP BELOW SET POINTS, THE REVERSE SHALL OCCUR.

- WHEN THE ON/OFF/AUTO SUB-BASE IS SET TO "OFF", THE WALL-MOUNTED EXHAUST FAN SHALL STOP, AFTER WHICH BOTH THE 2-POSITION OUTDOOR AIR MOTOR-OPERATED DAMPERS AND THE 2-POSITION EXHAUST AIR MOTOR-OPERATED DAMPER SHALL CLOSE.
- WHEN THE ON/OFF/AUTO SUB-BASE IS SET TO "ON", BOTH THE 2-POSITION OUTDOOR AIR MOTOR-OPERATED DAMPERS AND THE 2-POSITION EXHAUST AIR MOTOR-OPERATED DAMPER SHALL OPEN, AFTER WHICH THE 2-SPEED EXHAUST FAN SHALL START AND RUN AT HIGH SPEED.

B. ELECTRICAL ROOM - VENTILATION (EF-2)

- WHEN THE ON/OFF/AUTO SUB-BASE IS SET TO "AUTO", UPON A RISE ABOVE SPACE TEMPERATURE SETPOINT (90 DEGREES F ADJUSTABLE) AS SENSED BY A 2-POSITION REVERSE ACTING THERMOSTAT AS SHOWN ON THE DRAWINGS, BOTH THE 2-POSITION OUTDOOR AIR MOTOR-OPERATED DAMPER AND THE 2-POSITION EXHAUST AIR MOTOR-OPERATED DAMPER SHALL OPEN, AFTER WHICH THE WALL-MOUNTED EXHAUST FAN SHALL START. UPON A DROP BELOW SETPOINT, THE REVERSE SHALL OCCUR.
- WHEN THE ON/OFF/AUTO SUB-BASE IS SET TO "OFF", THE WALL-MOUNTED EXHAUST FAN SHALL STOP, AFTER WHICH BOTH THE 2-POSITION OUTDOOR AIR MOTOR-OPERATED DAMPER AND THE 2-POSITION EXHAUST AIR MOTOR-OPERATED DAMPER SHALL CLOSE.
- WHEN THE ON/OFF/AUTO SUB-BASE IS SET TO "ON", BOTH THE 2-POSITION OUTDOOR AIR MOTOR-OPERATED DAMPER AND THE 2-POSITION EXHAUST AIR MOTOR-OPERATED DAMPER SHALL OPEN, AFTER WHICH THE WALL-MOUNTED EXHAUST FAN SHALL START.

C. STRIPPER ROOM - VENTILATION (EF-4)

CAUSTIC ROOM / POTASSIUM PERMANGANATE ROOMS (EF-3)

- EACH FAN SHALL BE CONTROLLED BY A SWITCH AS SHOWN ON THE DRAWINGS. SWITCH AND DAMPER MOTORS LOCATED IN STRIP ROOM SHALL HAVE NEMA 4X ENCLOSURES.
- WHEN FAN IS "ON", BOTH THE 2-POSITION OUTDOOR AIR MOTOR-OPERATED DAMPERS AND THE 2-POSITION EXHAUST AIR MOTOR-OPERATED DAMPER SHALL OPEN, AFTER WHICH THE WALL-MOUNTED EXHAUST FAN SHALL START. WHEN FAN IS "OFF", THE REVERSE SHALL OCCUR.

LEGEND

- Ⓣ THERMOSTAT
- Ⓢ MANUAL SWITCH
- Ⓜ MOTOR OPERATED DAMPER (MOD)
- HOA HAND-OFF AUTO THERMOSTAT (SUB-BASE)

NO.	DATE	BY	REVISIONS
2	MAY 2008	AS-BUILT DRAWING FILE	
1	10/31/08	ISSUED FOR RFI POSTED SET	
0	10/29/08	ISSUED FOR CONSTRUCTION	
8	8/16/08	ISSUED FOR REV. REVISION REVIEW	
7	7/22/08	ISSUED FOR REVISION REVIEW	

ROBERT H. SHELDON
No. 4103
PAWTUCKET, RHODE ISLAND
PAWTUCKET REGIONAL WATER TREATMENT FACILITY
PKGS 11 & 12 - RAW WATER PUMP STATION
HVAC SCHEDULES, DETAILS, CONTROL SEQUENCES, AND NOTES

PAWTUCKET, RHODE ISLAND
PAWTUCKET REGIONAL
WATER TREATMENT FACILITY
PKGS 11 & 12 - RAW WATER PUMP STATION
HVAC SCHEDULES, DETAILS, CONTROL SEQUENCES, AND NOTES

DESIGNED BY AG	DWG SCALE AS NOTED
DRAWN BY CA	CONTRACT NO.
CHECKED BY	DATE OCTOBER 31, 2008

**EARTH TECH
AS-BUILT FILE
MAY 2008**

H-3
SHEET OF

PLUMBING LEGEND

- PLUG VALVE
- BALL VALVE
- CHECK VALVE
- GATE VALVE
- PRESSURE REDUCING VALVE
- PIPE REDUCER
- SAFETY RELIEF VALVE
- PIPE DOWN
- PIPE UP
- STRAINER
- UNION
- WATER HAMMER ARRESTOR
- WATER METER ASSEMBLY
- VALVE IN RISER
- PIPE CAP

MISCELLANEOUS

- NEW WORK, EQUIPMENT (SHOWN DARK)
- NEW WORK PIPING (SHOWN DARK)
- NEW WORK, HIDDEN (AS SHOWN)
- NEW WORK BY OTHERS (SHOWN LIGHT)
- EXISTING WORK (SHOWN SCREENED)
- PRESSURE GAGE
- THERMOMETER

PIPELINE DESIGNATIONS

- BURIED VENT PIPING
- BURIED PIPING EXCEPT VENT PIPING
- COLD WATER
- HOT WATER
- TEMPERED WATER
- SANITARY VENT
- SANITARY ABOVE GROUND

STANDARD KEY

- MOTORIZED EQUIPMENT EQUIPMENT NUMBER
- NON-MOTORIZED EQUIPMENT EQUIPMENT NUMBER

PLUMBING ABBREVIATIONS

- AFF ABOVE FINISHED FLOOR
- AFG ABOVE FINISHED GRADE
- CO CLEANOUT
- CONN CONNECTION
- CW COLD WATER
- D DRAIN
- EWL ELECTRIC WATER HEATER
- EWT ENTERING WATER TEMPERATURE
- FCO FLOOR CLEANOUT
- FD FLOOR DRAIN
- GAL GALLONS
- GPH GALLONS PER HOUR
- HP HORSEPOWER
- HW HOT WATER
- HWR HOT WATER RETURN
- ID INDIRECT WASTE, INSIDE DIMENSIONS
- IN. WG. INCHES WATER GAGE
- LWT LEAVING WATER TEMPERATURE
- MAX MAXIMUM
- MBH THOUSAND BRITISH THERMAL UNITS PER HOUR
- MIN MINIMUM
- NP NON-POTABLE
- OD OUTSIDE DIMENSIONS
- PSIG POUNDS PER SQUARE INCH GAUGE
- RD ROOF DRAIN
- RL RAIN LEADER
- RPBFP REDUCED PRESSURE BACKFLOW PREVENTER
- S SOIL
- SAN SANITARY
- SPD SUMP PUMP DISCHARGE
- ST STORM
- TW TEMPERED WATER
- V VENT
- VTR VENT THROUGH ROOF
- W WASTE
- WHA WATER HAMMER ARRESTOR

GENERAL NOTES

1. THE DRAWINGS ARE DIAGRAMMATIC ONLY TO SHOW THE SCOPE OF THE WORK INVOLVED. ANY WORK INSTALLED CONTRARY TO OR WITHOUT APPROVAL SHALL BE SUBJECT TO CHANGE. NO EXTRA COMPENSATION WILL BE ALLOWED. DO NOT SCALE DRAWINGS FOR FABRICATION PURPOSES.
2. PERFORM ALL WORK IN STRICT ACCORDANCE WITH LAWS, REGULATIONS, AND STANDARDS OF LOCAL, STATE AND FEDERAL GOVERNMENTS.
3. GIVE ALL NOTICES, FILE PLANS, OBTAIN PERMITS AND LICENSES, PAY FEES AND BACK CHARGES, AND OBTAIN NECESSARY APPROVALS FROM AUTHORITIES HAVING JURISDICTION AS REQUIRED TO PERFORM WORK.
4. COOPERATE AND COORDINATE WITH OTHER TRADES IN EXECUTING THE WORK. PERFORM WORK SO THAT PROGRESS OF ENTIRE PROJECT SHALL NOT BE DELAYED. PROVIDE INFORMATION TO OTHER TRADES, AS REQUESTED. OBTAIN FINAL ROUGHING DIMENSIONS AS REQUIRED TO COMPLETE WORK.
5. PERFORM WORK REQUIRED SO AS TO PROVIDE PROPER ACCESS TO MATERIAL AND EQUIPMENT REQUIRING INSPECTION, MAINTENANCE OR SERVICE.
6. PIPING AND EQUIPMENT LAYOUT SHOWN IS DIAGRAMMATIC, LOCATION SHALL BE DETERMINED IN FIELD.
7. SUBMIT SHOP DRAWINGS AND PRODUCT INFORMATION. NO WORK SHALL PROCEED WITHOUT WRITTEN APPROVAL ON EACH ITEM SCHEDULED, SPECIFIED OR SHOWN ON PLAN.
8. ALL EQUIPMENT SHALL BE AS SHOWN ON EQUIPMENT SCHEDULES.

PLUMBING NOTES

1. PIPING AND ACCESSORIES
 - A. PIPING SHALL FOLLOW THE GENERAL ROUTING, INDICATED ON DRAWINGS. COORDINATE LOCATION WITH ALL OTHER PIPING, DUCTWORK, AND EQUIPMENT.
 - B. PROVIDE UNIONS IN CONNECTIONS TO EQUIPMENT REQUIRING REMOVAL FOR REPAIRS AND/OR REPLACEMENT. LOCATE BETWEEN SHUTOFF VALVES AND EQUIPMENT.
 - C. ALL SHUT-OFF VALVES AND WATER HAMMER ARRESTORS SHALL BE INSTALLED IN ACCESSIBLE LOCATIONS.
 - D. PROVIDE PROPER DRAINAGE FOR ALL PIPING SYSTEMS.
 - E. PROVIDE SEISMIC RESTRAINTS FOR PIPING AND EQUIPMENT WHERE REQUIRED BY THE BUILDING CODE.
 - F. MAINTAIN MAXIMUM HEADROOM. UNLESS OTHERWISE INDICATED, RUN ALL PRESSURIZED OVERHEAD HORIZONTAL PIPING MAXIMUM 12" BELOW THE OVERHEAD BUILDING STRUCTURE. RUN ALL GRAVITY OVERHEAD HORIZONTAL PIPING AS TIGHT TO OVERHEAD BUILDING STRUCTURE AS POSSIBLE WHILE MAINTAINING REQUIRED PITCH. OVERHEAD BUILDING STRUCTURE SHALL MEAN THE MINIMUM ELEVATION OF UNDERSIDE OF STRUCTURAL BEAMS WHERE RUNNING PERPENDICULAR TO BEAMS, OR THE CEILING BELOW STRUCTURAL ELEMENTS IN ALL OTHER CASES. (EG. CONCRETE SLAB)
 - G. PROVIDE APPROVED FIRE STOP MATERIAL WHERE PIPING PENETRATES FIRE RATED WALLS.
 - H. INSTALL WATER HAMMER ARRESTORS (WHA) PER PDI REQUIREMENTS WHERE INDICATED ON DRAWINGS.
 - I. NO PORTION OF THE SANITARY DRAIN-WASTE-VENT SYSTEM INSTALLED UNDERGROUND SHALL BE LESS THAN TWO INCHES IN DIAMETER.
 - J. FLOOR DRAIN OUTLET PIPES SHALL BE THE SAME SIZE AS ATTACHED SERVICE.
 - K. SANITARY PLUMBING VENTS THROUGH ROOF SHALL BE TERMINATED MINIMUM 12 INCHES ABOVE ROOF.
 - L. RUN ALL BURIED PIPING BENEATH, NOT IN, CONCRETE FLOOR SLABS.
 - M. PROVIDE THERMOMETERS ON OUTLETS OF ALL MIXING VALVES.
2. INSULATION
 - A. INSULATE ALL DOMESTIC COLD WATER AND DOMESTIC HOT WATER PIPING. DO NOT INSULATE EMERGENCY SHOWER/EYE WASH TEMPERED WATER PIPING.
3. ELECTRICAL ENCLOSURES
 - A. ALL ENCLOSURES SHALL BE NEMA TYPE 1 UNLESS OTHERWISE INDICATED. "ENCLOSURES" SHALL MEAN ELECTRICAL EQUIPMENT ENCLOSURES AND ASSOCIATED CONDUIT.

FULL SIZE DRAWING = 4"		DATE
2	AS-BUILT DRAWING FILE	MAY 2008
1	ISSUED FOR PER POSTED SET	10/01/05
0	ISSUED FOR CONSTRUCTION	10/28/05
6	ISSUED FOR RFI/RESPONSE REVIEW	8/16/05
8	ISSUED FOR RFI/RESPONSE REVIEW	7/22/05
NO.	REVISONS	BY

ROBERT H. SHELDON
No. 4103
REG. PROFESSIONAL ENGINEER
MASSACHUSETTS


PAWTUCKET, RHODE ISLAND
**PAWTUCKET REGIONAL
WATER TREATMENT FACILITY**
PKGS 11 & 12 - RAW WATER PUMP STATION
PLUMBING LEGENDS, ABBREVIATIONS, AND GENERAL NOTES

DESIGNED BY CVA	DWG SCALE AS NOTED
DRAWN BY CVA	CONTRACT NO.
CHECKED BY AG	DATE OCTOBER 31, 2008


EARTH TECH
AS-BUILT FILE
MAY 2008

PLOT FILE UNDER C:\PROGRAMS\STEP\2008\111208.PWG

Filename: L:\WORK\69993\CAD\AS-BUILT\11-12 RWTF\PLUMB\69993-RWFS-P-2.DWG
 Plot File Date Created: Sep/22/2008 11:34 AM

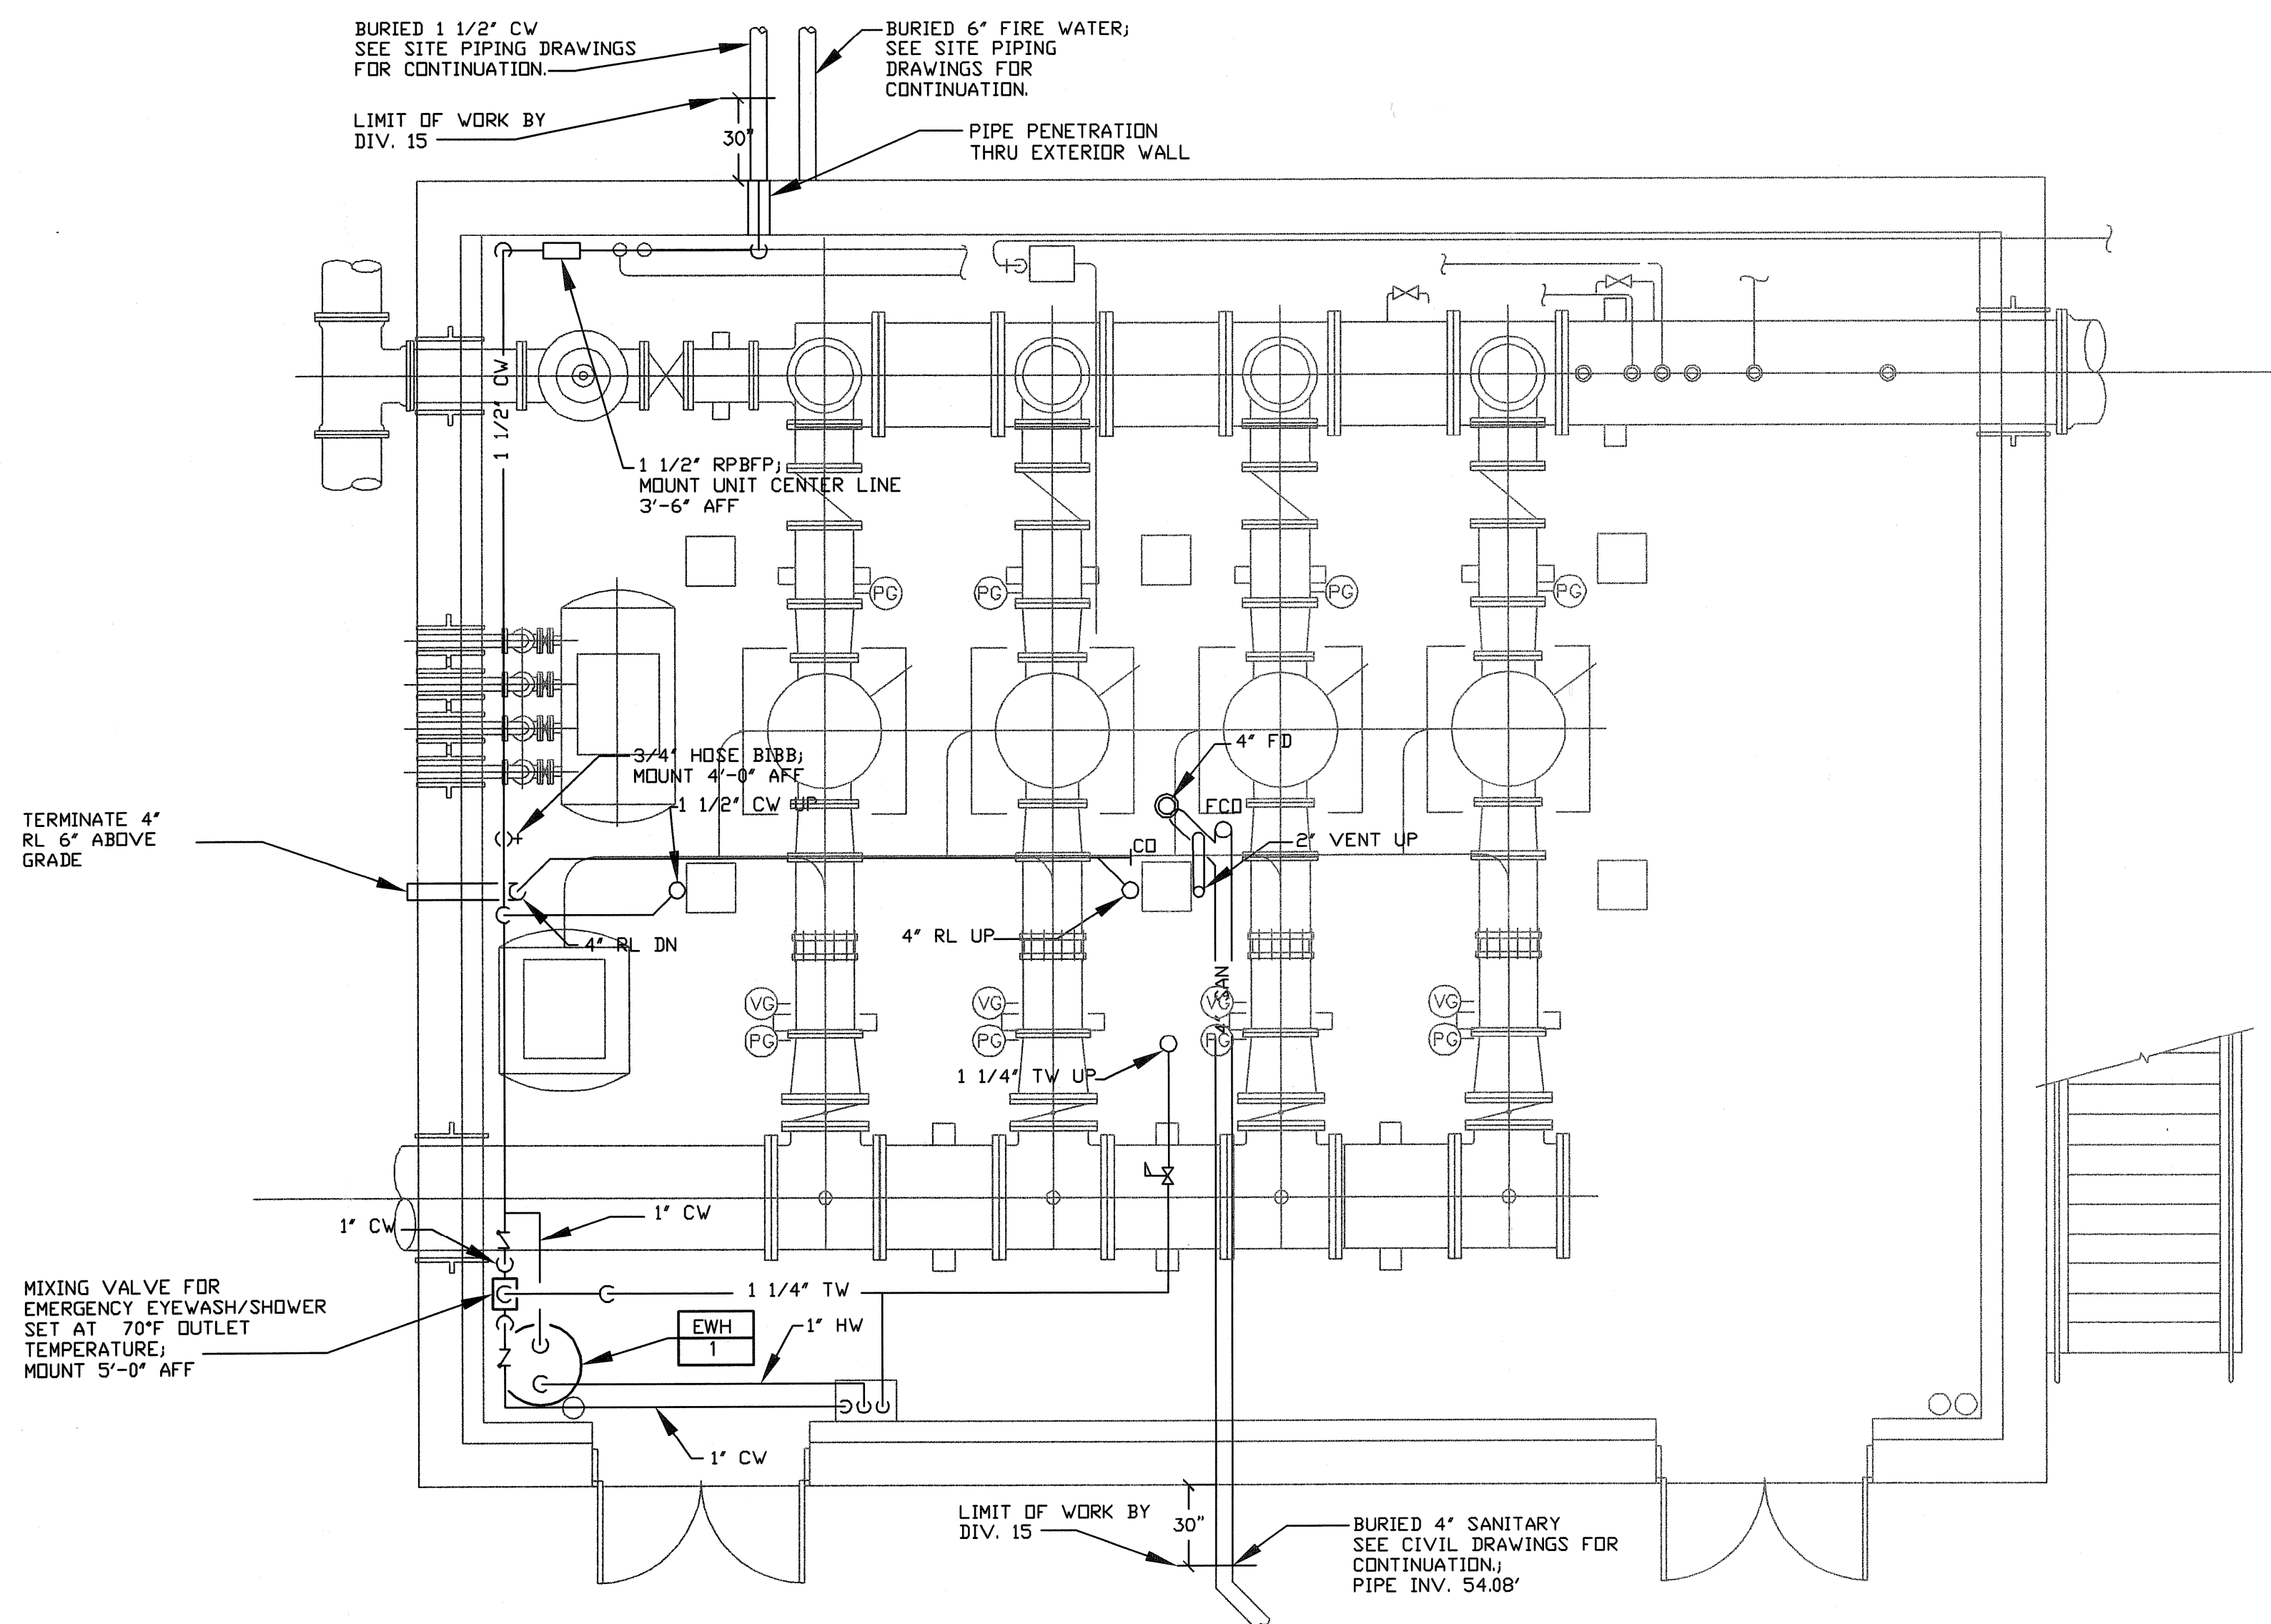

PUMP LEVEL FLOOR PLAN - EL. 59.00'
 SCALE: 1/4" = 1'-0"

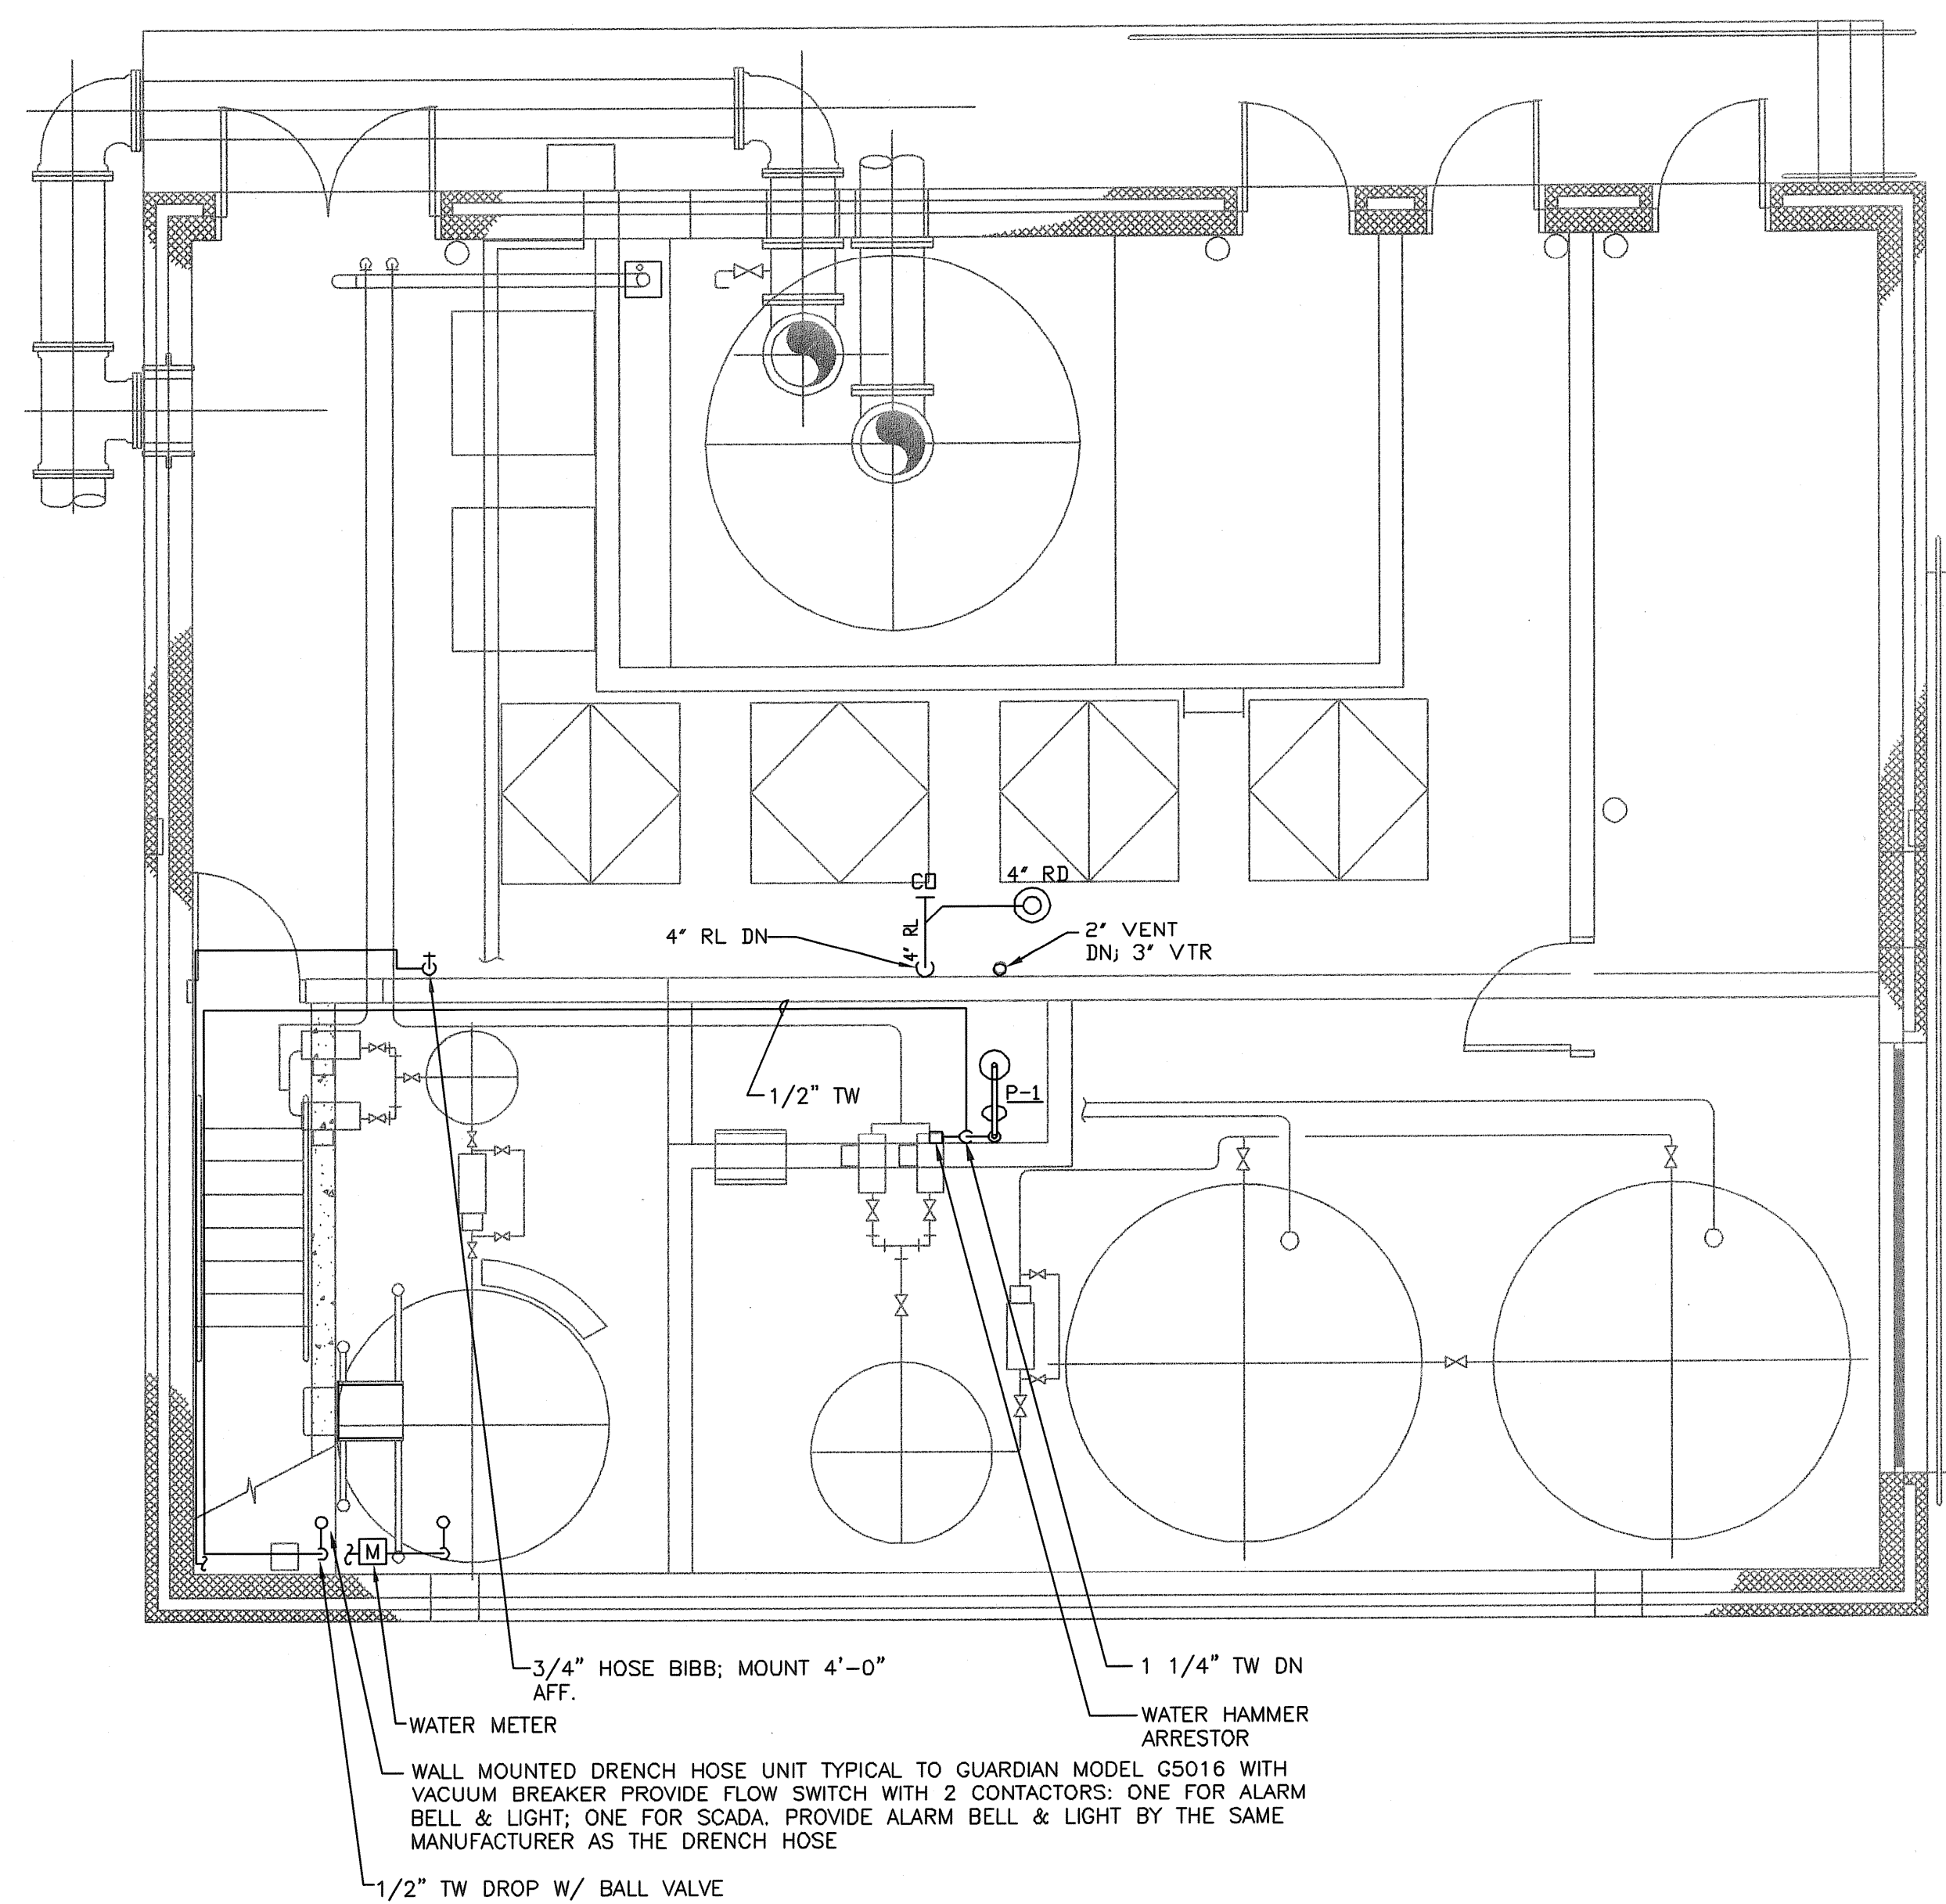

GROUND LEVEL FLOOR PLAN - EL. 79.00'
 SCALE: 1/4" = 1'-0"


NO.	REV.	DATE	REVISIONS
2	AS-BUILT DRAWING FILE	MAY 2008	
1	ISSUED FOR RFI POSTED SET	10/31/08	
0	ISSUED FOR CONSTRUCTION	10/29/05	
0	ISSUED FOR CONSTRUCTION REVIEW	8/16/05	
0	ISSUED FOR CONSTRUCTION REVIEW	7/22/05	

ROBERT H. SHELDON
 No. 4103


PAWTUCKET, RHODE ISLAND
PAWTUCKET REGIONAL WATER TREATMENT FACILITY
PKGS 11 & 12 - RAW WATER PUMP STATION
 PLUMBING PLANS

DESIGNED BY CVA	DWG SCALE AS NOTED
DRAWN BY CVA	CONTRACT NO.
CHECKED BY AG	DATE OCTOBER 31, 2008


EARTH TECH
 AS-BUILT FILE
 MAY 2008

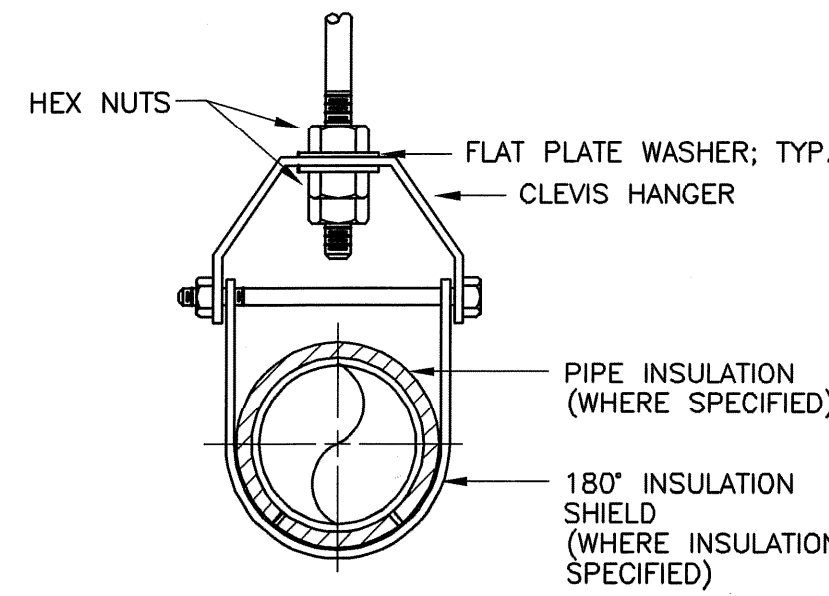

TYPICAL PIPE SUPPORT DETAIL
NOT TO SCALE

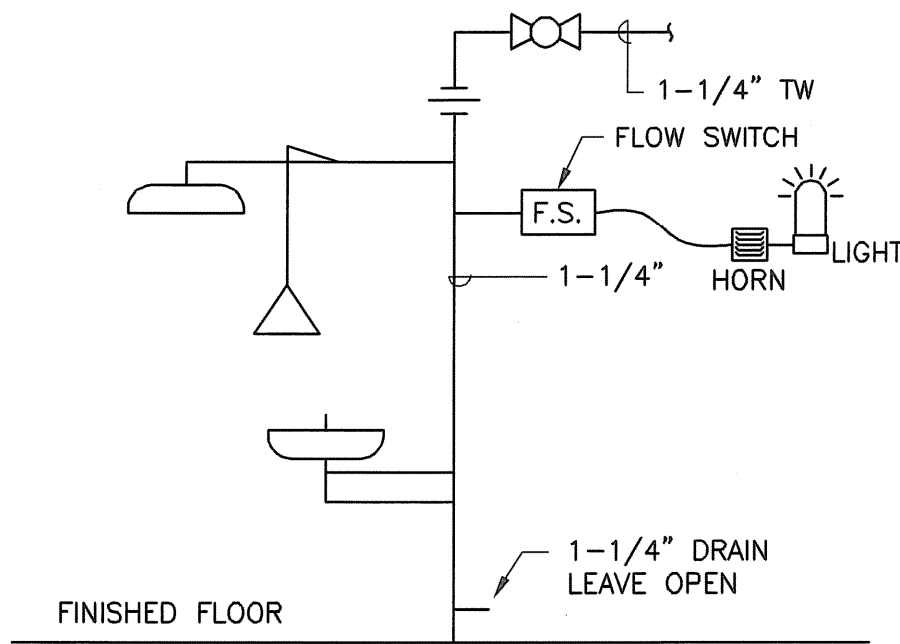

EMERGENCY EYEWASH/SHOWER PIPING DETAIL
NOT TO SCALE

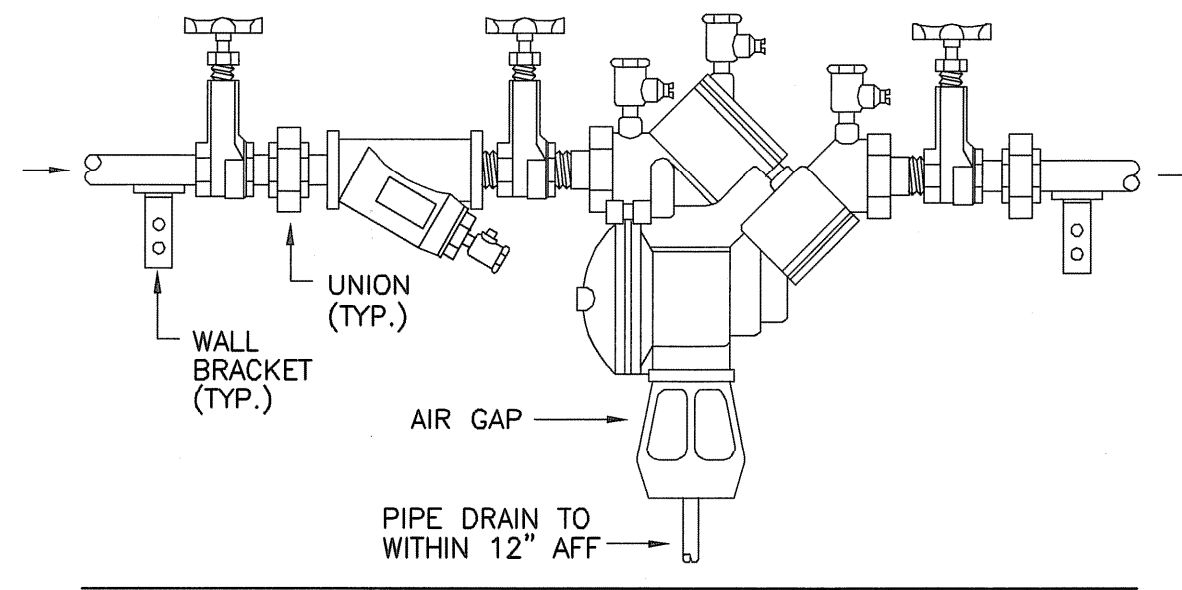


REDUCED PRESSURE BACKFLOW PREVENTER DETAIL
NOT TO SCALE

ELECTRIC WATER HEATER SCHEDULE										
TAG NO.	MANUFACTURER AND MODEL NO.	AREA SERVED	TANK STORAGE (GAL.)	HEATING ELEMENT				RECOVERY RATE (GPH) AT 100° F RISE	TEMP SETTING (° F)	REMARKS
				QTY	WATTS	VOLTS	PHASE			
EWH-1	RHEEM ELD120	RWPS - GROUND FLOOR	120	2	4500	460	3	18	140	(1) (2)


- (1) NON-SIMULTANEOUS WIRING
- (2) HEAT TRAP FITTINGS

PLUMBING FIXTURE SCHEDULE								
FIXTURE NO.	FIXTURE	MODEL	DRAIN/WASTE	COLD WATER	HOT WATER	TEMPERED WATER	VENT	REMARKS
P-1	EMERGENCY EYEWASH/SHOWER	-	-	-	-	1 1/4"	-	(1) (2)

- (1) 20 GPM CONTROL VALVE
- (2) FLOW ALARM CONTROL PACKAGE

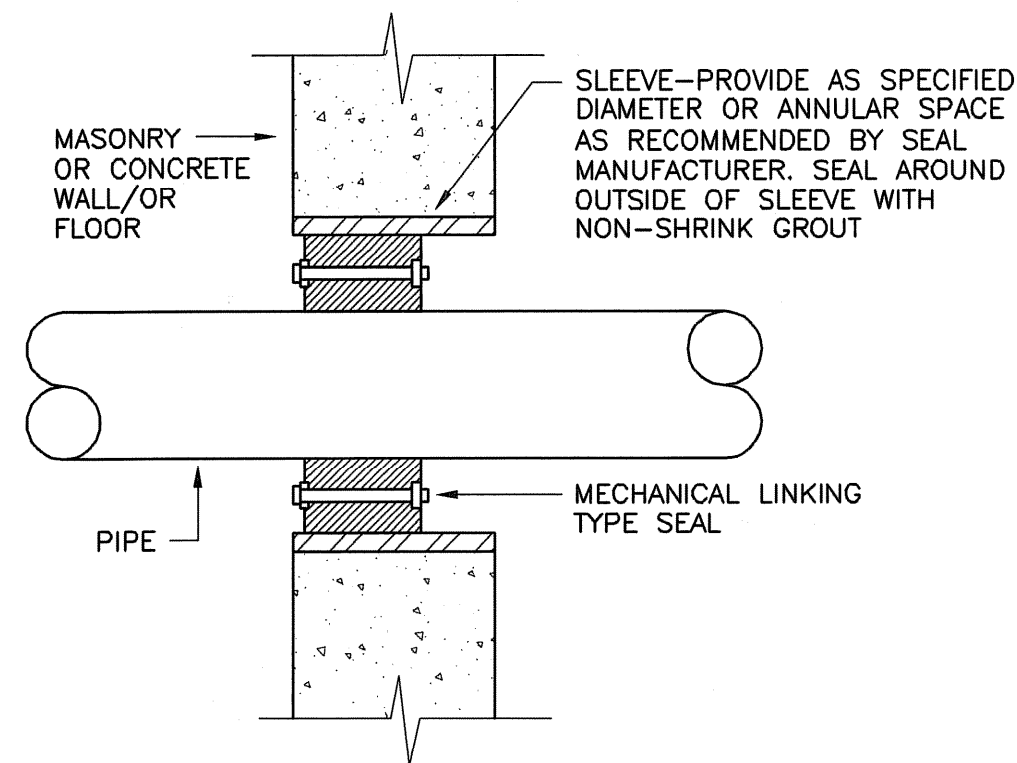


PIPE PENETRATION THROUGH EXTERIOR WALL DETAIL
NOT TO SCALE

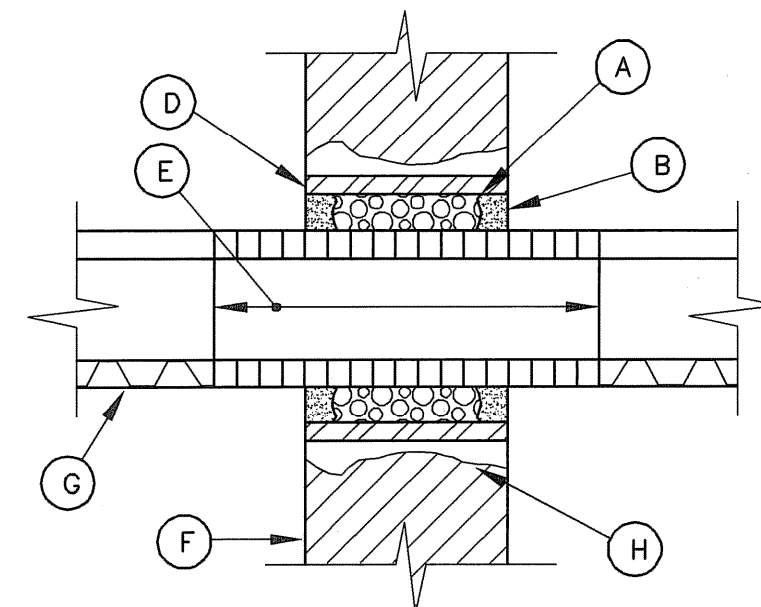


PIPE PENETRATION THROUGH INTERIOR WALL/FLOOR DETAIL
NOT TO SCALE

- (A) PROVIDE 1/4" CLEARANCE BETWEEN PIPE SLEEVE OR CORE DRILLED HOLE AND PIPE. PACK CLEARANCE SPACE WITH SPECIFIED INSULATION
- (B) PROVIDE SPECIFIED END SEALANT
- (C) NOT USED
- (D) SLEEVE-PROVIDE AS SPECIFIED. SLEEVE MAY BE OMITTED AND CORE DRILLED HOLE PROVIDED IN CONCRETE AS SPECIFIED. EXTEND FLOOR PIPE SLEEVES 2" ABOVE FLOOR.
- (E) CALCIUM SILICATE OR APPROVED EQUAL INSULATION THRU PENETRATION AND EXTENDED 2" ON BOTH SIDES OF WALL OR FLOOR; PROVIDE METAL JACKET AS SPECIFIED OVER INSULATION
- (F) WALL OR FLOOR
- (G) SPECIFIED INSULATION
- (H) GROUT SPACE BETWEEN SLEEVE AND MASONRY OR CONCRETE WALLS AND FLOORS

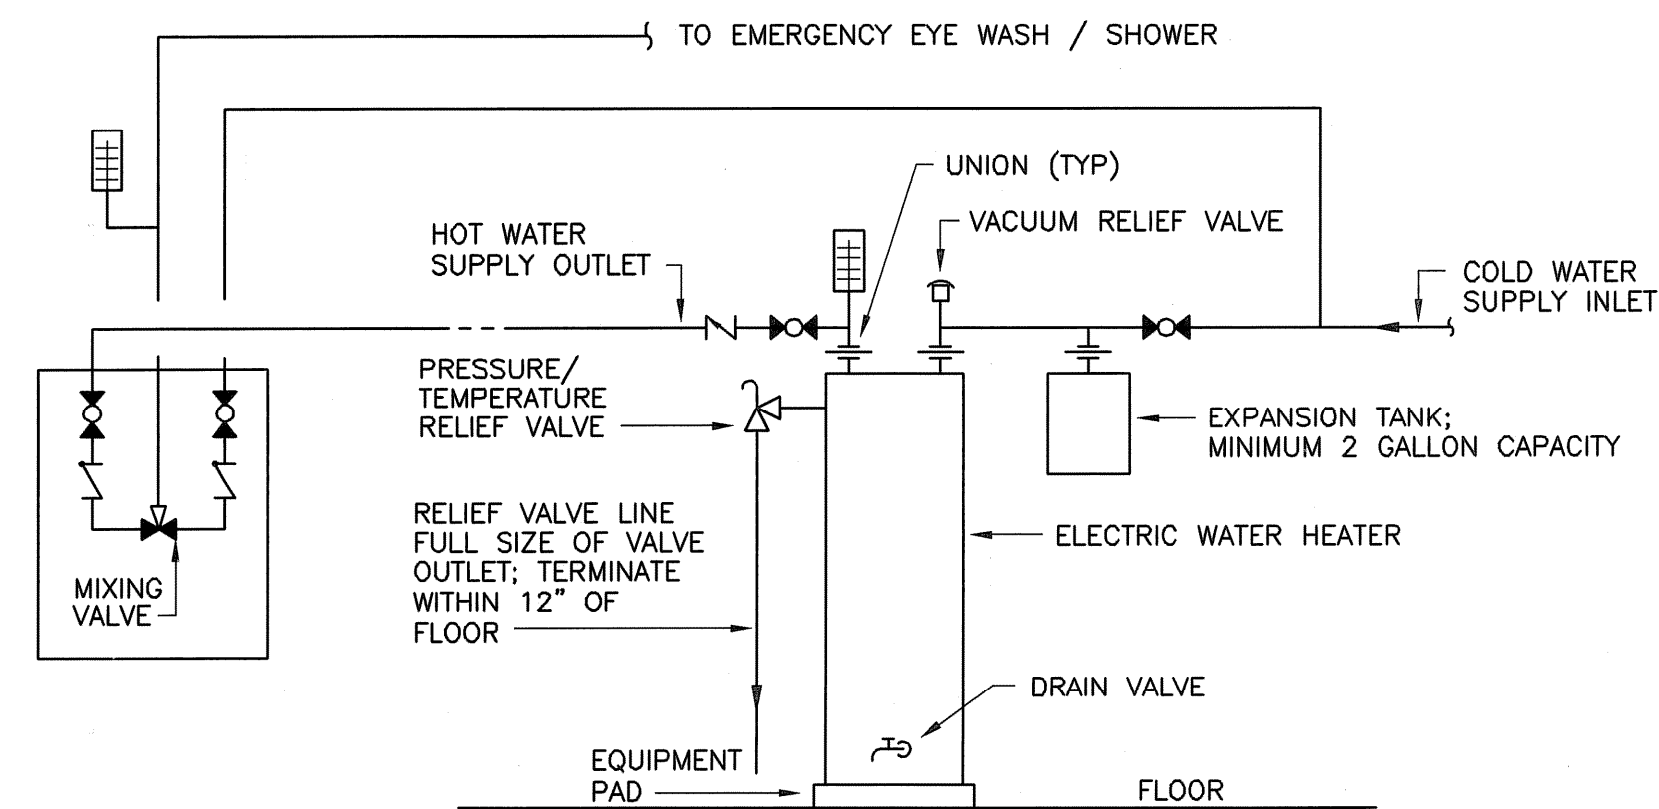


ELECTRIC WATER HEATER DETAIL
NOT TO SCALE

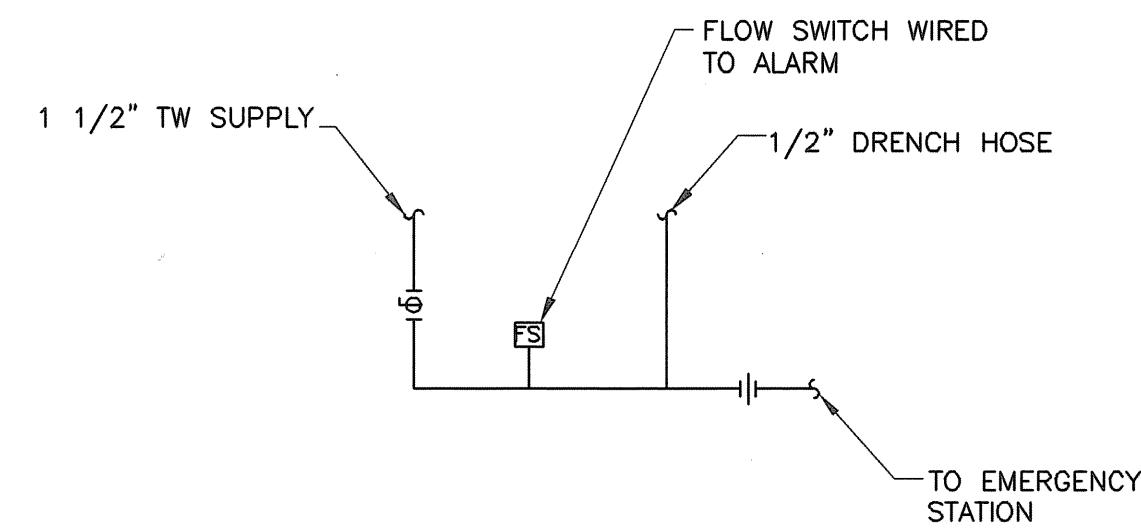

EMERGENCY STATION SCHEMATIC PIPING DETAIL
NOT TO SCALE

NO.	DATE	BY	REVISIONS
2	MAY 2006		AS-BUILT DRAWING FILE
1	10/21/05		ISSUED FOR SET POSTED SET
0	10/28/05		ISSUED FOR CONSTRUCTION
4	8/16/05		ISSUED FOR REVIEW
3	7/22/05		ISSUED FOR CONSTRUCTION REVIEW

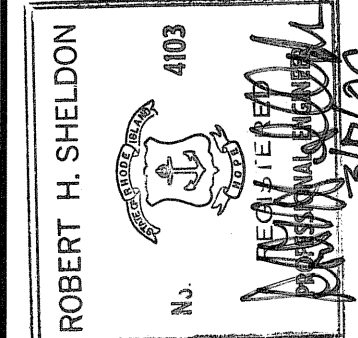

PAWTUCKET, RHODE ISLAND
PAWTUCKET REGIONAL WATER TREATMENT FACILITY
PKGS 11 & 12 - RAW WATER PUMP STATION
PLUMBING SCHEDULES AND DETAILS


DESIGNED BY	DWG SCALE AS NOTED
DRAWN BY	CONTRACT NO
CHECKED BY	DATE
AS	OCTOBER 31, 2006

EARTH TECH
AS-BUILT FILE
MAY 2006

P-3

SHEET OF

FIRE PROTECTION LEGEND

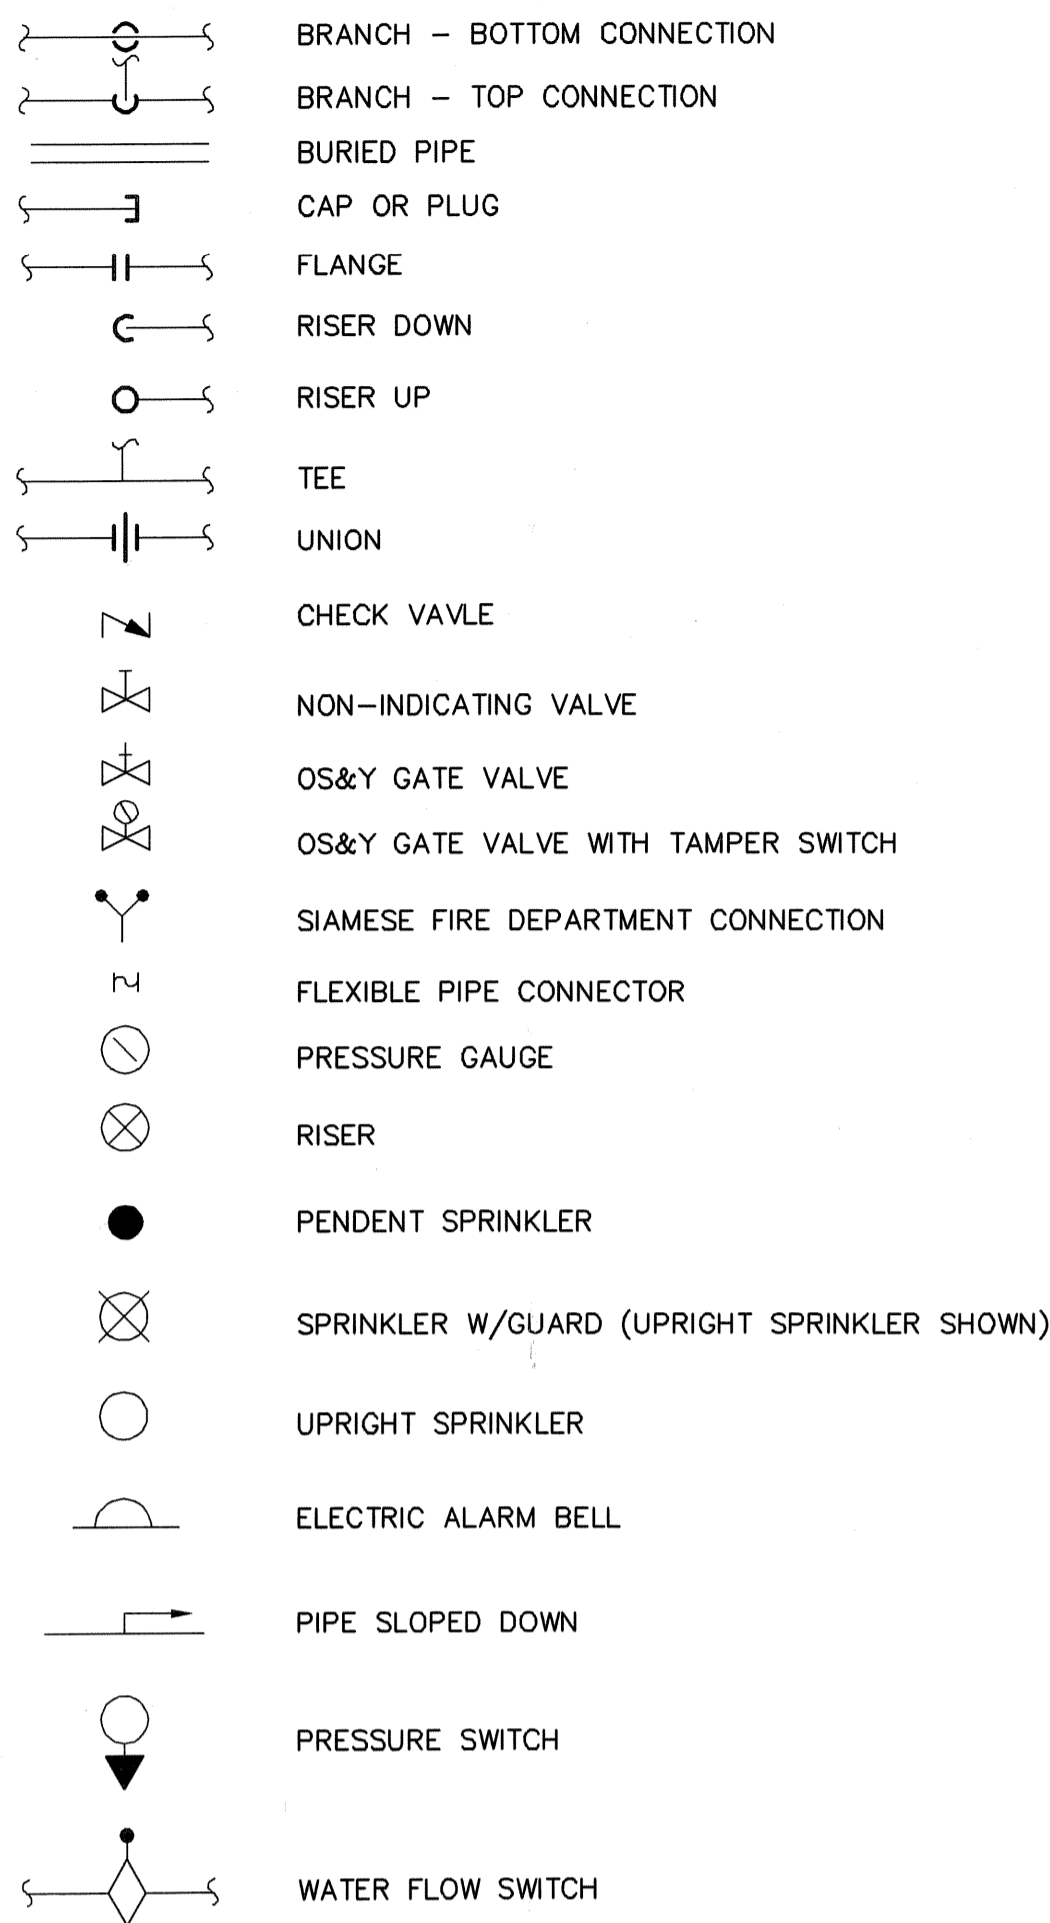

ABBREVIATIONS


ACV	ALARM CHECK VALVE
AFF	ABOVE FINISHED FLOOR
AFG	ABOVE FINISHED GRADE
ATC	ACOUSTICAL TILE CEILING
CL	CENTER LINE
DCBFP	DOUBLE CHECK BACKFLOW PREVENTER
DN	DOWN
FACP	FIRE ALARM CONTROL PANEL
FDC	FIRE DEPARTMENT CONNECTION
FS	FLOW SWITCH
MIN	MINIMUM
PIV	POST INDICATING VALVE
SQ.FT.	SQUARE FEET
TYP.	TYPICAL

GENERAL NOTES


- THE SPRINKLER CONTRACTOR SHALL PRODUCE A COMPLETE SET OF WORKING FIRE PROTECTION DRAWINGS IN ACCORDANCE WITH THE RHODE ISLAND FIRE SAFETY CODE AND NFPA 13. THE SYSTEM SHALL BE HYDRAULICALLY CALCULATED PER THE DESIGN CRITERIA PROVIDED AND REQUIRED. ALL DRAWINGS AND CALCULATIONS SHALL BE STAMPED AND SIGNED BY THE CONTRACTOR'S REGISTERED FIRE PROTECTION ENGINEER AND SHALL BE SUBMITTED TO THE LOCAL FIRE DEPARTMENT FOR APPROVAL AND PERMIT PRIOR TO THE COMMENCEMENT OF ANY SPRINKLER WORK. PLANS AND HYDRAULIC CALCULATIONS AS DESCRIBED ABOVE SHALL ALSO BE SUBMITTED TO THE OWNER FOR APPROVAL PRIOR TO THE COMMENCEMENT OF ANY SPRINKLER WORK.
- HAZARD OCCUPANCIES IN THIS STRUCTURE ARE NOT TO EXCEED THOSE INDICATED ON THE DRAWINGS. A FIRE PROTECTION AND HYDRAULIC ANALYSIS INDICATING THE ACCEPTABILITY OF THE FIRE PROTECTION SYSTEM(S), AND ASSOCIATED SYSTEMS TO ADEQUATELY SERVE THE PROPOSED HAZARD MUST BE CONDUCTED BY A LICENSED FIRE PROTECTION ENGINEER PRIOR TO OCCUPANCY CHANGES OF A GREATER HAZARD.
- THE OWNER IS TO PROVIDE HEAT AS REQUIRED THROUGHOUT THE BUILDING TO PREVENT WATER IN THE SYSTEM FROM FREEZING. THE OWNER IS ALSO TO MAINTAIN THE SYSTEM IN ACCORDANCE WITH THE REQUIREMENTS OF THE RHODE ISLAND FIRE SAFETY CODE.
- THE DRAWINGS ARE NOT INTENDED TO SHOW SPRINKLER HEAD LOCATIONS, NUMBER OF SPRINKLER HEADS, OR THE ROUTING OF PIPING. THIS SHALL BE THE RESPONSIBILITY OF THE SPRINKLER CONTRACTOR. THE SPRINKLER CONTRACTOR SHALL COORDINATE WITH THE ARCHITECTURAL DRAWINGS.
- THE DESIGN AREAS AND DENSITIES INDICATED ON THE DRAWINGS ARE FOR REFERENCE ONLY. THE SPRINKLER CONTRACTOR SHALL BE RESPONSIBLE FOR DETERMINING ALL DESIGN AREAS AND DENSITIES IN STRICT ACCORDANCE WITH NFPA 13.
- THE SPRINKLER CONTRACTOR SHALL PERFORM A HYDRANT FLOW TEST TO OBTAIN CURRENT FLOW AND PRESSURE DATA. THE SPRINKLER CONTRACTOR SHALL USE HIS OBTAINED FLOW AND PRESSURE DATA TO PERFORM HIS HYDRAULIC CALCULATIONS FOR THE SPRINKLER SYSTEM DESIGN. THE HYDRANT FLOW TEST SHALL BE PERFORMED IN ACCORDANCE WITH NFPA 291. THE SPRINKLER CONTRACTOR SHALL PERFORM ALL COORDINATION WITH THE LOCAL WATER AUTHORITIES IN ORDER TO PERFORM THE HYDRANT FLOW TEST. THE SPRINKLER CONTRACTOR SHALL REVIEW THE SYSTEM REQUIREMENTS AND MAKE PROVISIONS FOR A FIRE PUMP IF REQUIRED.
- MAINTAIN MAXIMUM HEADROOM FOR ALL NEW PIPING.
- FLUSH ALL NEW SPRINKLER PIPING IN ACCORDANCE WITH FACTORY MUTUAL LOSS PREVENTION DATA SHEET 2-81, SPRINKLER SYSTEM MAINTENANCE, SECTION 9.5 USING THE HYDRAULIC METHOD. USE THE FIRE WATER SERVICE FOR THE SOURCE OF WATER. FLUSH BEFORE SPRINKLER HEADS ARE INSTALLED. FLUSH UNTIL WATER RUNS CLEAN. DISCHARGE USED WATER TO SANITARY SEWER.
- PROVIDE FIRE WATCH AND ALL OTHER SAFEGUARDING IN ACCORDANCE WITH NFPA 241 AND OWNER PROCEDURES.
- SPRINKLER HEADS SHALL BE UL LISTED AND FM APPROVED FOR THE INSTALLATION APPLICATION AND CONFIGURATION SPECIFIC TO THIS PROJECT AND SHALL BE INSTALLED IN ACCORDANCE WITH THE MANUFACTURER'S INSTRUCTIONS. POSITION ALL NEW HEADS IN ACCORDANCE WITH NFPA 13, UL, FM AND THE MANUFACTURER'S INSTRUCTIONS. ALL HEADS SHALL BE OF THE SAME MANUFACTURER.
- ENCLOSURE FOR ELECTRICAL COMPONENTS SHALL BE NEMA TYPE 1 SO LOCATED WHERE INDICATED ON THE DRAWINGS.

DESIGN CRITERIA


- PROVIDE WET PIPE SPRINKLER SYSTEM THROUGHOUT BUILDING EXCEPT IN ELECTRICAL ROOM. ELECTRICAL ROOM SHALL NOT BE SPRINKLED.
- PROVIDE HYDRAULIC CALCULATIONS AS SPECIFIED. HYDRAULIC CALCULATIONS SHALL INCORPORATE A MINIMUM 10 PSI CUSHION AT DESIGN CONDITIONS TO ALLOW FOR FUTURE DEGRADATION OF THE SYSTEMS.
- HAZARD OCCUPANCIES: 0.14 GPM/SQ.FT. OVER MOST REMOTE 2000 SQ.FT.

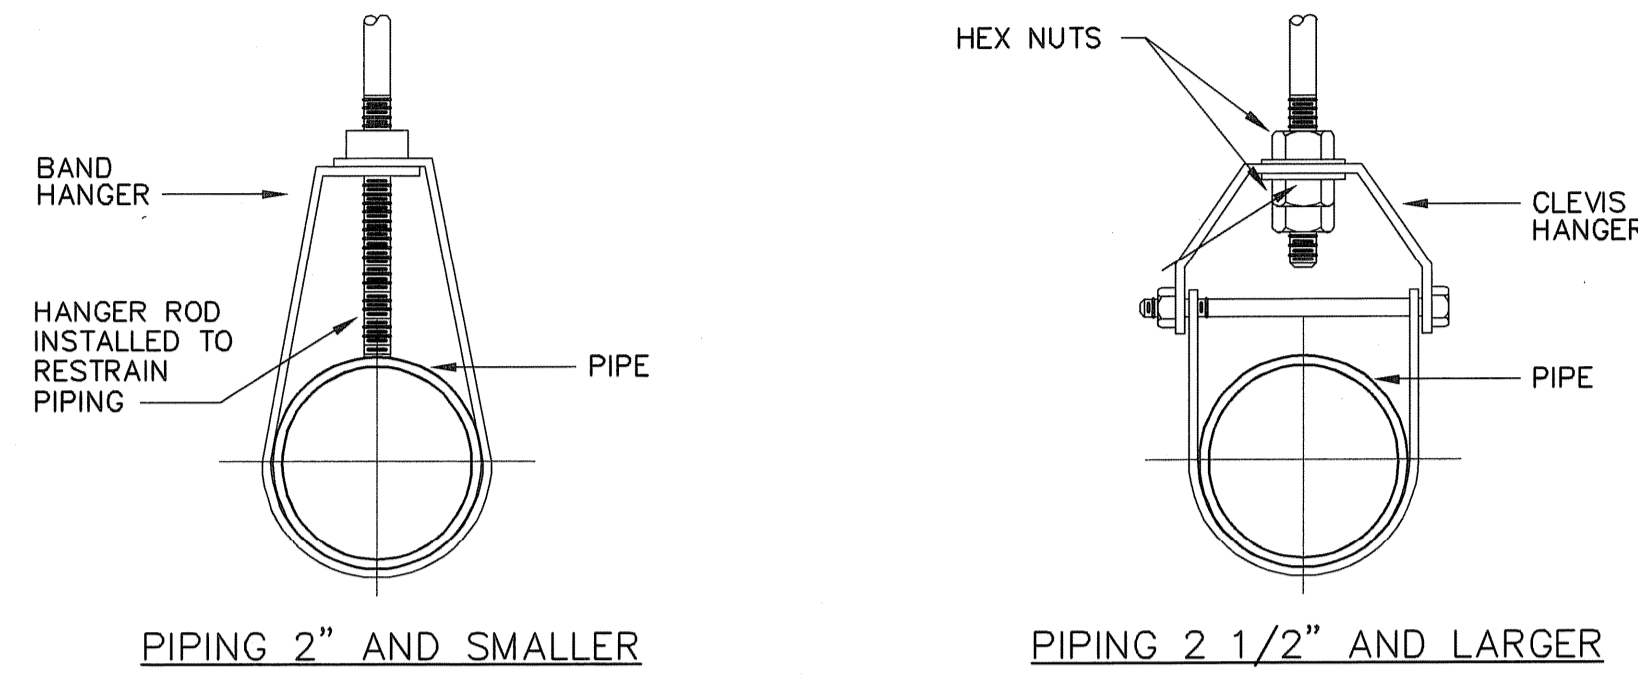


TYPICAL PIPE SUPPORT DETAILS
NOT TO SCALE

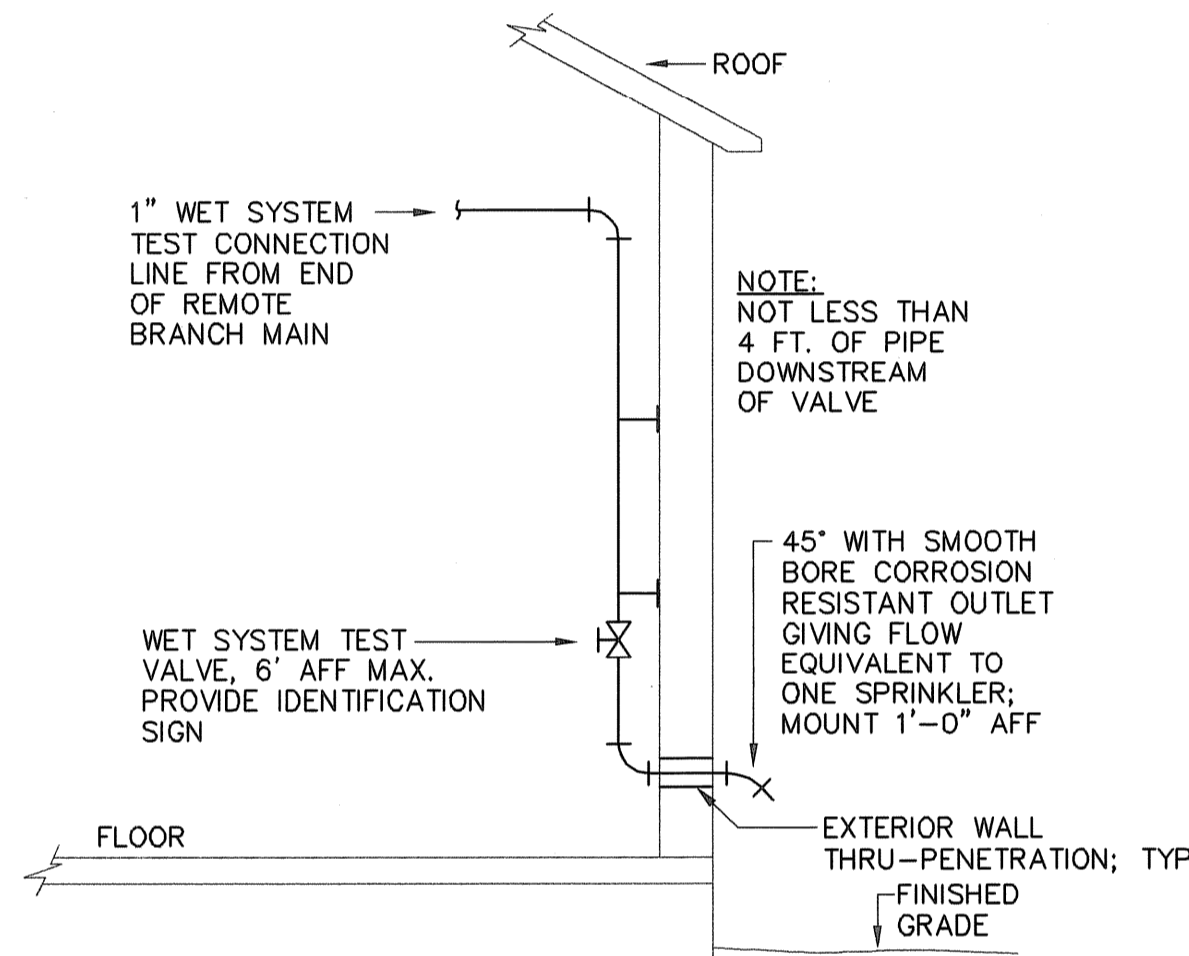


INSPECTOR'S TEST CONNECTION (WET PIPE) DETAIL
NOT TO SCALE

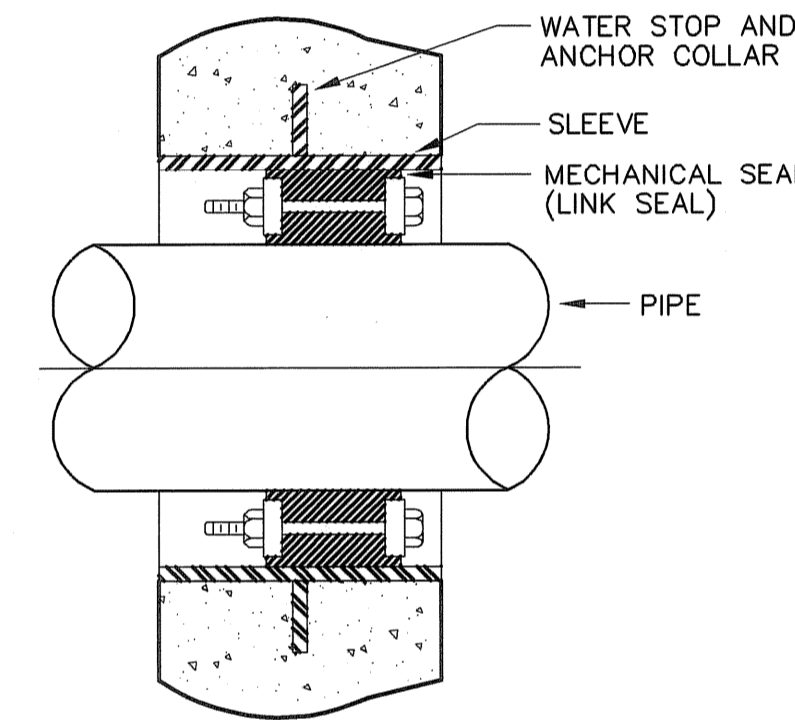


EXTERIOR WALL THRU-PENETRATION DETAIL
NOT TO SCALE

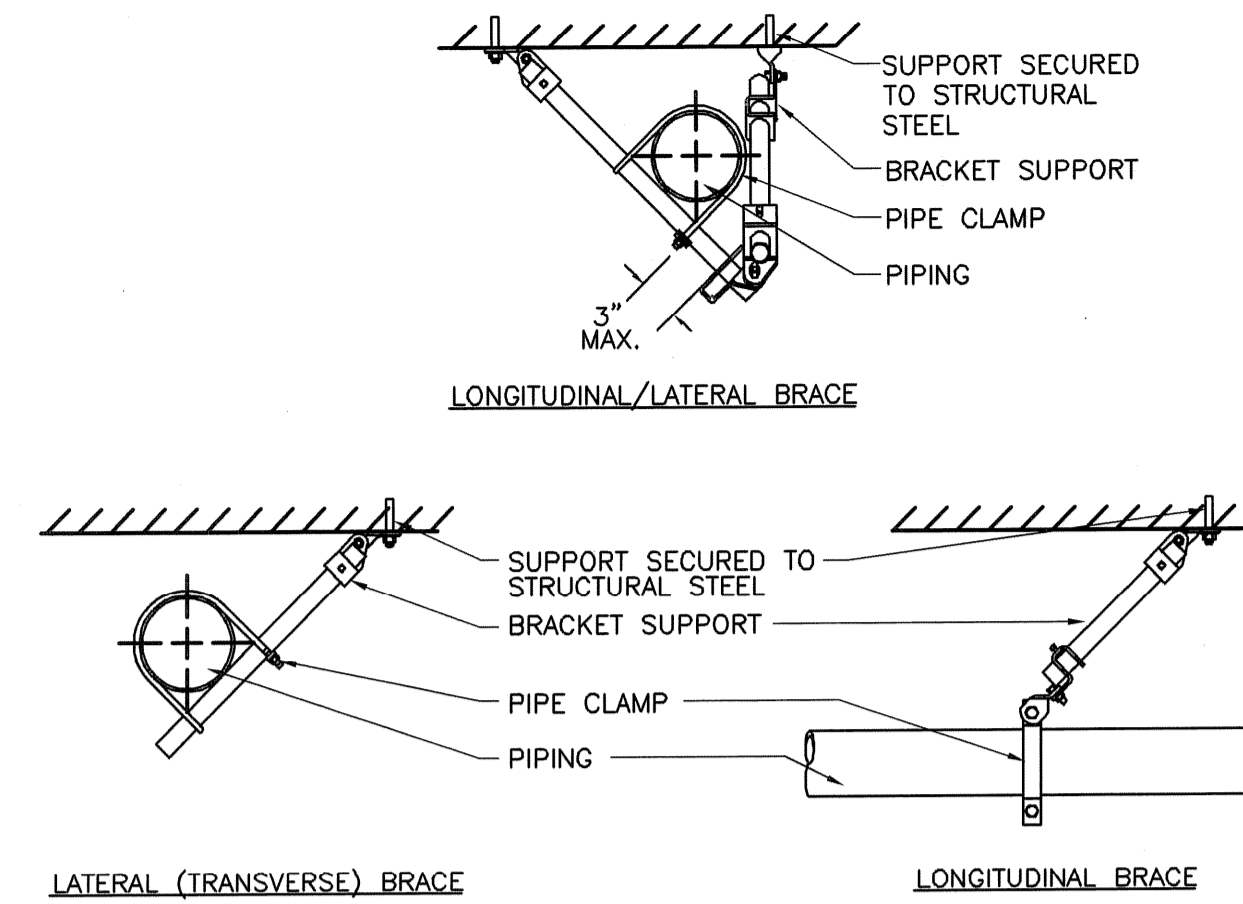


SEISMIC PIPE BRACING DETAILS
NOT TO SCALE

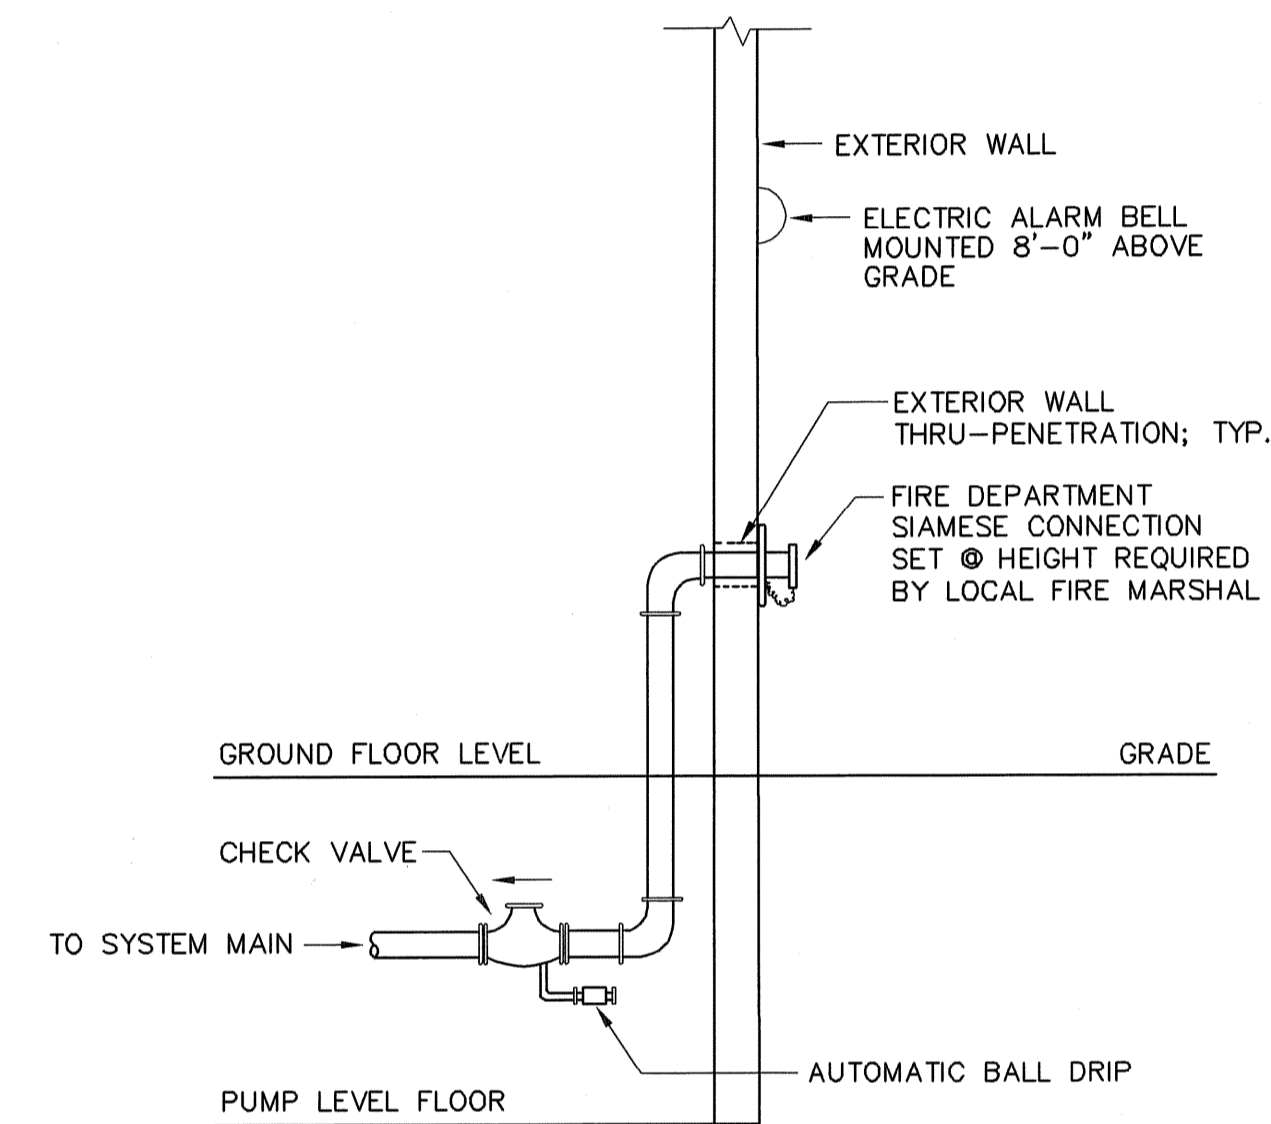

FIRE DEPARTMENT CONNECTION DETAIL
NOT TO SCALE

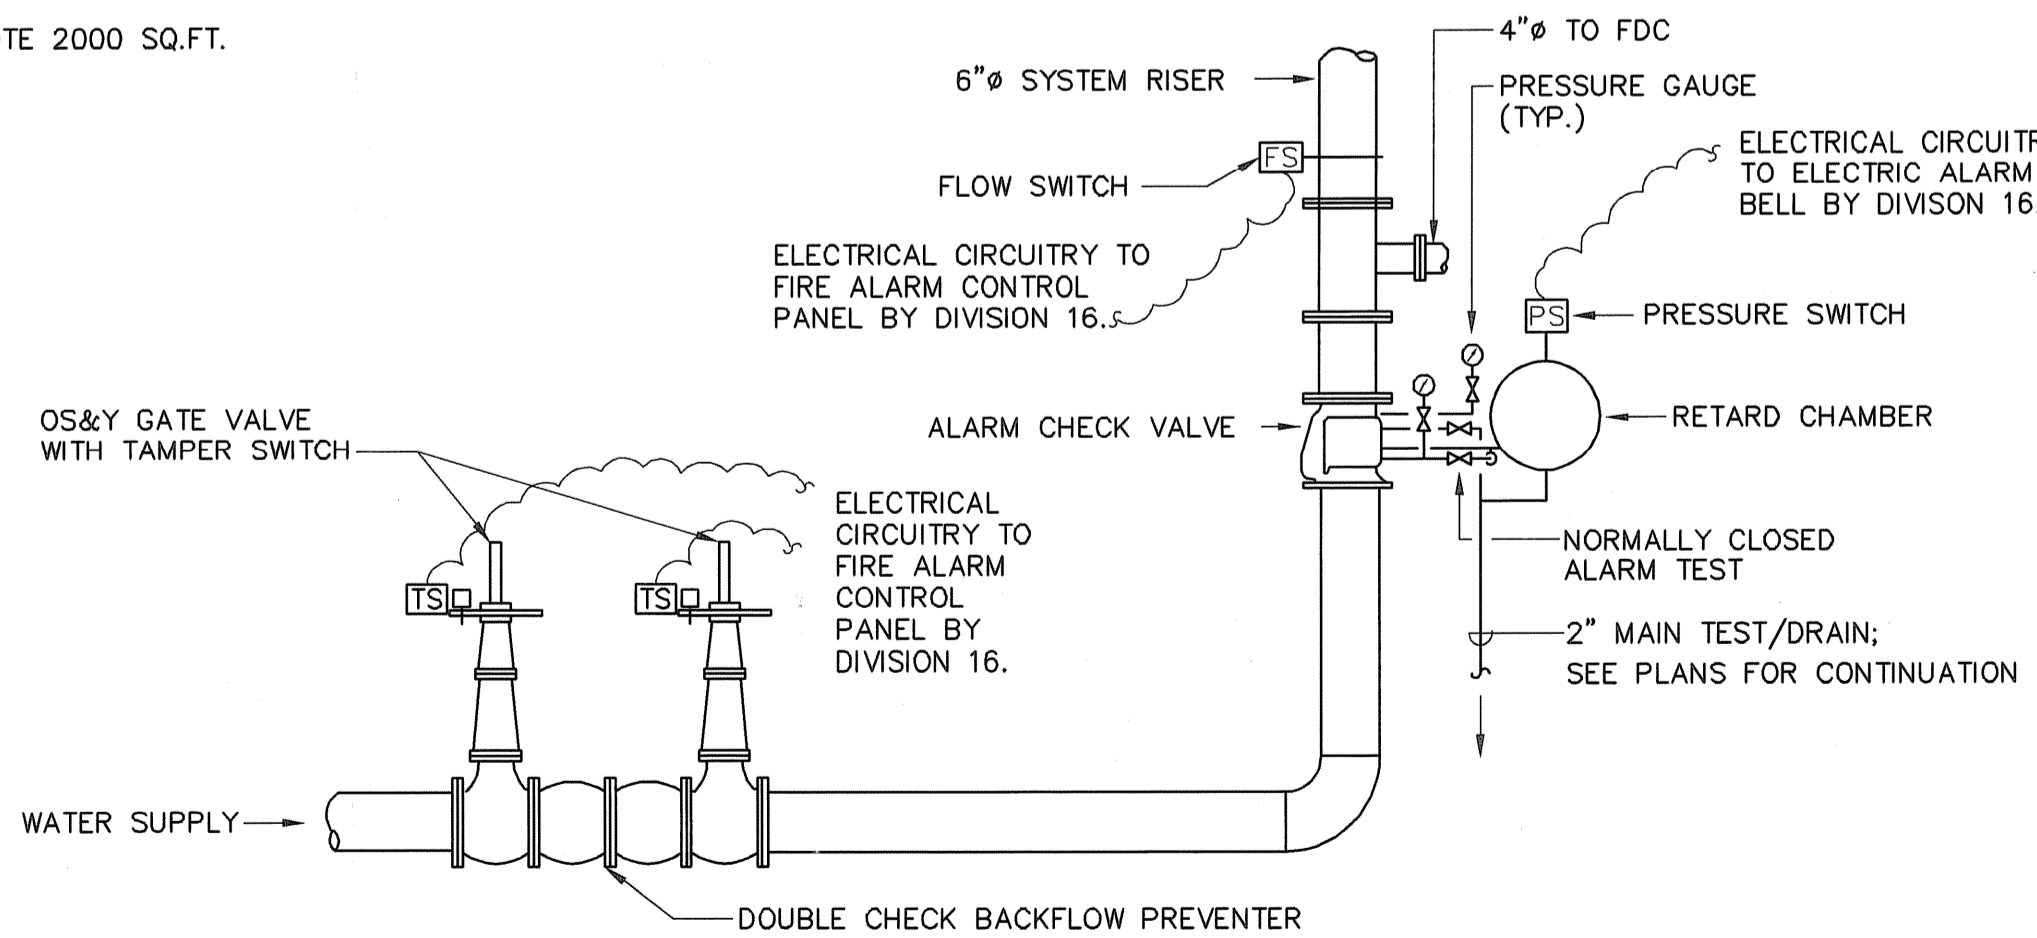

ALARM CHECK VALVE ASSEMBLY DETAIL
NOT TO SCALE

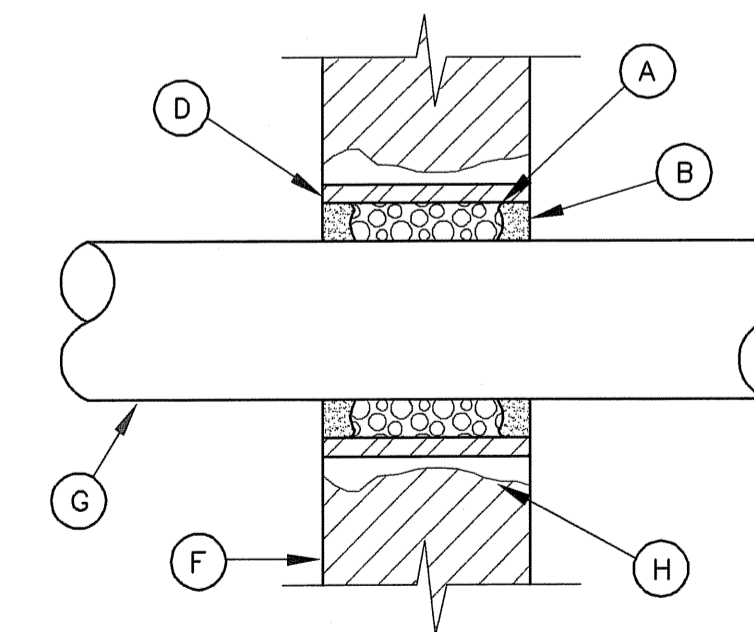

PIPE PENETRATION DETAIL
(NOT FOR WATER TIGHT CONSTRUCTION)
NOT TO SCALE

- (A) PROVIDE 1/4" CLEARANCE BETWEEN PIPE SLEEVE OR CORE DRILLED HOLE AND PIPE. PACK CLEARANCE SPACE WITH SPECIFIED INSULATION
- (B) PROVIDE SPECIFIED END SEALANT
- (C) (NOT USED)
- (D) SLEEVE-PROVIDE AS SPECIFIED. EXTEND FLOOR PIPE SLEEVES 2" ABOVE FLOOR.
- (E) (NOT USED)
- (F) WALL OR FLOOR
- (G) (NOT USED)
- (H) GROUT SPACE BETWEEN SLEEVE AND MASONRY OR CONCRETE WALLS AND FLOORS

DATE	BY	REVISIONS
7/22/05	AJG	REV. A CLIENT REVIEW
8/16/05	AJG	REV. B AGENCY REVIEW
10/28/05	AJG	ISSUED FOR CONSTRUCTION
10/21/05	AJG	ISSUED FOR PERMITTED SET
5/10/06	AJG	AS-BUILT DRAWING FILE
MAY 2008	DRB	2


ROBERT H. SHELDON
4103
REGISTERED PROFESSIONAL ENGINEER
STATE OF RHODE ISLAND
No. 11719

PAWTUCKET, RHODE ISLAND
PAWTUCKET REGIONAL WATER TREATMENT FACILITY
PKGS 11 & 12 - RAW WATER PUMP STATION
FIRE PROTECTION LEGENDS, ABBREVIATIONS, GENERAL NOTES, DETAILS, AND DESIGN CRITERIA


DESIGNED BY	DWG SCALE
CVA	AS NOTED
DRAWN BY	CONTRACT NO.
CVA	
CHECKED BY	DATE
AG	OCTOBER 31, 2008

EARTH TECH
AS-BUILT FILE
MAY 2008

FP-1
SHEET OF

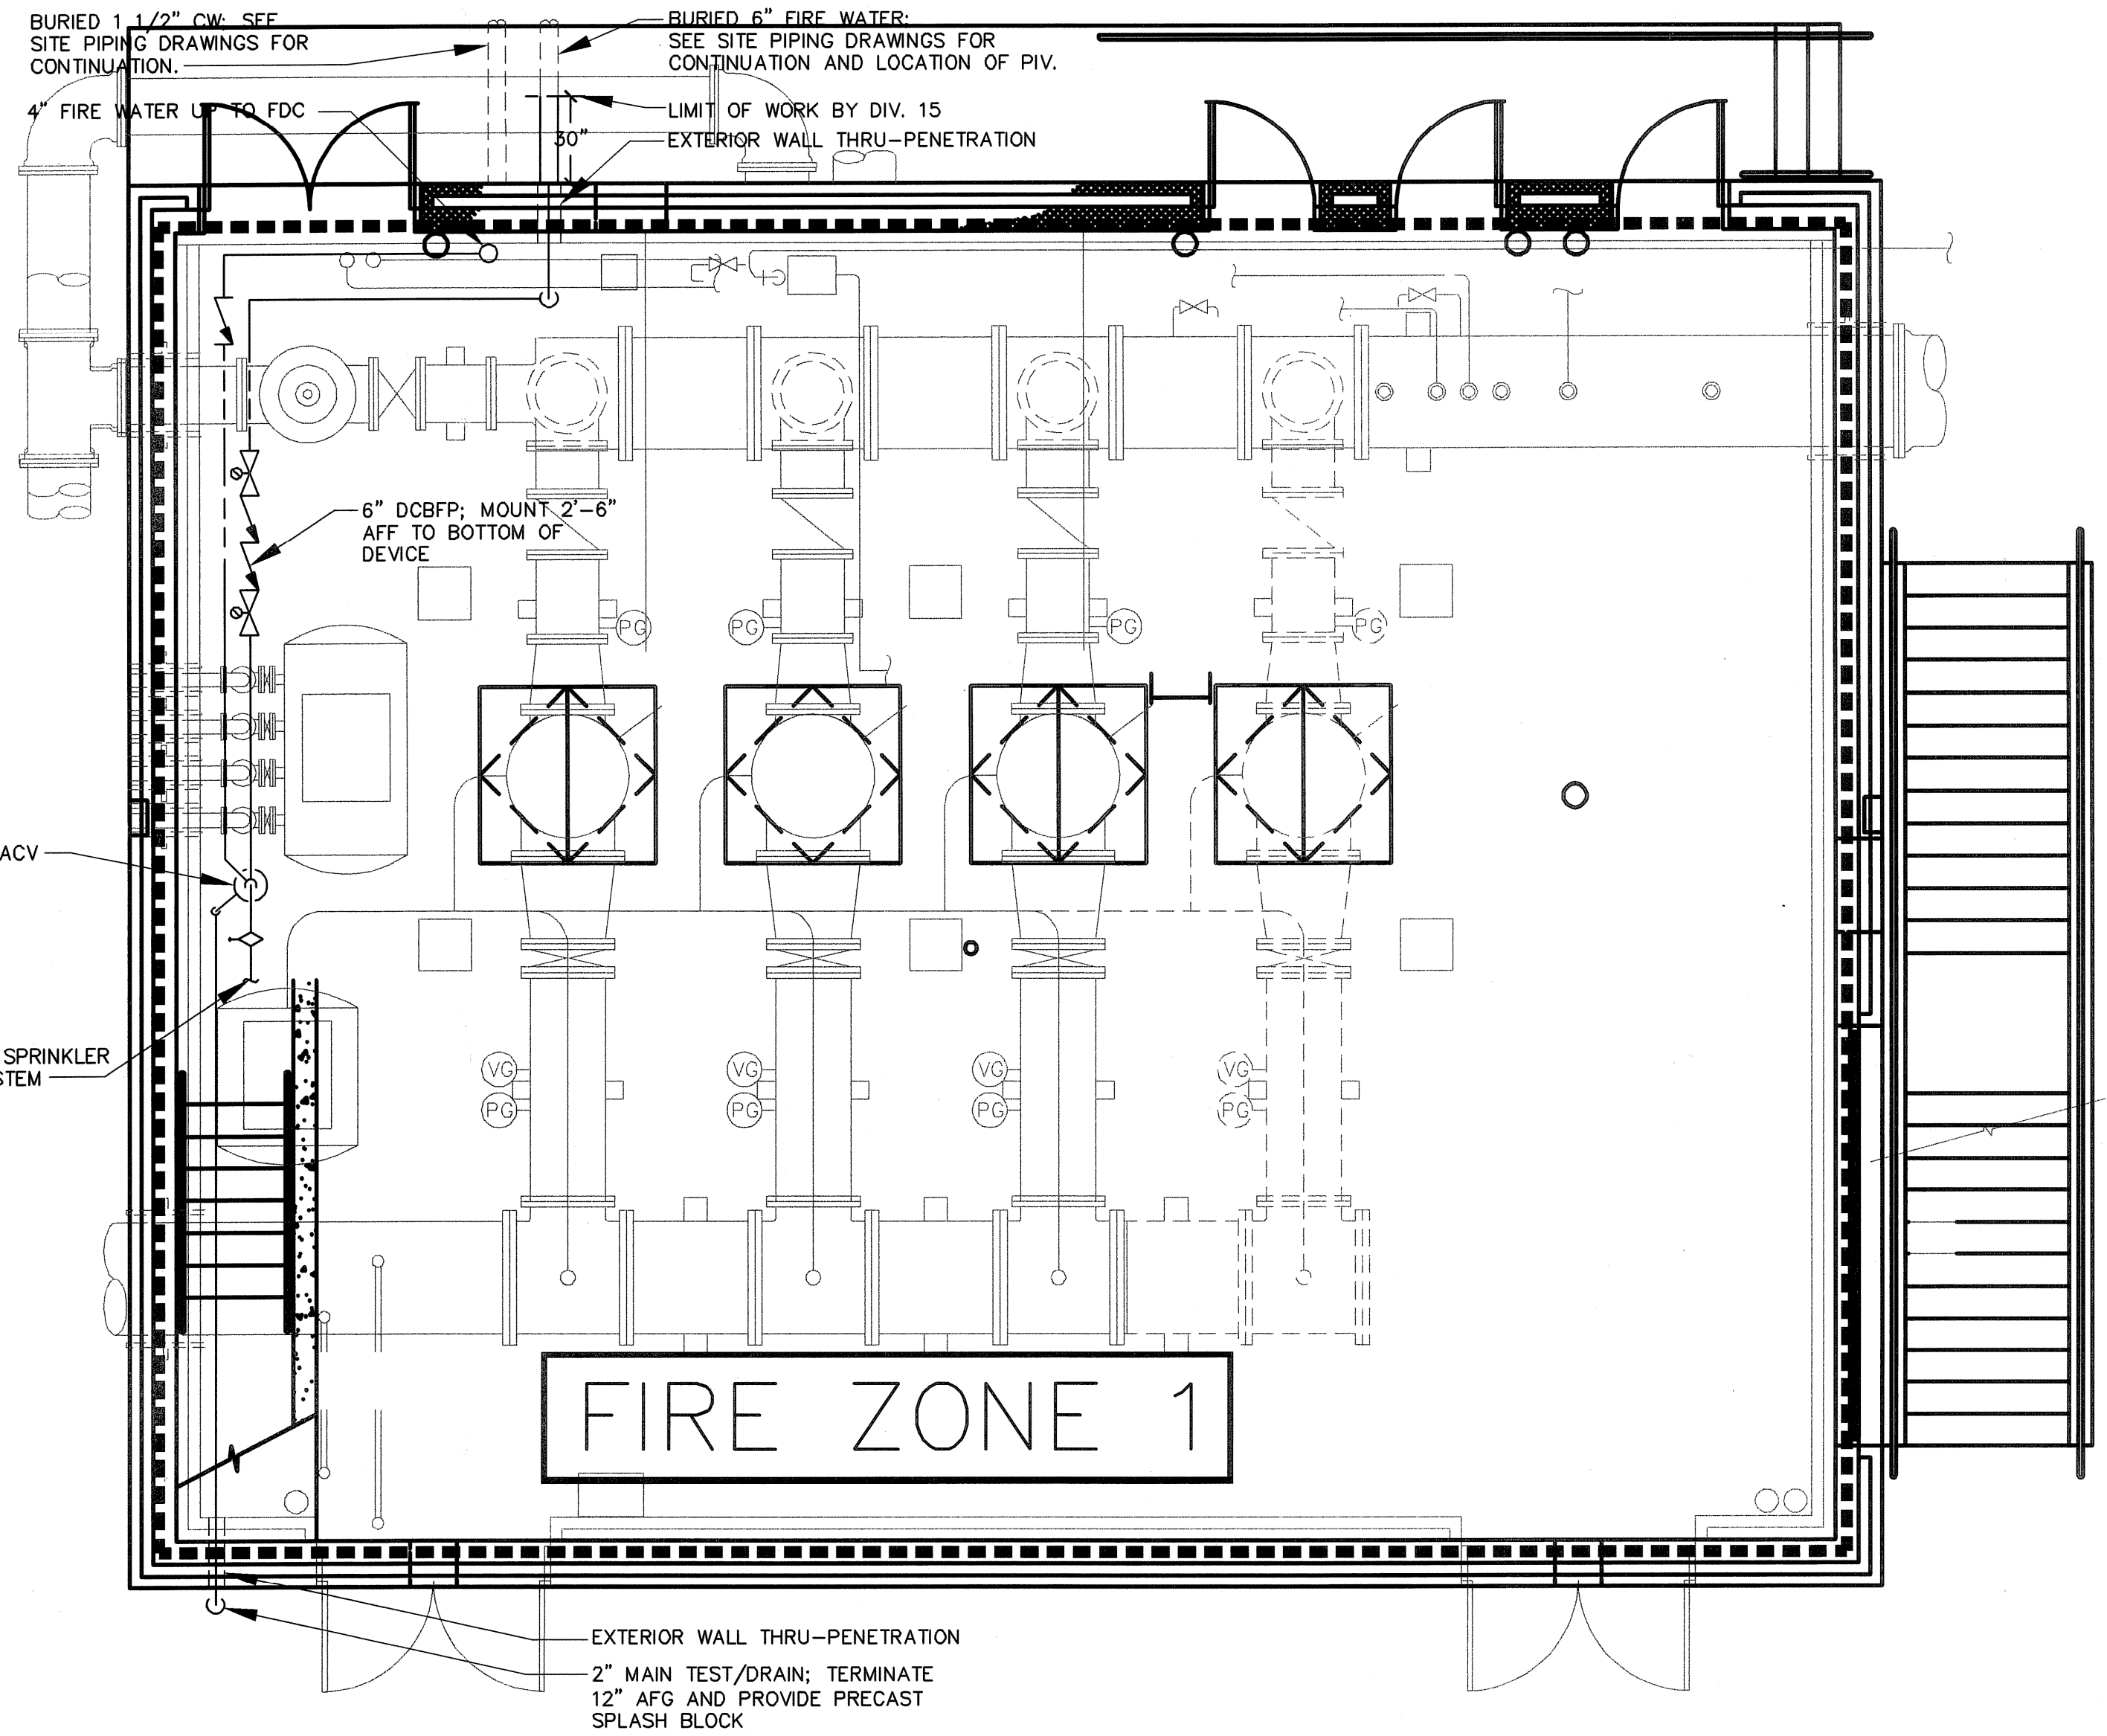

PUMP LEVEL FLOOR PLAN - EL. 59.00'
SCALE: 1/4" = 1'-0"

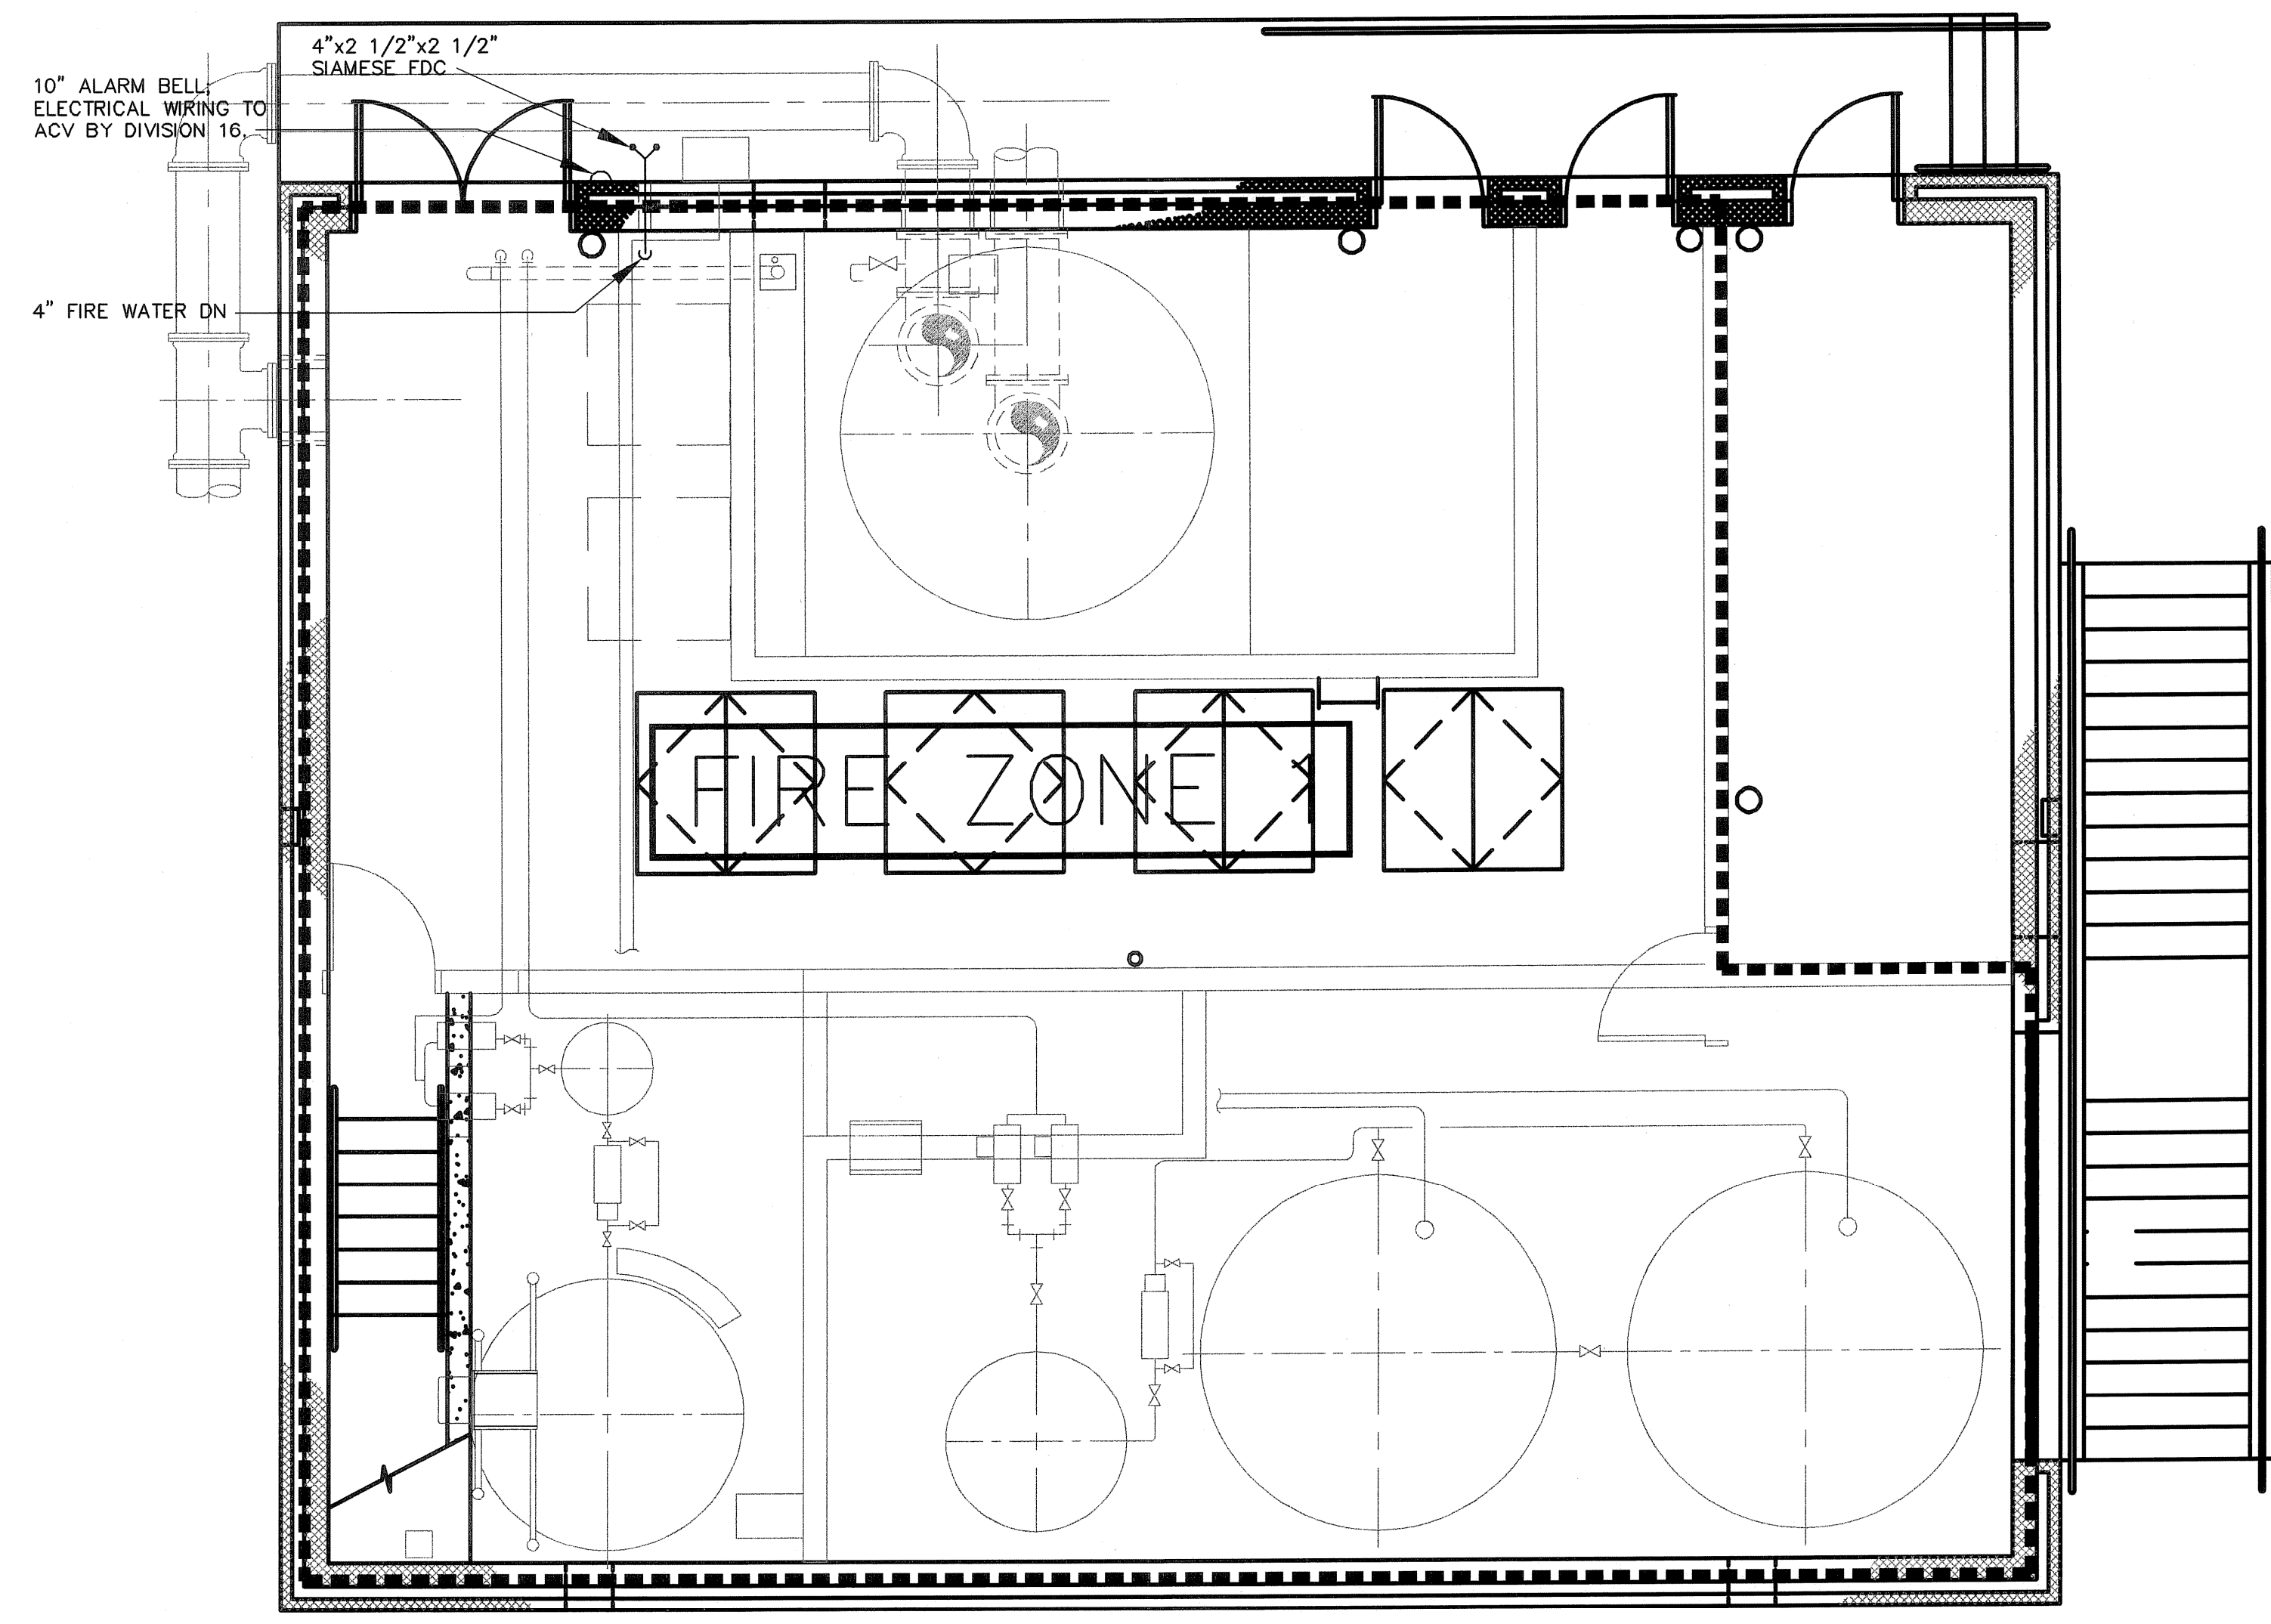

GROUND LEVEL FLOOR PLAN - EL. 79.00'
SCALE: 1/4" = 1'-0"

FULL SIZE DRAWING = 4"

NO.	DATE	BY	REVISIONS
2	05/08	DRP	AS-BUILT DRAWING FILE
1	10/31/08	AMM	ISSUED FOR RFI POSTED SET
0	10/28/08	AMG	ISSUED FOR CONSTRUCTION
8	8/16/08	AMG	ISSUED FOR RFI/RESPONSE REVIEW
7	7/22/08	AMG	ISSUED FOR RFI/RESPONSE REVIEW

ROBERT H. SHELDON
No. 4103
REGISTERED PROFESSIONAL ENGINEER
MASSACHUSETTS
3/1/09


PAWTUCKET, RHODE ISLAND
**PAWTUCKET REGIONAL
WATER TREATMENT FACILITY**
PKGS 11 & 12 - RAW WATER PUMP STATION
FIRE PROTECTION PLANS

DESIGNED BY	DWG SCALE
CVA	AS NOTED
DRAWN BY	CONTRACT NO.
CVA	
CHECKED BY	DATE
AG	OCTOBER 31, 2008


EARTH TECH
AS-BUILT FILE
MAY 2008

FP-2
SHEET OF

PLW - FIRE LOSS CHECKED: 3/29/22/2008 11:24 AM

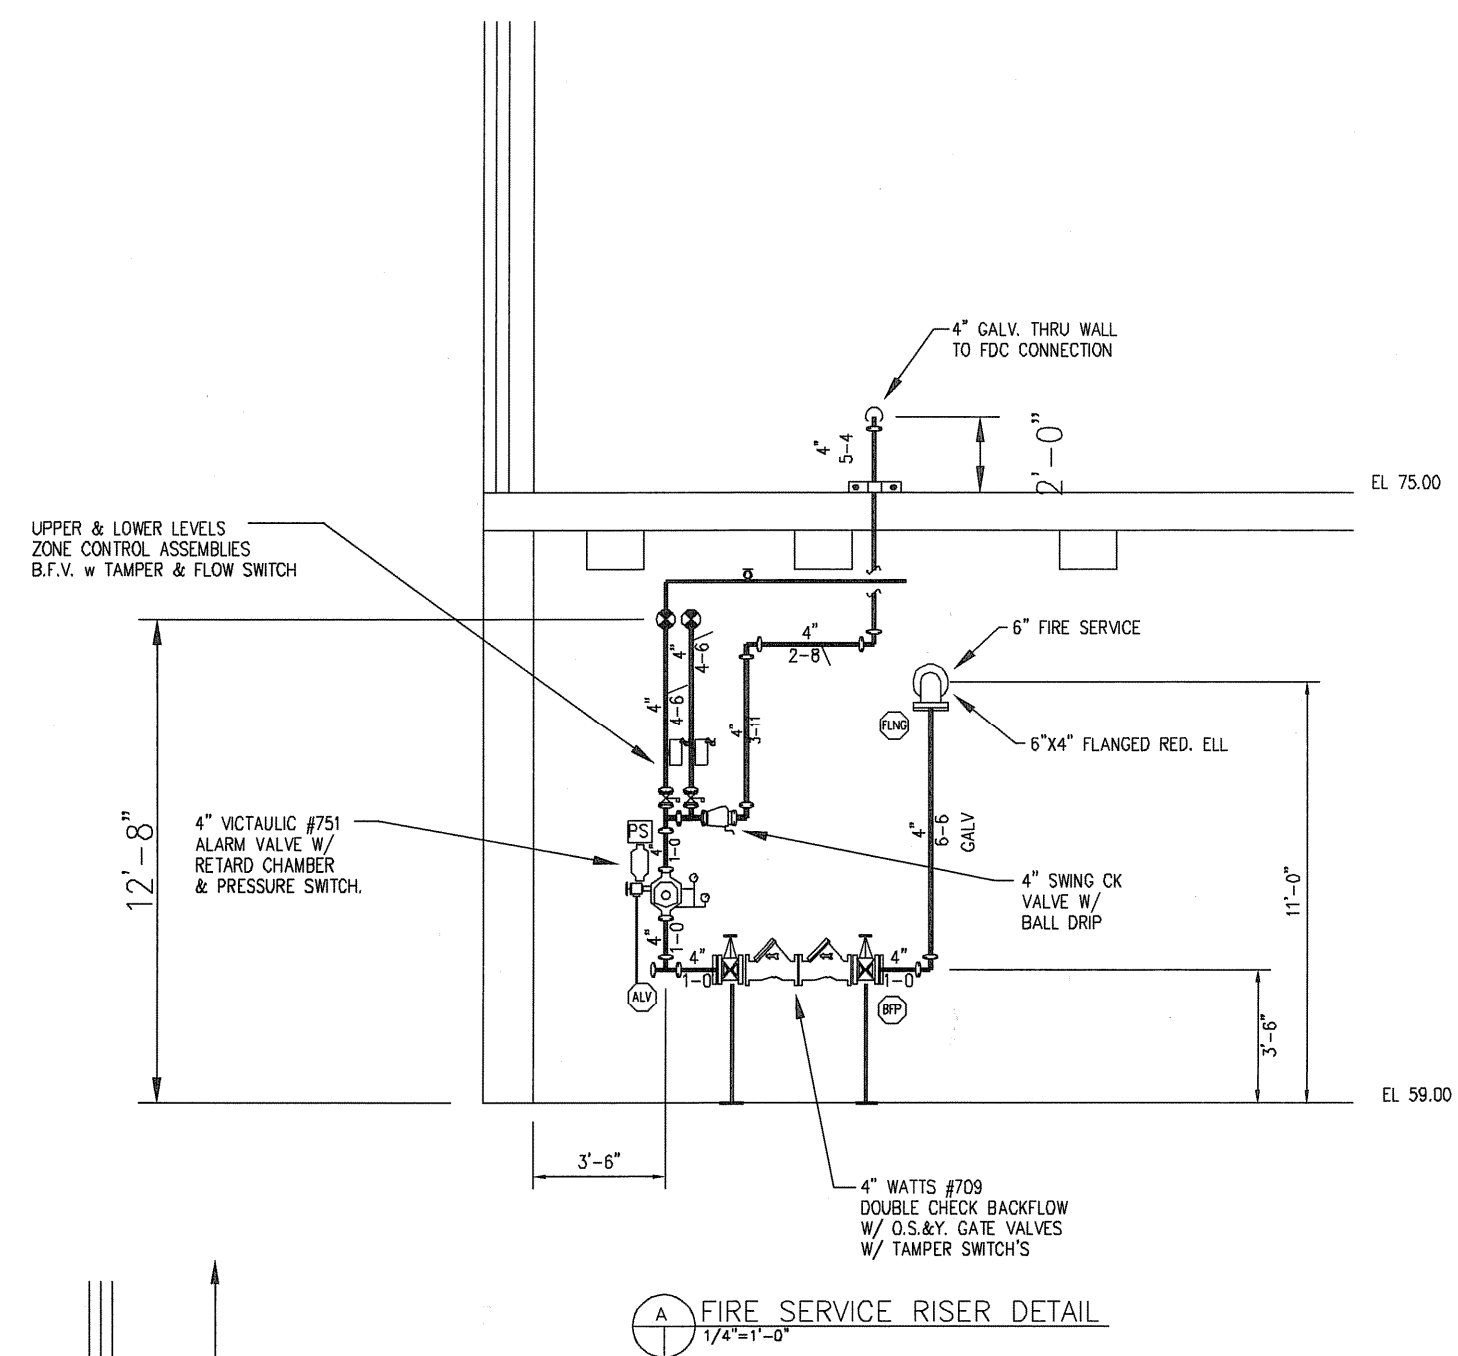


A FIRE SERVICE RISER DETAIL
1/4\"/>

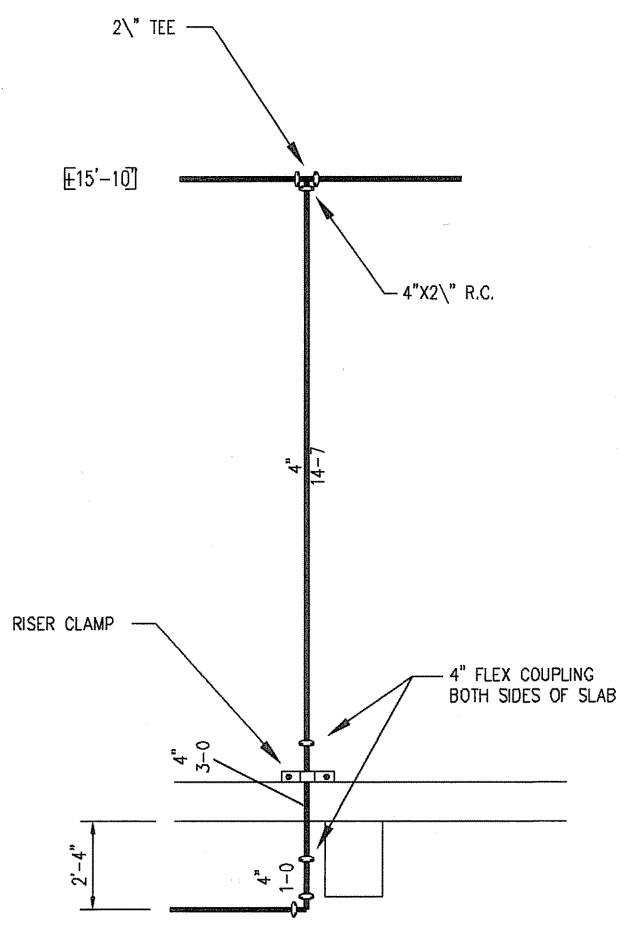


B UPPER FLR RISER DETAIL
1/4\"/>

FLOW TEST DATA
 DATE: 12/10/03
 LOCATION: MILL ST & PROSPECT ST.
 STATIC: 82 psi
 RESIDUAL: 76 psi
 FLOW: 895 gpm
 1- 2 1/2\"/>

HYDRALIC DESIGN INFO.
 CALC # 1455-12.WX1
 THIS SYSTEM HAS BEEN HYDRALICALLY CALCULATED BASED ON N.F.P.A. 13 ORDINARY HAZARD GROUP 1. THIS SYSTEM WILL DELIVER A DENSITY OF .15 GPM/SQFT OF FLOOR AREA OVER A MAX. AREA OF 2000 SQFT WHEN SUPPLIED WITH WATER AT A RATE OF 611 GPM AT 44.5 PSI AT THE BASE OF THE RISER.
 REF. FRONT # TEST
 TOTAL HOSE ALLOWANCE = 250 GPM @ TEST

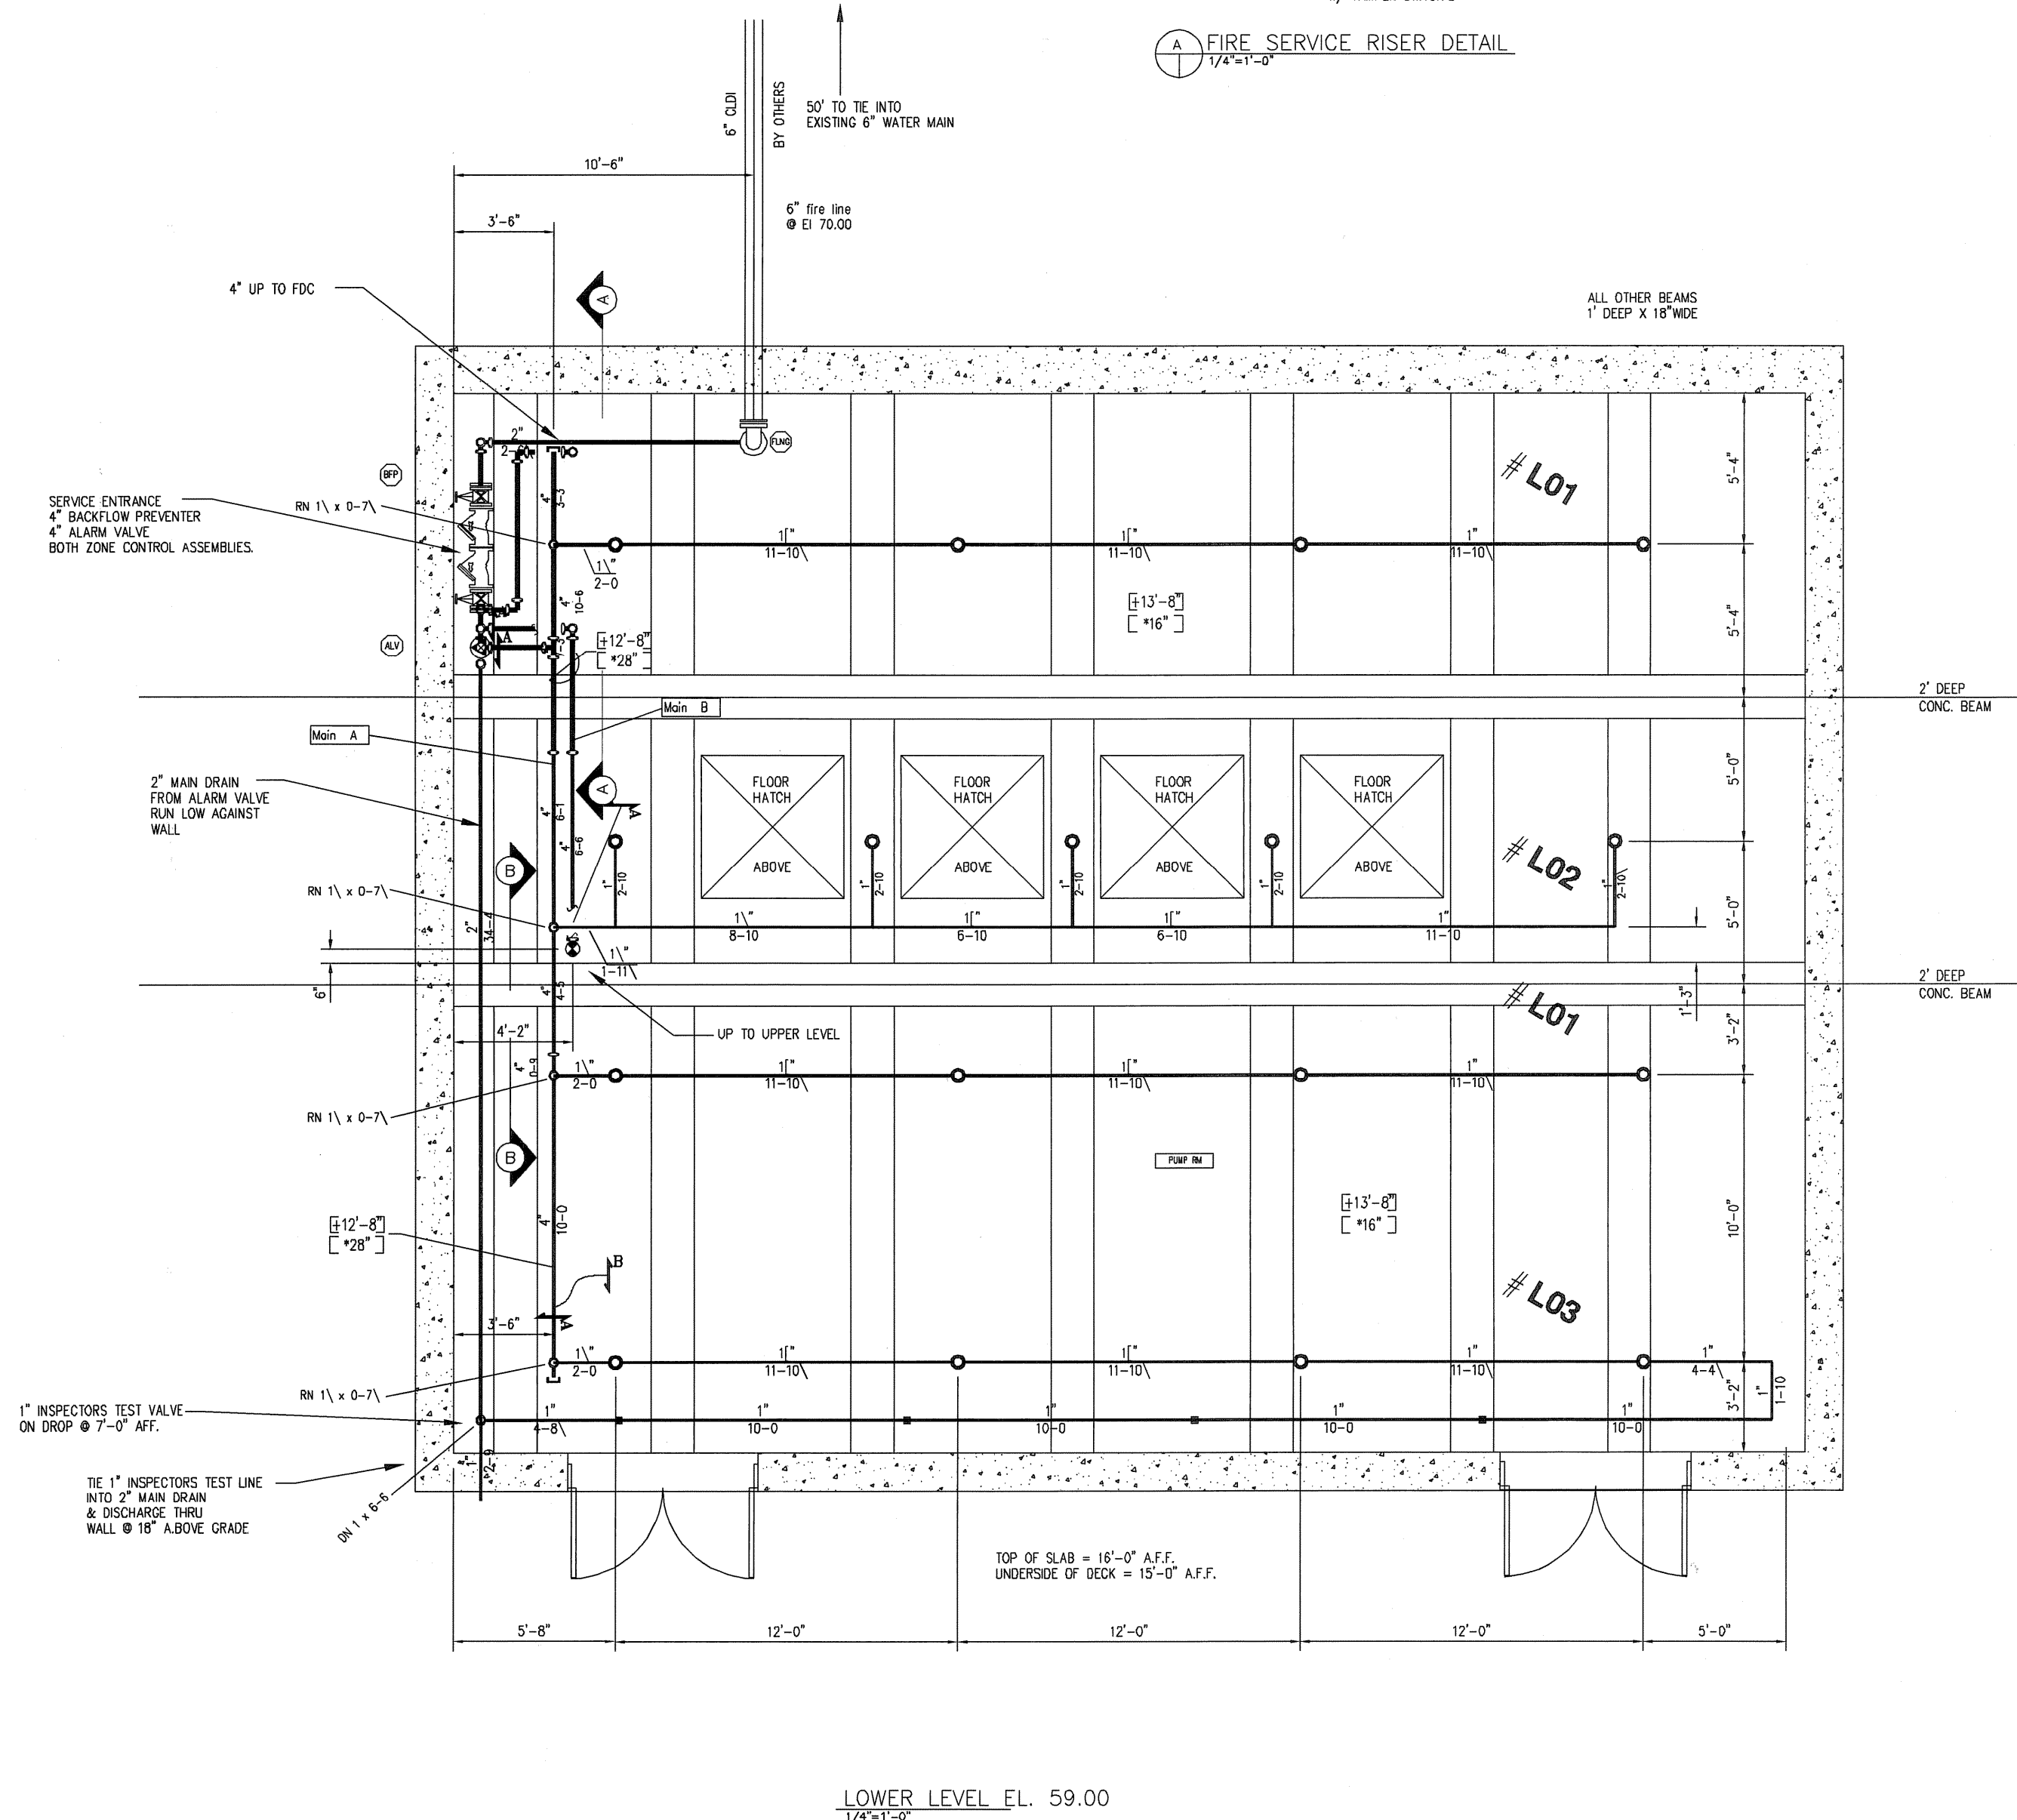



LOWER LEVEL EL. 59.00
1/4\"/>

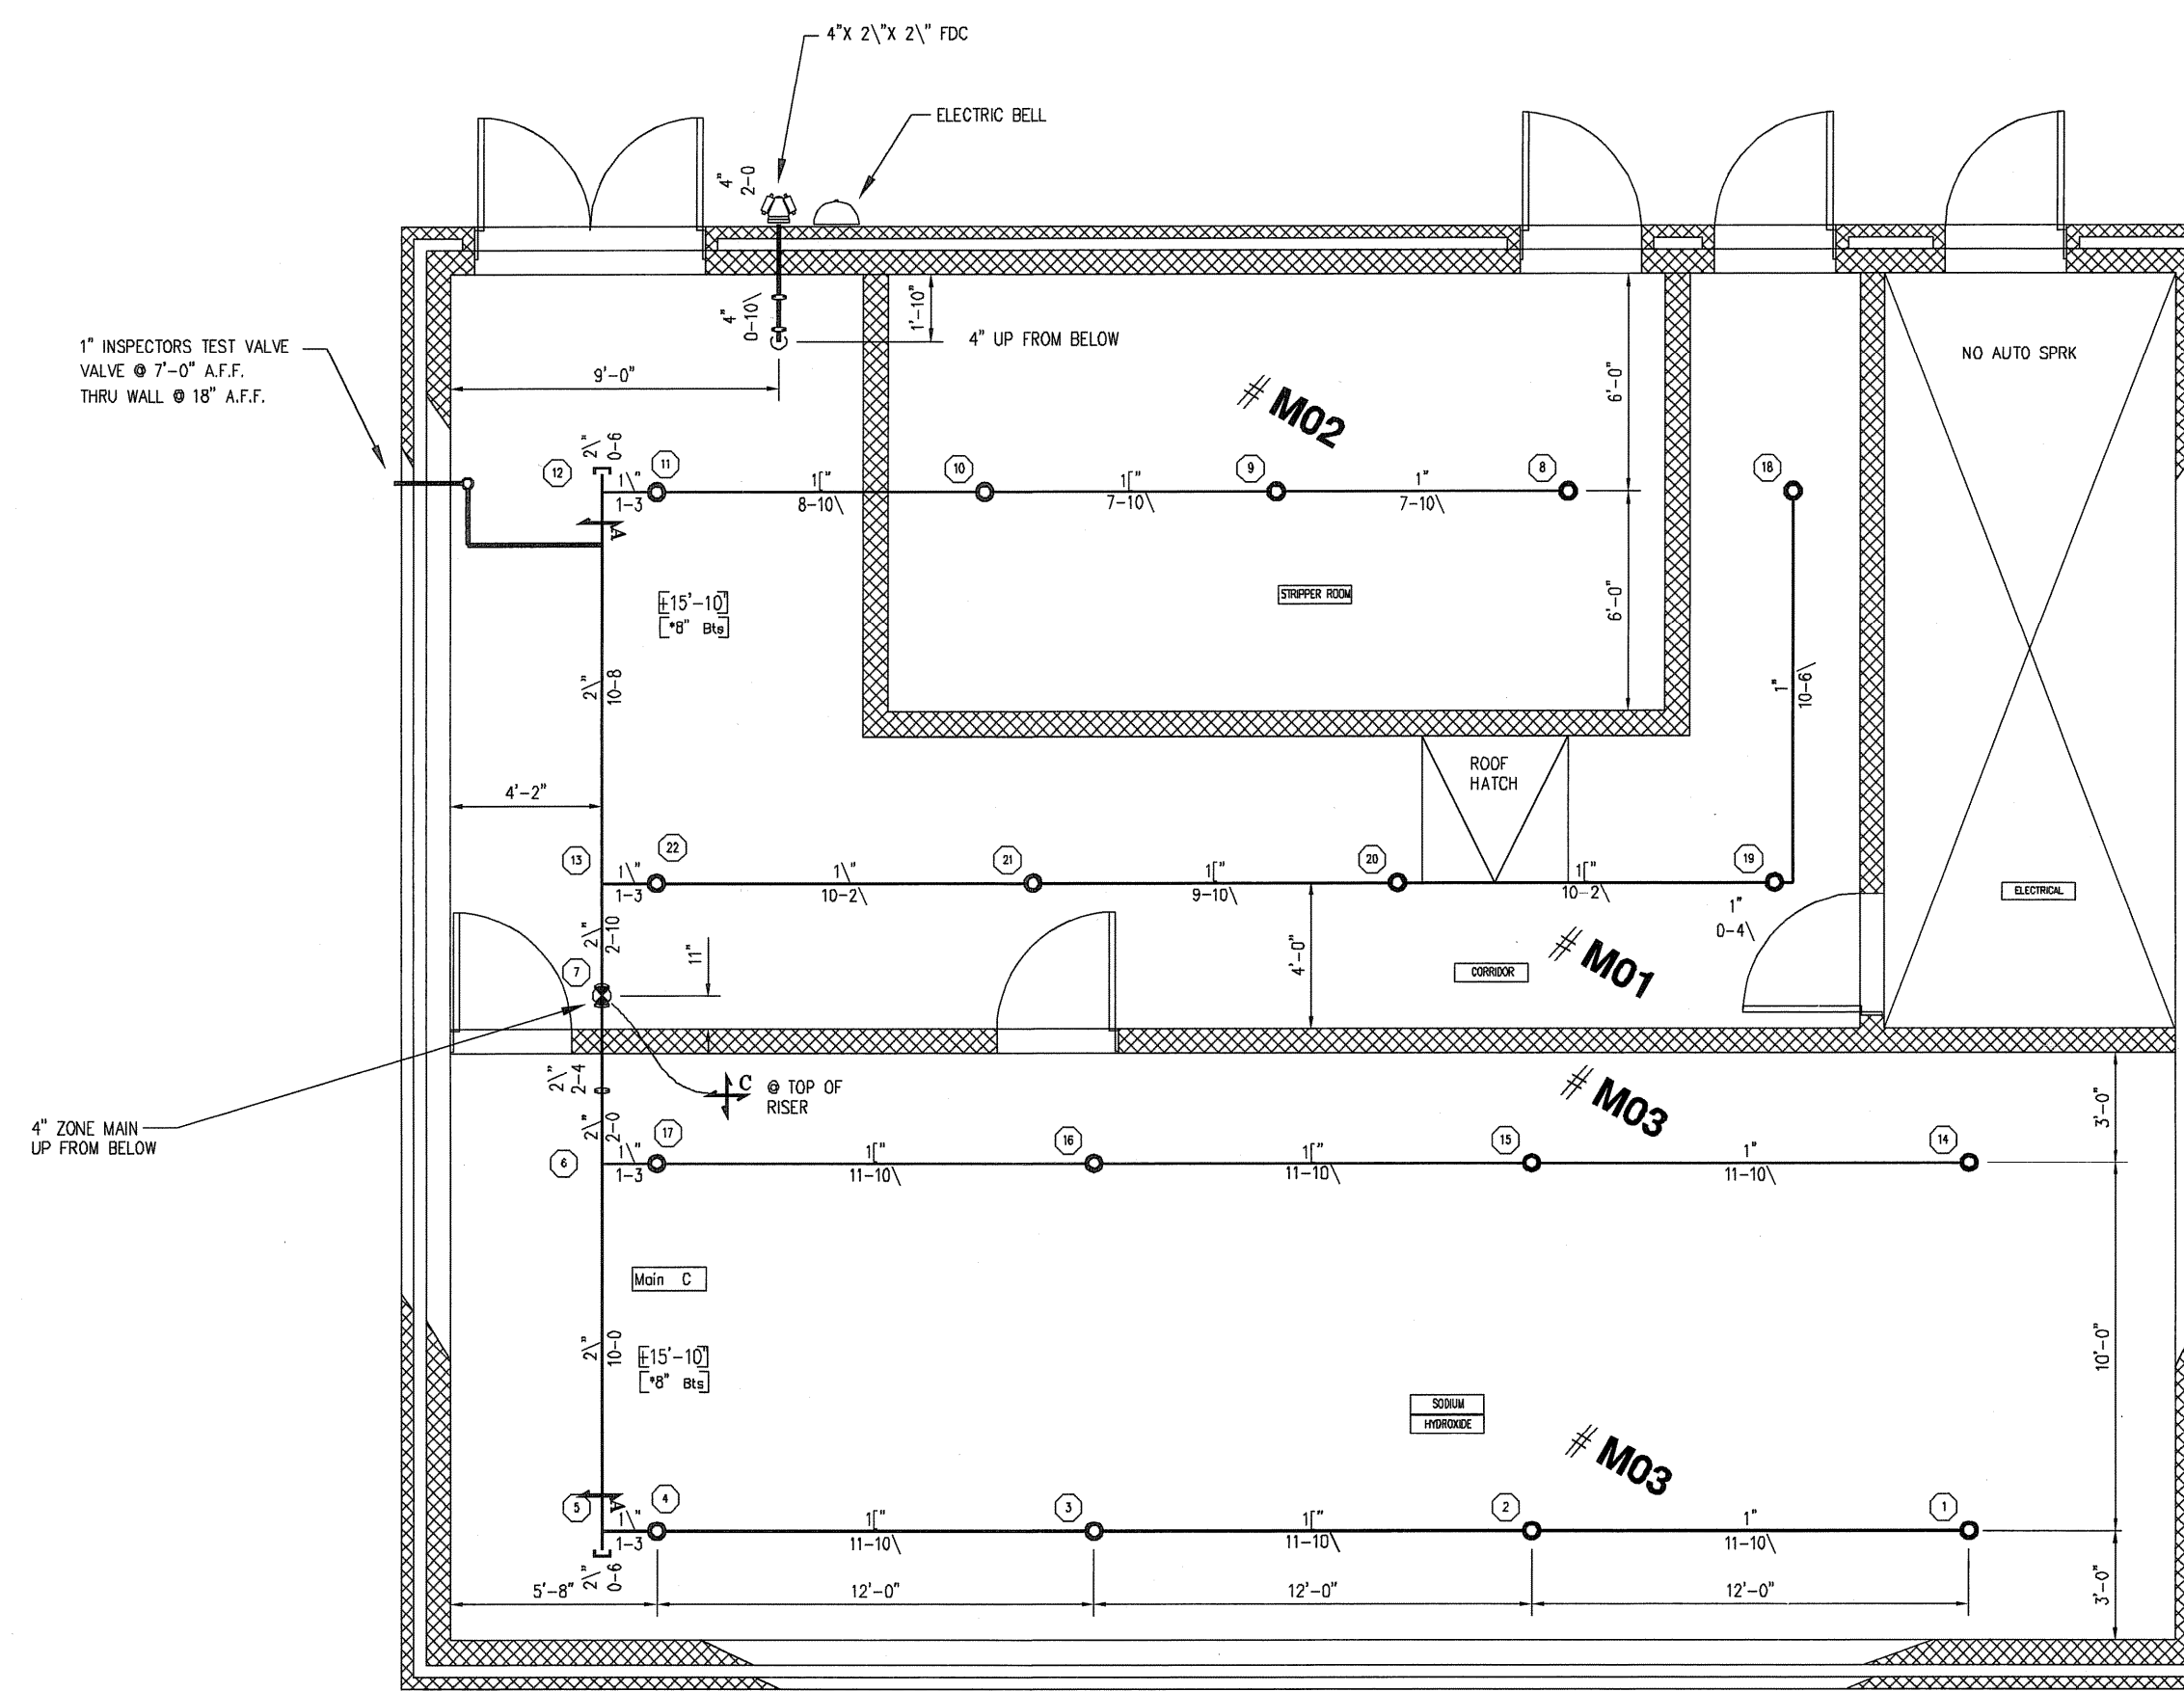

UPPER LEVEL EL. 75.00
1/4\"/>

**AS BUILT
DRAWING**

PACKAGE 12
RAW WATER PUMPING STATION

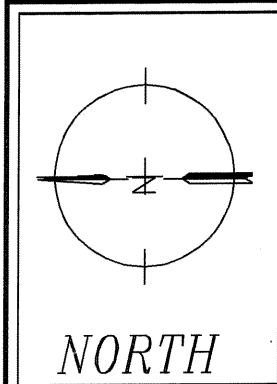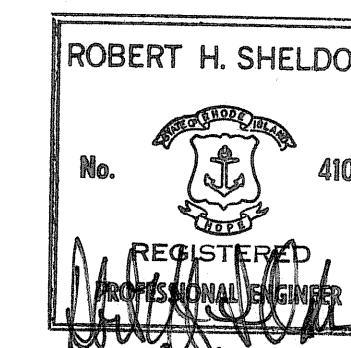

HYDRALIC DESIGN CRITERIA

Density	.15 GPM / 1500 SQ. FT.
Spacing	SEE PLAN
K Factor	5.8 Head Size 1/2"
Hose Allowance	250 GPM
Water Supply	
Static	82 PSI
Residual	76 PSI
Water Flowing	895 GPM
Size of Supply	6"

SYSTEM DESIGN CRITERIA

1.Type of Hazard	ORDINARY GRP 1	2.Deflector Distance	Varies
3.Pipe Schedule Used	N/A	4.Maximum Spacing	130 SQ.FT.
5.Type of Construction	OBSTRUCTED & UNOBSTRUCTED		
6.Maximum Square Footage Allowed	130 SQ.FT. OR SPRK. LISTING		
7.Hazard Group or Hydraulicity	Calculated.		
8.Sprinklers in this system are designed to be in the center of the ceiling tile			
9.Owner is to provide heat throughout the building to prevent water in the system from freezing			

KEY PLAN

- GENERAL NOTES**
- 1.(*) Denotes distance down in inches from deck to center line of pipe
 - 2.(0'-0") Denotes distance in feet and inches from floor up to center line of pipe
 - 3.○ Denotes Hydraulic Reference Points.
 4. This system has been designed based on N.F.P.A. 13 2002 ed. and all State & Local codes.
 5. - Denotes pipe sleeve locations.
 6. M Denotes seismic brace location.

REVISIONS

No.	Date	Description
1	10/9/07	AS BUILT CONDITION


NUMBER OF SPRINKLERS

Symbol	Size	Degree	Make	Model	No. Req'd
○	1/2"	155	VIC	VZ703 Q.R. BRASS UPRIGHT	34

ENGINEERED BY
CPL
NICET LEVEL IV
93648
DATE
03/07/06
SCALE
1/4"=1'-0"
DRAWING NUMBER
FP-12.1

JOB NAME
**PAWTUCKET REGIONAL
WATER TREATMENT FACILITY**
85 BRANCH STREET
PAWTUCKET, RHODE ISLAND

STORIES 2 LEVELS
CONST. CONCRETE
CONTRACT No. 1455

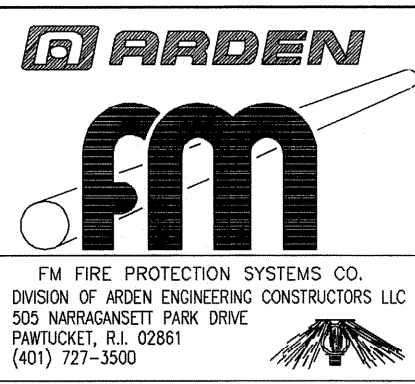

SINGLE LINE AND SCHEMATIC DIAGRAM SYMBOLS

	COMBINATION DISCONNECT SWITCH AND MAGNETIC STARTER
	COMBINATION MOLDED CASE BREAKER AND MAGNETIC CONTACTOR
	COMBINATION MOTOR CIRCUIT PROTECTOR AND MAGNETIC ACROSS THE LINE STARTER
	COMBINATION MOTOR CIRCUIT PROTECTOR AND MAGNETIC STARTER AS FOLLOWS: 2S2W = 2 SPEED 2 WINDING 2S1W = 2 SPEED 1 WINDING RVNR = REDUCED VOLTAGE NON-REVERSING AUTO-TRANSFORMER FVR = FULL VOLTAGE REVERSING SSRV = SOLID STATE REDUCED VOLTAGE
	MOLDED CASE AIR CIRCUIT BREAKER (3 POLE UNLESS OTHERWISE NOTED) 100 REFERS TO FRAME AMPERES SIZE & 30 REFERS TO TRIP RATING
	TRANSFORMER (AS NOTED)
	DELTA
	GROUNDING WYE
	LIGHTNING ARRESTER, NUMERAL DENOTES QUANTITY
	SURGE CAPACITOR
	GROUND
	FUSE- CLF DENOTES CURRENT LIMITING TYPE
	MOTOR, NUMBER INDICATES HORSEPOWER
	2 WINDING, 2 SPEED MOTOR
	ELECTRIC HEATING UNIT
	LOW VOLTAGE POWER CIRCUIT BREAKER, DRAW OUT TYPE, MANUALLY OR ELECTRICALLY OPERATED WITH STATIC TRIP DEVICES AND GROUND SENSOR. UPPER NUMERAL INDICATES FRAME SIZE, LOWER NUMERAL INDICATES TRIP SETTING. "E" INDICATES ELECTRICALLY OPERATED.
	CPT = CONTROL POWER TRANSFORMER PT = POTENTIAL TRANSFORMER NUMERAL DENOTES QUANTITY
	CURRENT TRANSFORMER, NUMERAL DENOTES QUANTITY
	A=AMMETER PF=POWER FACTOR METER V=VOLTMETER VAR=VAR-METER W=WATTMETER KWH=KILOWATT-HOUR METER D=DEMAND METER F=FREQUENCY METER
	INDICATING LIGHTS R=RED, B=BLUE, G=GREEN, A=AMBER
	MECHANICALLY INTERLOCKED (KEY)
	ELECTRICALLY INTERLOCKED
	NORMALLY OPEN CONTACT (DENERGIZED POSITION)
	NORMALLY CLOSED CONTACT (DENERGIZED POSITION)
	VOLTMETER SELECTOR SWITCH
	AMMETER SELECTOR SWITCH
	CIRCUIT BREAKER CONTROL SWITCH
	CURRENT TEST BLOCK
	POTENTIAL TEST BLOCK
	SYNCHRONIZING SWITCH
	TEST BLOCK
	GROUND FAULT PROTECTION
	PREWIRED PACKAGE MOTOR WITH COMPLETE MOTOR, MOTOR STARTER AND ALL NECESSARY CONTROLS. NUMERAL INDICATES KILOWATT RATING OR HORSEPOWER.
	PROTECTIVE RELAY 25 - SYNCHROCHECK RELAY 26 - THERMAL DEVICE 27 - UNDERVOLTAGE RELAY 32 - REVERSE POWER RELAY 43 - TRANSFER DEVICE 50 - INSTANTANEOUS OVERCURRENT RELAY 51 - INVERSE TIME OVERCURRENT RELAY 62 - TIME DELAY RELAY 64 - GROUND PROTECTIVE RELAY 67 - DIRECTIONAL OVERCURRENT 71 - TRANSFORMER LEVEL 74 - ALARM RELAY 83 - TRANSFER RELAY 86 - LOCKOUT RELAY, HAND RESET 87 - DIFFERENTIAL RELAY
	NEUTRAL GROUNDING RESISTOR (MEDIUM VOLTAGE)
	SURGE ARRESTOR
	MEDIUM VOLTAGE POWER CIRCUIT BREAKER DRAWOUT TYPE, ELECTRICALLY OPERATED, STORED-ENERGY. NUMERAL INDICATES CONTINUOUS AMPERE RATING
	DRAW OUT STYLE CPT = CONTROL POWER TRANSFORMER PT = POTENTIAL TRANSFORMER NUMERAL DENOTES QUANTITY
	KIRK KEY INTERLOCK
	CONTROL SWITCH
	UNINTERRUPTABLE POWER SUPPLY
	DIGITAL POWER METERING
	CABLE/CONDUIT TAG. P - INDICATES POWER CABLE C - INDICATES CONTROL CABLE S - SIGNAL CABLE

LIGHTING LEGEND

	CEILING OUTLET AND INCANDESCENT OR HIGH INTENSITY DISCHARGE FIXTURE "G" INDICATES FIXTURE TYPE, "b" INDICATES CONTROLLED BY SWITCH "b" "2" INDICATES CIRCUIT NUMBER
	WALL MOUNTED LIGHTING FIXTURES. NOTATION SAME AS ABOVE
	FLUORESCENT LIGHTING FIXTURE. NOTATION SAME AS ABOVE
	FLUORESCENT NIGHT LIGHT LIGHTING FIXTURE. NOTATION SAME AS ABOVE FIXTURE SHALL BE UNSWITCHED
	WALL OUTLET AND EXIT SIGN
	CEILING OUTLET AND EXIT SIGN (ARROW INDICATES DIRECTION OF EGRESS)
	EMERGENCY LIGHTING BATTERY UNIT WITH LIGHT HEADS. 1 DENOTES UNIT NUMBER
	REMOTE EMERGENCY LIGHTING HEAD, WALL MOUNTED REMOTE EMERGENCY LIGHTING HEAD, CEILING MOUNTED ELU#1 DENOTES CONNECTED TO ELU#1
	POLE MOUNTED LIGHT FIXTURE
	PHOTOCELL

SWITCH LEGEND

	S _c SINGLE POLE SWITCH CONTROLLING LIGHTS "c"
	S ₂ DOUBLE POLE SWITCH
	S ₃ THREE WAY SWITCH
	S ₄ FOUR WAY SWITCH
	S _T WALL MOUNTED TIMER SWITCH

WIRING DEVICE LEGEND

	20A-2P-3W-208V RECEPTACLE
	DUPLEX RECEPTACLE, GROUNDING TYPE-13 INDICATES CIRCUIT NUMBER UON MOUNTING HEIGHT SHALL BE AS PER SPEC. SECTION 16,500
	SIMPLEX RECEPTACLE
	SPECIAL PURPOSE RECEPTACLE, 240, 2P, 3 WIRE, OR AS OTHERWISE INDICATED (30 INDICATES AMPERE RATING)
	GROUND FAULT RECEPTACLE (MOUNT 4'-0" A.F.F.)

BRANCH CIRCUIT AND FEEDER LEGEND

	CONDUIT RUN EXPOSED (DIAGONALS DENOTE THE NUMBER OF NO. 12 AWG WIRES. IF NO DIAGONALS, 2 NO. 12 WIRES & 1#12 GND IN 3/4" CONDUIT U.O.N.)
	HOMERUN. RUN TO PANEL. LPT" CIRCUITS 1 & 3
	CONDUIT RUN CONCEALED (2 NO. 12 WIRES & 1#12 GND IN 3/4" CONDUIT UNLESS OTHERWISE NOTED)
	CONDUIT RUN UNDERGROUND
	FLEXIBLE CONDUIT
	CONDUIT TURNING UP
	CONDUIT TURNING DOWN

MOTOR AND CONTROL LEGEND

	DISCONNECT SWITCH, 600 VOLT-30A,3P,UON F INDICATES FUSED TYPE
	MANUAL MOTOR STARTER. "P" DENOTES WITH PILOT LIGHT
	MAGNETIC MOTOR STARTER
	UNIT HEATER
	LIGHTING OR HEATING CONTACTOR, M-MECHANICALLY, E-ELECTRICALLY HELD TYPE
	THERMOSTAT
	EMERGENCY PUSH BUTTON
	MANUAL MOTOR STARTER SWITCH WITH THERMAL OVERLOAD PROTECTION

FIRE ALARM SYSTEM SYMBOLS

	MANUAL FIRE ALARM STATION
	FIRE ALARM AUDIO/VISUAL DEVICE
	FIRE ALARM BEACON
	FIRE ALARM VISUAL DEVICE
	SMOKE DETECTOR, PHOTOELECTRIC TYPE. "ER" ELEVATOR RECALL
	DUCT SMOKE DETECTOR
	REMOTE TEST STATION FOR DUCT SMOKE DETECTOR
	HEAT DETECTOR, COMBINATION RATE-OF-RISE AND FIXED TEMPERATURE
	HEAT DETECTOR, FIXED TEMPERATURE, NUMBER INDICATES TEMPERATURE SETTING
	FLOW SWITCH
	TAMPER SWITCH
	FIRE ALARM CONTROL PANEL
	FIRE ALARM ANNUNCIATOR PANEL
	REMOTE ALARM INDICATING LIGHT

ABBREVIATIONS

2(3#8,1"C.)	2, 1-INCH CONDUITS EACH CONDUIT CONTAINING 3-#8 AWG COPPER WIRES	MH	MANHOLE
3/4" CE	EMPTY CONDUIT, WITH PULL STRING. NUMERAL DENOTES SIZE	MeH	METAL HALIDE MANUFACTURER
1-2/C#14TS	ONE-TWO CONDUCTOR, NO. 14 AWG, TWISTED SHIELDED PAIR CABLE	MFR	MOTOR OPERATED VALVE
ACV	AIR CONTROL VALVE	MOV	MOISTURE SENSOR
AE	ANALYZER ELEMENT	N	NEUTRAL
AIT	ANALYZER INDICATING TRANSMITTER	MS	NORMALLY CLOSED
AFF	ABOVE FINISHED FLOOR	NC	NORMALLY OPEN
AFG	ABOVE FINISHED GRADE	NTS	NOT TO SCALE
AR	AUXILIARY RELAY	OH	OVERHEAD
ATC	AUTOMATIC TEMPERATURE CONTROL	OL	MOTOR OVERLOAD HEATER
ATS	AUTOMATIC TRANSFER SWITCH	P	PUMP
BC	BATTERY CHARGER	PB	PUSHBUTTON CONTROL STATION MOMENTARY CONTACT TYPE, STOP START
BDS	BLOWER DISCHARGE TEMPERATURE SWITCH	PBL	PUSHBUTTON CONTROL STATION MOMENTARY TYPE WITH LOCK-OUT DEVICE, STOP-START
BP	BYPASS (CONTACT AT MOTOR STARTER)	PBM	PUSHBUTTON CONTROL STATION MAINTAINED CONTACT TYPE, STOP START
BWCV	BACKWASH WASTE CONTROL VALVE	PC	PHOTOCELL
CFPWTF	CHEMICAL FILL PANEL WATER TREATMENT FACILITY	PF	POWER FACTOR
CP	CONTROL PANEL	PFCC	POWER FACTOR CORRECTION CAPACITOR
CPT	CONTROL POWER TRANSFORMER	PFR	PHASE FAILURE RELAY
CR	CONTROL RELAY	PIT	PRESSURE INDICATOR TRANSMITTER
DMFM	DIGITAL MULTIFUNCTION METER	PL	PUSHBUTTON CONTROL STATION MOMENTARY TYPE WITH LOCK-OUT DEVICE, STOP
DPIT	DIFFERENTIAL PRESSURE INDICATING TRANSMITTER	PMG	PERMANENT MAGNET GENERATOR
DRG. DWG.	DRAWING	POT	POTENTIOMETER
DS	DOOR SWITCH FOR SECURITY SYSTEM	PS	PRESSURE SWITCH
EF	EXHAUST FAN	PSH	PRESSURE SWITCH HIGH
EMH	ELECTRICAL MANHOLE	PSL	PRESSURE SWITCH LOW
EPO	EMERGENCY PUSH BUTTON	PT	PRESSURE TRANSMITTER
ETM	ELAPSED TIME METER	RGS	RIGID GALVANIZED STEEL
EUH	ELECTRIC UNIT HEATER	RP	RELAY PANEL
EWH	ELECTRIC WATER HEATER	RTCP	REMOTE TELEMETRY CONTROL PANEL
FCP	FILTER CONTROL PANEL	RTU	REMOTE TELEMETRY UNIT
FCV	FLOW CONTROL VALVE	RWSPCP	RAW WATER PUMP STATION CONTROL PANEL
FE	FLOW ELEMENT	SOV	SOLENOID VALVE
FIT	FLOW INDICATOR TRANSMITTER	SSRV	SOFT START REDUCED VOLTAGE
FLUOR	FLUORESCENT	SS	SELECTOR SWITCH
FS	FLOW SWITCH	ST	SHUNT TRIP RELAY
FSL	FLOW SWITCH LOW	SWP	SAMPLE WATER PUMP
FT	FLOW TRANSMITTER	TB	TERMINAL BOX
FV	FLOW VALVE	TD	MOTOR TEMPERATURE DETECTOR
FWCV	FILTER WASTE CONTROL VALVE	TDC	TIME DELAY CLOSING
GFCI	GROUND FAULT CIRCUIT INTERRUPTER	TDO	TIME DELAY OPENING
GFR	GROUND FAULT RELAY	TDM	TEMPERATURE DETECTION MODULE
GND, GRD	GROUNDING CONDUCTOR (EQUIPMENT)	TE/TT	TEMPERATURE ELEMENT/TEMPERATURE TRANSMITTER
HOA	HAND-OFF-AUTOMATIC	TG	TACH GENERATOR
HH	HANDHOLE	TOC	TOP OF CONCRETE
HPS	HIGH PRESSURE SODIUM	TO	TORQUE OVERLOAD SWITCH
HTR	HEATER	TS	TEMPERATURE SWITCH
J	JUNCTION BOX	TVSS	TRANSIENT VOLTAGE SURGE SUPPRESSOR
K	KEY INTERLOCK	TYP	TYPICAL
LC	LOAD CENTER	UG	UNDERGROUND
LE	LEVEL ELEMENT	UPS	UNINTERRUPTIBLE POWER SUPPLY
LIT	LEVEL INDICATOR TRANSMITTER	USP	UNINTERRUPTIBLE SUPPLY PANELBOARD
LL	LOW LEVEL	UV	ULTRAVIOLET
LSL	LEVEL SWITCH LOW	VD	VIBRATION DETECTOR
LSH	LEVEL SWITCH HIGH	VFD	VARIABLE FREQUENCY DRIVE
LO	LOCKOUT	VFDC	VFD POWERED FROM A DC SOURCE
LR	LATCHING RELAY	WP	WEATHERPROOF (NEMA 4 UNLESS OTHERWISE NOTED)
LS	LIMIT SWITCH	WTPCP	WATER TREATMENT PLANT CONTROL PANEL
LT	LEVEL TRANSMITTER		
MAU	MAKE UP AIR UNIT		
MCC	MOTOR CONTROL CENTER		

SECURITY LEGEND

	MAGNETIC DOOR SWITCH		ELECTRIC LOCK
	SECURITY ALARM CONTROL PANEL		
	DOOR BELL		
	KEY PAD		
	CARD READER		
	SECURITY ALARM BEACON		

COMMUNICATIONS SYSTEM SYMBOLS

	TELEPHONE OUTLET - WALL TYPE
	CEILING SPEAKER FLUSH MOUNTED
	WALL SPEAKER
	WALL MOUNTED INTERCOM HORN, W=WIDE ANGLE, WP=WEATHERPROOF, CR=CORROSION RESISTANT
	SPEAKER AMPLIFIER
	SPEAKER AMPLIFIER WITH HANDSET
	HANDSET-WALL MOUNTED

POWER DISTRIBUTION LEGEND

	SURFACE MOUNTED POWER PANEL
	FLUSH MOUNTED POWER PANEL
	SURFACE MOUNTED LIGHTING PANEL
	FLUSH MOUNTED LIGHTING PANEL
	TRANSFORMER

SITE AND GROUNDING LEGEND

	POWER COMPANY POLE
	GROUND ROD
	BUILDING GROUND GRID

GENERAL NOTES

- ALL CONDUIT AND EQUIPMENT SHALL BE INSTALLED AND GROUNDED IN ACCORDANCE WITH THE LATEST EDITION OF THE NATIONAL ELECTRICAL CODE AND APPLICABLE LOCAL CODES.
- PROVIDE GROUND CONNECTIONS TO WATER PIPES, IN EACH FACILITY BONDING JUMPERS, CONDUIT CLAMPS AND POINTS OF ATTACHMENT ARE NOT SHOWN ON DRAWINGS. SIZE BONDING JUMPERS IN ACCORDANCE WITH TABLE 250-122 OF THE NATIONAL ELECTRICAL CODE. THE POINTS OF ATTACHMENT OF THE GROUND CLAMPS SHALL BE ACCESSIBLE LOCATIONS.
- CONDUIT INSTALLATIONS ARE SHOWN DIAGRAMMATICALLY ONLY AND SHALL BE INSTALLED IN A MANNER TO PREVENT CONFLICTS WITH EQUIPMENT AND STRUCTURAL CONDITIONS. EXPOSED CONDUITS SHALL BE INSTALLED PARALLEL TO BEAMS AND WALLS.
- CONDUITS SHALL BE TERMINATED SO AS TO PERMIT NEAT CONNECTIONS TO MOTORS AND OTHER EQUIPMENT.
- NO CONDUIT SMALLER THAN 3/4" PIPE SIZE NOR WIRE SMALLER THAN NO. 12 A.W.G. SHALL BE USED UNLESS OTHERWISE NOTED.
- THE WIRING DIAGRAMS, QUANTITY AND SIZE OF WIRES AND CONDUIT REPRESENT A SUGGESTED ARRANGEMENT BASED UPON SELECTED STANDARD COMPONENTS OF ELECTRICAL EQUIPMENT. MODIFICATIONS ACCEPTABLE TO THE ENGINEER MAY BE MADE BY THE CONTRACTOR TO ACCOMMODATE EQUIPMENT ACTUALLY PURCHASED. THE BASIC SEQUENCE AND METHOD OF CONTROL MUST BE MAINTAINED AS INDICATED ON THE DRAWINGS AND/OR SPECIFICATIONS.
- SWITCHES SHALL BE MOUNTED 4'-0" ABOVE FINISHED FLOOR UNLESS OTHERWISE NOTED. RECEPTACLES SHALL BE MOUNTED 4'-0" ABOVE FINISHED FLOOR UNLESS OTHERWISE NOTED, EXCEPT RECEPTACLES IN OFFICES OR AREAS WITH SUSPENDED CEILINGS SHALL BE MOUNTED 1'-6" ABOVE FINISHED FLOOR UNLESS OTHERWISE NOTED.
- ALL SURFACE MOUNTED PANELS AND PANELBOARDS ON THE INSIDE OF THE EXTERIOR WALLS ABOVE GRADE OR IN OTHER LOCATIONS CONSIDERED AS DAMP, SHALL BE MOUNTED SO AS TO MAINTAIN A 1/4" AIR SPACE BETWEEN THE ENCLOSURE AND THE WALL.
- ALL PANELBOARDS SHALL BE MOUNTED SO THAT THE DISTANCE FROM THE TOP CIRCUIT BREAKER OPERATING HANDLE TO THE FLOOR SHALL NOT EXCEED 6'-6".
- LIGHTING FIXTURES SHALL BE MOUNTED ACCORDING TO THE MOUNTING HEIGHT GIVEN ON THE DRAWINGS, WITH THE DISTANCE BEING MEASURED FROM THE BOTTOM OF THE LIGHTING FIXTURE TO THE FINISHED FLOOR.
- FOR EXPLANATION OF INSTRUMENTATION SYMBOLS SHOWN ON ELECTRICAL DRAWINGS, SEE INSTRUMENTATION LEGEND AND NOTES ON SHEET I-1.
- PROVIDE CONDUIT AND WIRE FOR ALL SURGE PROTECTION DEVICES AT INSTRUMENTS AND INSTRUMENTATION PANELS. SURGE PROTECTION DEVICES TO BE PROVIDED BY DIVISION 13 SUPPLIER. INSTALLATION OF INSTRUMENTATION AND ACCESSORIES BY DIVISION 13 CONTRACTOR.
- CONDUIT AND WIRE (NOT SHOWN) FOR THE HVAC CONTROL EQUIPMENT AND MISCELLANEOUS DEVICES SHALL BE FURNISHED AND INSTALLED UNDER DIVISION 15 OF SPECIFICATIONS AND SHALL BE:
A. 3/4" (MIN.) CONDUIT.
B. NO. 14 CU. WIRE (MIN.) TYPE "THWN/THHN" NO. OF WIRES AS REQUIRED
- CONDUIT AND WIRE (NOT SHOWN) FOR LIGHTING FIXTURES, SWITCHES AND/OR RECEPTACLES SHALL BE FURNISHED AND INSTALLED BY THE ELECTRICAL CONTRACTOR AND SHALL BE:
A. 3/4" (MIN.) CONDUIT OR MC CABLE IN FINISHED WALLS/CEILINGS
B. CONCEALED ABOVE SUSPENDED CEILINGS AND IN WALLS IN FINISHED AREAS.
B. NO. 12 CU. WIRE (MIN.) TYPE "THWN/THHN" NO. OF WIRES AS REQUIRED, INCLUDING GROUND.
- OUTLET, SWITCH, JUNCTION, PULL AND TERMINAL BOXES SHALL BE PROVIDED WITH NEMA ENCLOSURE AS INDICATED ON THE EQUIPMENT ENCLOSURE SCHEDULE.
- DUCTLINE CONDUIT SIZES ARE GIVEN IN THE DUCTBANK CABLE/CONDUIT SCHEDULE, WHERE THE SAME CONDUIT NUMBER IS USED BOTH IN THE DUCTLINE AND IN A BUILDING. THE CONDUIT SIZE GIVEN IN THE CONDUIT SCHEDULE APPLIES TO THE CONDUIT IN THE BUILDING ONLY.
- ALL CONDUIT RUNS CROSSING EXPANSION JOINTS SHALL HAVE EXPANSION OR EXPANSION AND DEFLECTION TYPE FITTINGS AS REQUIRED. FOR EXACT LOCATIONS OF EXPANSION JOINTS SEE STRUCTURAL DRAWINGS.
- SWITCHGEAR AND MCC COMPARTMENT DESIGNATIONS AS INDICATED BELOW:
BLANK: NOT INTENDED FOR USE, PLATE ONLY.
SPACE: CONTAINS NECESSARY BUS AND HARDWARE FOR FUTURE ADDITION OF BREAKERS OR STARTERS WITHIN SIZE RANGE SHOWN.
SPARE: CONTAINS A COMPLETE BREAKER OR STARTER INSTALLED, SIZE AS INDICATED AVAILABLE FOR FUTURE USE.
- ALL MOTOR STARTER CONTROL TRANSFORMERS SHALL BE SIZED TO PROVIDE SUFFICIENT VOLT-AMPERE CAPACITY FOR OPERATING ALL ELECTRICAL DEVICES ASSOCIATED WITH CONTROL OF THE MOTOR; IN ADDITION TO THE STARTER COIL, IT SHALL INCLUDE RELAYS, TIMERS, MOTOR HEATERS, INDICATING LIGHTS, ETC.

2	AS-BUILT DRAWING FILE	08/11/2008	BY	
1	ISSUED FOR SET POSTED SET	10/21/06	DATE	
0	ISSUED FOR CONSTRUCTION	10/28/05	DATE	
B	REV. B AGENCY REVIEW	8/16/05	DATE	
A	REV. A CLIENT REVIEW	7/22/05	DATE	

ROBERT H. SHELDON
No. 4103
Professional Engineer
State of Massachusetts

PAWTUCKET, RHODE ISLAND
PAWTUCKET REGIONAL
WATER TREATMENT FACILITY
PKGS 11 & 12 - RAW WATER PUMP STATION
LEGEND, ABBREVIATIONS AND GENERAL NOTES

DESIGNED BY	DWG SCALE
DM	AS NOTED
DRAWN BY	CONTRACT NO.
DM	
CHECKED BY	DATE
WS	OCTOBER 31, 2006

EARTH TECH
AS-BUILT FILE
MAY 2008



NO.	DATE	BY	REVISIONS
2	MAY 2008	DM	AS-BUILT DRAWING FILE
1	10/21/06	DM	ISSUED FOR RFI POSTED SET
0	10/28/05	DM	ISSUED FOR CONSTRUCTION
B	8/16/05	DM	REV. B AGENCY REVIEW
A	7/22/05	DM	REV. A CLIENT REVIEW

ROBERT H. SHELDON
No. 4103
3/17/09

PAWTUCKET, RHODE ISLAND
PAWTUCKET REGIONAL WATER TREATMENT FACILITY
PAGES 11 & 12 - RAW WATER PUMP STATION
SITE PLAN


DESIGNED BY	DM	DWG SCALE	AS NOTED
DRAWN BY	DM	CONTRACT NO.	
CHECKED BY	WS	DATE	OCTOBER 31, 2006

SYMBOL	CONDUIT SIZE	CONDUCTORS	FROM	TO	REMARKS
D1	5"	PRIMARY CABLE	UTILITY RISER POLE	TRANSFORMER	CABLE PROVIDED BY UTILITY
D2	5"	SPARE	UTILITY RISER POLE	TRANSFORMER	
D3	4"	3-400KCMIL, 1#4/0 N & 1#2/0 GRD	RWPS MCC2	GENERATOR	
D4	4"	3-400KCMIL, 1#4/0 N & 1#2/0 GRD	UTILITY TRANSFORMER	RWPS MCC2	
D5	4"	SPARE	UTILITY TRANSFORMER	RWPS MCC2	
D6	3"	12 PAIR TELEPHONE WITH JACKET	UTILITY RISER POLE	TELEPHONE BACKBOARD	
D7	2"	16#14	GENERATOR	SCADA CONTROL PANEL RWPSCP	
D8	3"	3#1/0, 1#4/0 N & 1#2 GRD	RWPS MCC2	EXISTING BUILDING POWER FEED	TO 480V DELTA TRANSFORMER
D9	3"	SPARE	RWPS MCC2	EXISTING BUILDING POWER FEED	CAP AT WALL
D10	2"	20#14	GENERATOR	JB1 IN ELECTRICAL ROOM	RWPSCP,E-STOP,REMOTE ANNUNCIATOR
D13	2"	SCADA (10#14)	RWPSCP	EXISTING BUILDING CONTROL PANEL	
D14	2"	TYPE/QUANTITY BY MANUFACTURER	RWPSCP	EXISTING BUILDING SECURITY	CAP AT WALL
D15	2"	TYPE/QUANTITY BY MANUFACTURER	RWPS FACP	EXISTING BUILDING FIRE ALARM	
D16	2"	12 PAIR TELEPHONE WITH JACKET	RWPS TELEPHONE BACKBOARD	EXISTING BUILDING TELEPHONE	
D17	2"	ANTENNA CABLE	RWPSCP	SCADA ANTENNA	CABLE SUPPLIED IN DIVISION 13
D18	2"	2-2/C#16 TS	HAND HOLE	FIT-600	
D19	2"	SPARE	HAND HOLE	VAULT	
D20	2"	7#8 & 3#8 GND	PANEL LP1	GENERATOR	120V GENERATOR LOADS
D21	2"	8#8 & 4#8 GND	PANEL LP1	GENERATOR	120V GENERATOR LOADS
D22	2"	5-2/C#16 TS	RWPSCP	HAND HOLD	
D23	2"	SPARE	RWPSCP	HAND HOLD	
D24	2"	3-2/C#16 TS	HAND HOLE	GATE HOUSE	

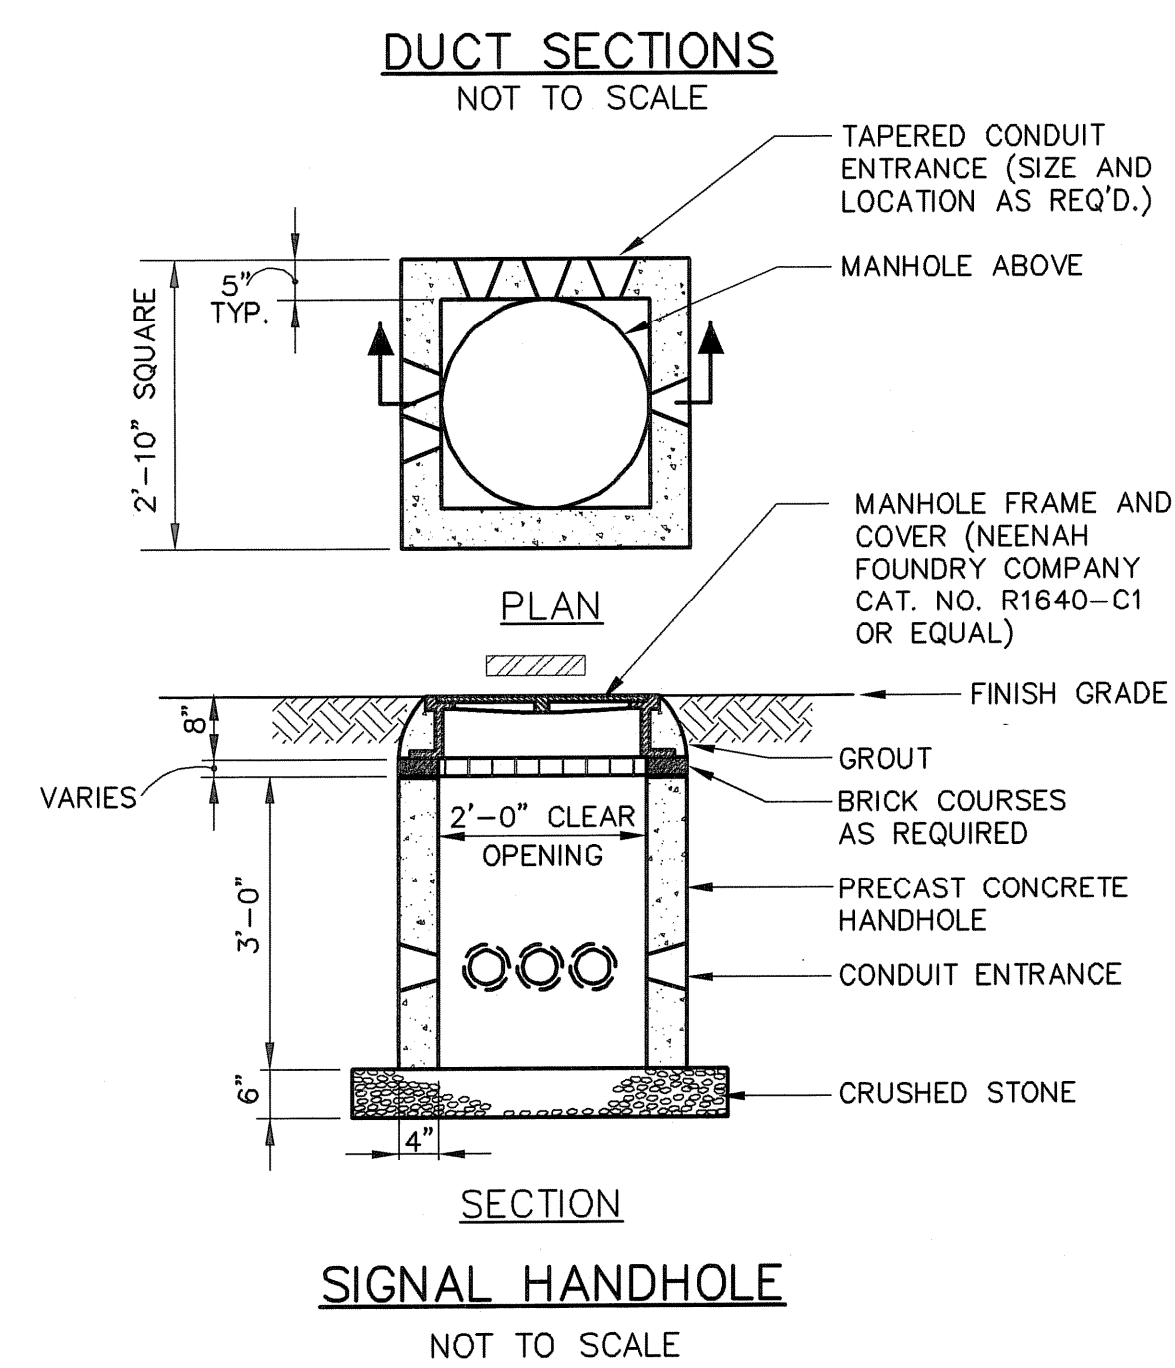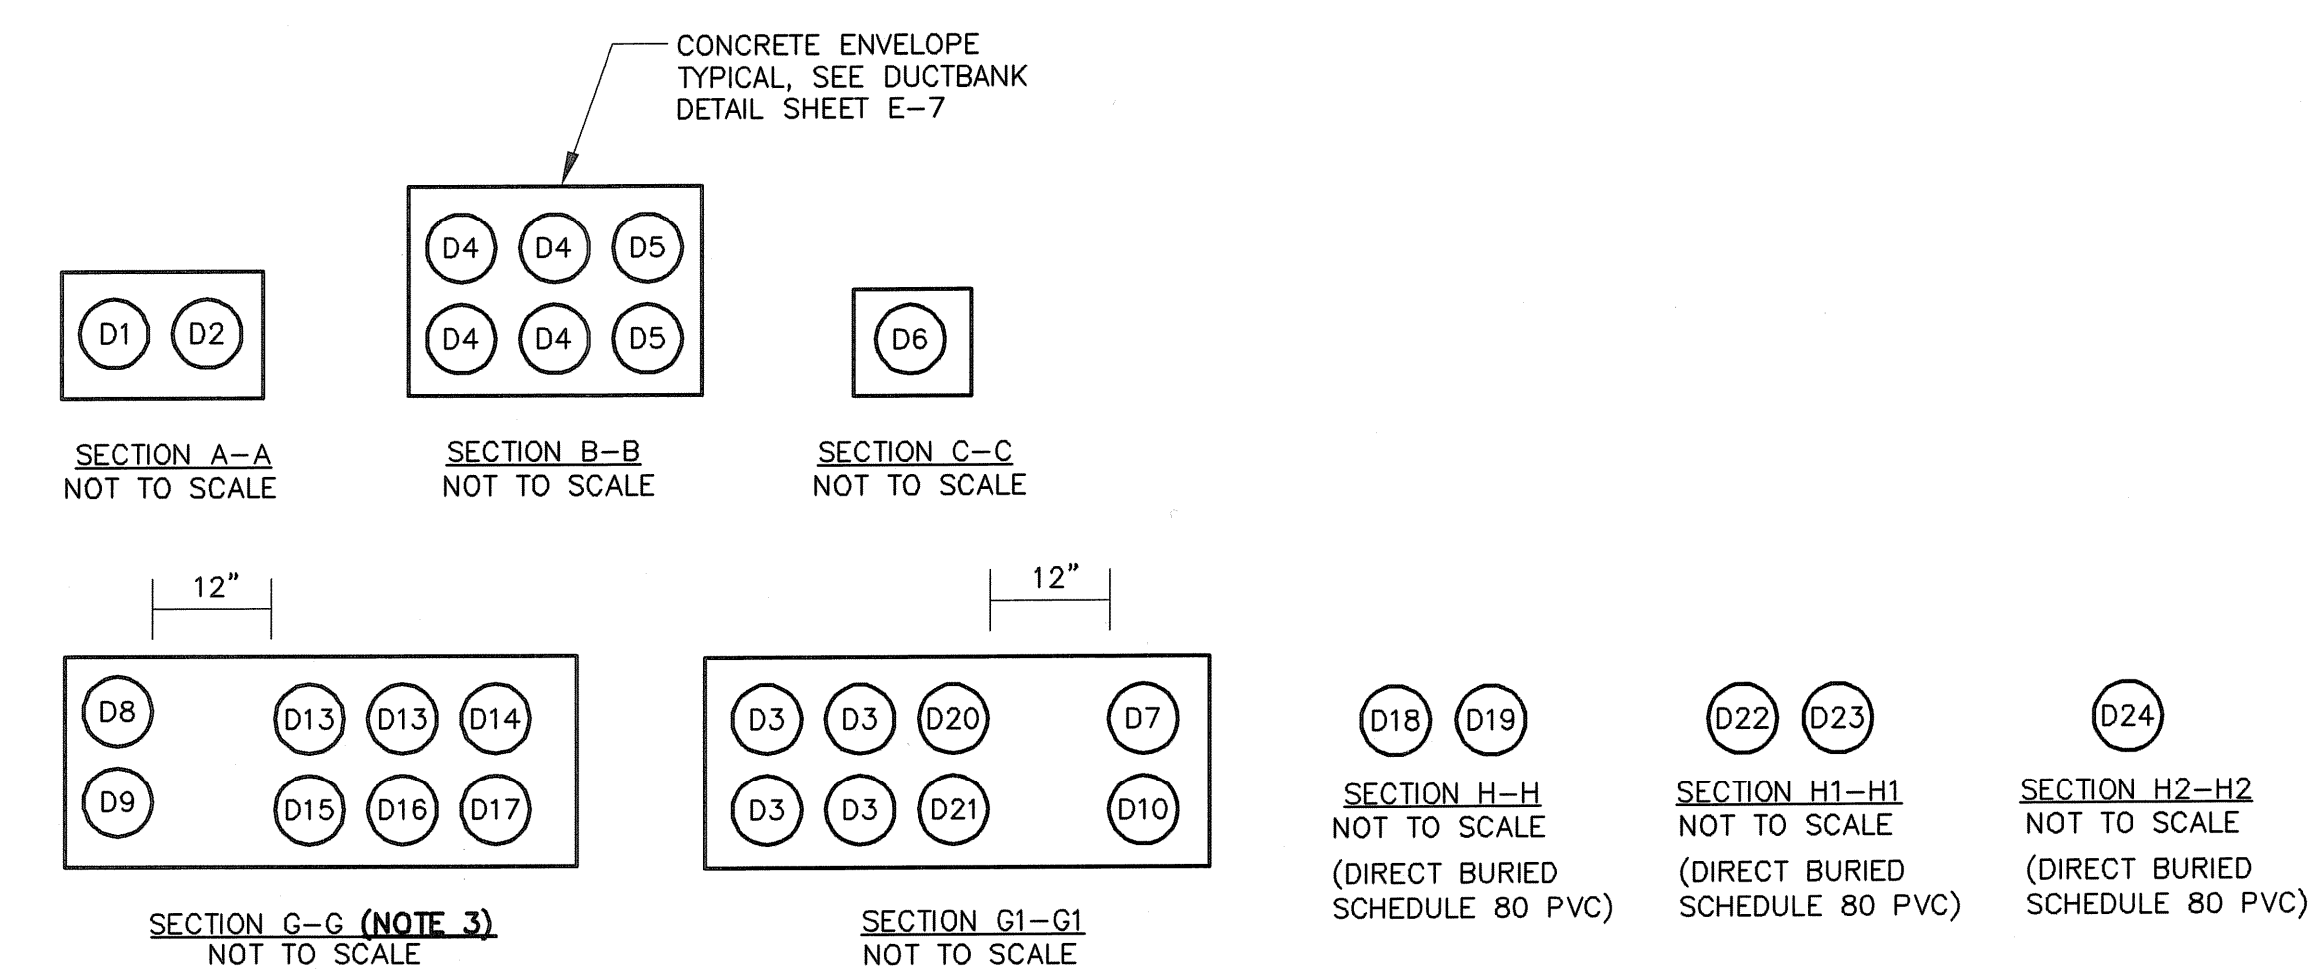


- NOTES:
- FOR LEGEND, ABBREVIATIONS AND GENERAL NOTES SEE SHEET E-1.
 - ELECTRICAL WORK ASSOCIATED WITH RE-FEEDING THE EXISTING STRUCTURE, EMERGENCY LIGHTING, FIRE ALARM, TELEPHONE AND SECURITY SYSTEMS IN THE EXISTING STRUCTURE NOT SHOWN.
 - DUCTBANK G-G AND ASSOCIATED HANDHOLES, PULLBOXES, CONDUIT AND WIRE SHALL BE AN ADD ALTERNATE AND NOT IN THE PROJECT SCOPE.

EARTH TECH
AS-BUILT FILE
MAY 2008

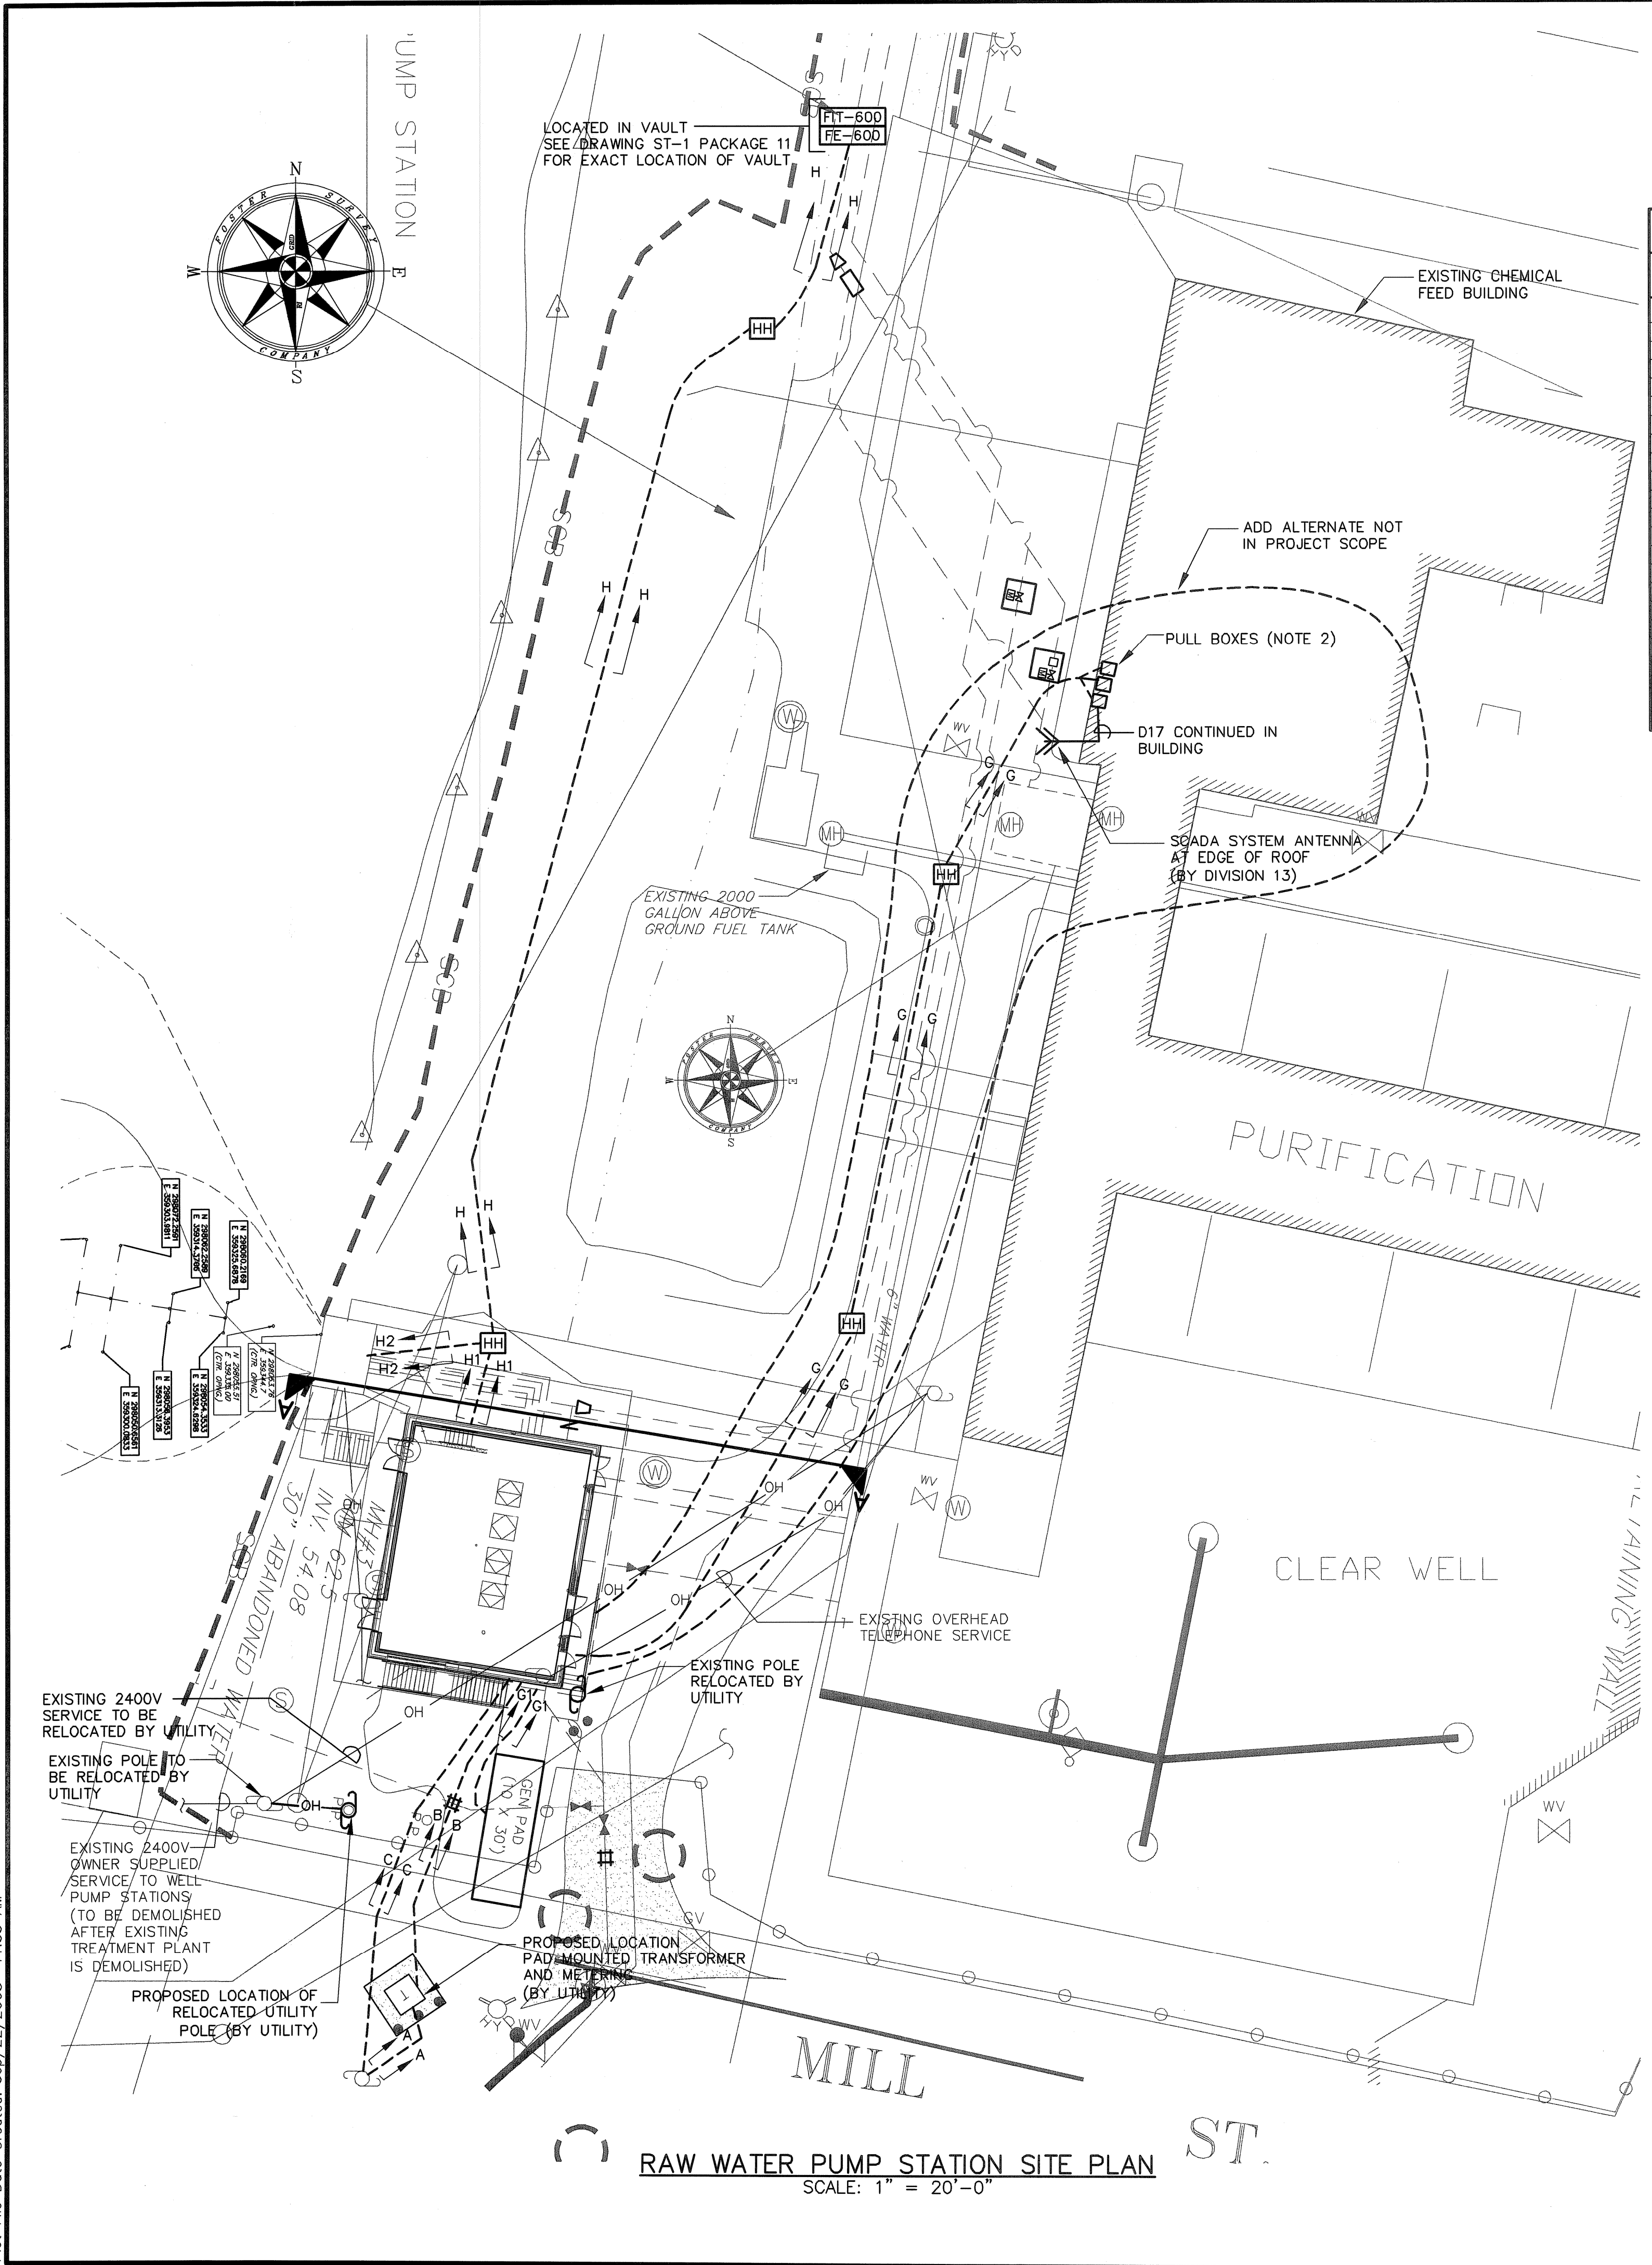


RAW WATER PUMP STATION SITE PLAN
SCALE: 1" = 20'-0"

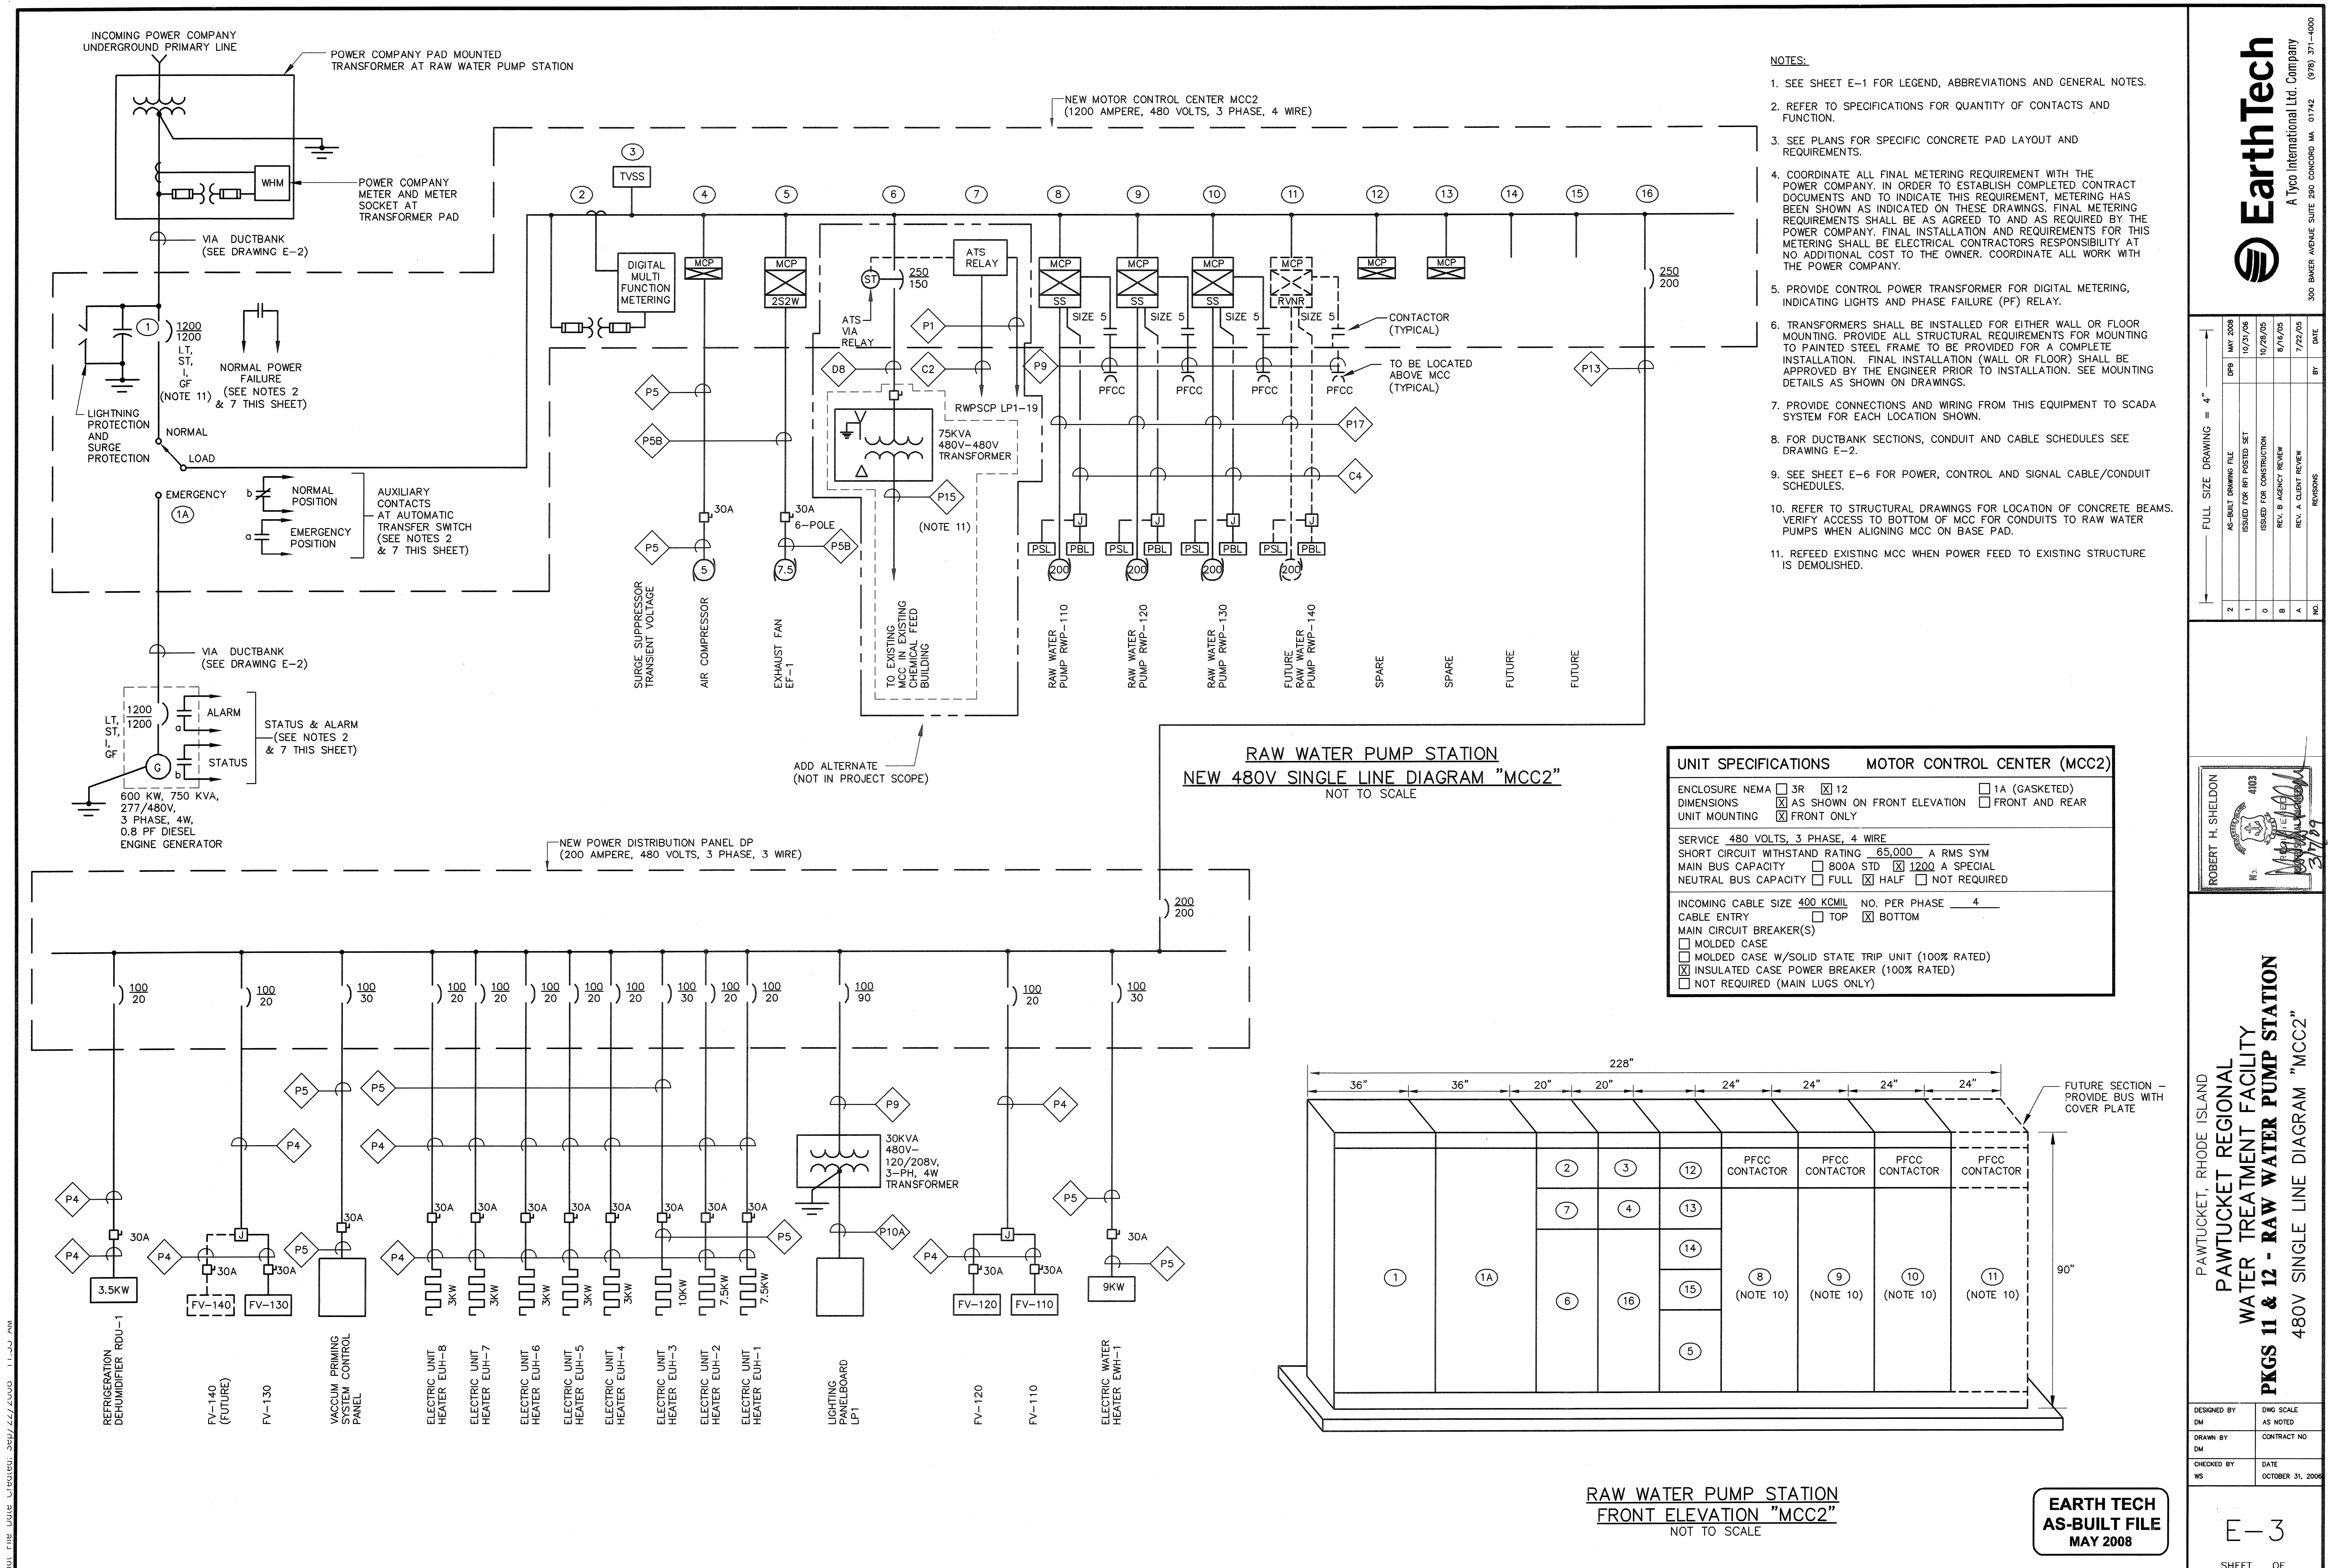

- NOTES:**
- SEE SHEET E-1 FOR LEGEND, ABBREVIATIONS AND GENERAL NOTES.
 - REFER TO SPECIFICATIONS FOR QUANTITY OF CONTACTS AND FUNCTION.
 - SEE PLANS FOR SPECIFIC CONCRETE PAD LAYOUT AND REQUIREMENTS.
 - COORDINATE ALL FINAL METERING REQUIREMENT WITH THE POWER COMPANY. IN ORDER TO ESTABLISH COMPLETED CONTRACT DOCUMENTS AND TO INDICATE THIS REQUIREMENT, METERING HAS BEEN SHOWN AS INDICATED ON THESE DRAWINGS. FINAL METERING REQUIREMENTS SHALL BE AS AGREED TO AND AS REQUIRED BY THE POWER COMPANY. FINAL INSTALLATION AND REQUIREMENTS FOR THIS METERING SHALL BE ELECTRICAL CONTRACTORS RESPONSIBILITY AT NO ADDITIONAL COST TO THE OWNER. COORDINATE ALL WORK WITH THE POWER COMPANY.
 - PROVIDE CONTROL POWER TRANSFORMER FOR DIGITAL METERING, INDICATING LIGHTS AND PHASE FAILURE (PF) RELAY.
 - TRANSFORMERS SHALL BE INSTALLED FOR EITHER WALL OR FLOOR MOUNTING. PROVIDE ALL STRUCTURAL REQUIREMENTS FOR MOUNTING TO PAINTED STEEL FRAME TO BE PROVIDED FOR A COMPLETE INSTALLATION. FINAL INSTALLATION (WALL OR FLOOR) SHALL BE APPROVED BY THE ENGINEER PRIOR TO INSTALLATION. SEE MOUNTING DETAILS AS SHOWN ON DRAWINGS.
 - PROVIDE CONNECTIONS AND WIRING FROM THIS EQUIPMENT TO SCADA SYSTEM FOR EACH LOCATION SHOWN.
 - FOR DUCTBANK SECTIONS, CONDUIT AND CABLE SCHEDULES SEE DRAWING E-2.
 - SEE SHEET E-6 FOR POWER, CONTROL AND SIGNAL CABLE/CONDUIT SCHEDULES.
 - REFER TO STRUCTURAL DRAWINGS FOR LOCATION OF CONCRETE BEAMS. VERIFY ACCESS TO BOTTOM OF MCC FOR CONDUITS TO RAW WATER PUMPS WHEN ALIGNING MCC ON BASE PAD.
 - REFEED EXISTING MCC WHEN POWER FEED TO EXISTING STRUCTURE IS DEMOLISHED.

**RAW WATER PUMP STATION
NEW 480V SINGLE LINE DIAGRAM "MCC2"**
NOT TO SCALE

UNIT SPECIFICATIONS		MOTOR CONTROL CENTER (MCC2)	
ENCLOSURE NEMA	<input type="checkbox"/> 3R <input checked="" type="checkbox"/> 12	<input type="checkbox"/> 1A (GASKETED)	
DIMENSIONS	<input checked="" type="checkbox"/> AS SHOWN ON FRONT ELEVATION	<input type="checkbox"/> FRONT AND REAR	
UNIT MOUNTING	<input checked="" type="checkbox"/> FRONT ONLY		
SERVICE 480 VOLTS, 3 PHASE, 4 WIRE			
SHORT CIRCUIT WITHSTAND RATING 65,000 A RMS SYM			
MAIN BUS CAPACITY <input type="checkbox"/> 800A STD <input checked="" type="checkbox"/> 1200 A SPECIAL			
NEUTRAL BUS CAPACITY <input type="checkbox"/> FULL <input checked="" type="checkbox"/> HALF <input type="checkbox"/> NOT REQUIRED			
INCOMING CABLE SIZE 400 KCMIL NO. PER PHASE 4			
CABLE ENTRY <input type="checkbox"/> TOP <input checked="" type="checkbox"/> BOTTOM			
MAIN CIRCUIT BREAKER(S)			
<input type="checkbox"/> MOLDED CASE			
<input type="checkbox"/> MOLDED CASE W/SOLID STATE TRIP UNIT (100% RATED)			
<input checked="" type="checkbox"/> INSULATED CASE POWER BREAKER (100% RATED)			
<input type="checkbox"/> NOT REQUIRED (MAIN LUGS ONLY)			

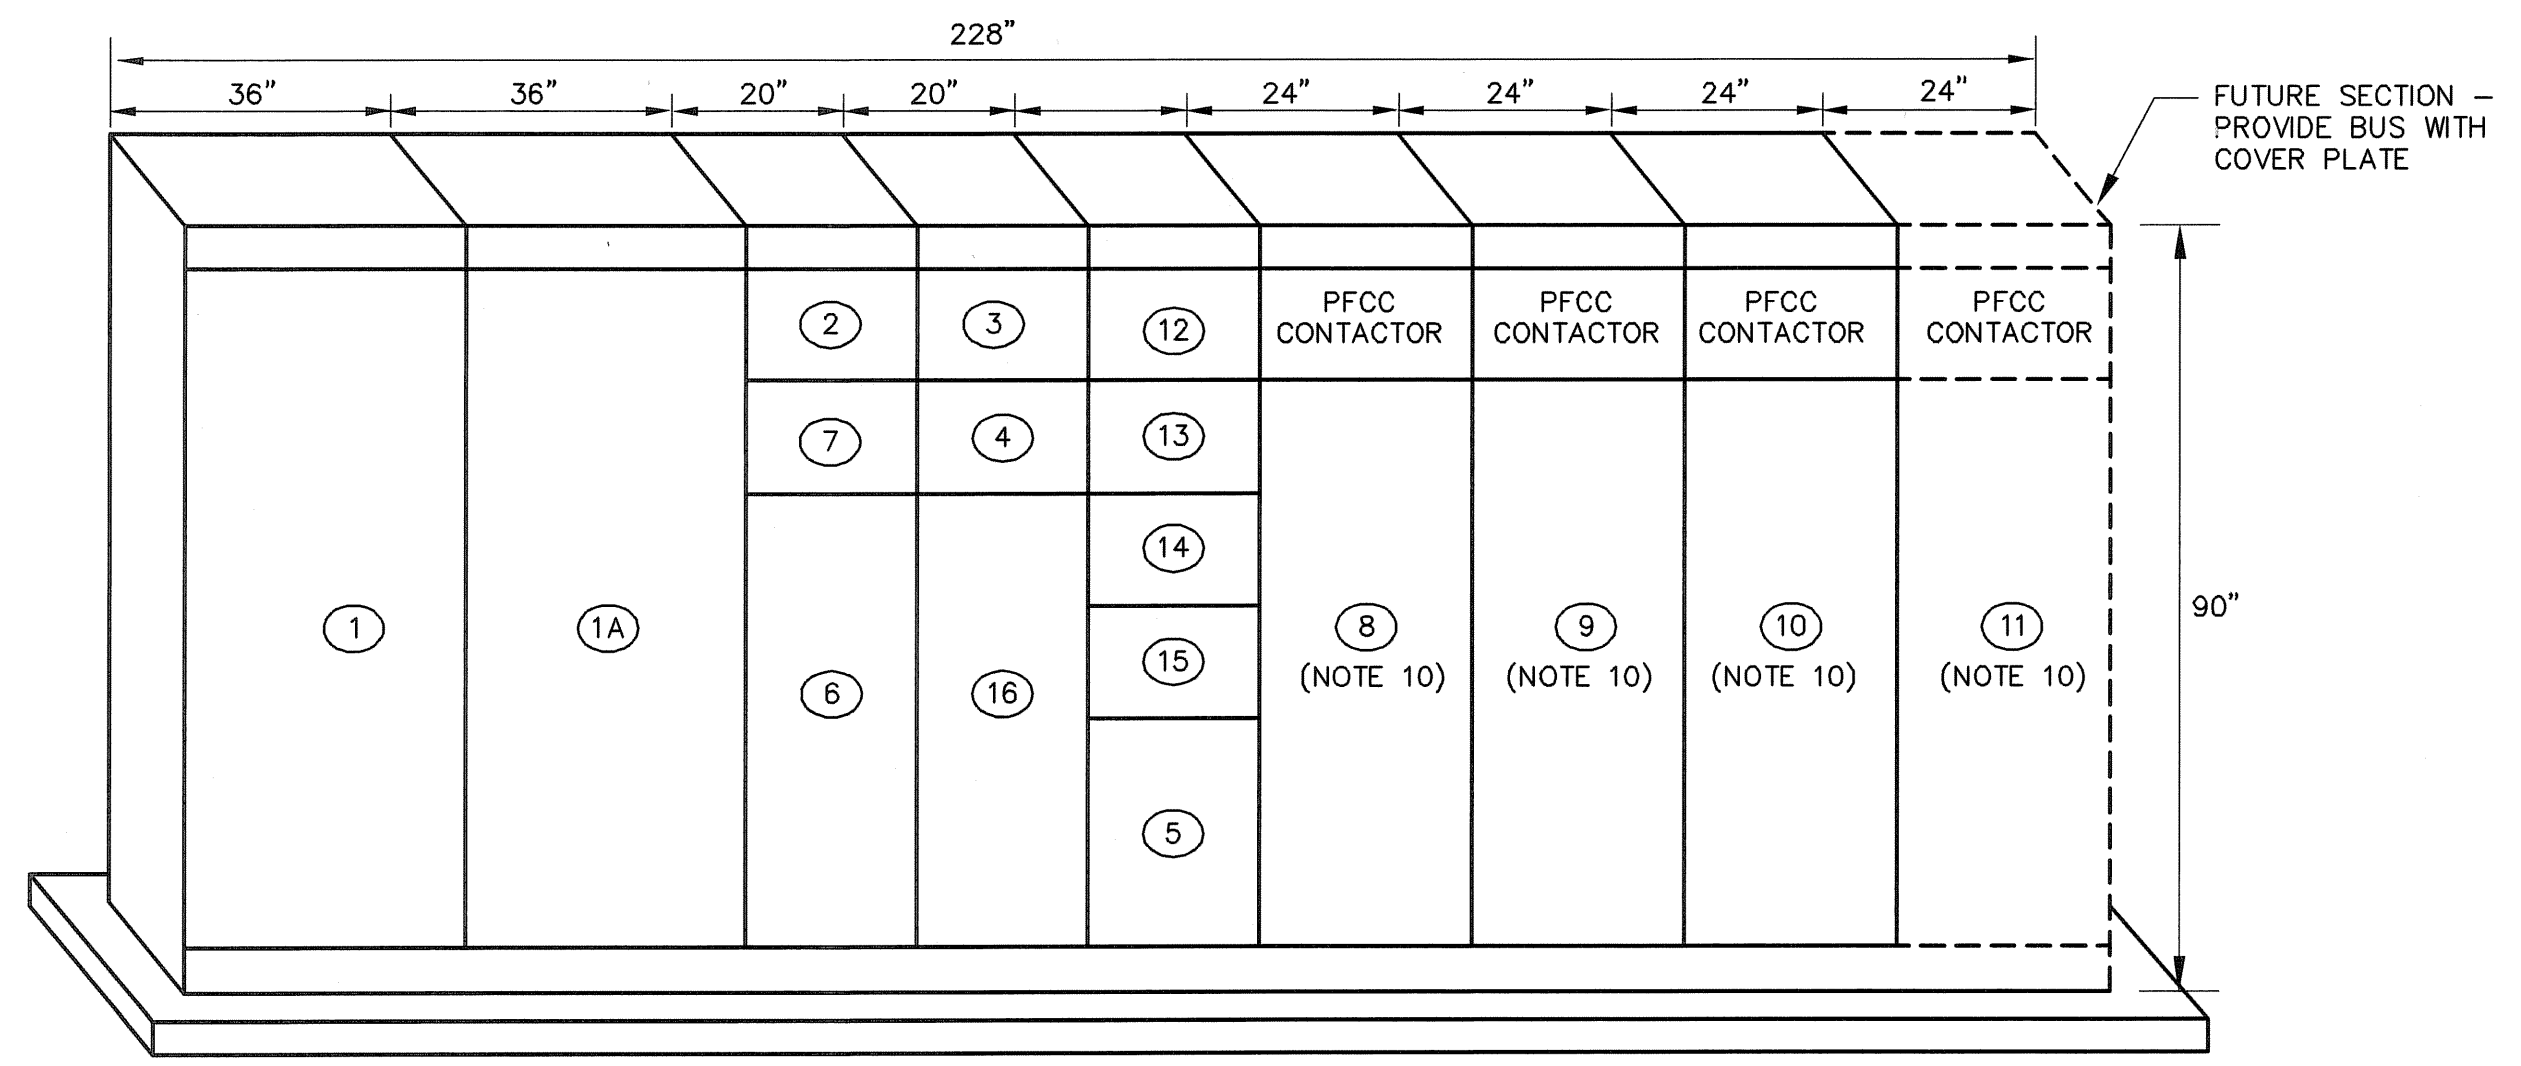

**RAW WATER PUMP STATION
FRONT ELEVATION "MCC2"**
NOT TO SCALE

EARTH TECH
AS-BUILT FILE
MAY 2008


EarthTech
A Tyco International Ltd. Company
300 BAKER AVENUE SUITE 200 CONCORD MA 01742 (978) 371-6000

DATE	BY	REVISIONS
7/22/05	A	REV. A CLIENT REVIEW
6/16/05	B	REV. B AGENCY REVIEW
10/28/05	0	ISSUED FOR CONSTRUCTION
10/21/05	1	ISSUED FOR IPI POSTED SET
10/13/05	2	AS-BUILT DRAWING FILE


PAWTUCKET, RHODE ISLAND
PAWTUCKET REGIONAL WATER TREATMENT FACILITY
PKGS 11 & 12 - RAW WATER PUMP STATION
480V SINGLE LINE DIAGRAM "MCC2"

DESIGNED BY DM
DRAWN BY DM
CHECKED BY WS
DATE OCTOBER 31, 2006
DWG SCALE AS NOTED
CONTRACT NO.
OCTOBER 31, 2006

E-3
SHEET OF

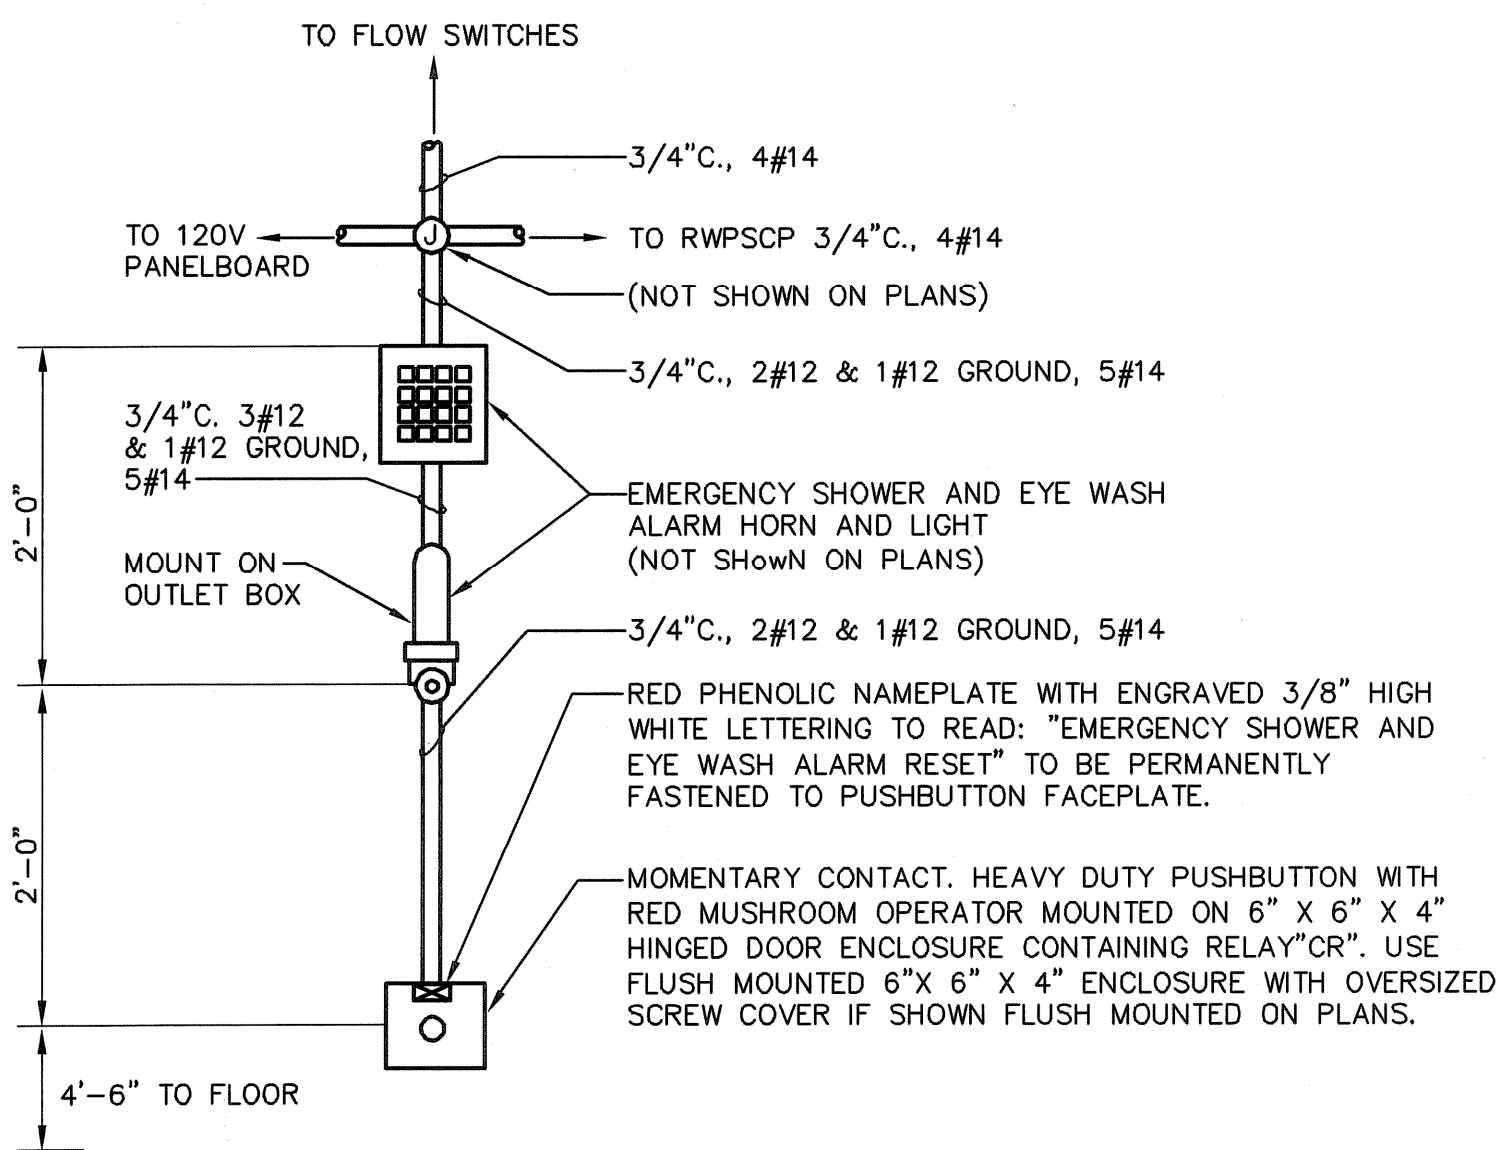

ELEVATION VIEW
NOT TO SCALE

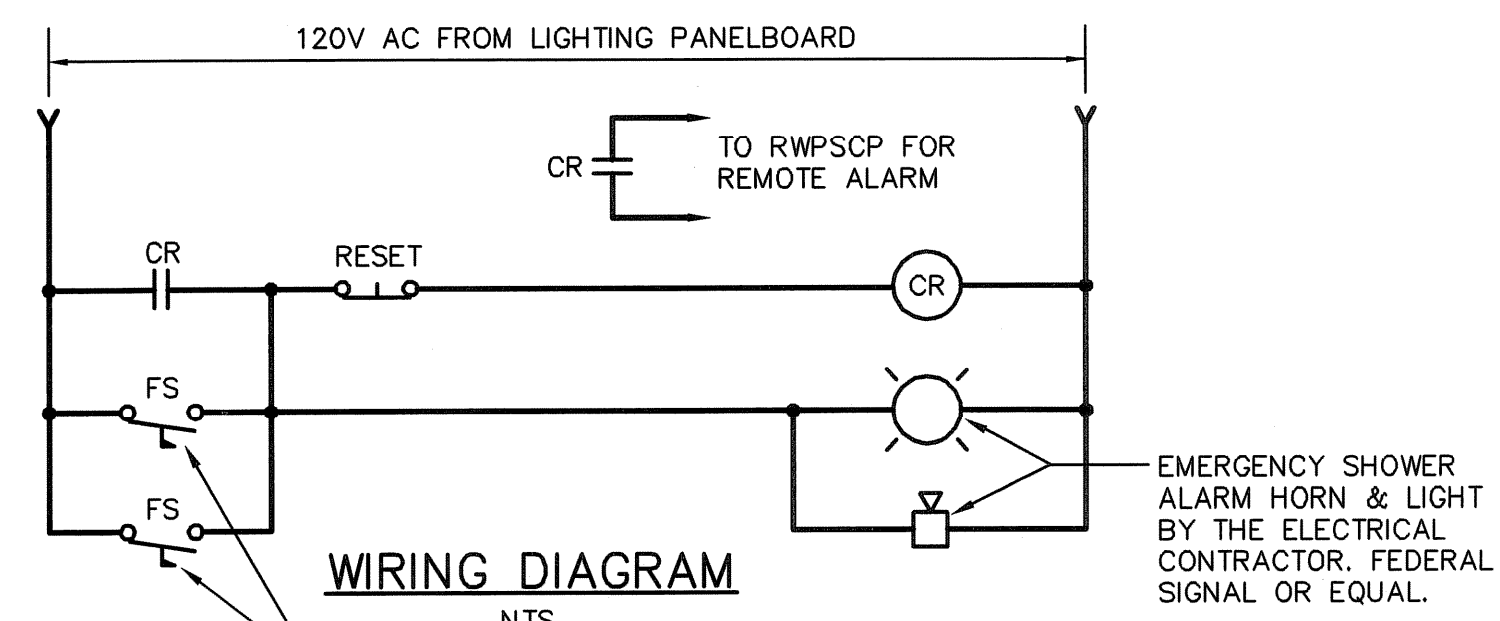


WIRING DIAGRAM
NTS


NOTES:

1. ALL EXPOSED SURFACES OF COMPONENTS SHALL HAVE A YELLOW ENAMEL FINISH, INCLUDING CONDUIT (WITHIN 10'-0" RADIUS OF THE STATION, BOXES, ENCLOSURE AND HORN GRILLE).
2. ALL EQUIPMENT PROVIDED UNDER DIVISION 16 UNLESS OTHERWISE NOTED.


EMERGENCY SHOWER AND EYE WASH ALARM STATION
NOT TO SCALE

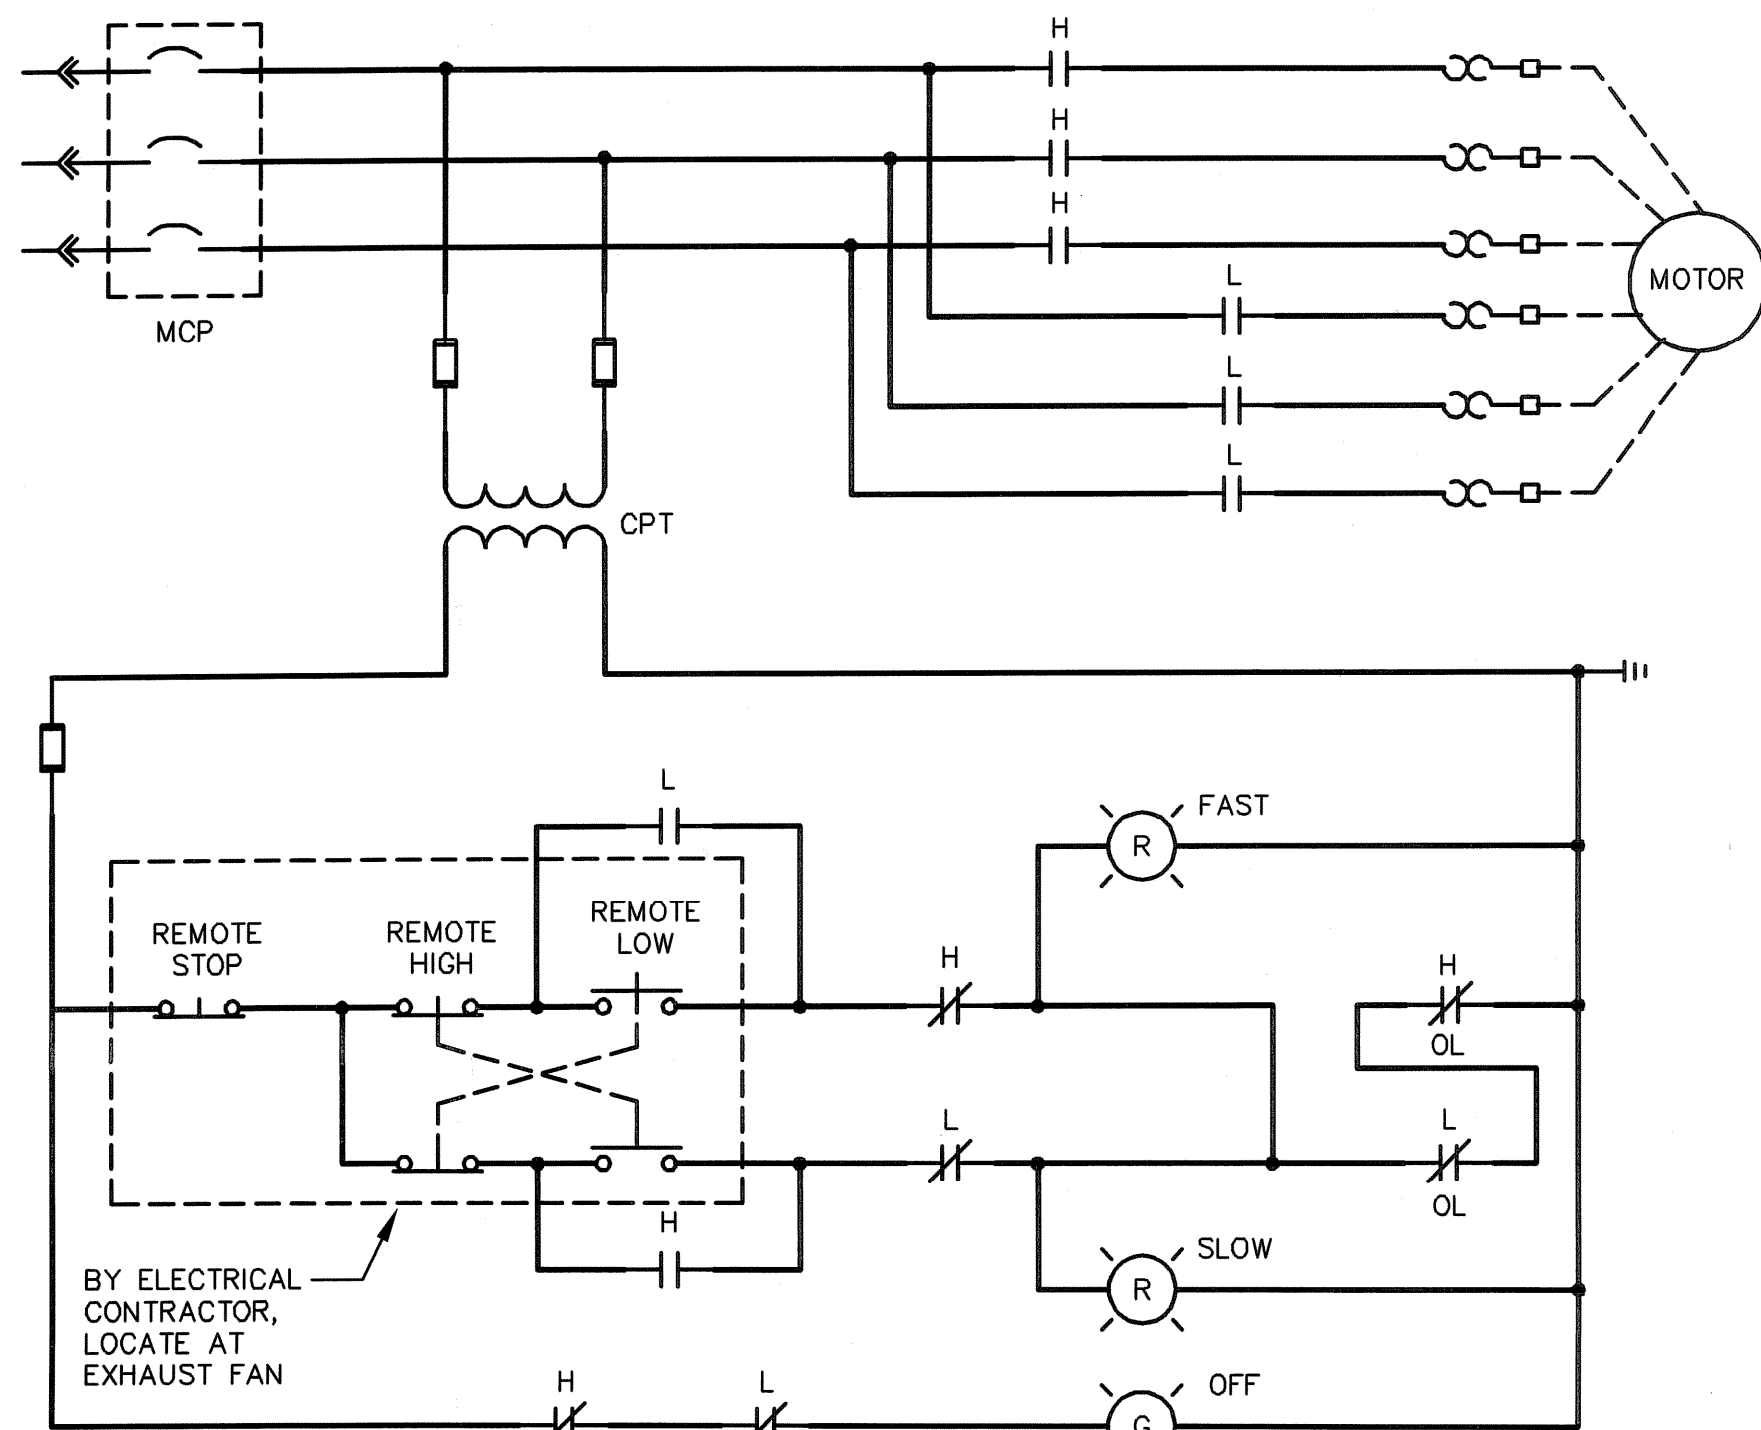



CONTROL WIRING DIAGRAM
2-SPEED, 2-WINDING EXHAUST FAN
NOT TO SCALE

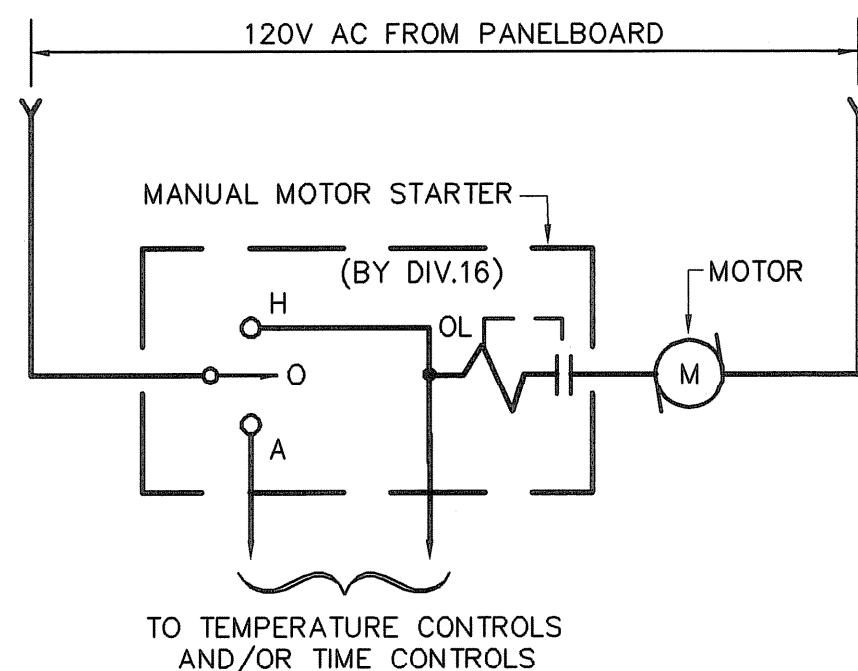


CONTROL WIRING DIAGRAM
1-PHASE EXHAUST FAN
NOT TO SCALE

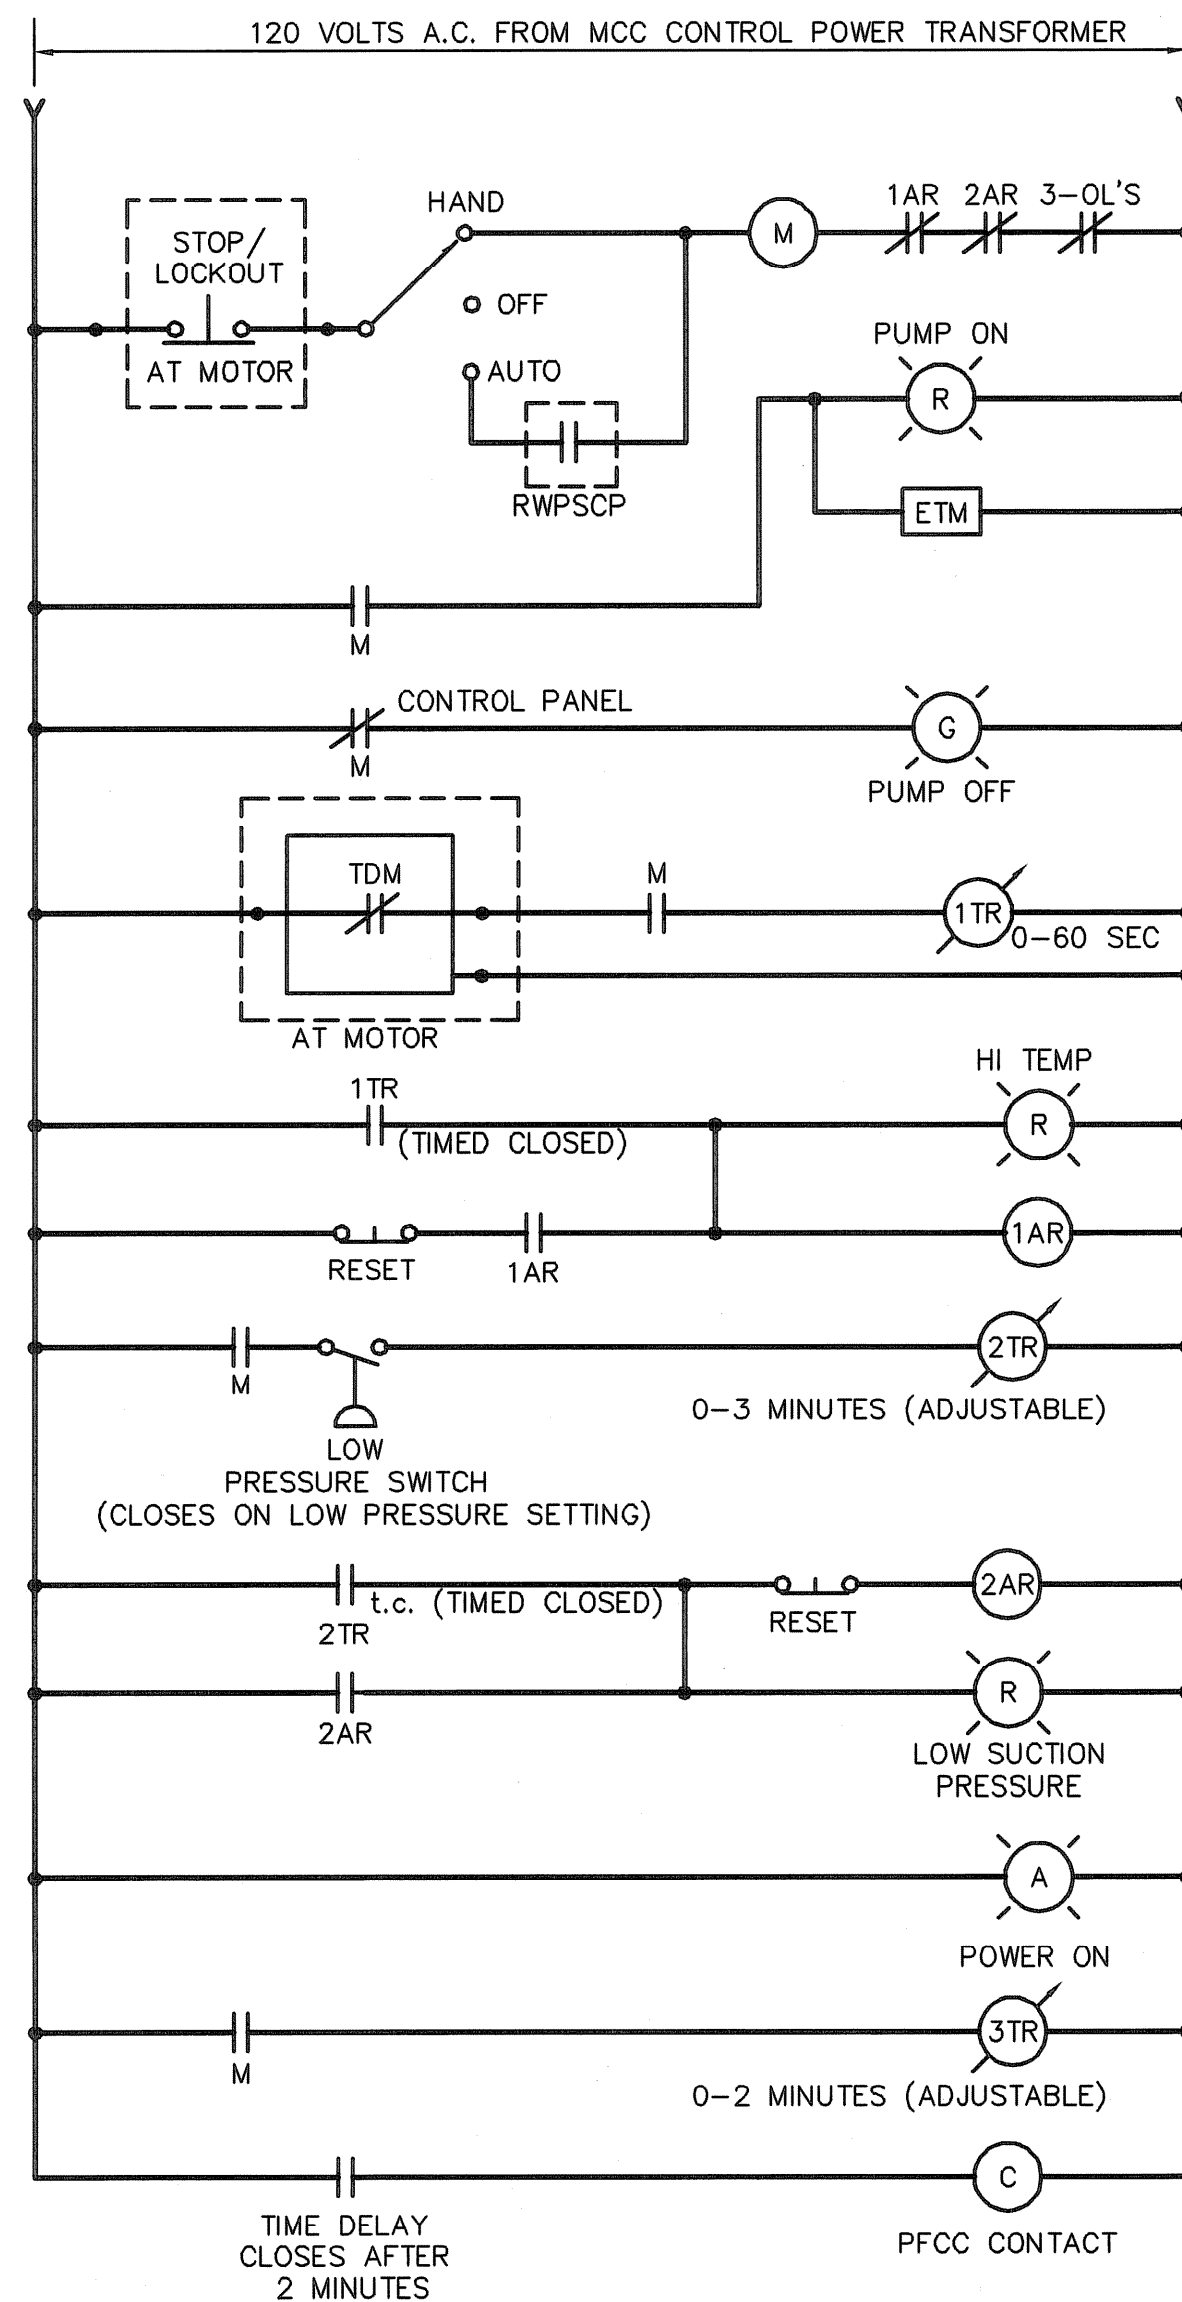


CONTROL WIRING DIAGRAM
RAW WATER PUMPS
NOT TO SCALE
(ALL DEVICES AT MCC UNLESS OTHERWISE NOTED)

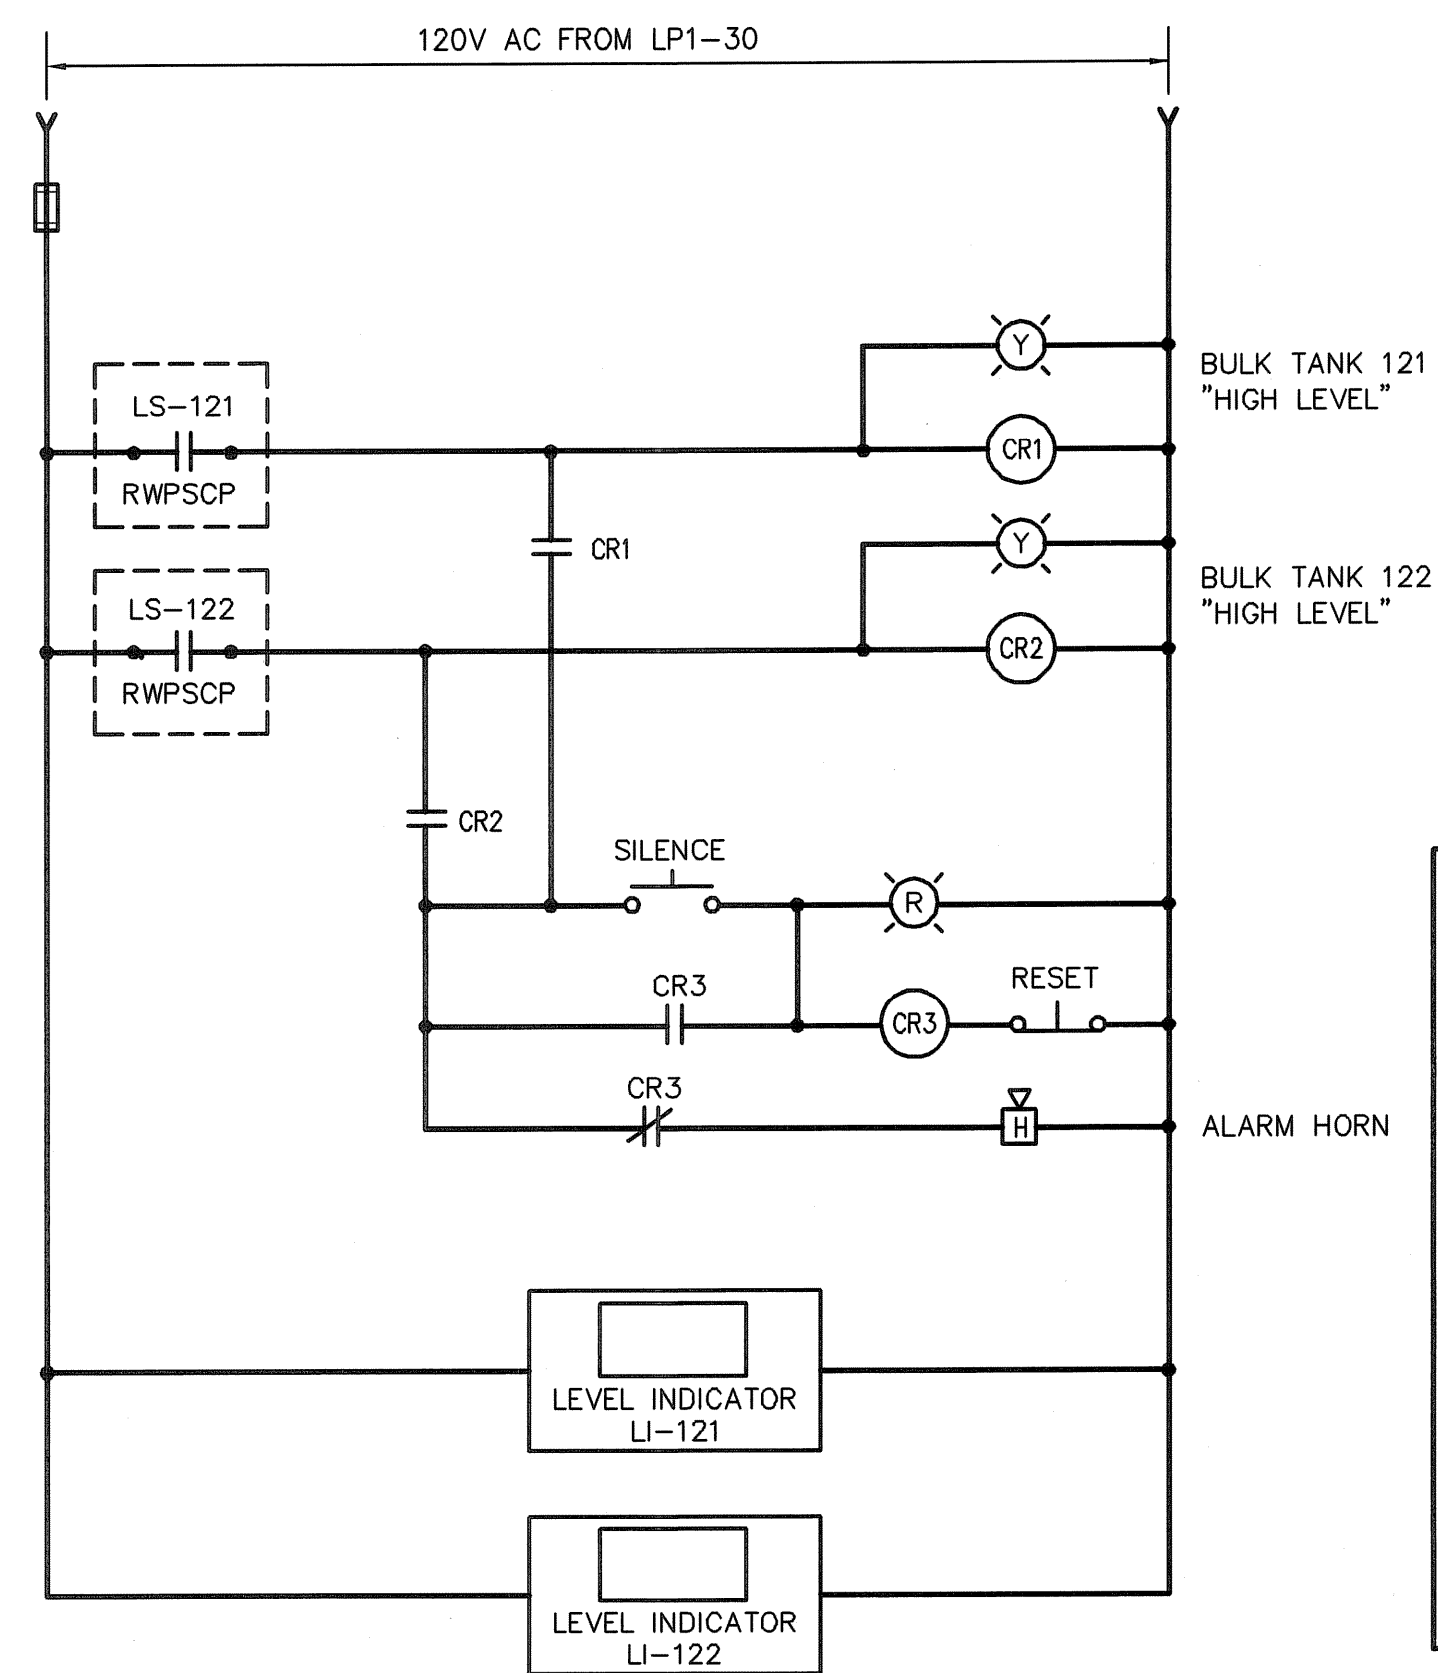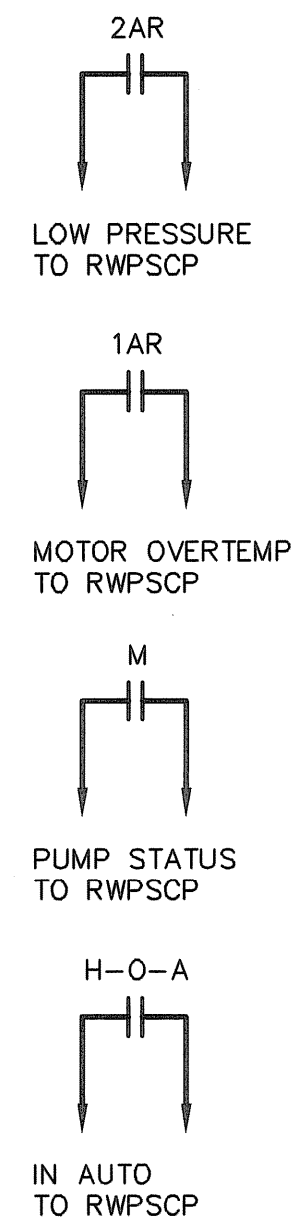

CHEMICAL SYSTEM FILL STATION
WIRING DIAGRAM
NOT TO SCALE

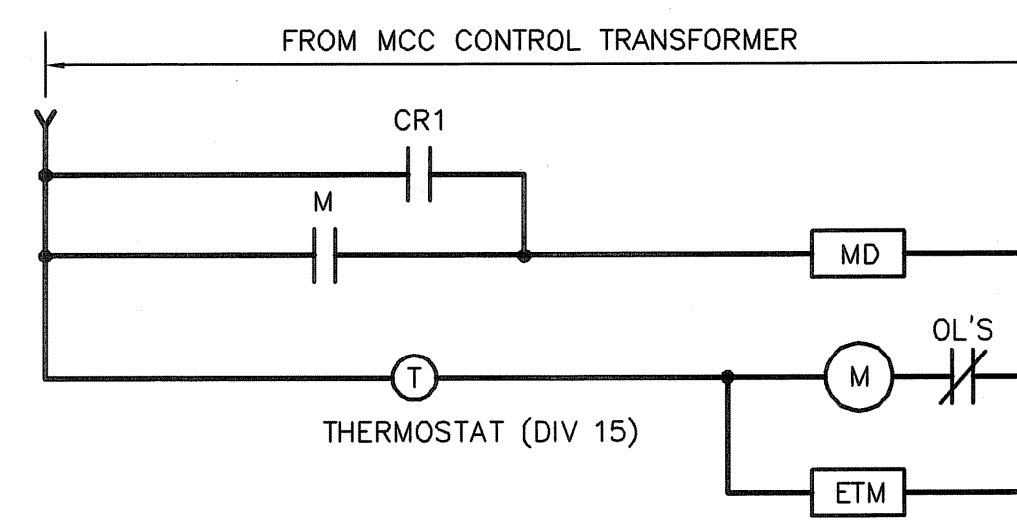

EXHAUST FAN AND DAMPER CONTROL
NOT TO SCALE

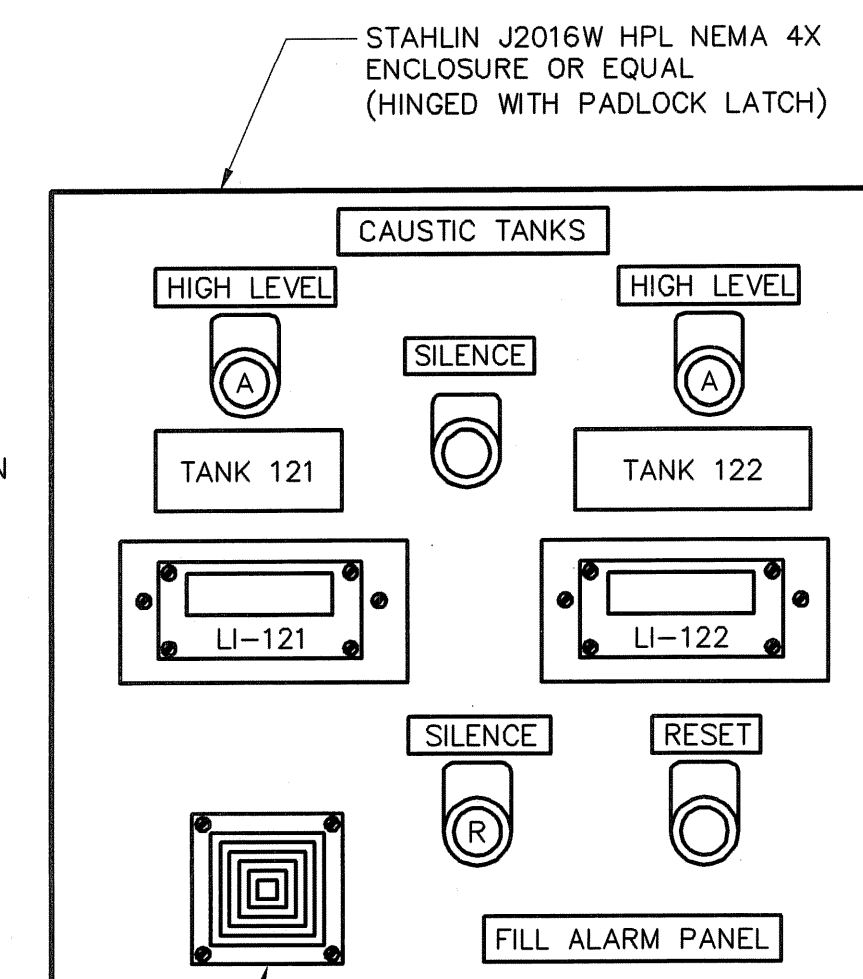

CHEMICAL SYSTEM FILL STATION CONTROL PANEL (CFPCRWS)
NOT TO SCALE
(PROVIDED UNDER DIVISION 13)

FULL SIZE DRAWING = 4"







NO.	DATE	BY	REVISIONS
2	10/27/08	DM	AS-BUILT DRAWING FILE
1	10/27/08	DM	ISSUED FOR RF1 POSTED SET
0	10/28/05	DM	ISSUED FOR CONSTRUCTION
B	8/16/05	DM	REV. B AGENCY REVIEW
A	7/22/05	DM	REV. A CLIENT REVIEW

ROBERT H. SHELDON
Professional Engineer
No. 4103
State of Rhode Island
2/1/09






PAWTUCKET, RHODE ISLAND
PAWTUCKET REGIONAL WATER TREATMENT FACILITY
PKGS 11 & 12 - RAW WATER PUMP STATION
CONTROL WIRING DIAGRAMS

DESIGNED BY	DWG SCALE
DM	NONE
DRAWN BY	CONTRACT NO.
DM	
CHECKED BY	DATE
WS	OCTOBER 31, 2004

EARTH TECH
AS-BUILT FILE
MAY 2008

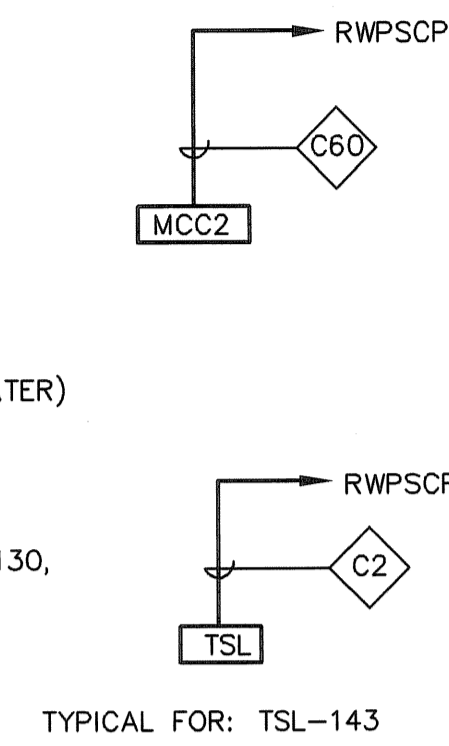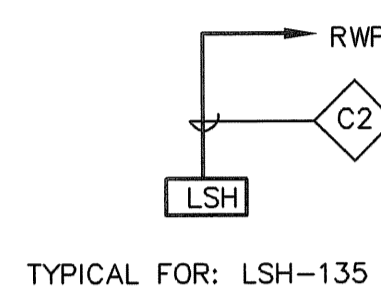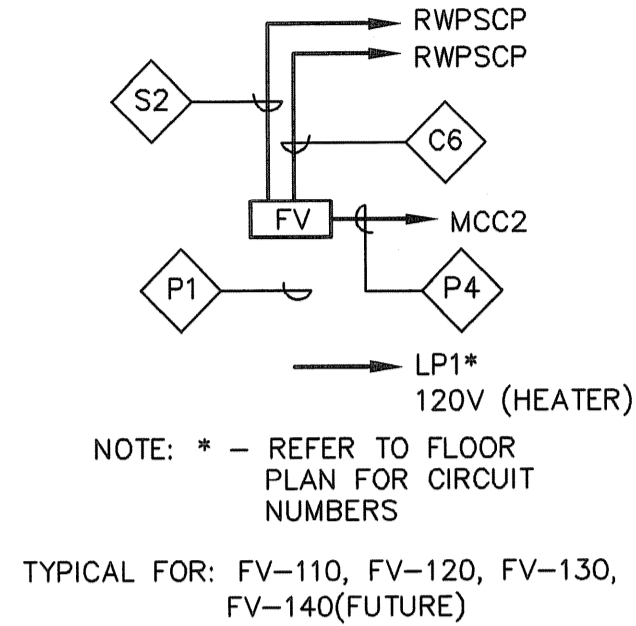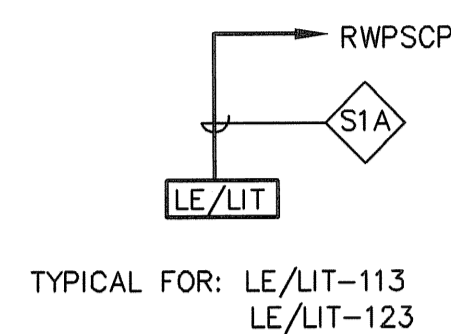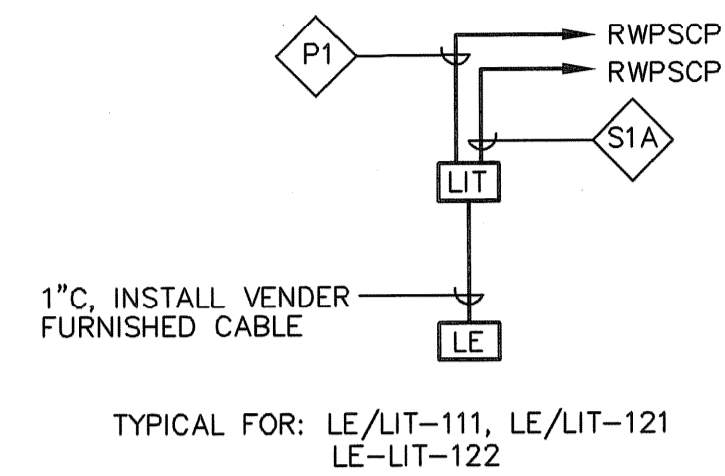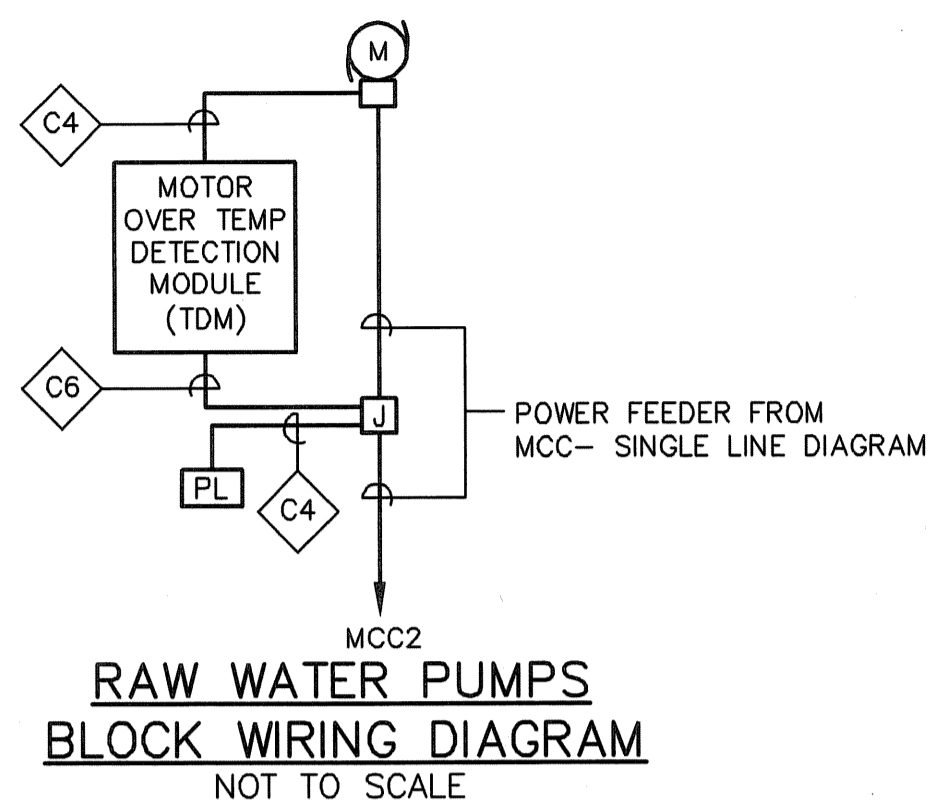


**TYPICAL INSTRUMENTATION
BLOCK WIRING DIAGRAMS**
NOT TO SCALE

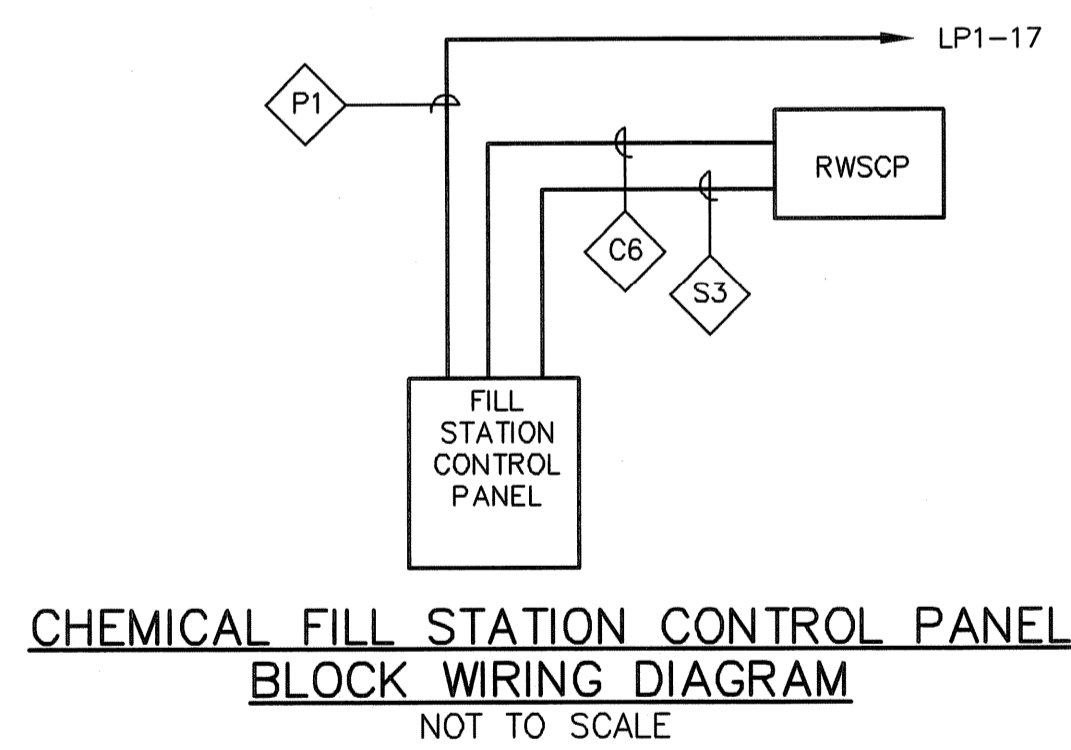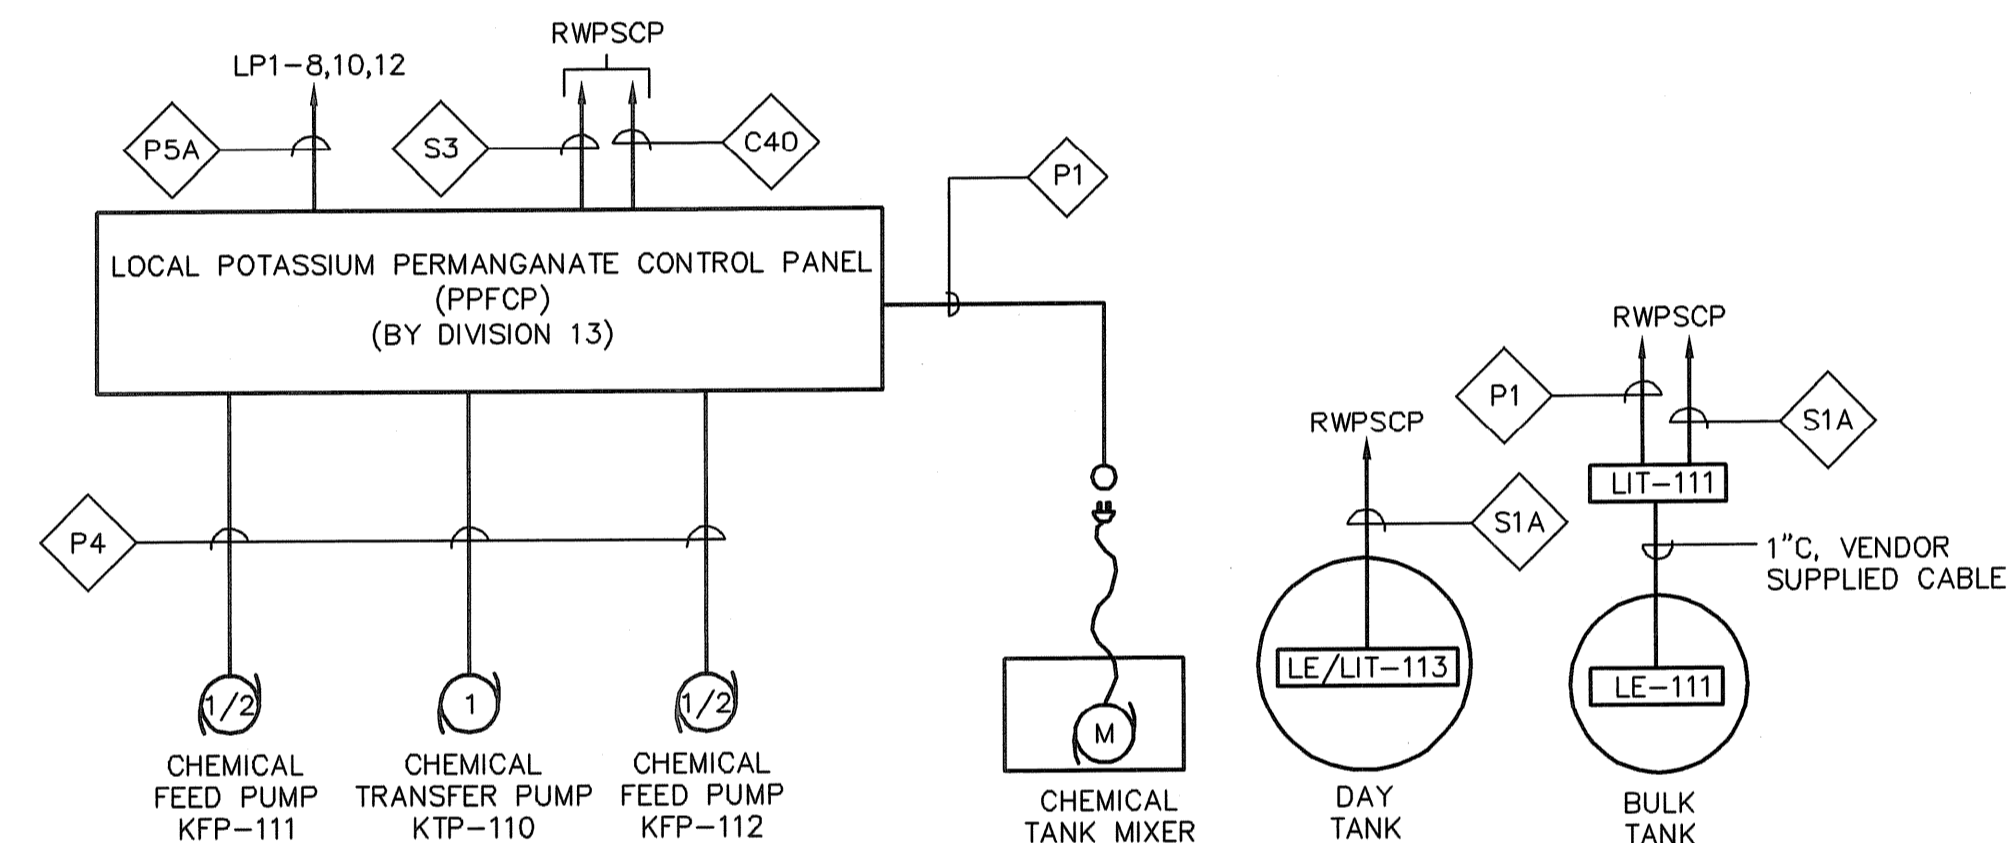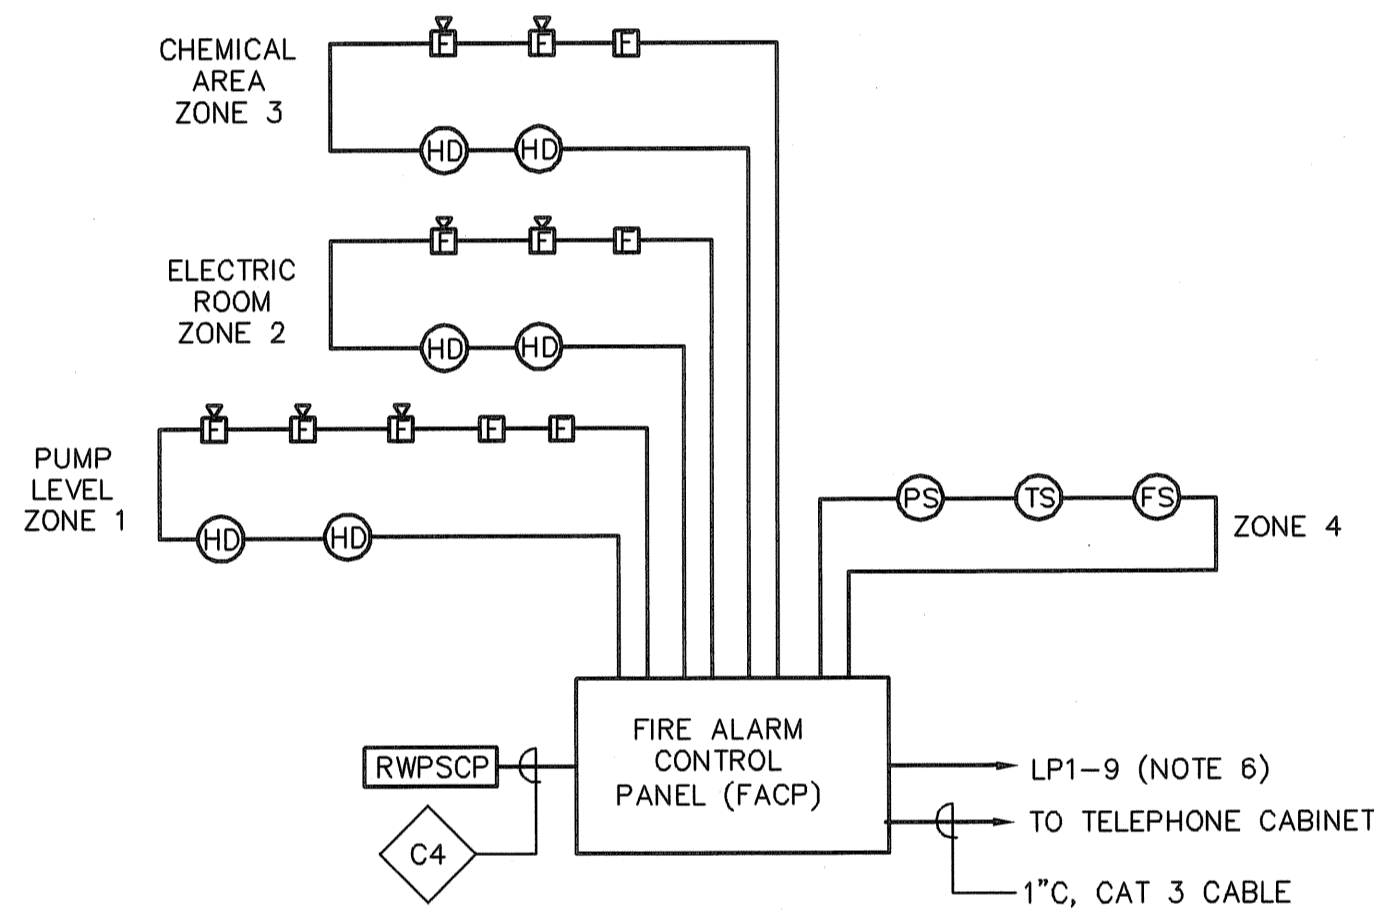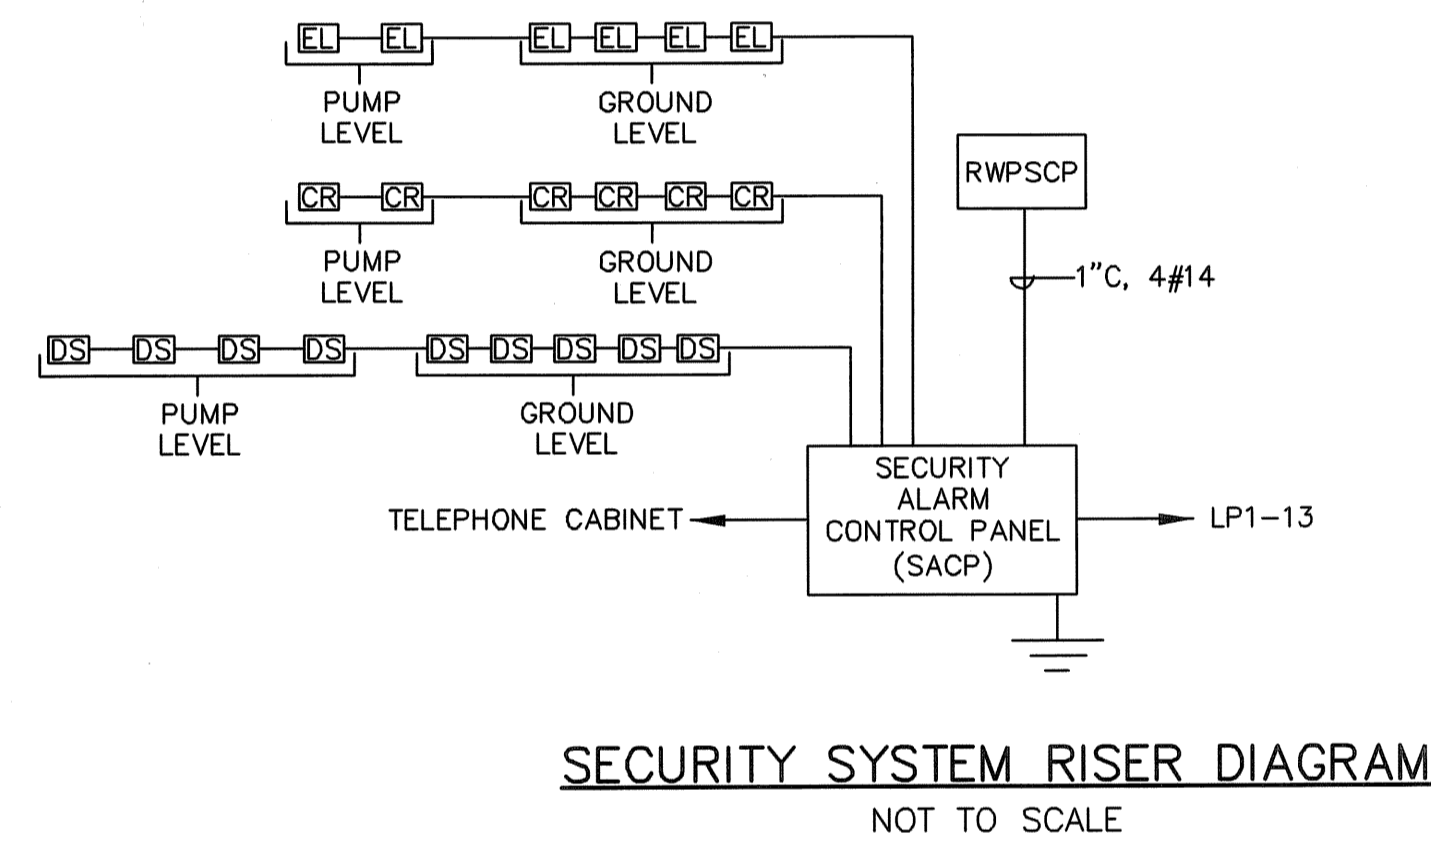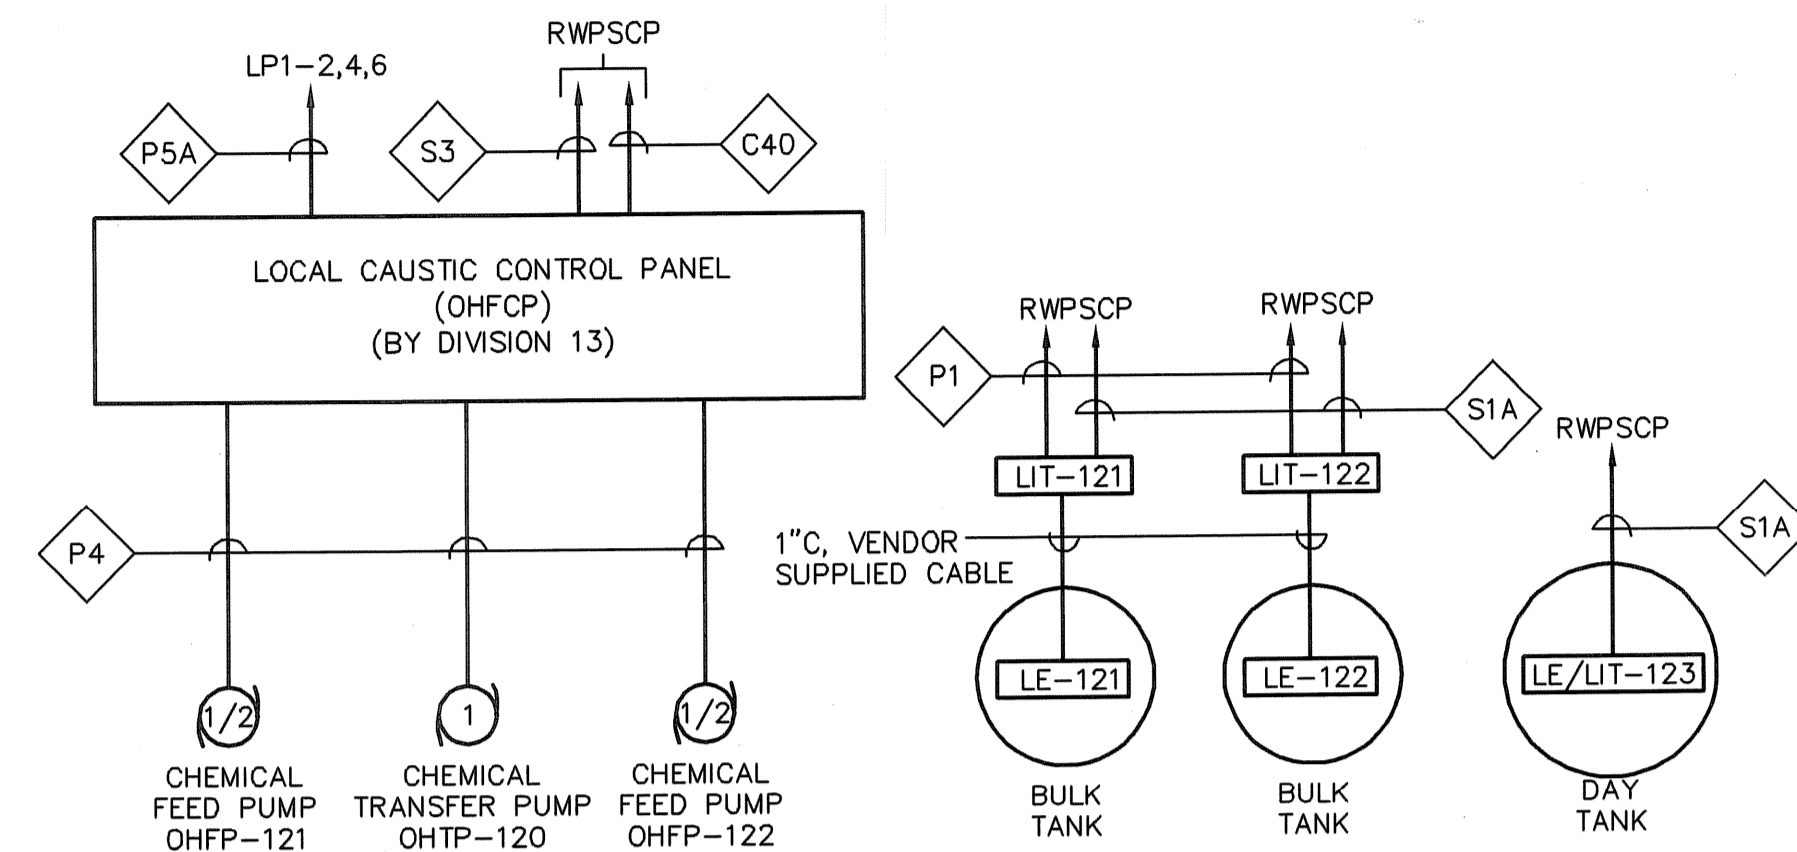

FIRE ALARM SYSTEM NOTES

- SEE SHEET E-1 FOR SYMBOLS, ABBREVIATIONS AND GENERAL NOTES.
- MINIMUM SIZE CONDUIT SHALL BE 3/4" UNLESS NOTED OTHERWISE.
- SYSTEM WIRING SHALL BE INSTALLED IN ACCORDANCE WITH EQUIPMENT SUPPLIERS APPROVED SHOP DRAWINGS AND WIRING DIAGRAMS.
- RISER DIAGRAM MAY NOT SHOW ENTIRE SYSTEM. REFER TO FLOOR PLANS FOR FINAL QUANTITIES AND LOCATIONS OF SYSTEM DEVICES AND EQUIPMENT.
- TWO CIRCUITS ARE REQUIRED FOR AUDIO/VISUAL SIGNALS. SIGNALS SHALL BE ALTERNATELY WIRED.
- PROVIDE CIRCUIT BREAKER HANDLE LOCK ON POWER CIRCUIT. HANDLE LOCK SHALL ALLOW THE CIRCUIT BREAKER TO TRIP, BUT PREVENT SWITCHING OF THE CIRCUIT BREAKER TO THE "OFF" POSITION.
- REFER TO THE HVAC AND FIRE PROTECTION DRAWINGS FOR EXACT LOCATION OF ALL EQUIPMENT REQUIRING FIRE ALARM SYSTEM INTERFACE.
- CONTRACTOR TO PROVIDE ALL DEVICES AS SHOWN AND AS REQUIRED BY LOCAL FIRE MARSHAL.

FULL SIZE DRAWING = 4"	
AS-BUILT DRAWING FILE	DPB MAY 2008
ISSUED FOR RFI POSTED SET	10/21/06
ISSUED FOR CONSTRUCTION	10/28/05
REV. B AGENCY REVIEW	8/16/05
REV. A CLIENT REVIEW	7/22/05
REVISIONS	BY DATE
2	
1	
0	
B	
A	
No.	

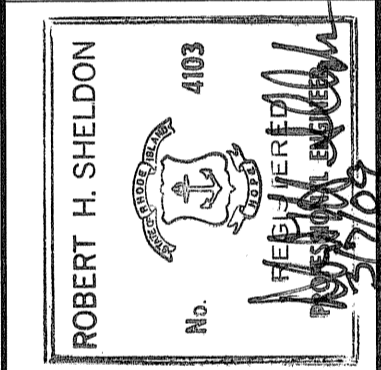

DESIGNED BY	DM	DWG SCALE	NONE
DRAWN BY	DM	CONTRACT NO.	
CHECKED BY	WS	DATE	OCTOBER 31, 2006

**EARTH TECH
AS-BUILT FILE
MAY 2008**

LIGHTING FIXTURE SCHEDULE									
FIXTURE TYPE	MANUFACTURER	CATALOG NO.	DESCRIPTION	WATTS	FIXTURE				REMARKS
				FIXT.	TYPE	MTG	LAMPS	VOLTS	
A	LITHONIA	LA23277GEB10RS	1X4 FLUORESCENT INDUSTRIAL STRIP LIGHTING FIXTURE	65	FLUOR.	PENDANT	2-T8	120	
	HOLOPHANE								
	HUBBELL								
A1	APPLETON	FVH244277SOF	1X4 FLUORESCENT ENCLOSED AND GASKETED INDUSTRIAL LIGHTING FIXTURE	90	FLUOR.	PENDANT	2-T8HO	120	NEMA 4/4X RATED
	LITHONIA								
	HUBBELL								
A2	LITHONIA	VDC232120GEB10RS	7"X4' FLUORESCENT ENCLOSED CORNER LIGHTING FIXTURE	65	FLUOR.	WALL	2-T8	120	
	HOLOPHANE								
	HUBBELL								
S	FAILSAFE	MHTWHE70N277F1BLK	EXTERIOR WALL PACK	70	MH	WALL	1	120	WIRE WITH H-O-A AND PHOTOCCELL ON BUILDING THROUGH LIGHTING CONTROL PANEL
	LITHONIA								
	HUBBELL								

PANELBOARD SCHEDULE "LP1"										
PANEL	LP1	VOLTS	120/208	MOUNT.	SURFACE	INTEGRAL TVSS				
MAIN	100A MCB	AMPS	100	AIC	10,000					
		PH/WIRE	3/4	LOC.	RWPS					
CIR.	AMPS/POLES	DESCRIPTION OF LOAD	LOAD kVA	LOAD BY PHASE, kVA			LOAD kVA	DESCRIPTION OF LOAD	AMPS/POLES	CIR.
1	20/1	LIGHTING LOWER LEVEL	1.00	2.00			1.00			2
3	20/1	LIGHTING UPPER LEVEL	1.20		2.20		1.00	SODIUM HYDROXIDE CP	30/3	4
5	20/1	EMERGENCY LIGHTING ELU-1	0.25			1.25	1.00			6
7	20/1	MOTORIZED DAMPERS (UL) & EF-4	0.50	1.50			1.00			8
9	20/1	FACP	0.50		1.50		1.00	POTASSIUM PERMANGANATE CP	30/3	10
11	30/1	RWPSCP	1.50			2.50	1.00			12
13	20/1	SACP	0.50	1.50			1.00	RECEPTACLES (CHEMICAL AREA)	20/1*	14
15	20/1	LIGHT, EYE WASH, CHEM ROOM	1.00		0.75		0.75	RECEPTACLES (ELECTRICAL ROOM)	20/1	16
17	20/1	CHEMICAL FILL PANEL	1.00			2.00	1.00	RECEPTACLES (PUMP LEVEL)	20/1*	18
19	20/1	SPARE	0.50	1.00			0.50	EXHUST FANS EF-2 & M. DAMPER	20/1	20
21	20/1	OUTSIDE LIGHTING	0.90		1.40		0.50	EF-1, MD-3, MD-4	20/1	22
23	20/1	EMERGENCY LIGHTING ELU-2	0.25			0.55	0.30	RECEPTACLE (EXTERIOR)	20/1*	24
25	20/1	RECEPTACLE (TELEPHONE CABINET)	0.25	0.25			0.50	SPARE	20/1	26
27	20/1	SPARE	1.00		1.00		0.50	SPARE	20/1	28
29	20/1	SPARE	1.00			1.00	0.50	GEN. BATTERY CHARGER	20/1	30
31	20/1	SPARE	1.00	1.00			0.50	SPARE	20/1	32
33	20/1	SPARE	1.00		1.00		0.50	ELECTRIC DOOR LOCKS	20/1	34
35	60/2	GENERATOR JACKET WATER HEATER	1.00					EF-3 & M. DAMPER	20/1	36
37	20/1	SPARE	1.00	0.50				R.A.M. PUMPS	20/1	38
39	20/1	SPARE	1.00		0.50			AIT-201	20/1	40
41	20/1	SPARE	0.50			0.50		EMERGENCY EYE WASH CHEM. ROOM	20/1	42
TOTAL kVA BY PHASE -				7.50	8.60	7.30		TOTAL kVA-	14.88	
DEMAND kVA BY PHASE -				5.20	5.28	4.40		TOTAL AMPERES-	41.33	

* - GFCI CIRCUIT BREAKER

POWER CABLE/CONDUIT SCHEDULE *			
SYMBOL	CONDUIT SIZE	CONDUCTORS	GRD
P1	3/4"	2#12	1#12
P2	3/4"	2#10	1#10
P3	3/4"	2#8	1#10
P4	3/4"	3#12	1#12
P5	3/4"	3#10	1#10
P5A	3/4"	4#10	1#10
P5B	3/4"	6#10	1#10
P6	3/4"	3#8	1#10
P7	1"	3#6	1#10
P8	1 1/2"	3#4	1#10
P9	1 1/2"	3#2	1#10
P9A	1 1/2"	3#3	1#10
P9B	1 1/2"	4#3	1#10
P10	1 1/2"	3#1	1#6
P10A	1 1/2"	4#1	1#6
P11	2"	3#1/0	1#2
P11A	2"	4#1/0	1#2
P12	2"	3#2/0	1#2
P13	2"	3#3/0	1#2
P13A	(2 SETS OF) 2"	(2 SETS OF) 3#3/0	(2 SETS OF) 1#2
P13B	(2 SETS OF) 2"	(2 SETS OF) 4#3/0	(2 SETS OF) 1#2
P14	2 1/2"	3#4/0	1#2
P14A	2 1/2"	4#4/0	1#2
P15	2 1/2"	3-250 KCMIL	1#2/0
P16	3"	3-350 KCMIL	1#2/0
P16A	(2 SETS OF) 3 1/2"	(2 SETS OF) 3-350 KCMIL	(2 SETS OF) 1#2/0
P17	3 1/2"	3-500 KCMIL & 6#14	1#2/0
P18	(2 SETS OF) 3 1/2"	(2 SETS OF) 3-300 KCMIL	(2 SETS OF) 1#2/0
P18A	(2 SETS OF) 3 1/2"	(2 SETS OF) 3-300 KCMIL, 2#10	(2 SETS OF) 1#2/0
P18B	(2 SETS OF) 3 1/2"	(2 SETS OF) 3-300 KCMIL & 1#4/0 N	(2 SETS OF) 1#2/0

CONTROL CABLE/CONDUIT SCHEDULE *		
SYMBOL	CONDUIT SIZE	CONDUCTORS
C2	3/4"	2#14
C3	3/4"	3#14
C4	3/4"	4#14
C5	3/4"	5#14
C6	3/4"	6#14
C7	3/4"	7#14
C8	3/4"	8#14
C9	3/4"	9#14
C10	3/4"	10#14
C12	1"	12#14
C16	1-1/2"	16#14
C22	1-1/2"	22#14
C24	1-1/2"	24#14
C40	2"	40#14
C60	2"	60#14
C80	3"	80#14

SIGNAL CABLE/CONDUIT SCHEDULE *		
SYMBOL	CONDUIT SIZE	CONDUCTORS
S	1"	EMPTY
S1	3/4"	1-2/C#16
S1A	3/4"	1-3/C#16
S2	3/4"	2-2/C#16
S3	1"	3-2/C#16
S4	1"	4-2/C#16
S5	1"	5-2/C#16
S6	1 1/2"	6-2/C#16
S7	1 1/2"	7-2/C#16
S8	1 1/2"	8-2/C#16
S9	1 1/2"	9-2/C#16
S10	2"	10-2/C#16
S11	3"	11-3/C#16
S13	3"	13-2/C#16

* - NOT ALL RACEWAYS/CABLES SHOWN ARE USED IN THIS PROJECT

2	AS-BUILT DRAWING FILE	DPB	MAY 2008	DATE
1	ISSUED FOR RF POSTED SET		10/31/06	BY
0	ISSUED FOR CONSTRUCTION		10/28/05	DATE
B	REV. B AGENCY REVIEW		8/16/05	BY
A	REV. A CLIENT REVIEW		7/22/05	DATE

ROBERT H. SHELDON
4103
10/31/06


PAWTUCKET, RHODE ISLAND
PAWTUCKET REGIONAL
WATER TREATMENT FACILITY
PKGS 11 & 12 - RAW WATER PUMP STATION
SCHEDULES

DESIGNED BY	DWG SCALE
DM	NONE
DRAWN BY	CONTRACT NO.
DM	
CHECKED BY	DATE
WS	OCTOBER 31, 2008


EARTH TECH
AS-BUILT FILE
MAY 2008

E-6

SHEET OF

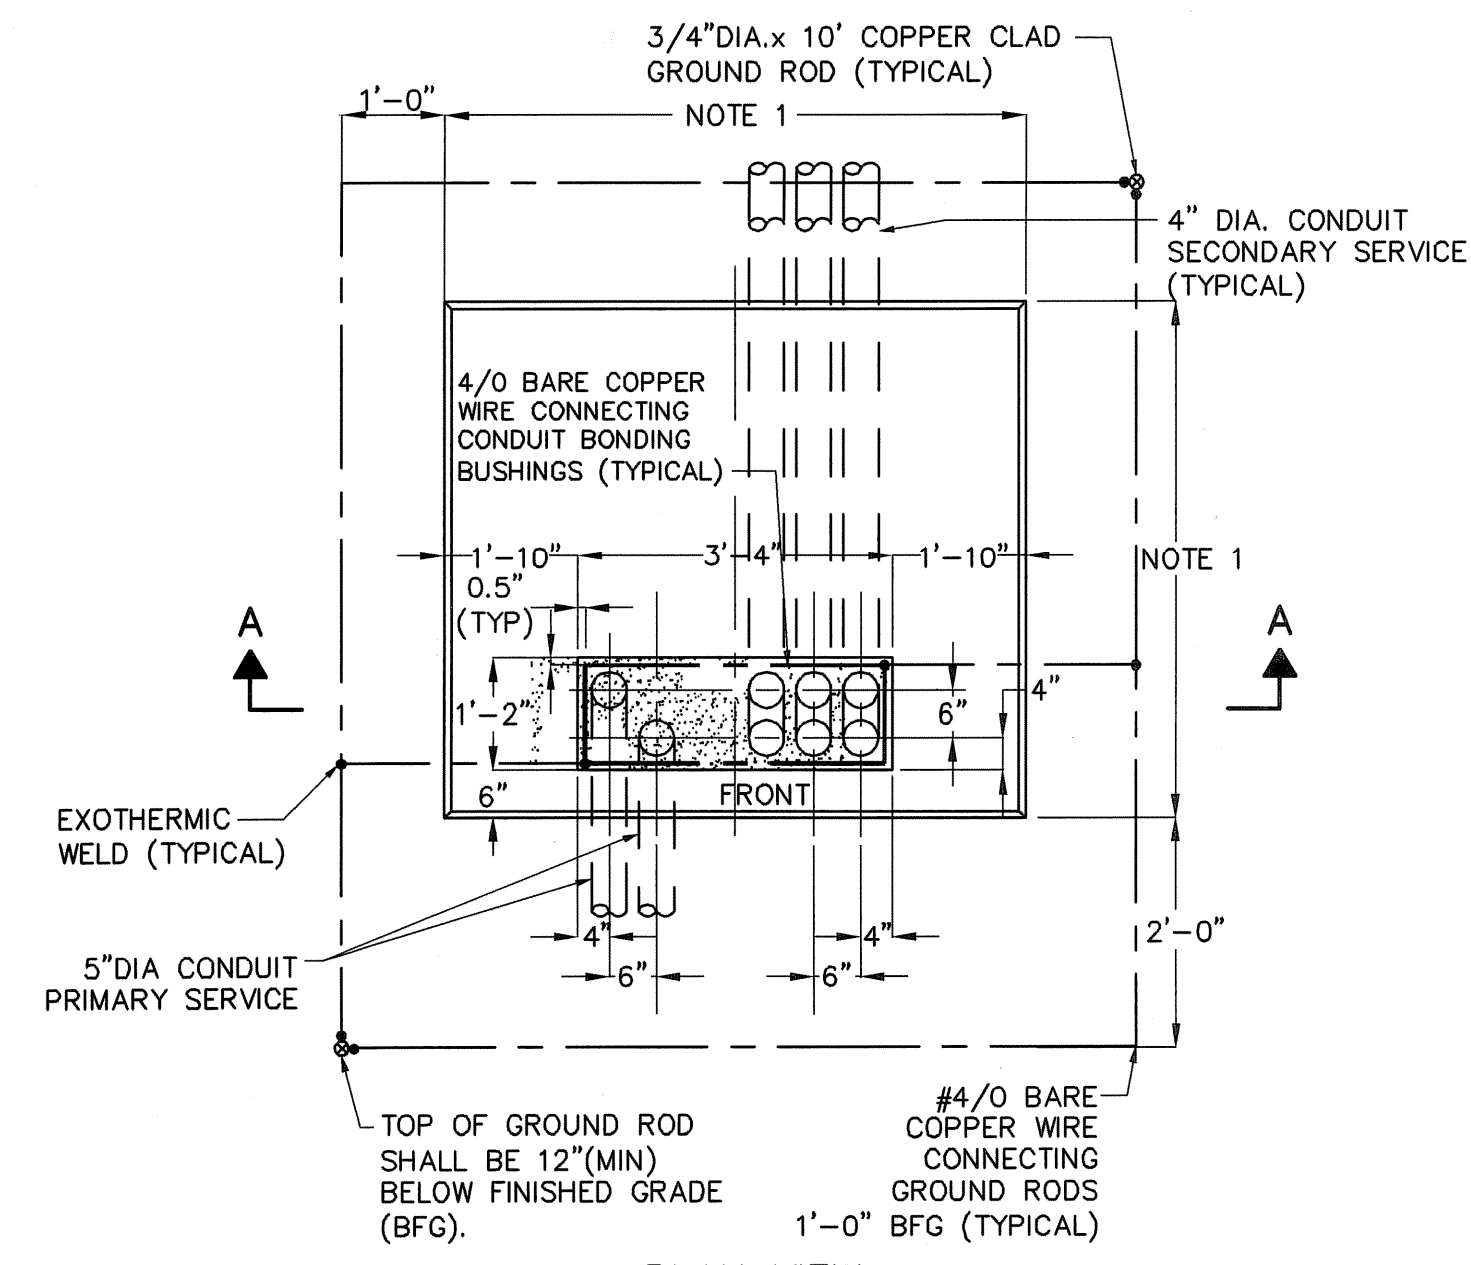


PLAN VIEW

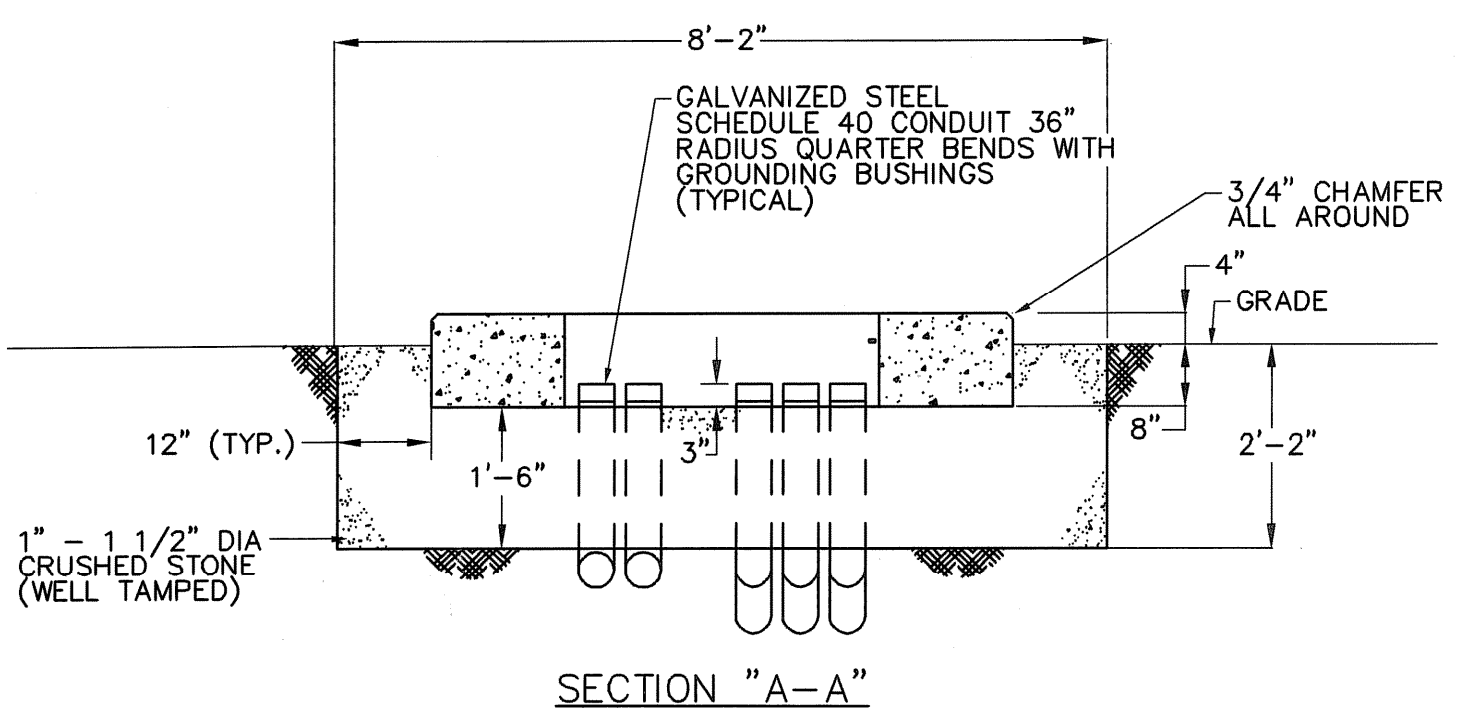


SECTION "A-A"

- NOTES:
- REFER TO UTILITY COMPANY REQUIREMENTS FOR PAD LAYOUT.
 - ALL GROUND GRID CONNECTIONS SHALL BE EXOTHERMIC WELD.
 - DO NOT ALLOW PRIMARY AND SECONDARY CONDUITS TO CROSS EACH OTHER INSIDE OR OUTSIDE THE PAD. LOCATE SECONDARY CONDUITS AS FAR TO THE RIGHT AS POSSIBLE IN THE PAD OPENING.
 - CAP ALL CONDUIT ENDS TO PREVENT MOISTURE AND DEBRIS FROM ENTERING CONDUITS PRIOR TO TRANSFORMER INSTALLATION.
 - PRIMARY DUCT GROUND SHALL BE CONNECTED TO PAD GROUND GRID.

TRANSFORMER PAD DETAIL

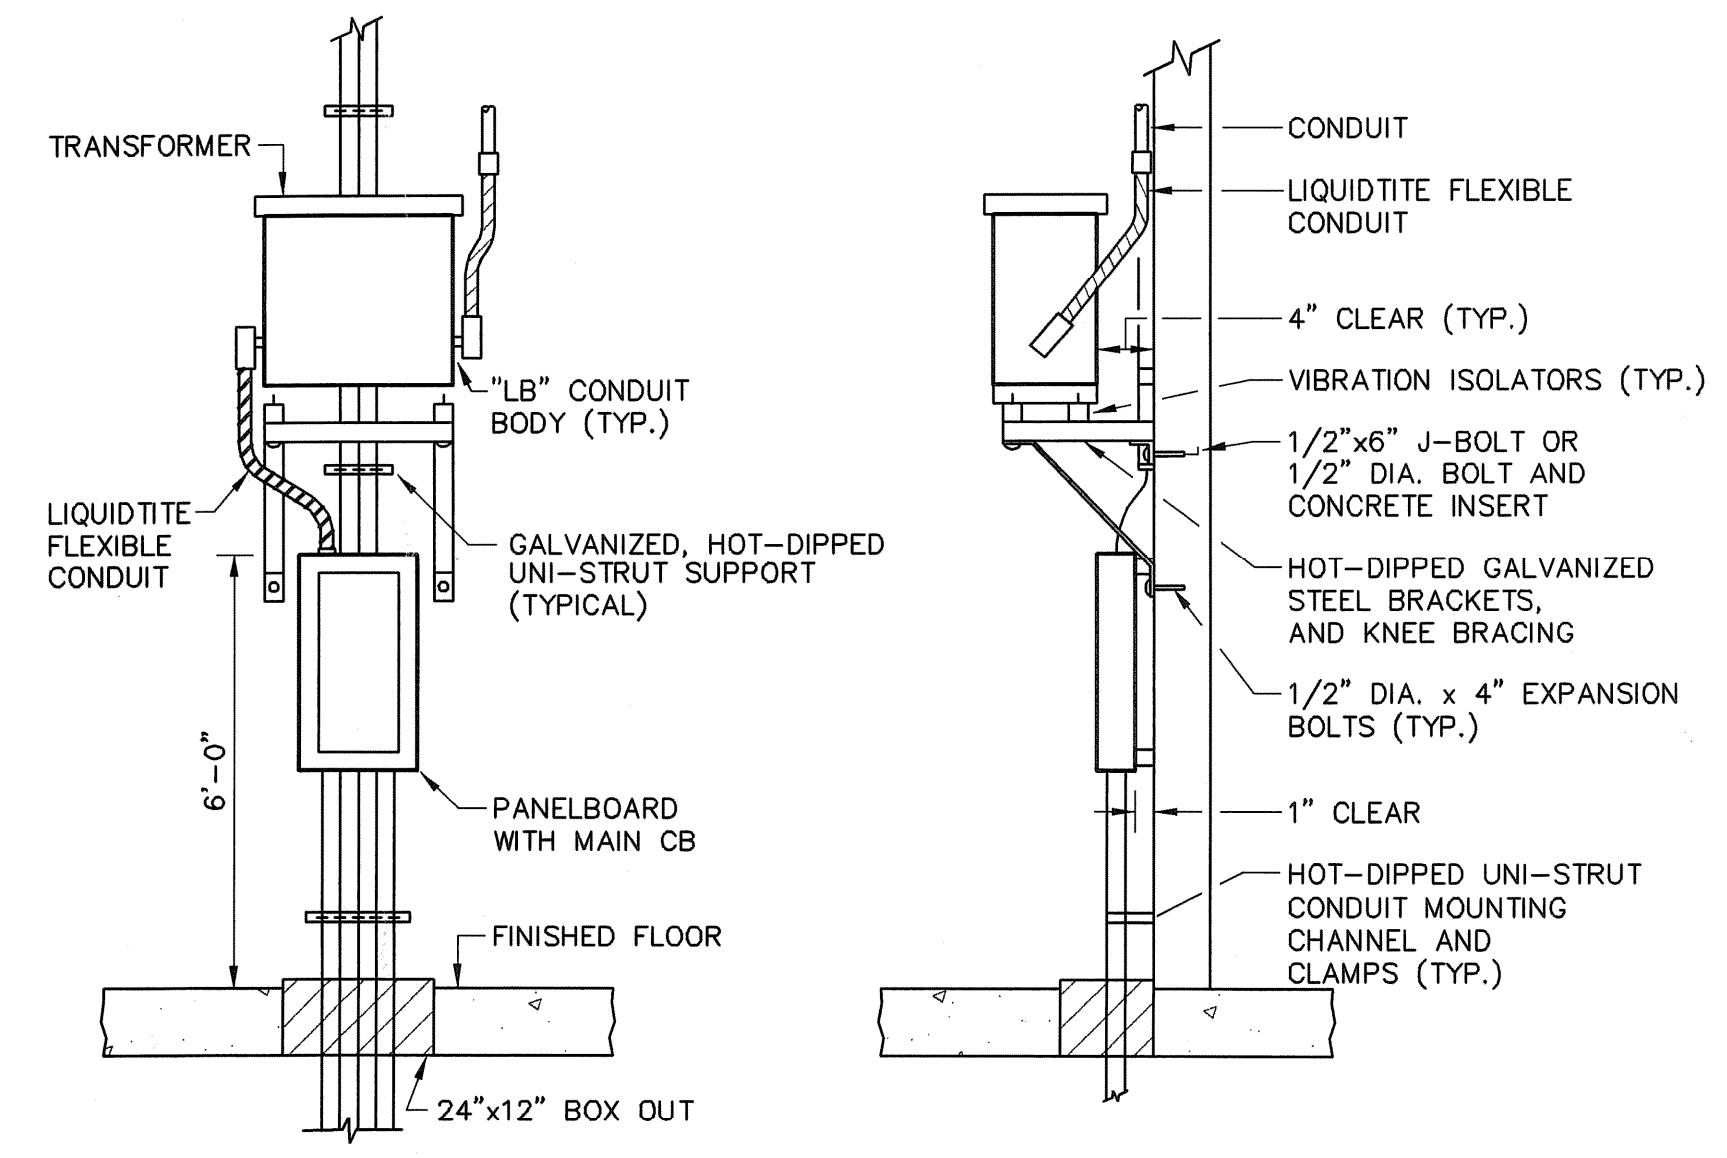


FRONT ELEVATION
TRANSFORMER MOUNTING DETAIL
NOT TO SCALE

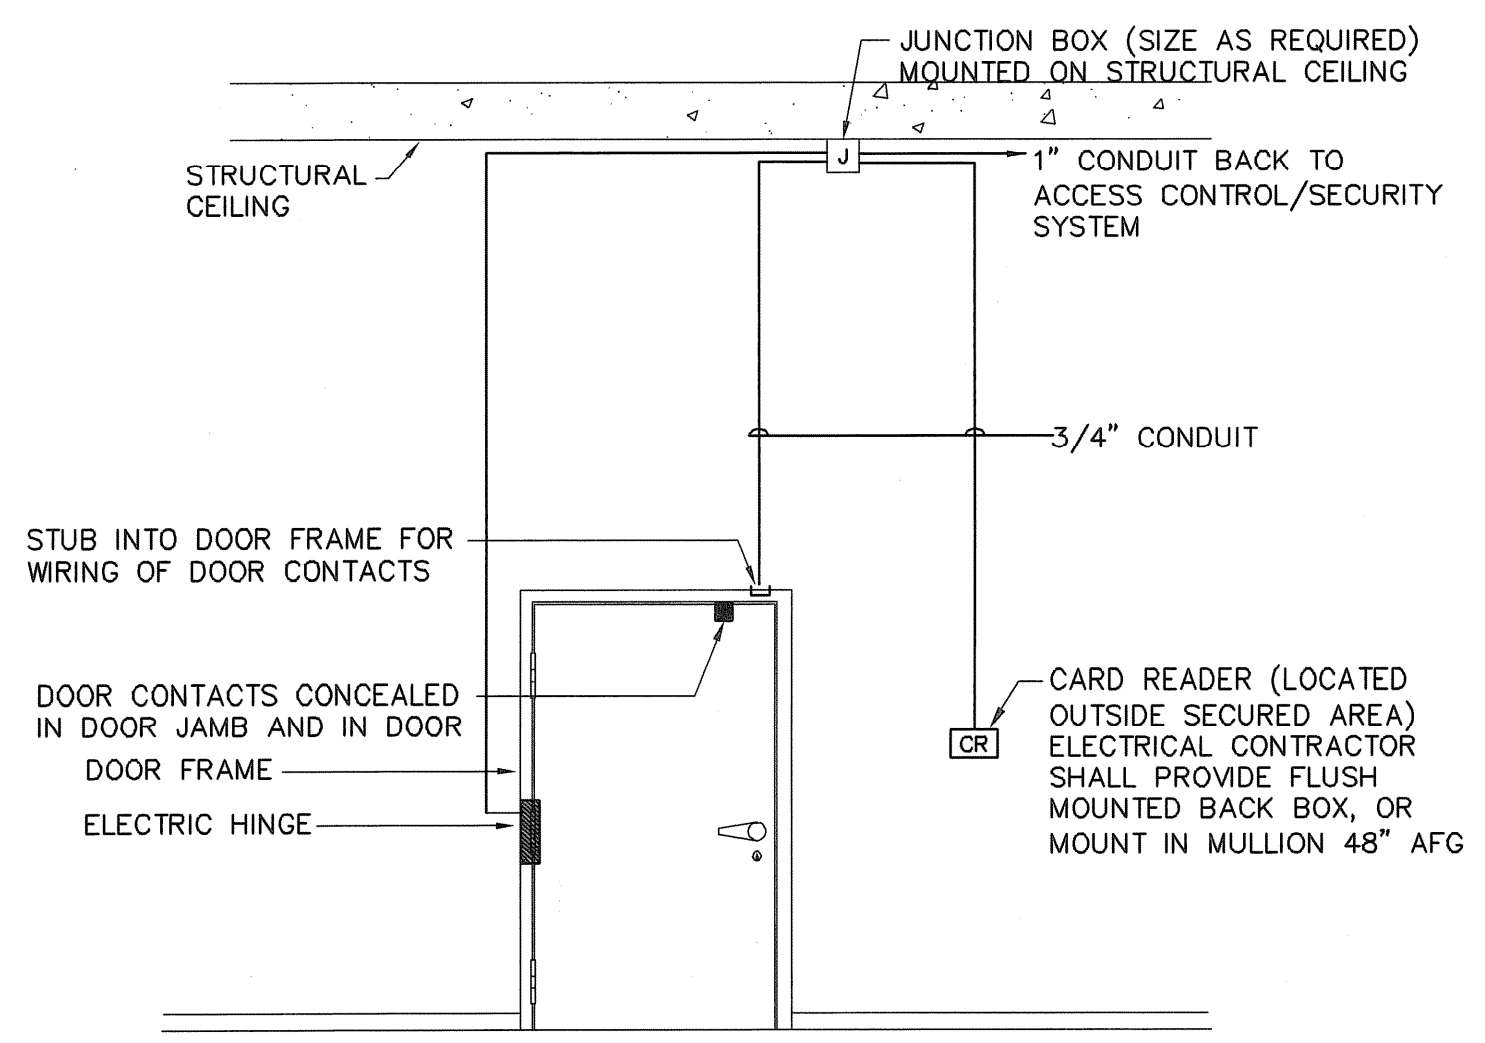


- NOTES:
- ALL LOW VOLTAGE WIRING AND SECURITY EQUIPMENT SHALL BE FURNISHED BY SECURITY SYSTEM SUPPLIER.
 - COORDINATE EXACT LOCATIONS AND MOUNTING REQUIREMENTS OF ALL DEVICES WITH ARCHITECTURAL DRAWINGS.
 - PROVIDE INSULATED BUSHINGS ON ALL CONDUITS.
 - ELECTRIC DOOR STRIKES AND HINGES SHALL BE FURNISHED AND INSTALLED BY THE HARDWARE CONTRACTOR.
 - VERIFY DOOR HARDWARE CONNECTIONS WITH MANUFACTURERS INSTALLATION MANUAL.
 - COORDINATE INSTALLATION OF RACEWAY W/OTHER BUILDING TRADES TO CONCEAL WITHIN STRUCTURE.


TYPICAL DOOR ACCESS CONTROL/SECURITY DETAIL
NOT TO SCALE

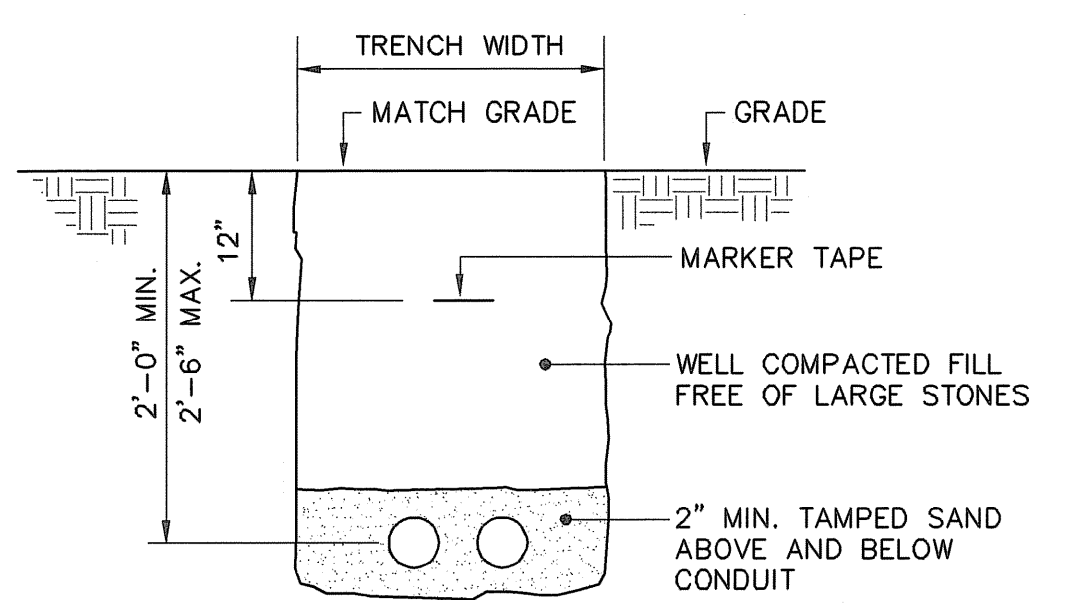

UNDERGROUND DIRECT BURIED CONDUIT TRENCH
NOT TO SCALE

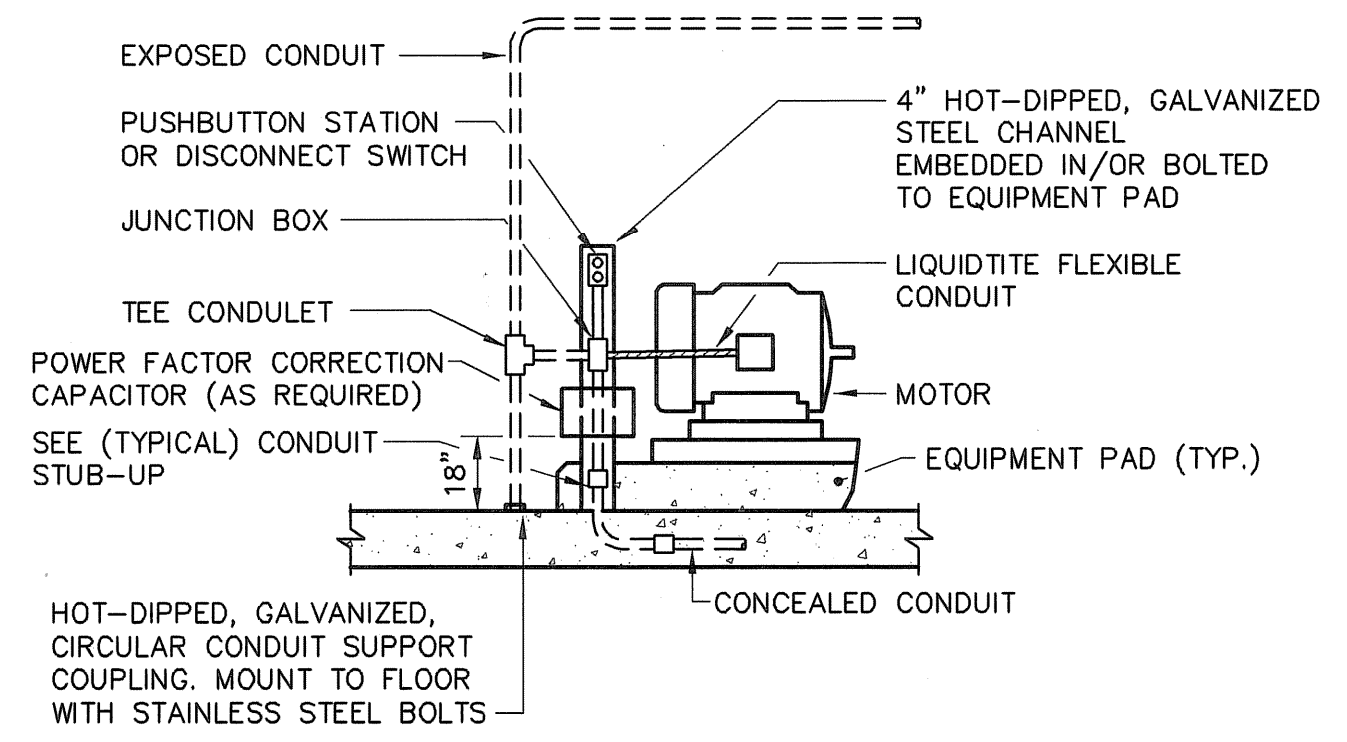


CONDUIT ARRANGEMENT FOR MOTOR
NOT TO SCALE

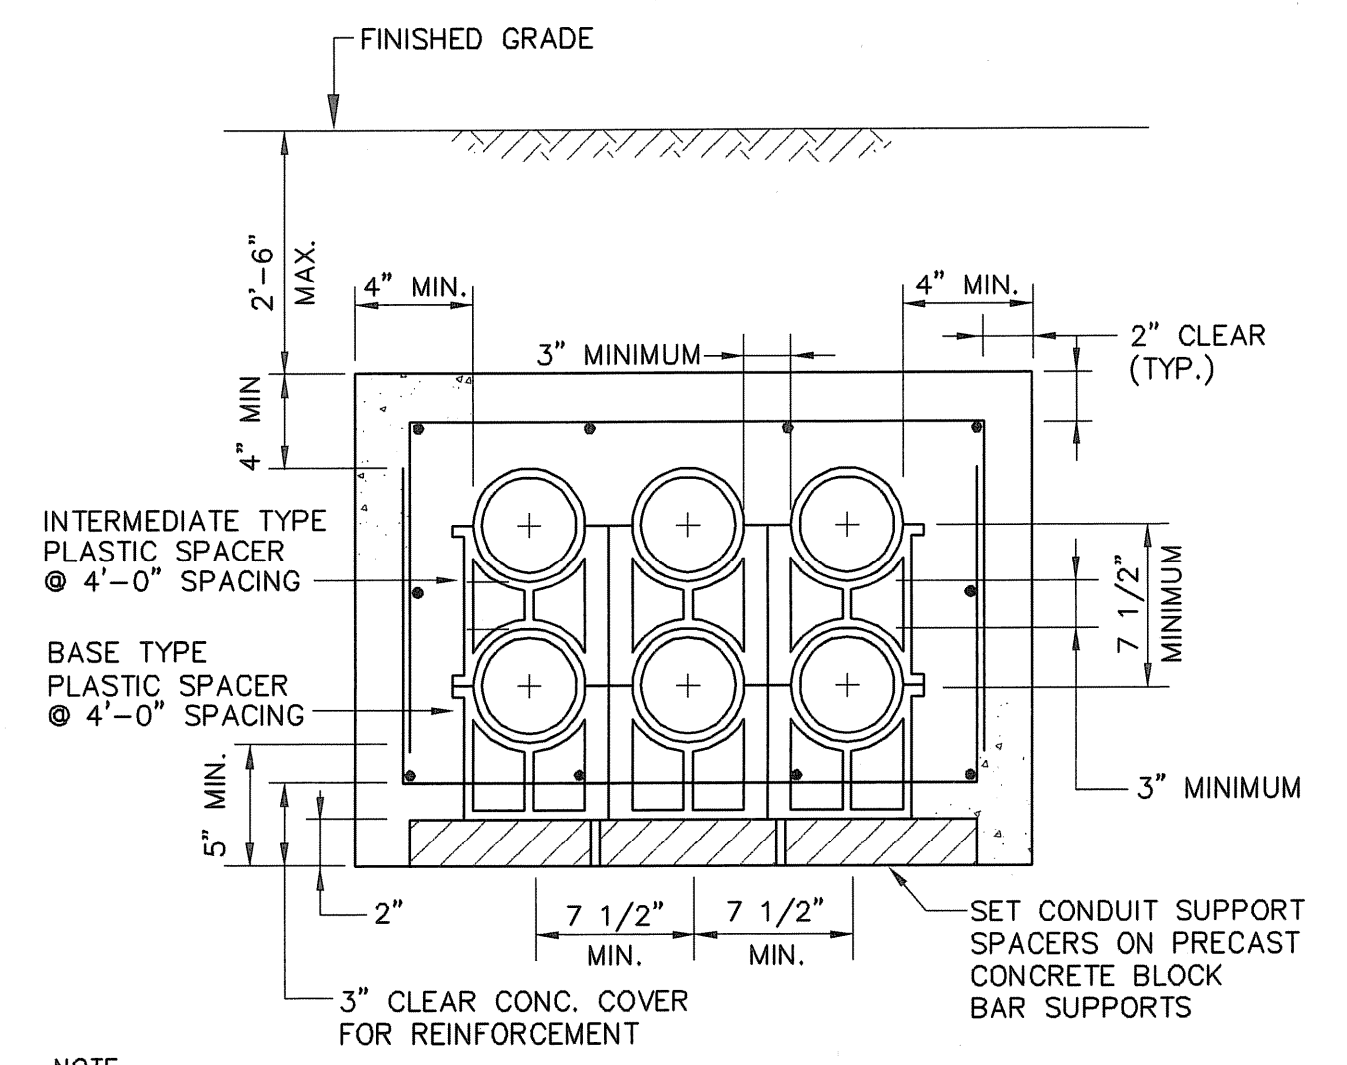

- NOTE:
- BACKFILL DUCT BANK IN LAYERS AND MANUALLY TAMP OR "PUDDLE" CONCRETE FILL. PROVIDE YELLOW DUCT BANK MARKER TAPES, READING "CAUTION - ELECTRICAL LINES BELOW", OVER ENTIRE LENGTH OF DUCTLINE. LOCATE TAPES 12 INCHES BELOW GRADE. PROVIDE A TAPE FOR EVERY 12 INCHES OF WIDTH OF DUCTLINE.
 - SEE STRUCTURAL DRAWING FOR ALL REINFORCEMENT REQUIREMENTS.


DOUBLE LAYER DUCT BANK SECTION

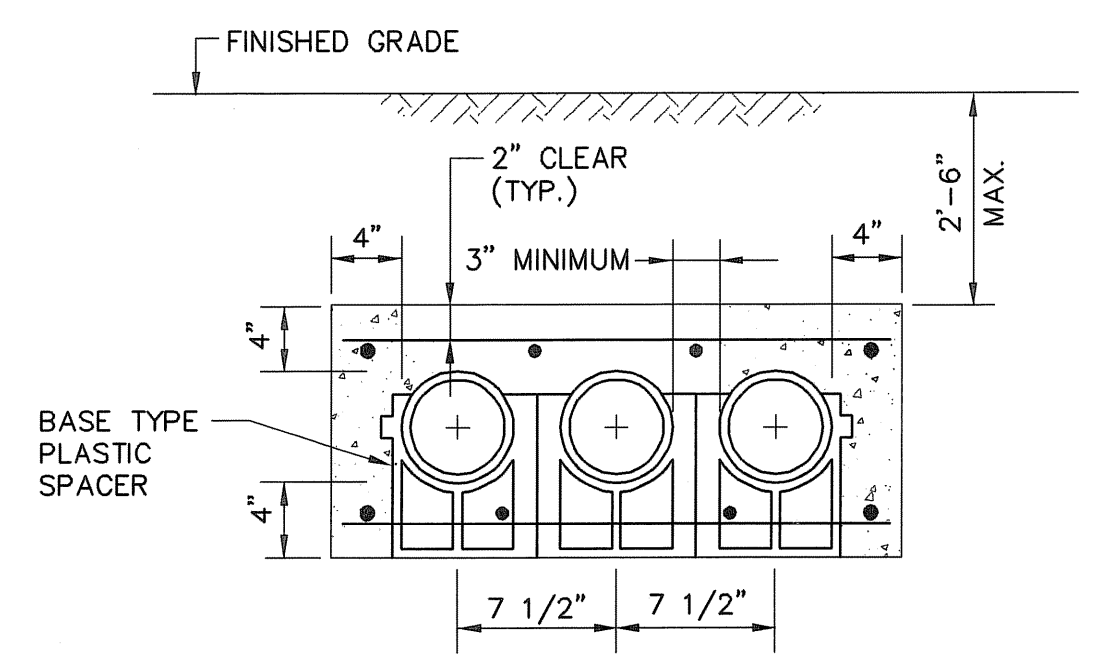


- NOTE:
- BACKFILL DUCT BANK IN LAYERS AND MANUALLY TAMP OR "PUDDLE" CONCRETE FILL. PROVIDE YELLOW DUCT BANK MARKER TAPES, READING "CAUTION - ELECTRICAL LINES BELOW", OVER ENTIRE LENGTH OF DUCTLINE. LOCATE TAPES 12 INCHES BELOW GRADE. PROVIDE A TAPE FOR EVERY 12 INCHES OF WIDTH OF DUCTLINE.
 - SEE STRUCTURAL DRAWING FOR ALL REINFORCEMENT REQUIREMENTS.

SINGLE LAYER DUCT BANK SECTION

UNDER ROADWAY AND PAVED AREA
NOT TO SCALE

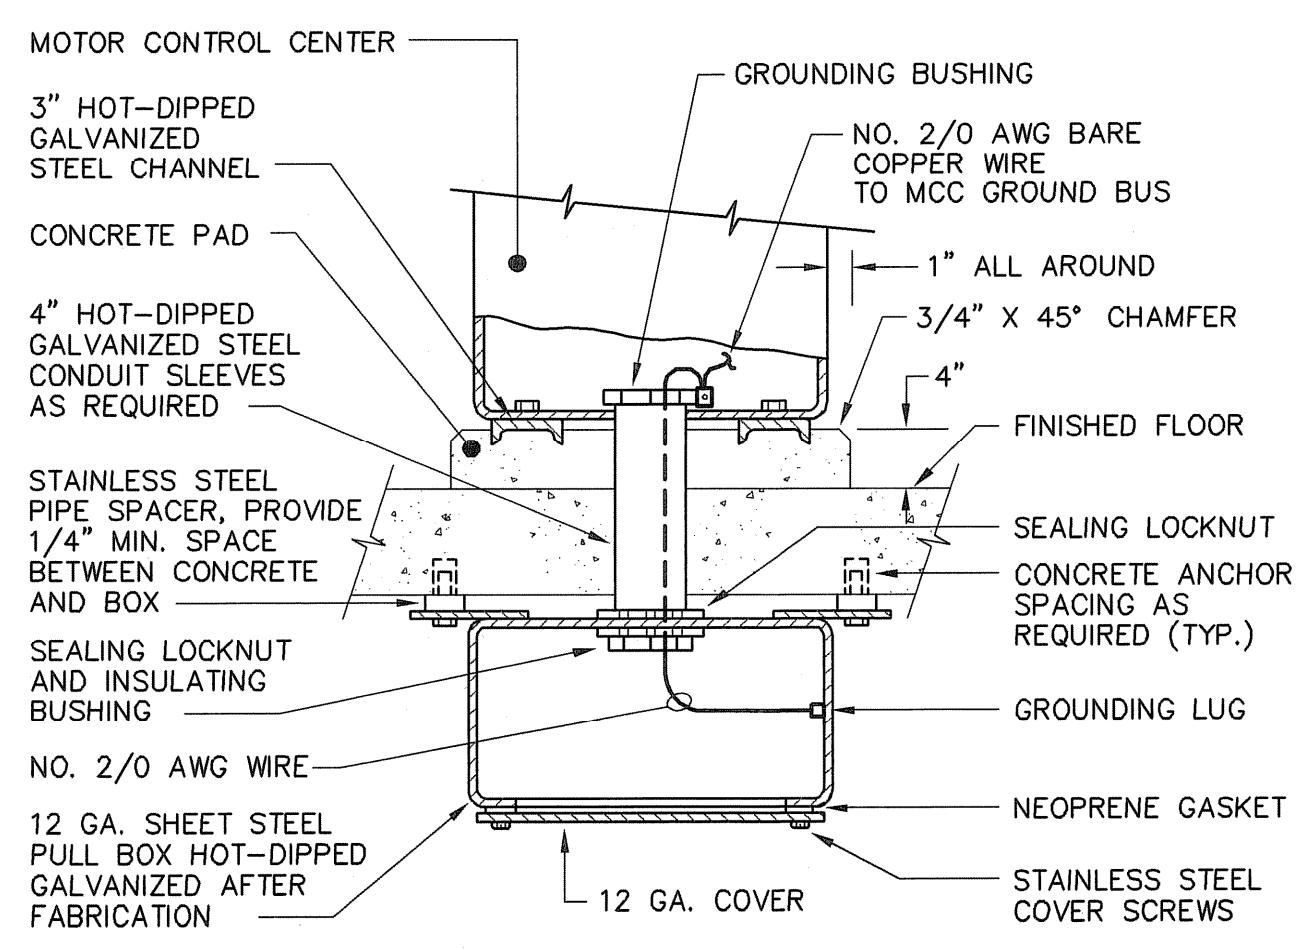


MOTOR CONTROL CENTER PULLBOX MOUNTED DIRECTLY UNDER SLAB
NOT TO SCALE

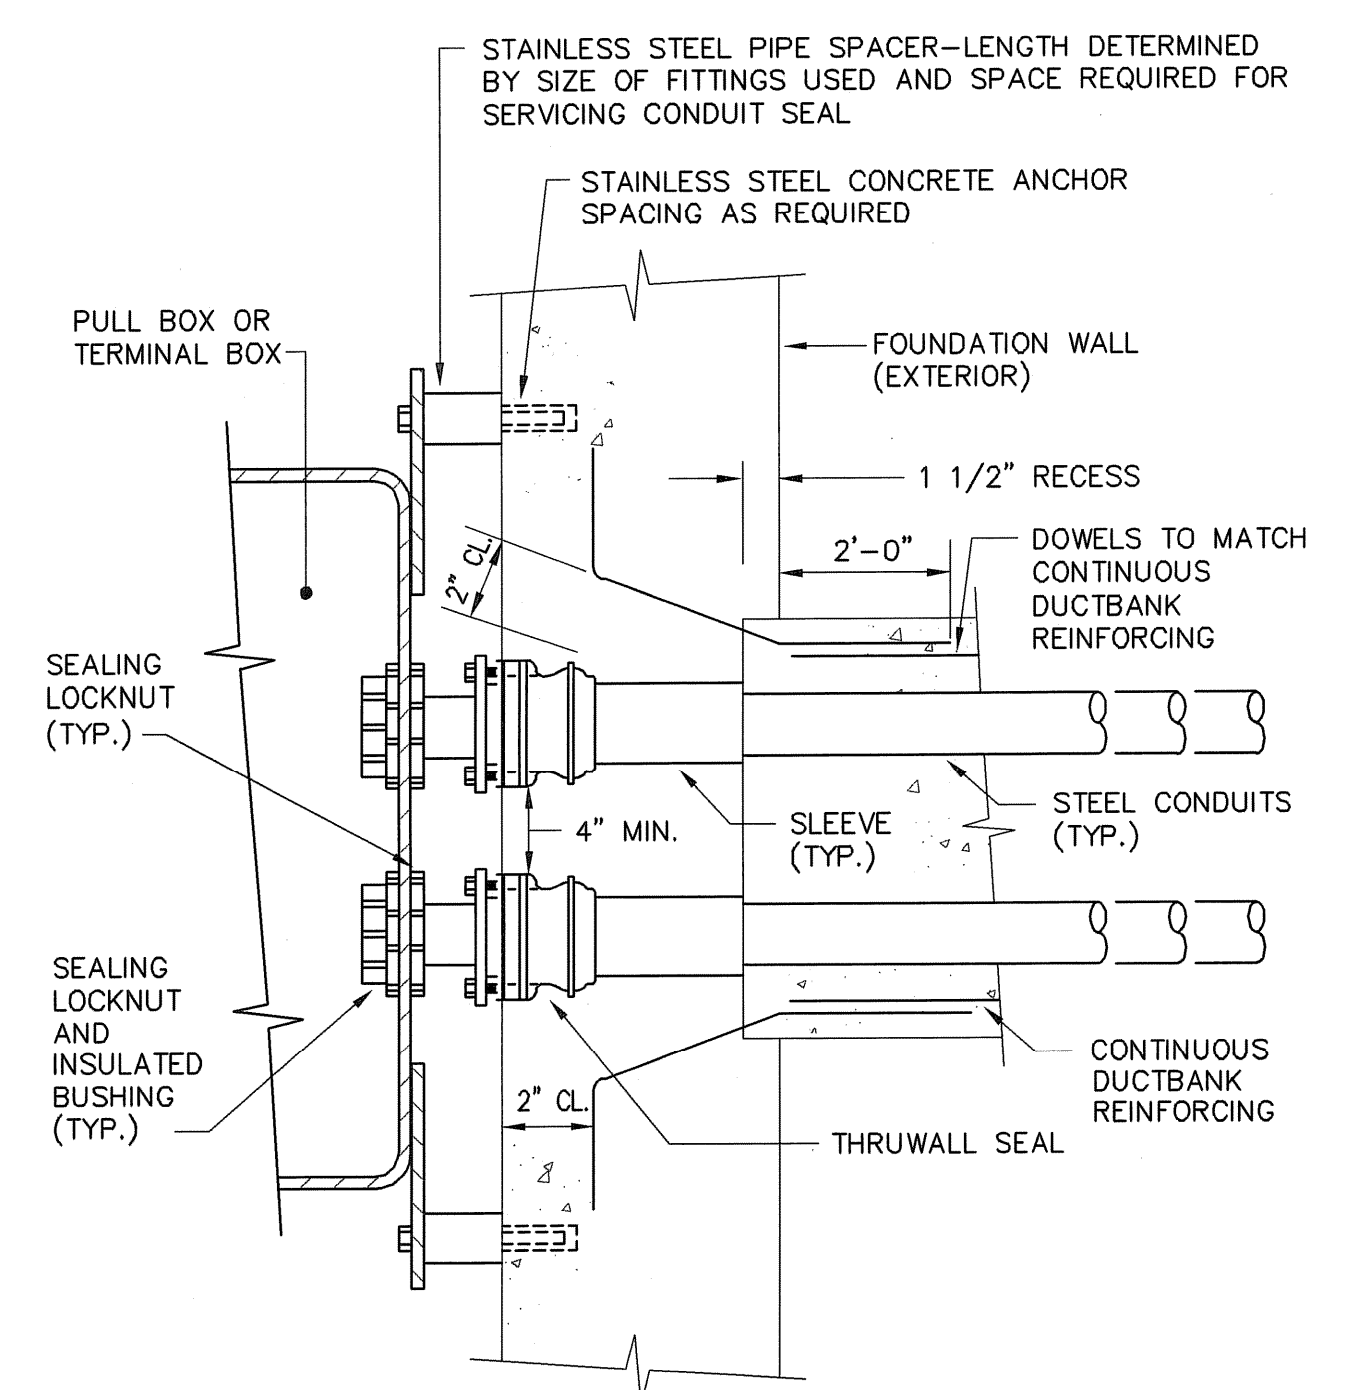


- NOTE:
- WHERE PVC CONDUIT IS USED IN DUCTBANK, CONVERT TO STEEL CONDUIT USING AN APPROPRIATE ADAPTER FITTING WITHIN 3'-0" OF WALL.

CONDUIT ENTRANCE SEAL IN NEW WALL
NOT TO SCALE

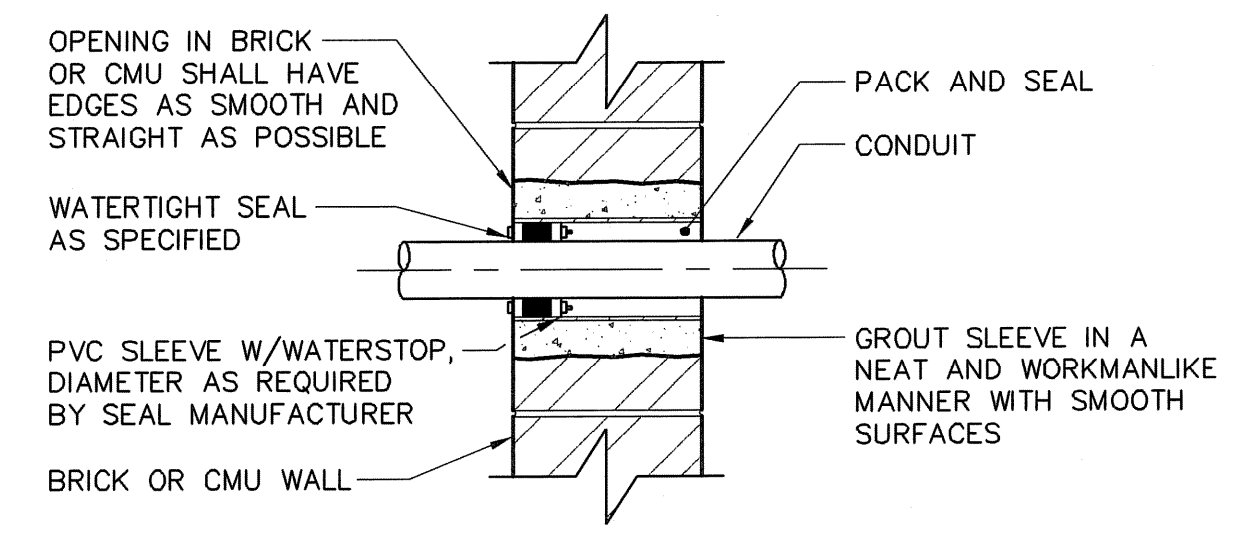


WATERTIGHT CONDUIT PENETRATION THROUGH BRICK OR CMU WALL
NOT TO SCALE

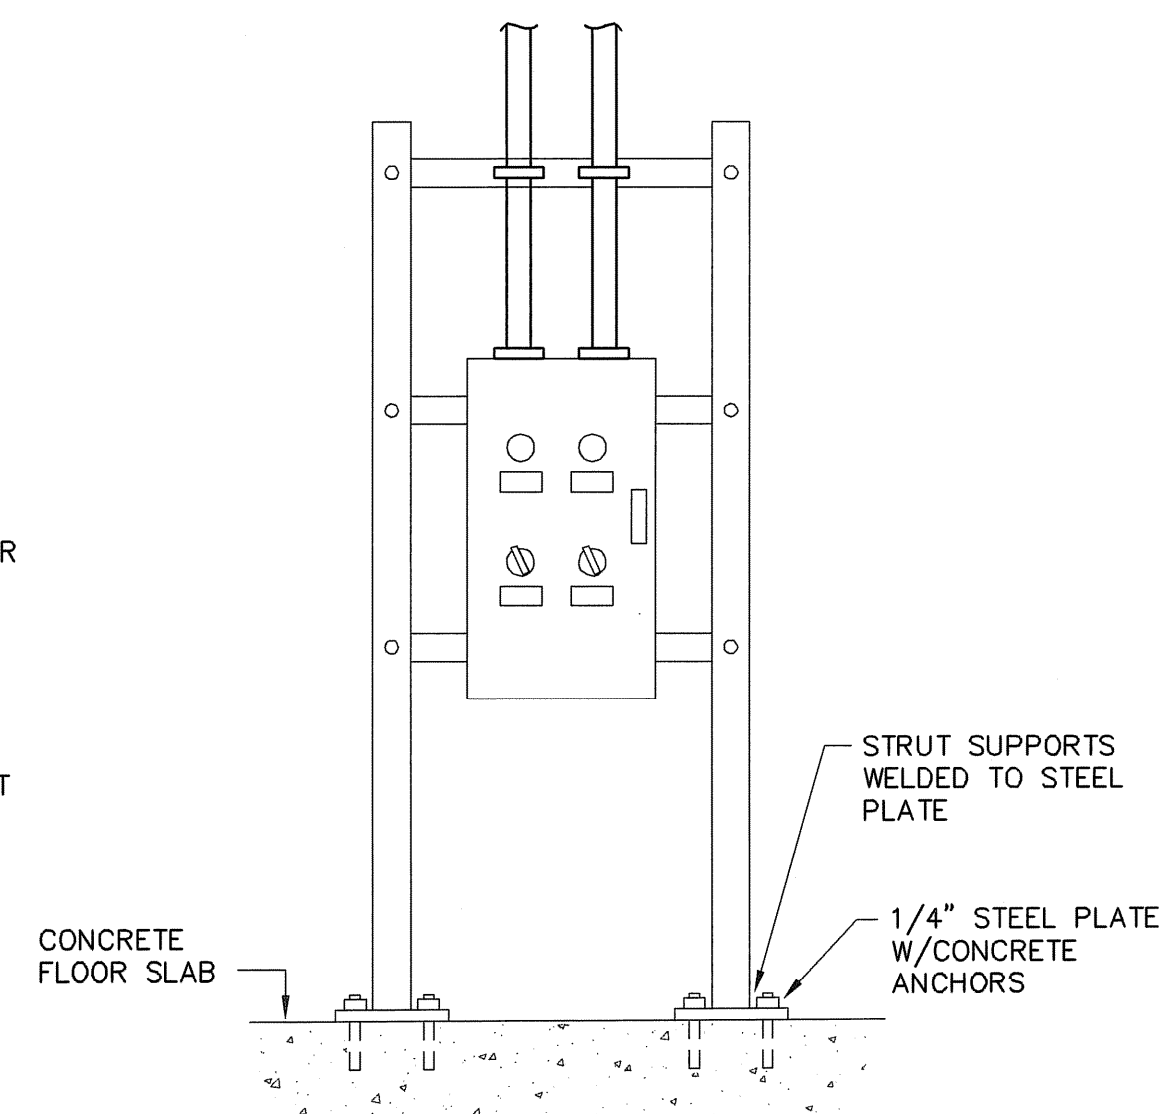

CONTROL PANEL MOUNTING DETAIL
NOT TO SCALE

NO.	DATE	BY	REVISIONS
2	MAY 2008		
1	10/23/06		ISSUED FOR RFI POSTED SET
0	10/28/05		ISSUED FOR CONSTRUCTION
B	8/16/05		REV. B AGENCY REVIEW
A	7/22/05		REV. A CLIENT REVIEW

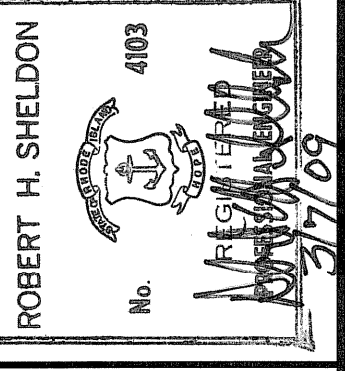


PAWTUCKET, RHODE ISLAND
PAWTUCKET REGIONAL
WATER TREATMENT FACILITY
PKGS 11 & 12 - RAW WATER PUMP STATION
DETAILS


DESIGNED BY	DWG SCALE
DM	NONE
DRAWN BY	CONTRACT NO.
DM	
CHECKED BY	DATE
WS	OCTOBER 31, 2006

EARTH TECH
AS-BUILT FILE
MAY 2008

Filename: L:\WORK\69993\CAD\AS-BUILT\11-12\ RWTP\ELEC\69993-PKG12-E8.DWG
 Plot File Date Created: Sep/22/2008 11:35 AM

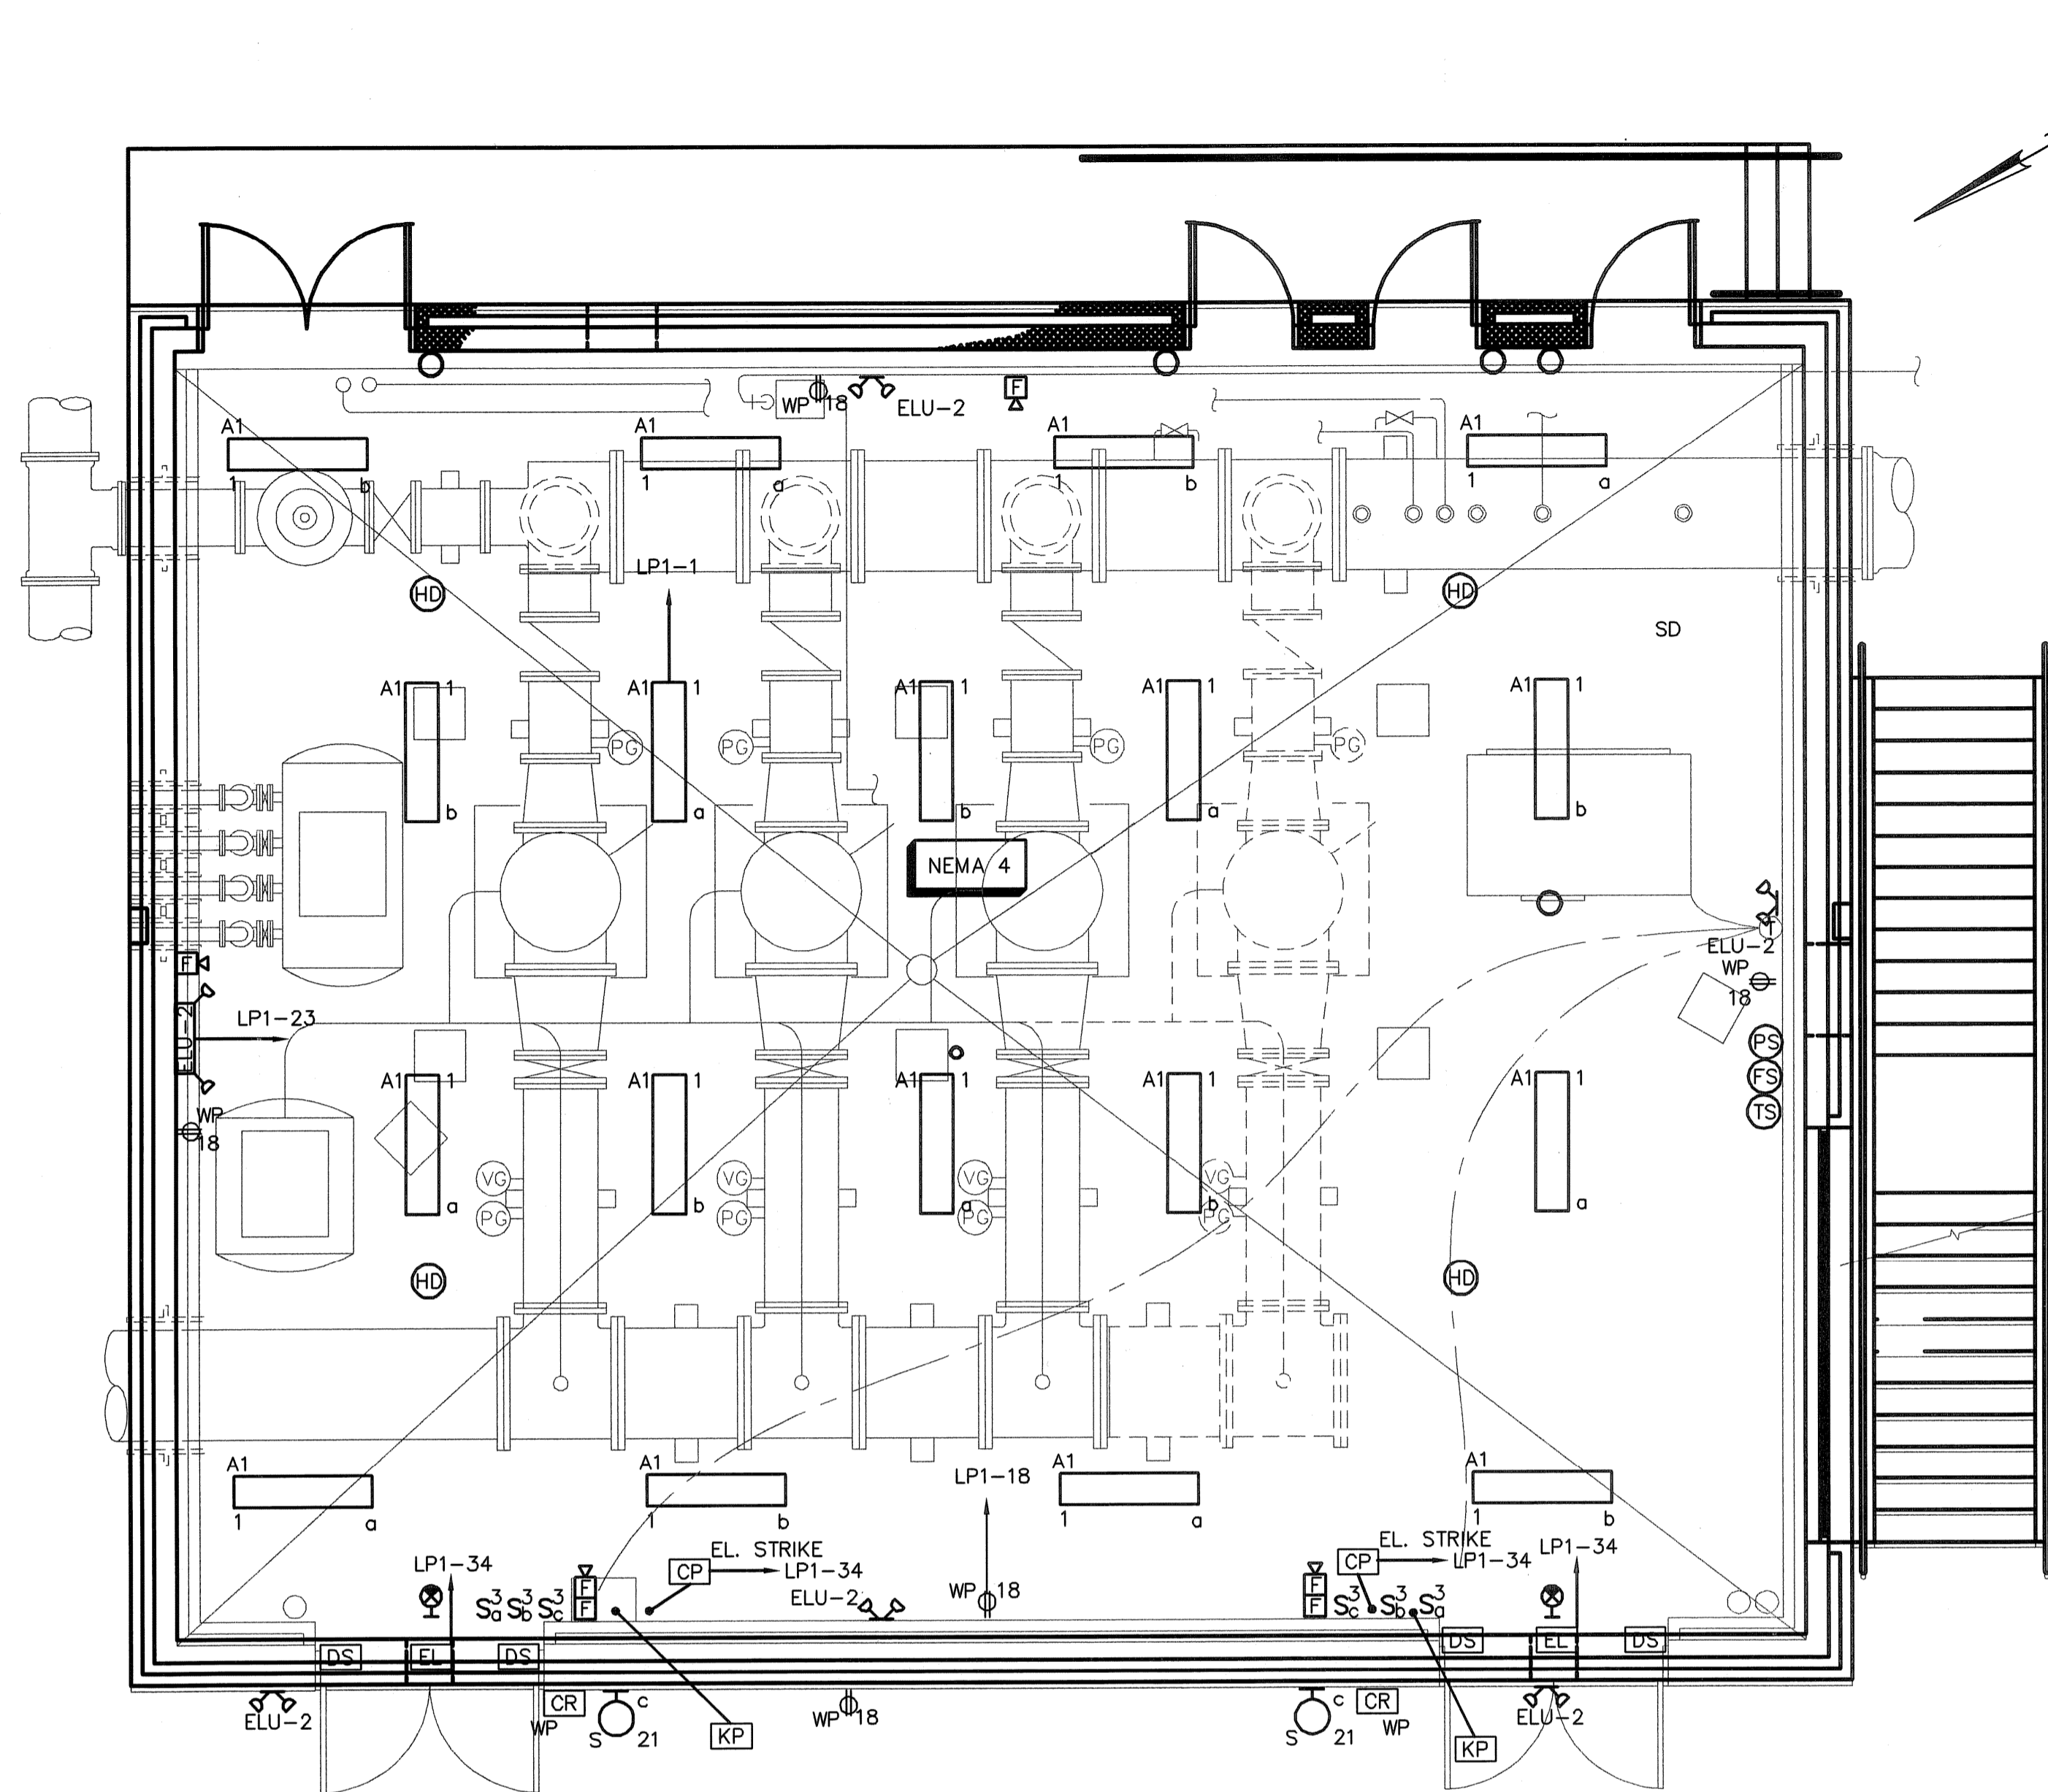

**PUMP LEVEL
 LIGHTING AND MISC. SYSTEMS PLAN**
 SCALE: 1/4" = 1'-0"

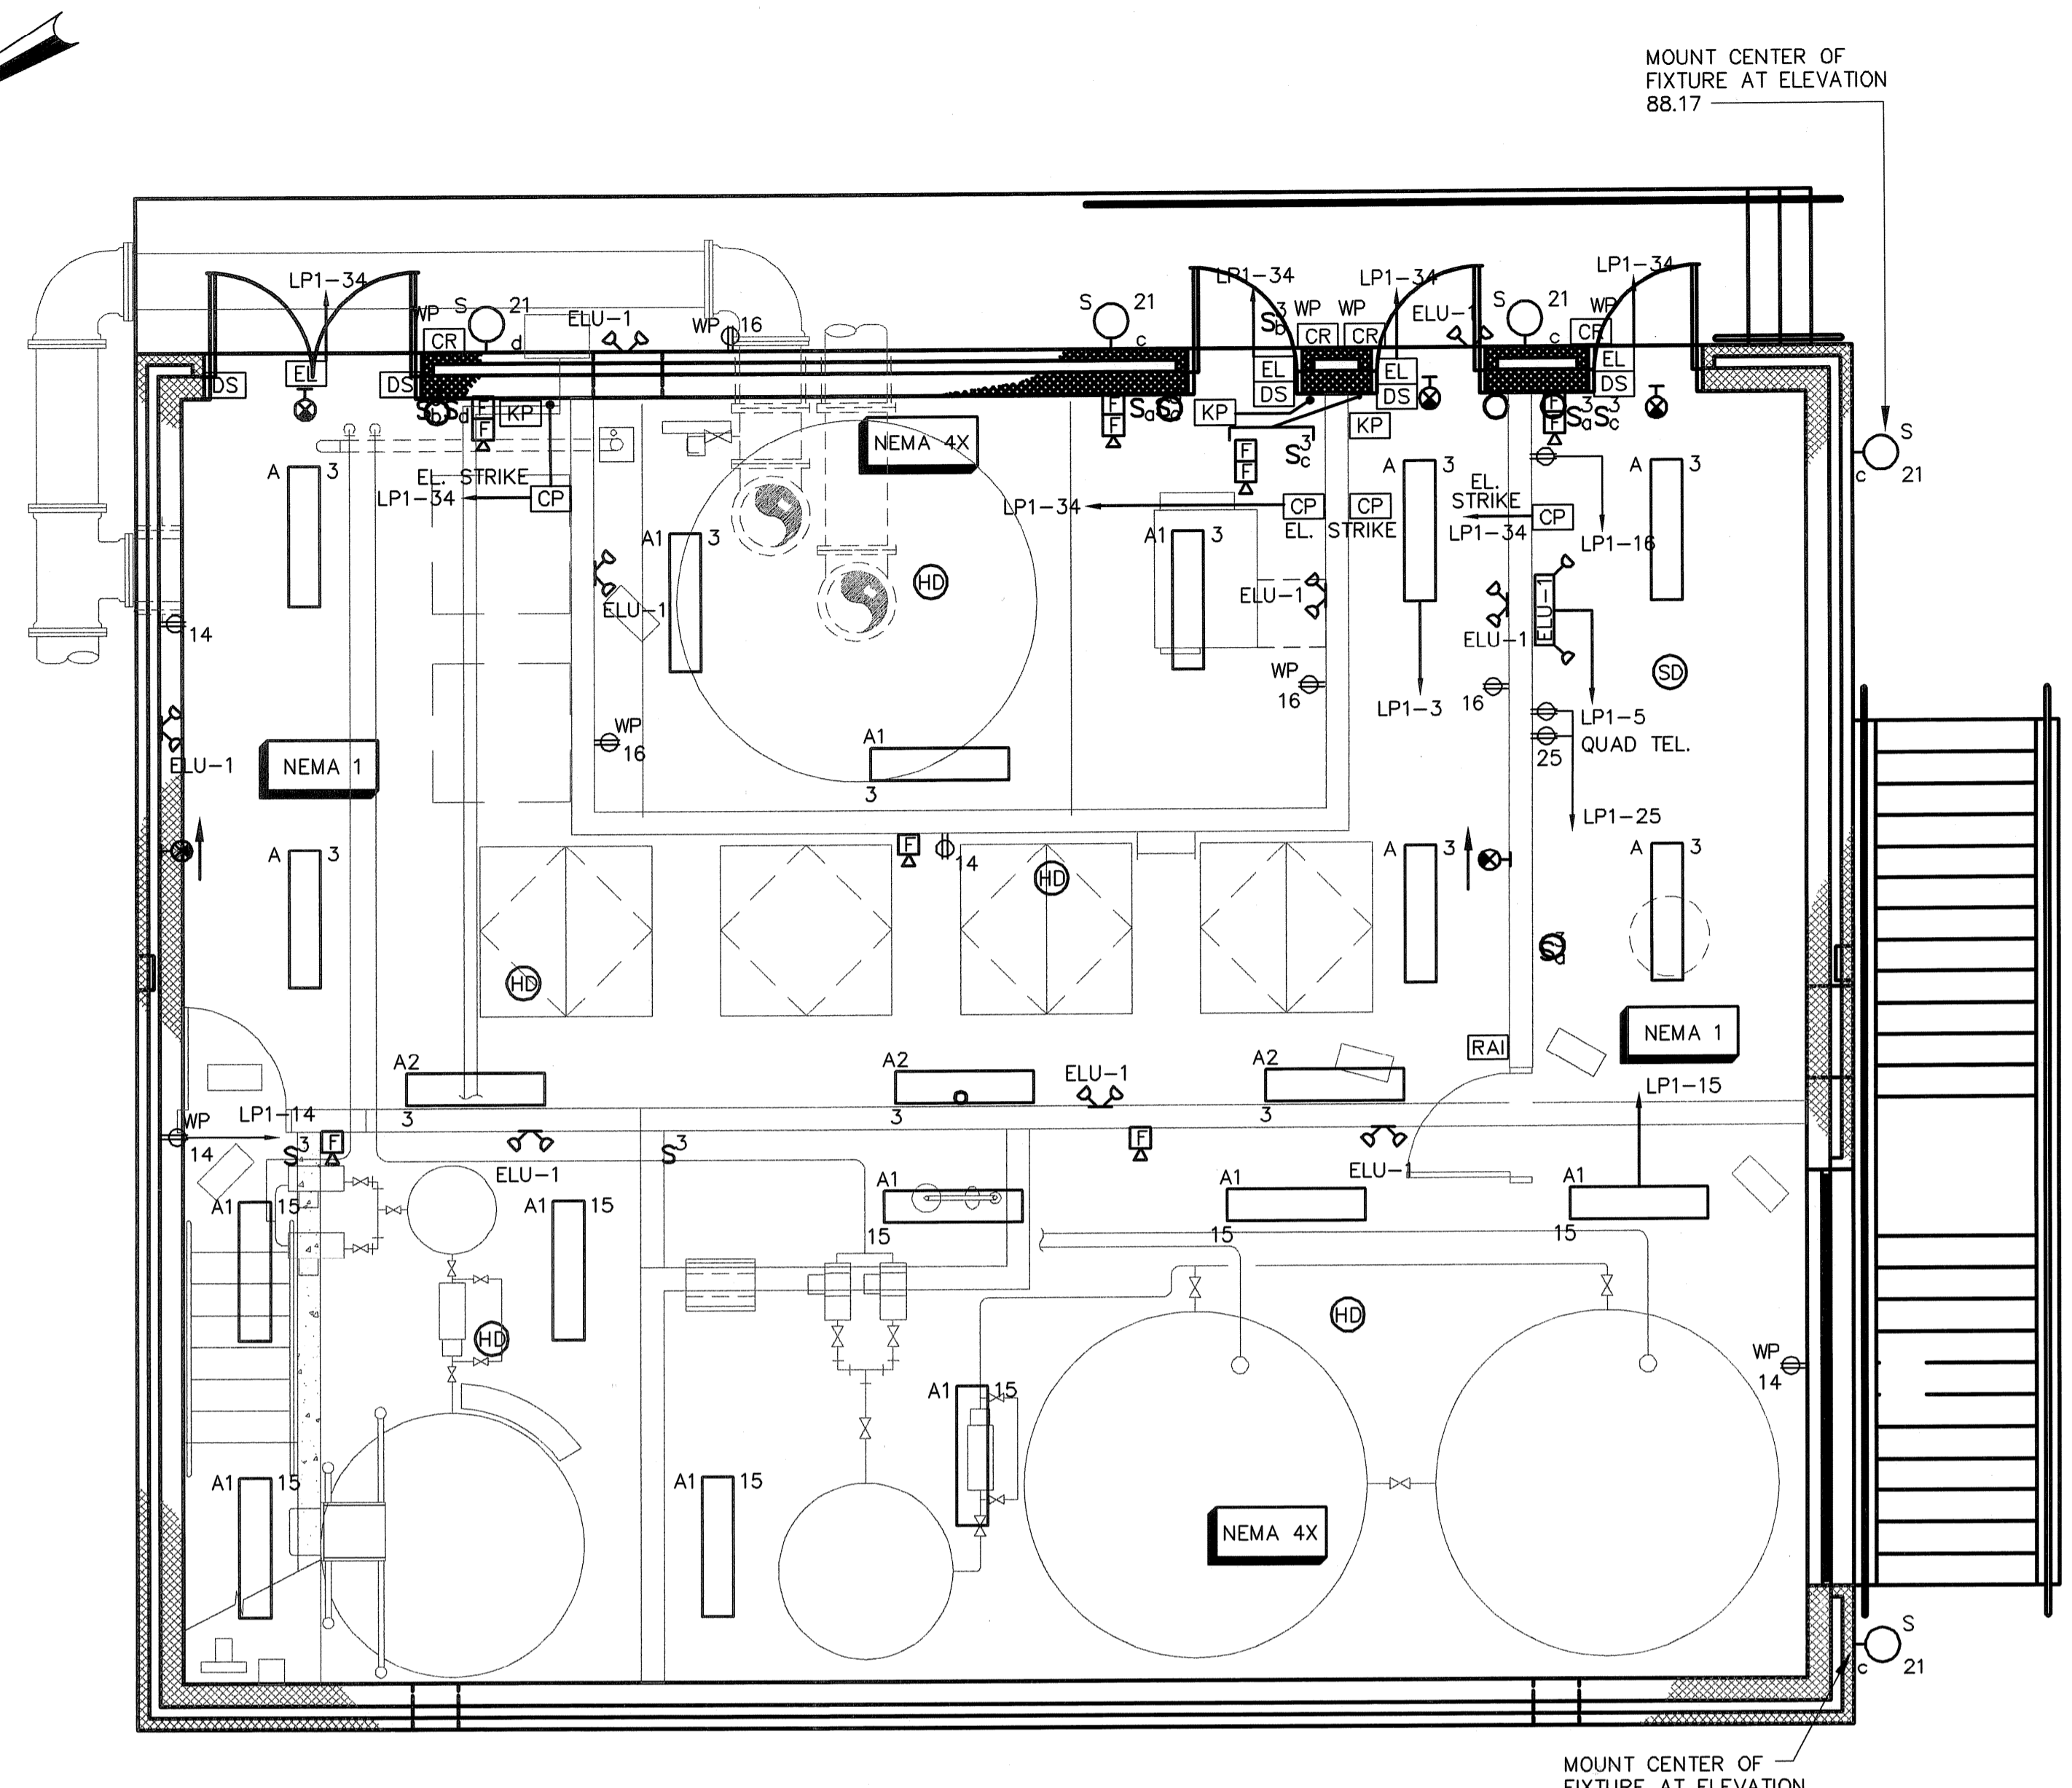

**GROUND LEVEL
 LIGHTING AND MISC. SYSTEMS PLAN**
 SCALE: 1/4" = 1'-0"

- NOTES:**
- SEE SHEET E-1 FOR LEGEND, ABBREVIATIONS, AND GENERAL NOTES.
 - CONNECT REMOTE EMERGENCY HEADS IDENTIFIED WITH UNIQUE NUMBERS TO THE EMERGENCY LIGHTING UNITS (ELU) OF THE SAME NUMBER. MINIMUM WIRE SIZE SHALL BE #10 IN 1/2" CONDUIT, WITH RECEWAY TYPE AS REQUIRED BY THE NEMA CLASSIFICATION OF THE AREA SERVED. PROVIDE #8 WIRE TO REMOTE HEADS GREATER THAN 50 FEET CABLE DISTANCE FROM ELU. PROVIDE JUNCTION BOX ABOVE ELU TO SPLICE WIRING TO SIZE REQUIRED FOR ELU.
 - EXIT LIGHTS SHALL BE POWERED FROM UNSWITCHED LINE OF NEAREST LIGHTING CIRCUIT.
 - VERIFY CORRECT LIGHT SWITCH LOCATION, PRIOR TO INSTALLATION TO INSURE THAT THE SWITCHES ARE NOT INSTALLED BEHIND OPENED DOOR.
 - RECEPTACLES IN NEAM 4 AREAS AND EXTERIOR TO BE GASKETED WITH COVERS THAT SEAL RECEPTACLE WHEN CORD CONNECTED EQUIPMENT ARE IN USE.

MOUNT CENTER OF FIXTURE AT ELEVATION 88.17

MOUNT CENTER OF FIXTURE AT ELEVATION 76.50



NO.	DATE	BY	REVISIONS
2	MAY 2008	DM	AS-BUILT DRAWING FILE
1	10/31/06	DM	ISSUED FOR RFI POSTED SET
0	10/28/05	DM	ISSUED FOR CONSTRUCTION
B	8/16/05	DM	REV. B AGENCY REVIEW
A	7/22/05	DM	REV. A CLIENT REVIEW

ROBERT H. SHELDON
 No. 4103
 [Signature]

PAWTUCKET, RHODE ISLAND
**PAWTUCKET REGIONAL
 WATER TREATMENT FACILITY**
PKGS 11 & 12 - RAW WATER PUMP STATION
 LIGHTING AND MISC. SYSTEMS PLAN

DESIGNED BY	DM	DWG SCALE	AS NOTED
DRAWN BY	DM	CONTRACT NO.	
CHECKED BY	WS	DATE	OCTOBER 31, 2008

**EARTH TECH
 AS-BUILT FILE
 MAY 2008**

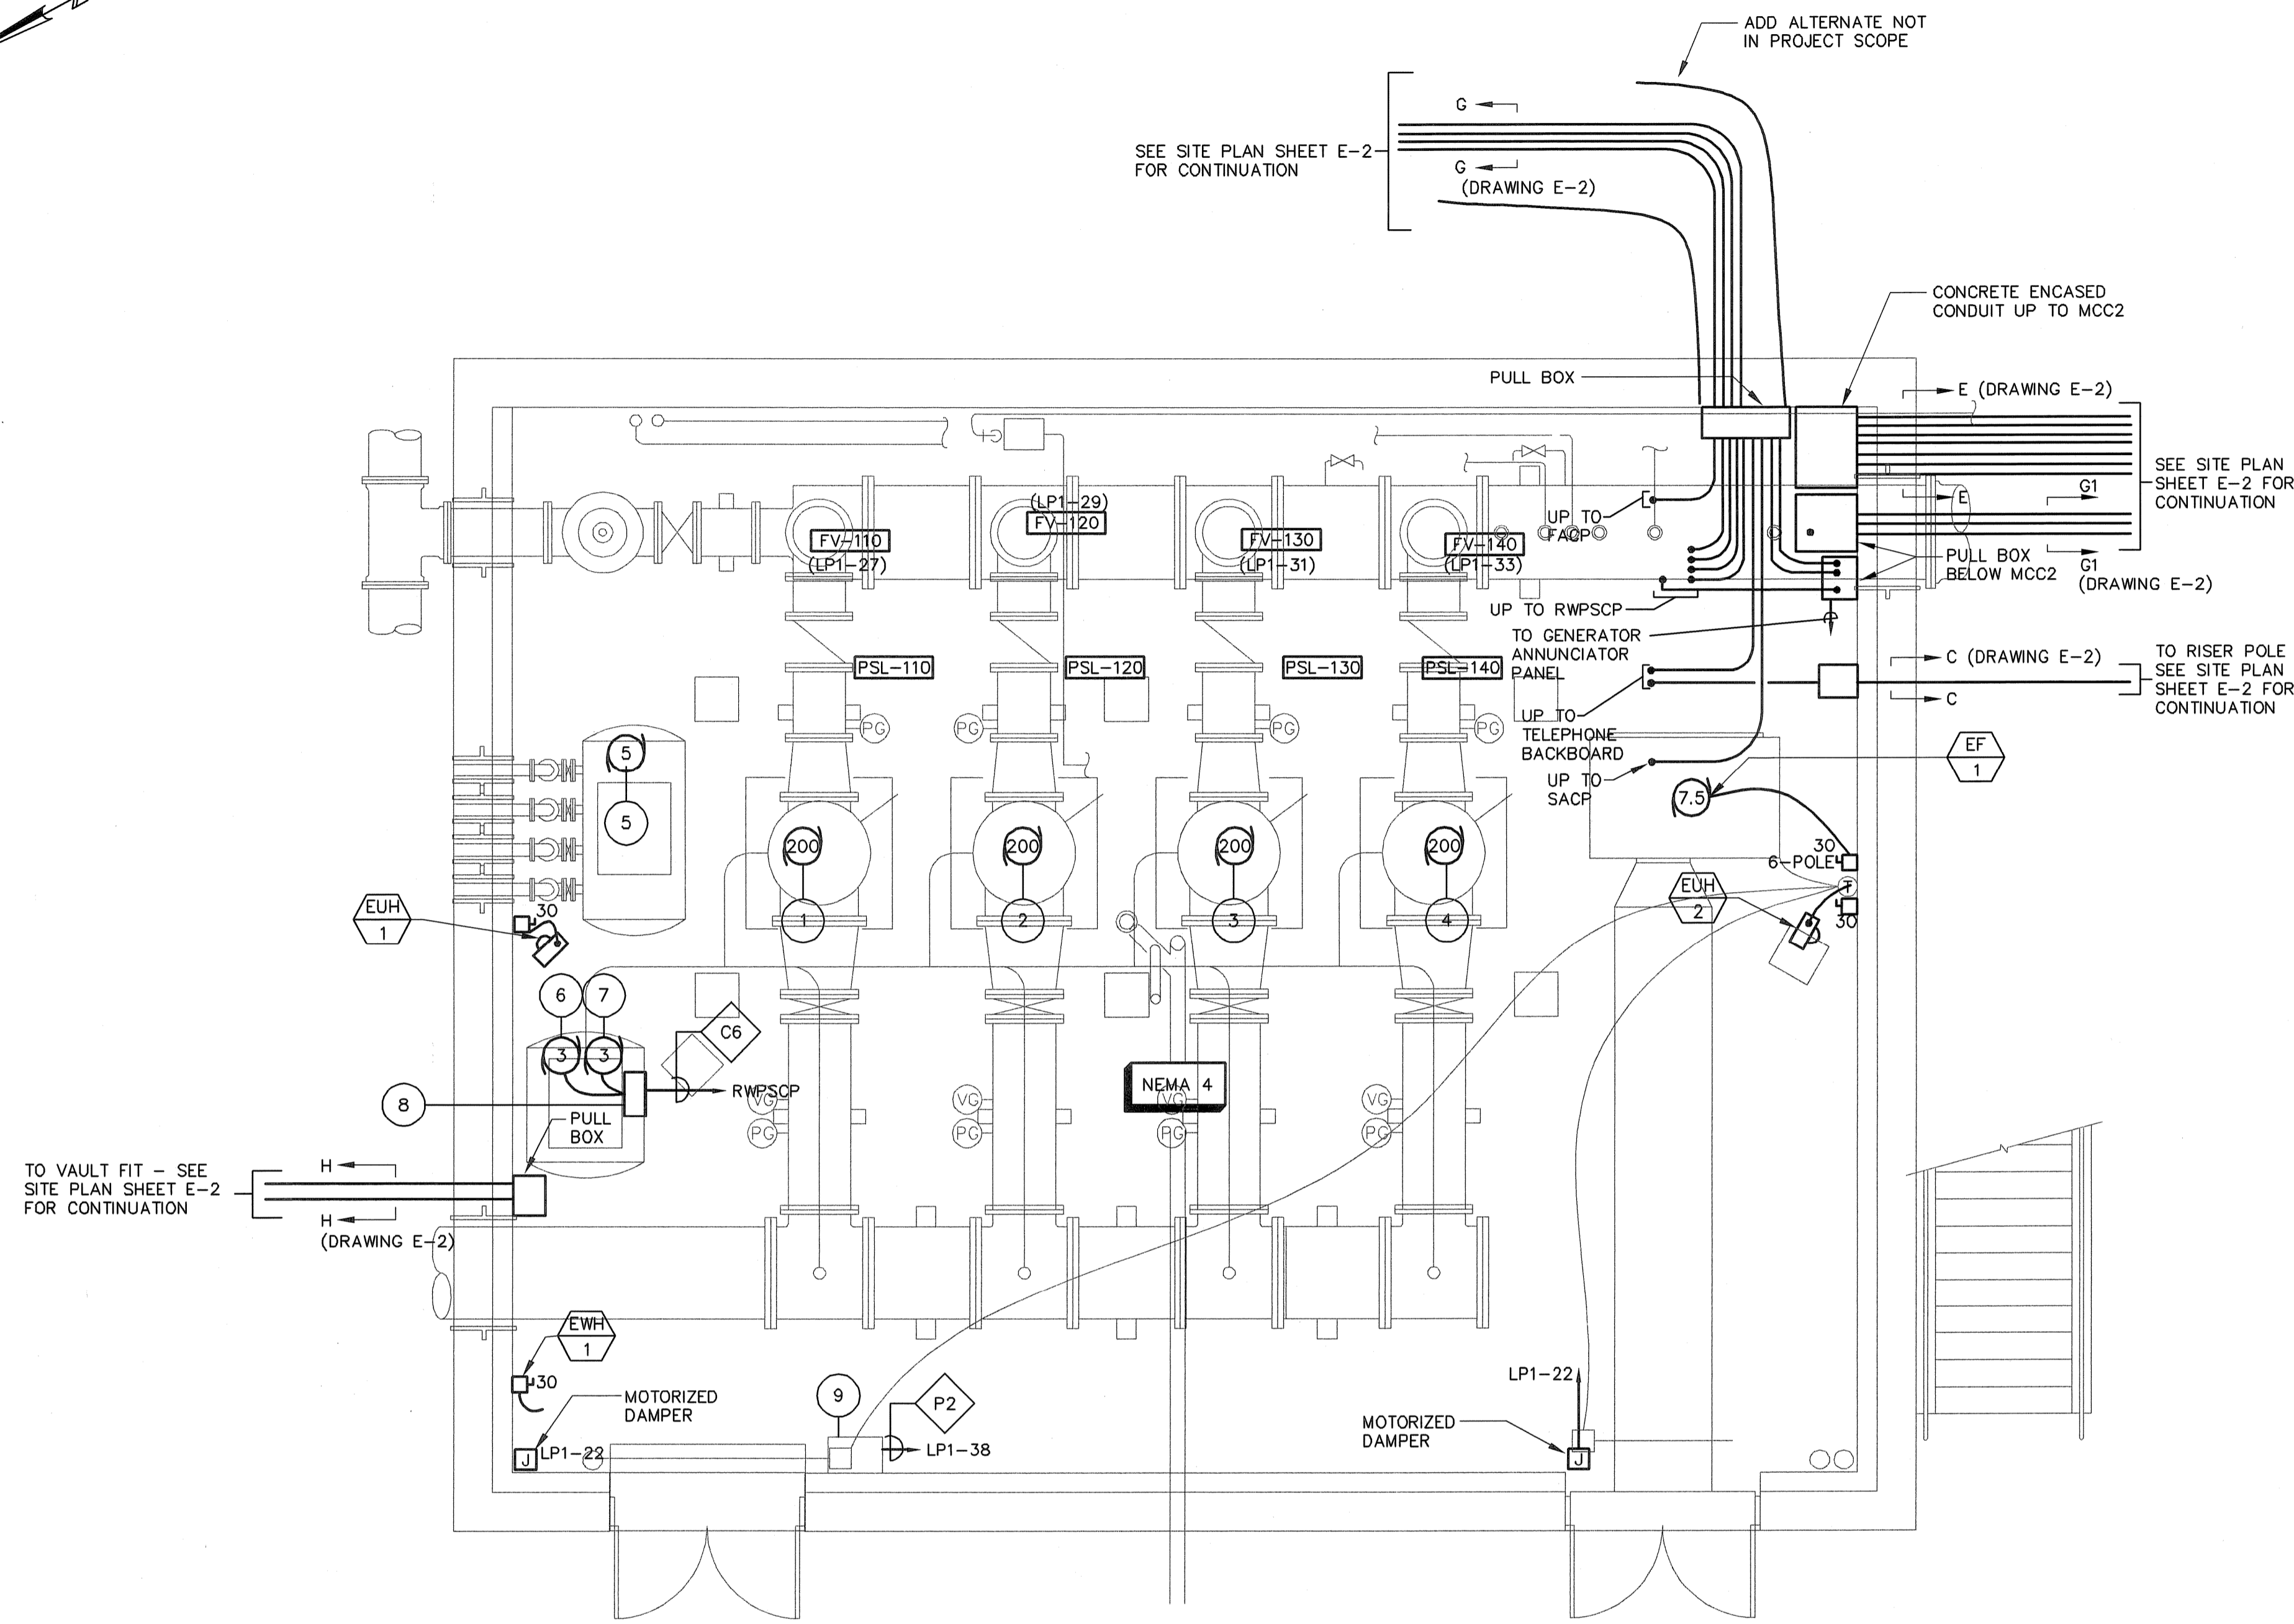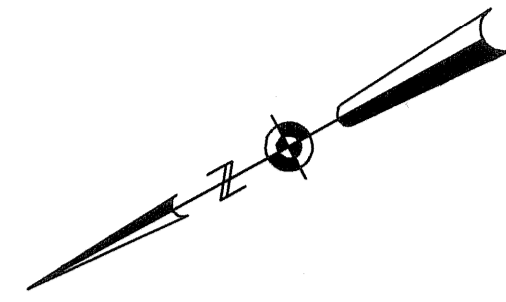


PUMP LEVEL - POWER PLAN
SCALE: 1/4" = 1'-0"

- EQUIPMENT LEGEND**
- ① RAW WATER PUMP "RWP-110"
 - ② RAW WATER PUMP "RWP-120"
 - ③ RAW WATER PUMP "RWP-130"
 - ④ FUTURE RAW WATER PUMP "RWP-140"
 - ⑤ AIR COMPRESSOR
 - ⑥ VACUUM PRIMING SYSTEM PUMP NO.1
 - ⑦ VACUUM PRIMING SYSTEM PUMP NO.2
 - ⑧ VACUUM PRIMING SYSTEM CONTROL PANEL
 - ⑨ AIR DIFFUSION SYSTEM

NOTES:
 1. SEE SHEET E-1 FOR LEGEND, ABBREVIATIONS, AND GENERAL NOTES.
 2. SEE SHEET E-3 FOR 480V POWER REQUIREMENTS.

NO.	REVISIONS	DATE	BY
2	REV. A CLIENT REVIEW	7/22/05	A
1	REV. B AGENCY REVIEW	9/16/05	B
0	ISSUED FOR CONSTRUCTION	10/28/05	
1	AS-BUILT DRAWING FILE	10/21/06	

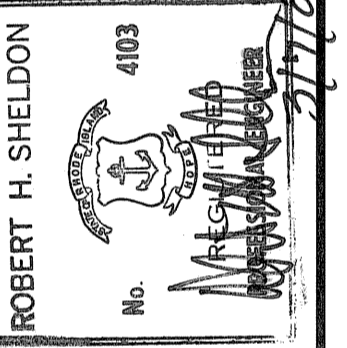

PAWTUCKET, RHODE ISLAND
PAWTUCKET REGIONAL WATER TREATMENT FACILITY
PKGS 11 & 12 - RAW WATER PUMP STATION
 PUMP LEVEL POWER PLAN

DESIGNED BY DM	DWG SCALE AS NOTED
DRAWN BY DM	CONTRACT NO.
CHECKED BY WS	DATE OCTOBER 31, 2006

EARTH TECH
AS-BUILT FILE
 MAY 2008

Filename: L:\WORK\69983\CAD\AS-BUILT\11-12 RWTP\ELEC\69983-PKG12-E9.DWG
 Plot File Date Created: Sep/22/2008 11:35 AM

NO.	BY	DATE	REVISIONS
2	DM	MAY 2008	AS-BUILT DRAWING FILE
1	DM	10/31/05	ISSUED FOR RT POSTED SET
0	DM	10/28/05	ISSUED FOR CONSTRUCTION
B	DM	9/16/05	REV. B AGENCY REVIEW
A	DM	7/22/05	REV. A CLIENT REVIEW



ROBERT H. SHELDON
No. 4103
3/17/08

PAWTUCKET, RHODE ISLAND
**PAWTUCKET REGIONAL
WATER TREATMENT FACILITY**
PKGS 11 & 12 - RAW WATER PUMP STATION
GROUND LEVEL POWER PLAN

DESIGNED BY DM	DWG SCALE AS NOTED
DRAWN BY DM	CONTRACT NO.
CHECKED BY WS	DATE OCTOBER 31, 2008

EARTH TECH
AS-BUILT FILE
MAY 2008

E-10
SHEET OF

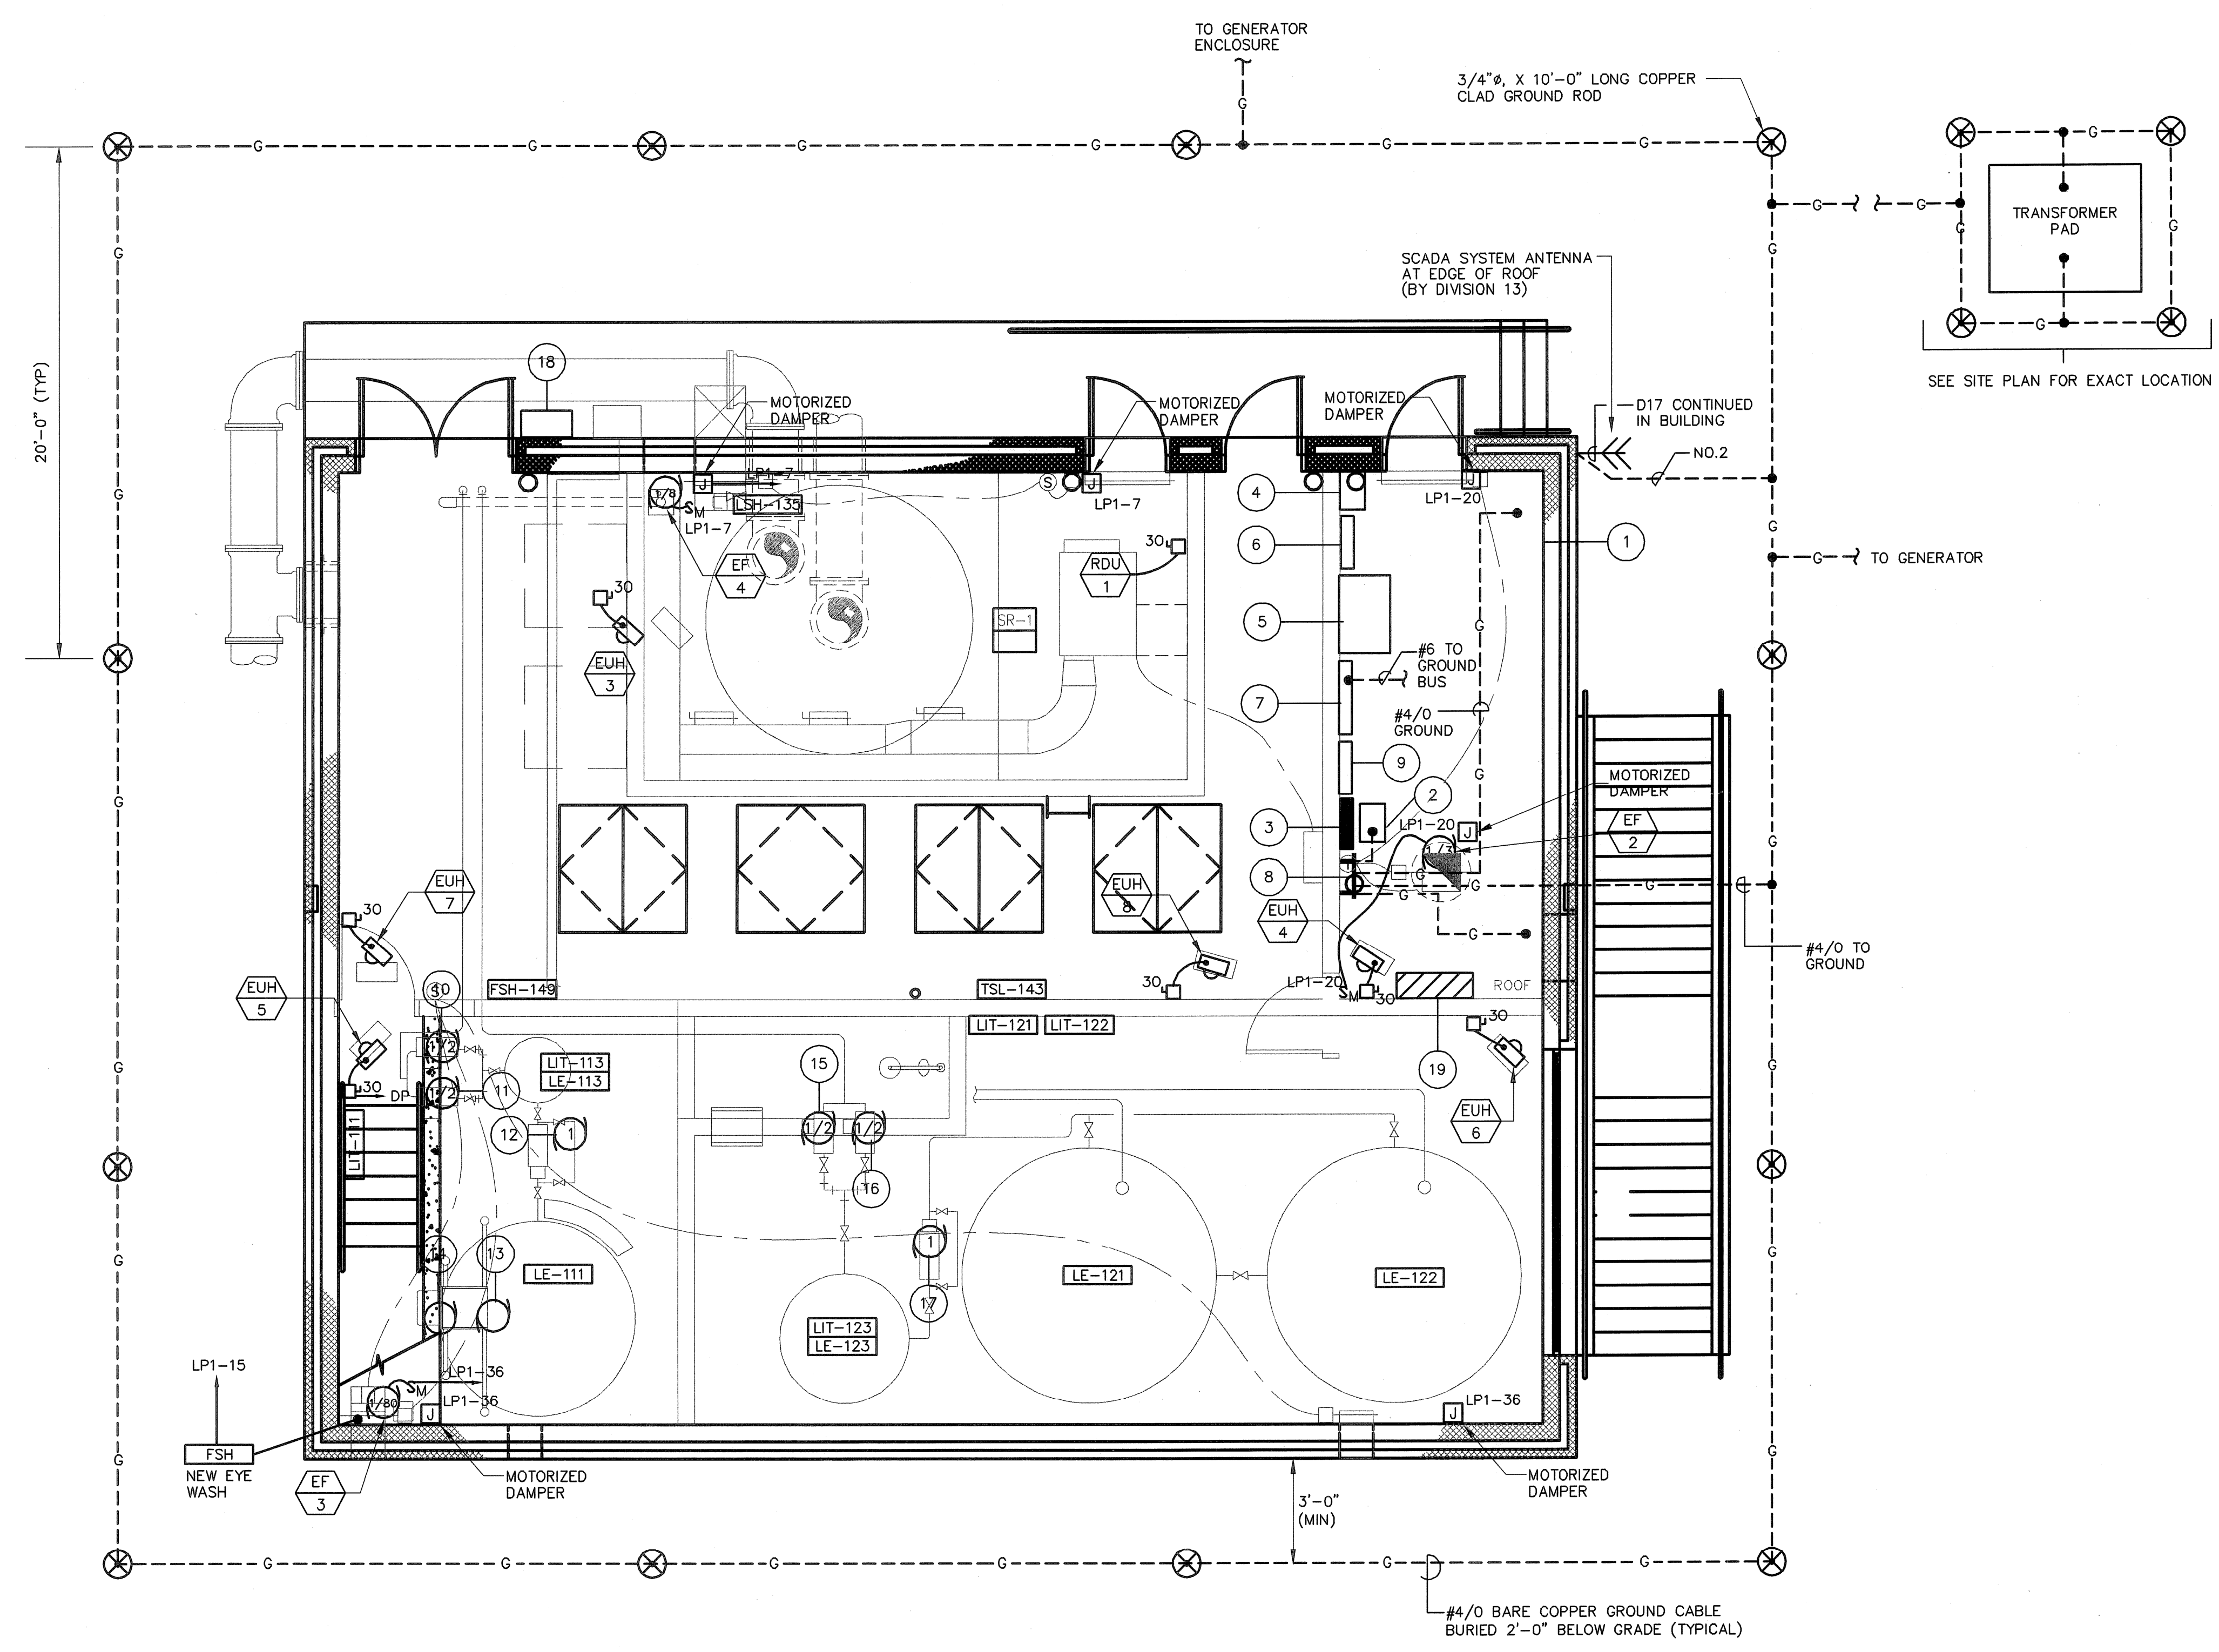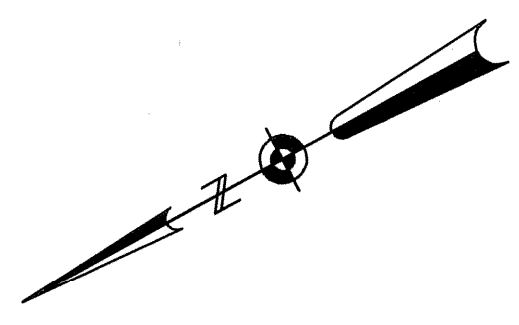

GROUND LEVEL - POWER PLAN
SCALE: 1/4" = 1'-0"

EQUIPMENT LEGEND

- | | |
|---|--|
| 1 MOTOR CONTROL CENTER "MCC2" (PULL BOX FOR FEEDS TO RAW WATER PUMPS NOT SHOWN) | 10 POTASSIUM PERMANGANATE CHEMICAL FEED PUMP "KFP-111" |
| 2 30KVA, 480-120/208V, 3PH, 4-WIRE TRANSFORMER | 11 POTASSIUM PERMANGANATE CHEMICAL FEED PUMP "KFP-112" |
| 3 LIGHTING PANELBOARD "LP1" | 12 POTASSIUM PERMANGANATE CHEMICAL TRANSFER PUMP "KTP-110" |
| 4 GENERATOR ANNUNCIATOR PANEL AND EMERGENCY STOP SWITCH | 13 POTASSIUM PERMANGANATE MIXER |
| 5 SCADA CONTROL PANEL "RWPSCP" | 14 POTASSIUM PERMANGANATE DUST COLLECTOR |
| 6 FIRE ALARM CONTROL PANEL (FACP) | 15 SODIUM HYDROXIDE CHEMICAL FEED PUMP "OHFP-121" |
| 7 TELEPHONE BACKBOARD AND CABINET PROVIDED WITH TELEPHONE INTERFACE PANEL, TELEPHONE JACK AND ASSOCIATED CATEGORY 3 CABLE | 16 SODIUM HYDROXIDE CHEMICAL FEED PUMP "OHFP-122" |
| 8 GROUND BUS | 17 SODIUM HYDROXIDE CHEMICAL TRANSFER PUMP "OHTP-120" |
| 9 SECURITY SYSTEM CONTROL PANEL "SACP" | 18 CHEMICAL FILL PANEL |
| | 19 POWER DISTRIBUTION PANEL "DP" |

NOTES:

- SEE SHEET E-1 FOR LEGEND, ABBREVIATIONS, AND GENERAL NOTES.
- MOUNT (QUANTITY 3) RAW WATER PUMP POWER FACTOR CORRECTION CAPACITORS ABOVE MOTOR CONTROL CENTER.

Filename: L:\WORK\69993\CAD\AS-BUILT\11-12 RWTP\LEEC\69993-PKG12-E10.DWG
Plot File Date Created: Sep/22/2008 11:35 AM